




A 112+50

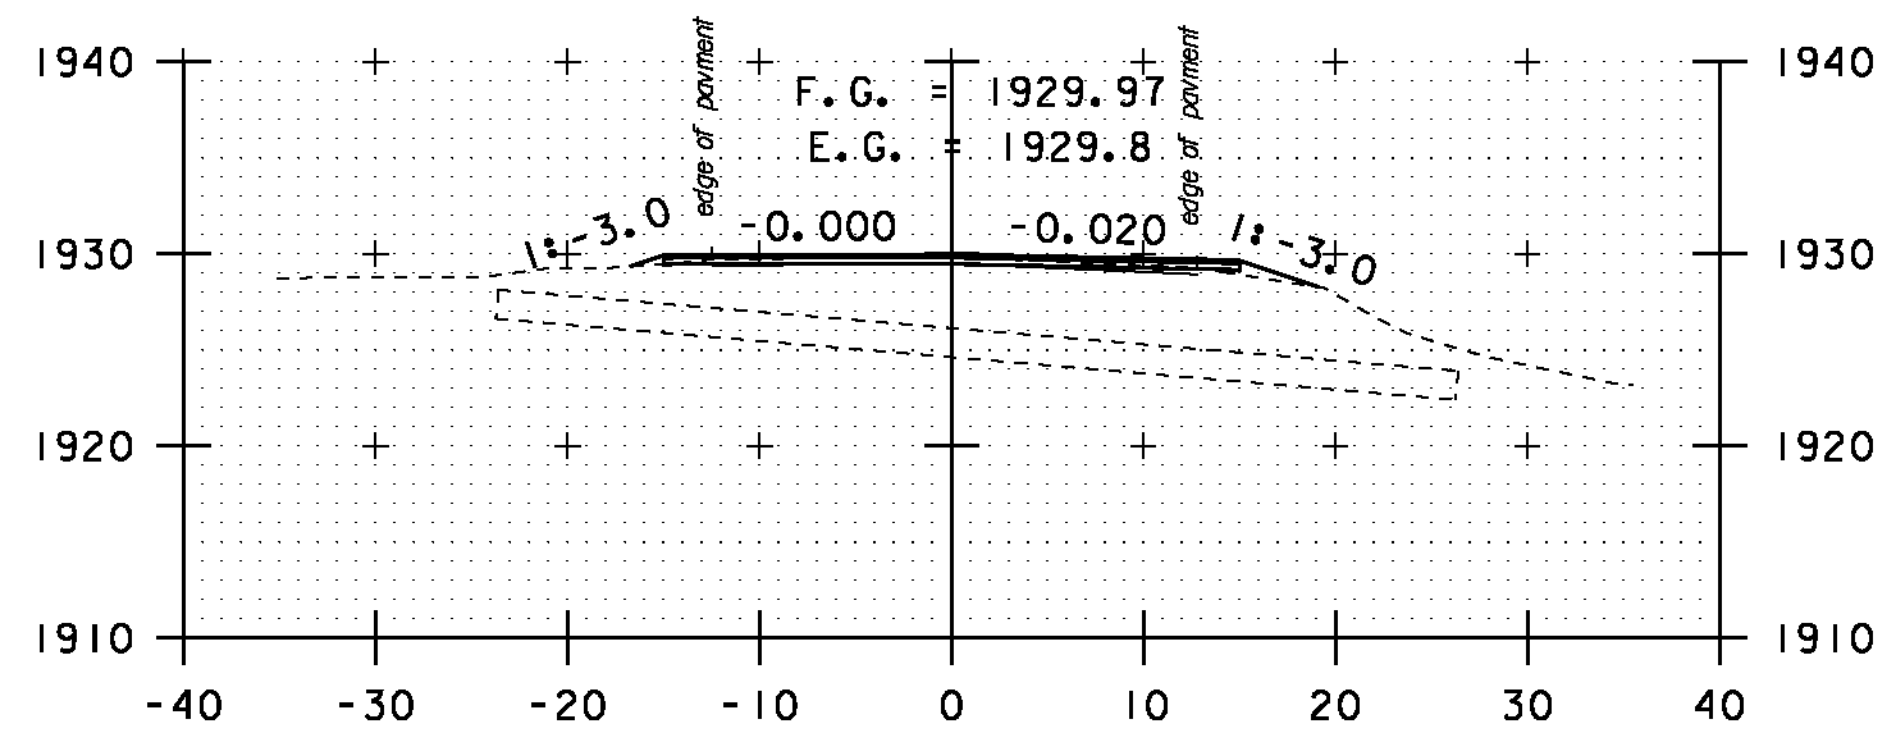


DRIVE LT
A 112+00

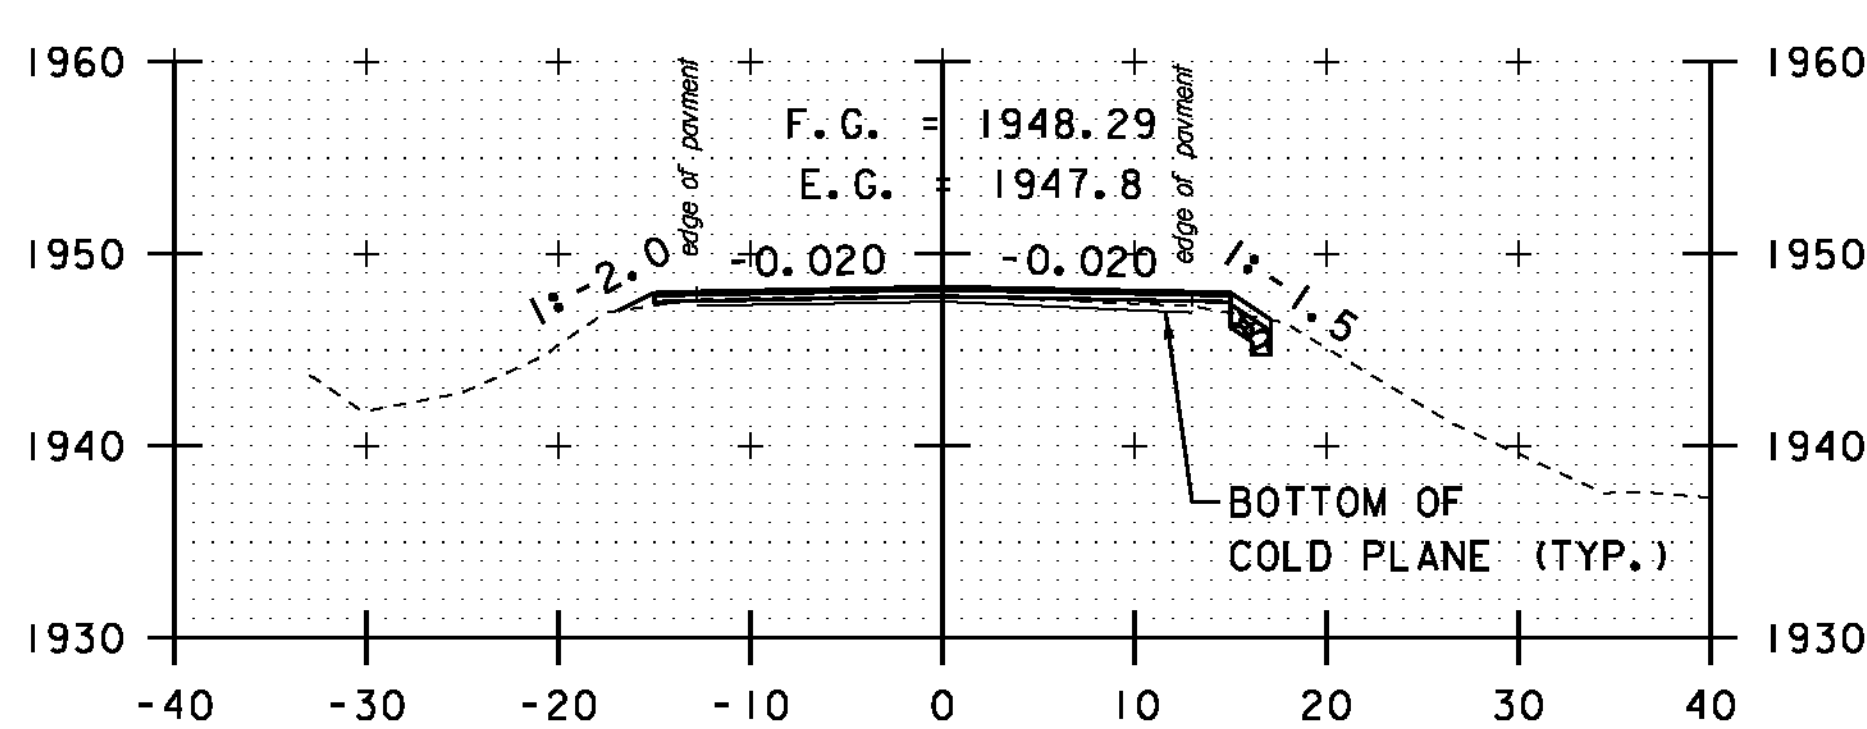


A 114+00

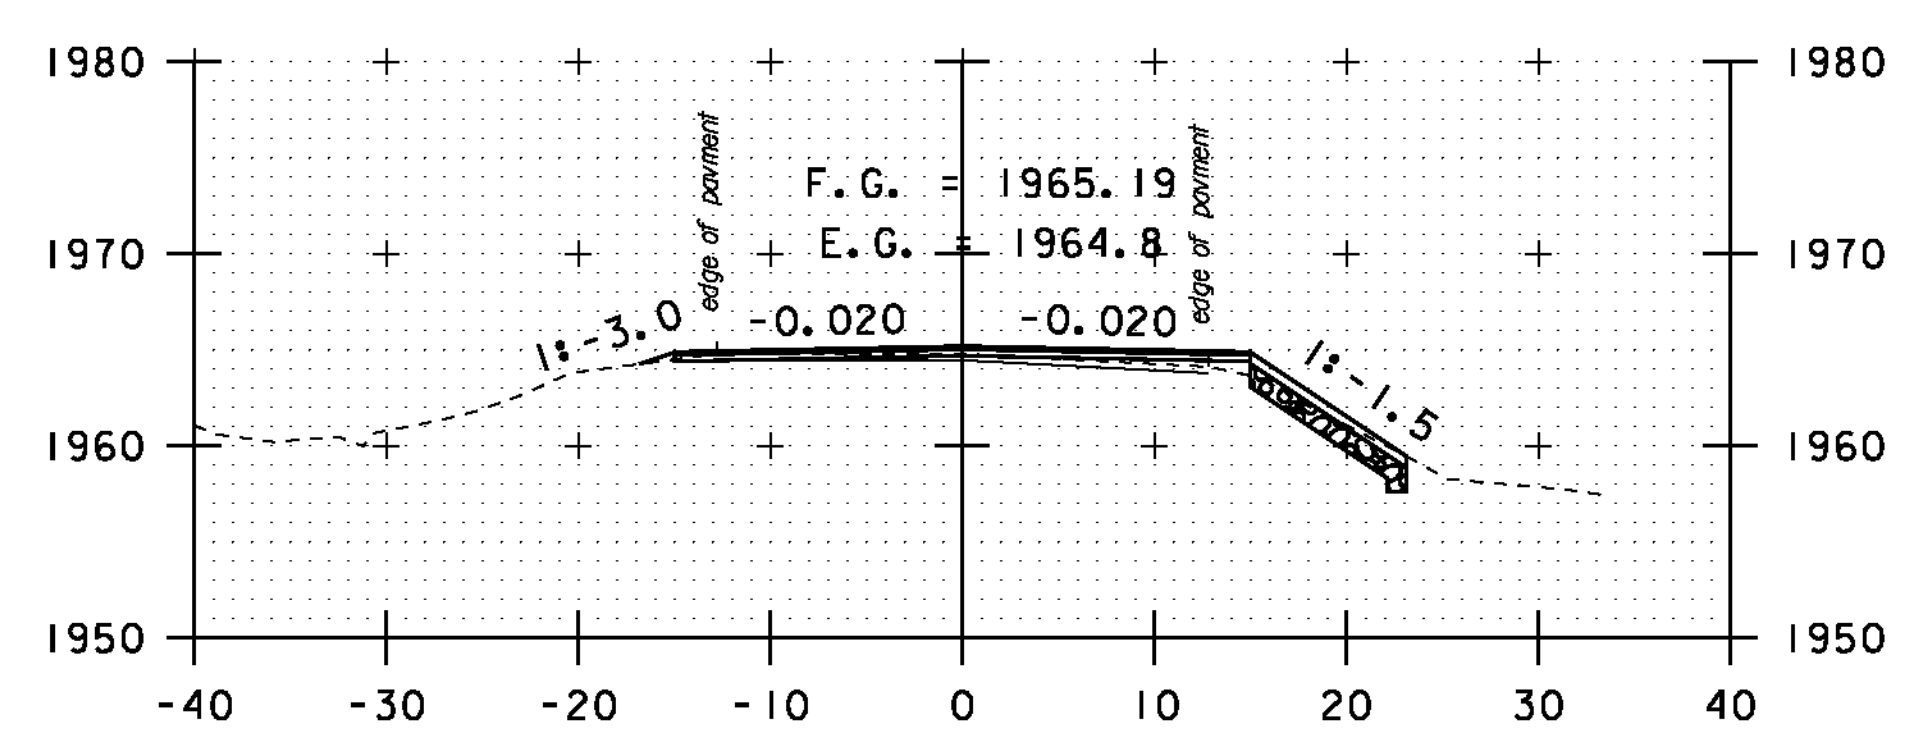


A 115+50

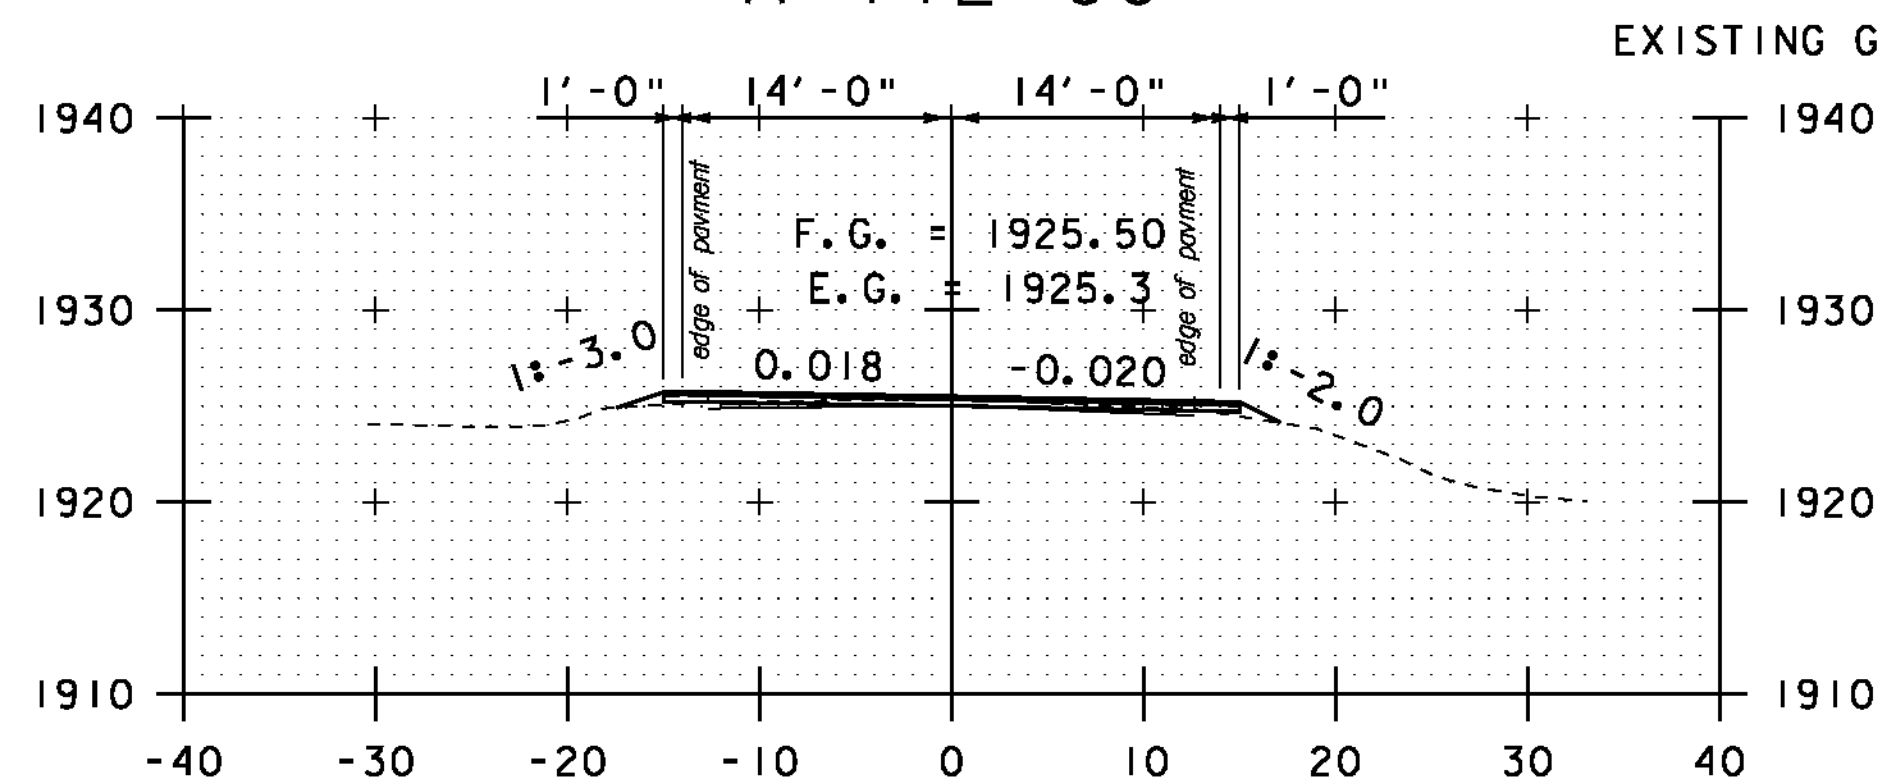


A 111+50

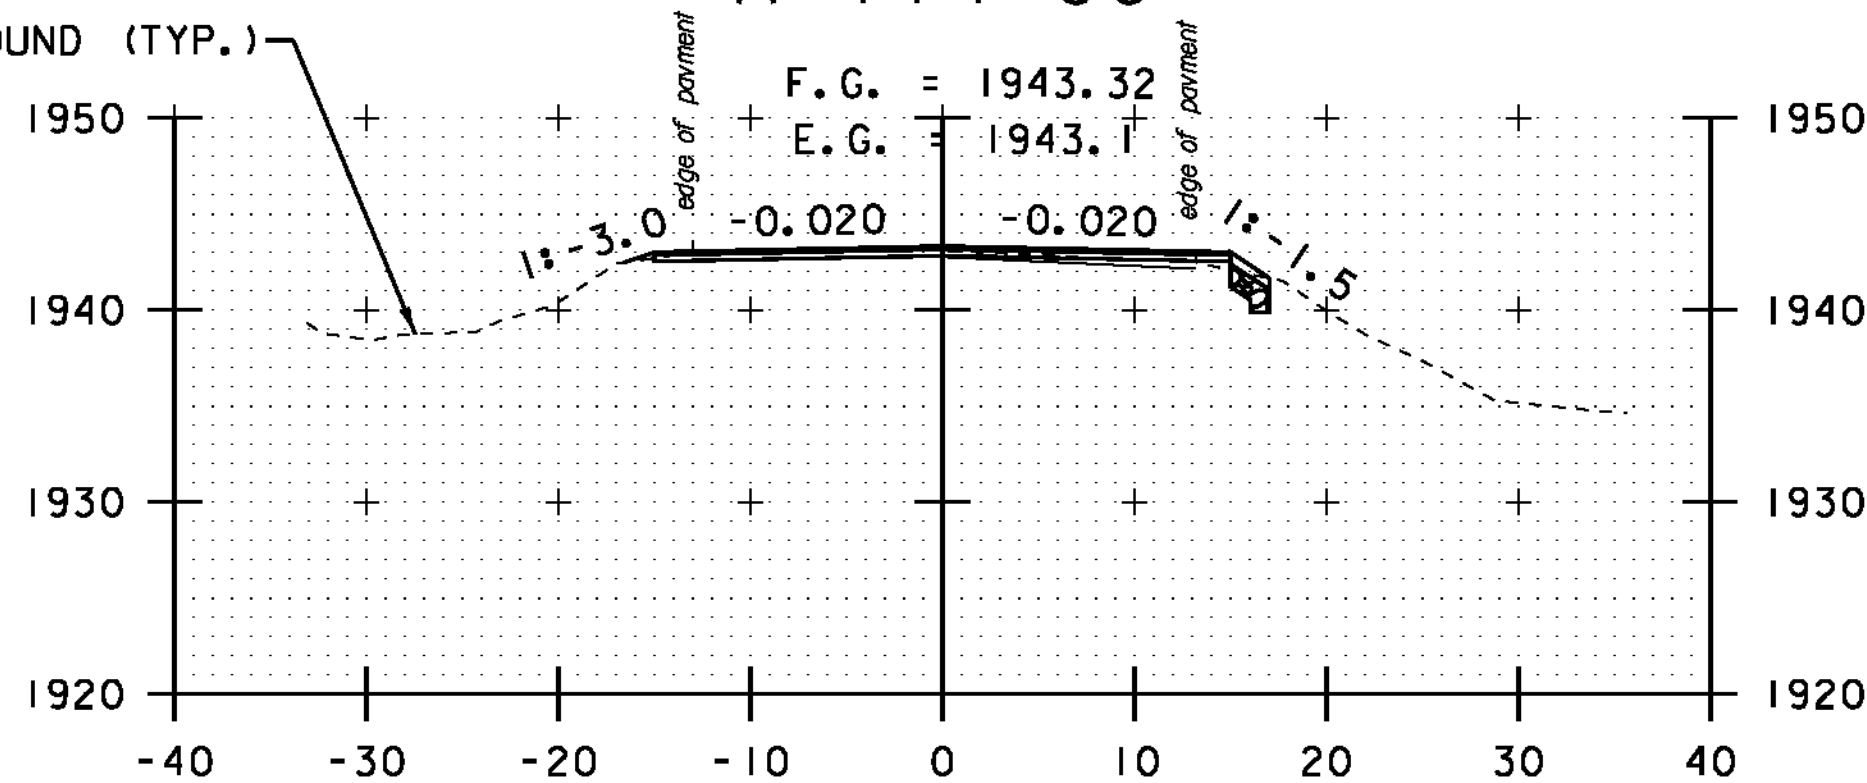


A 113+50

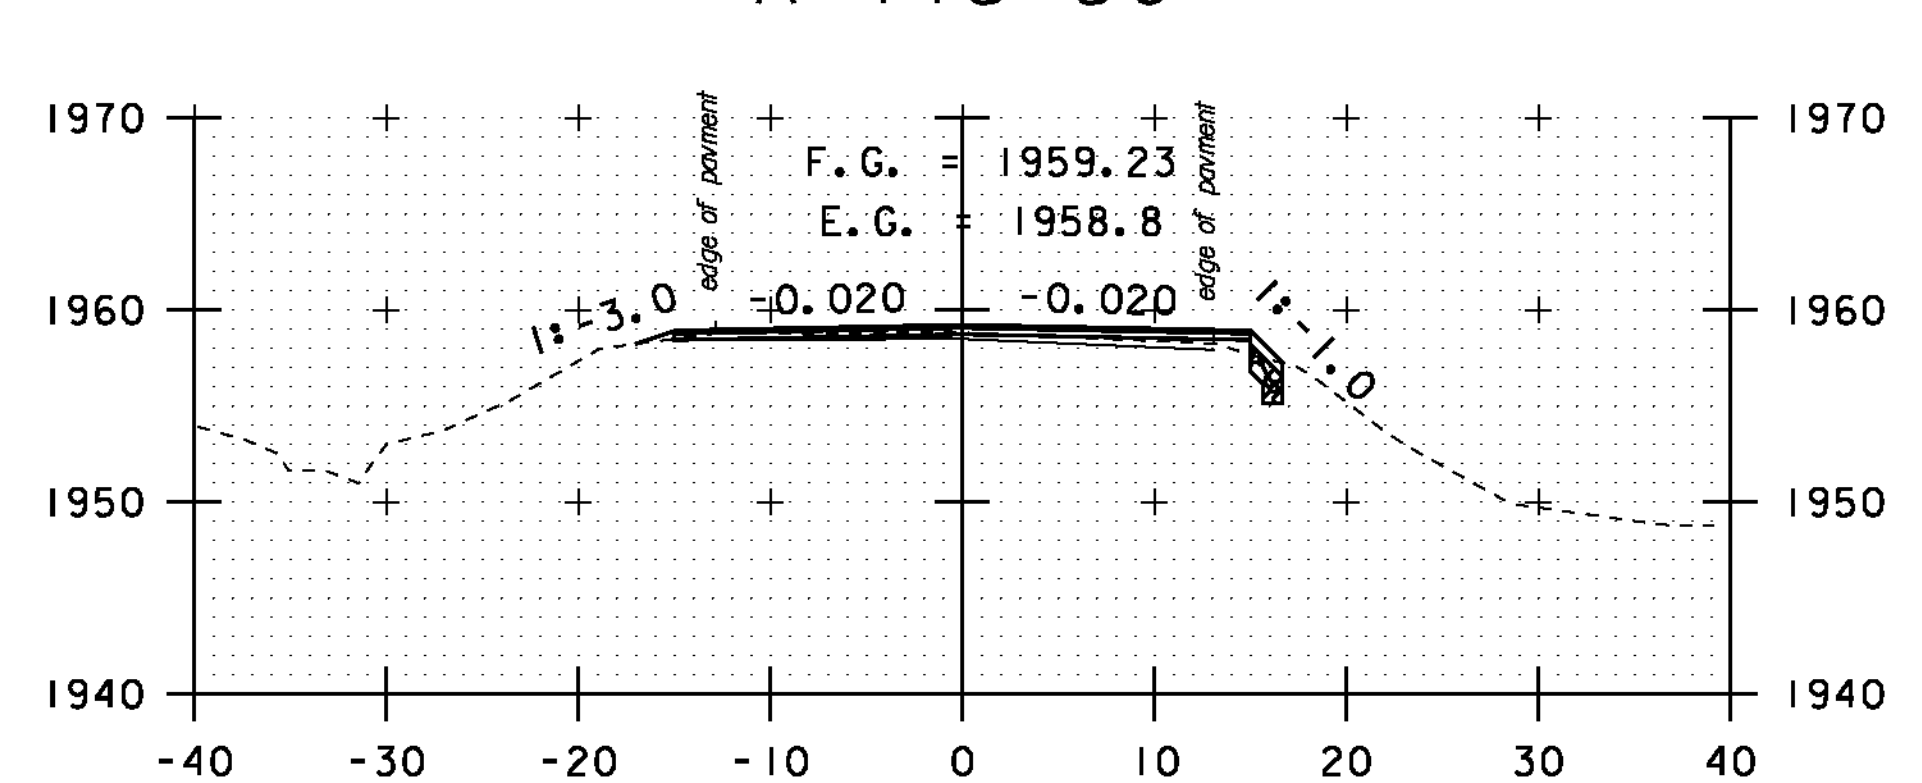


A 115+00

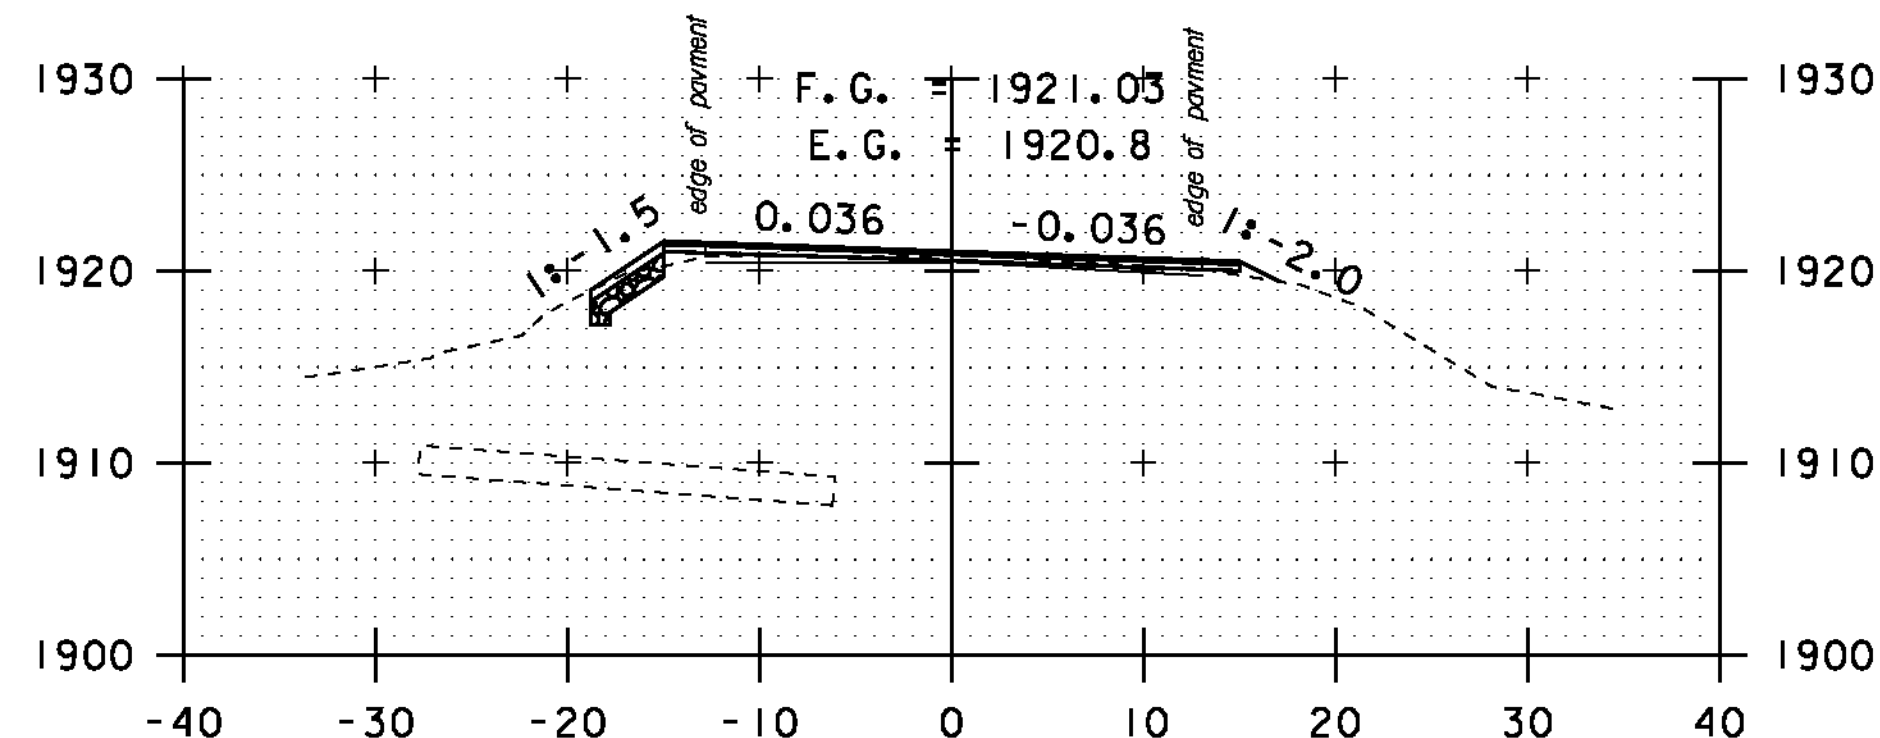

A 111+00

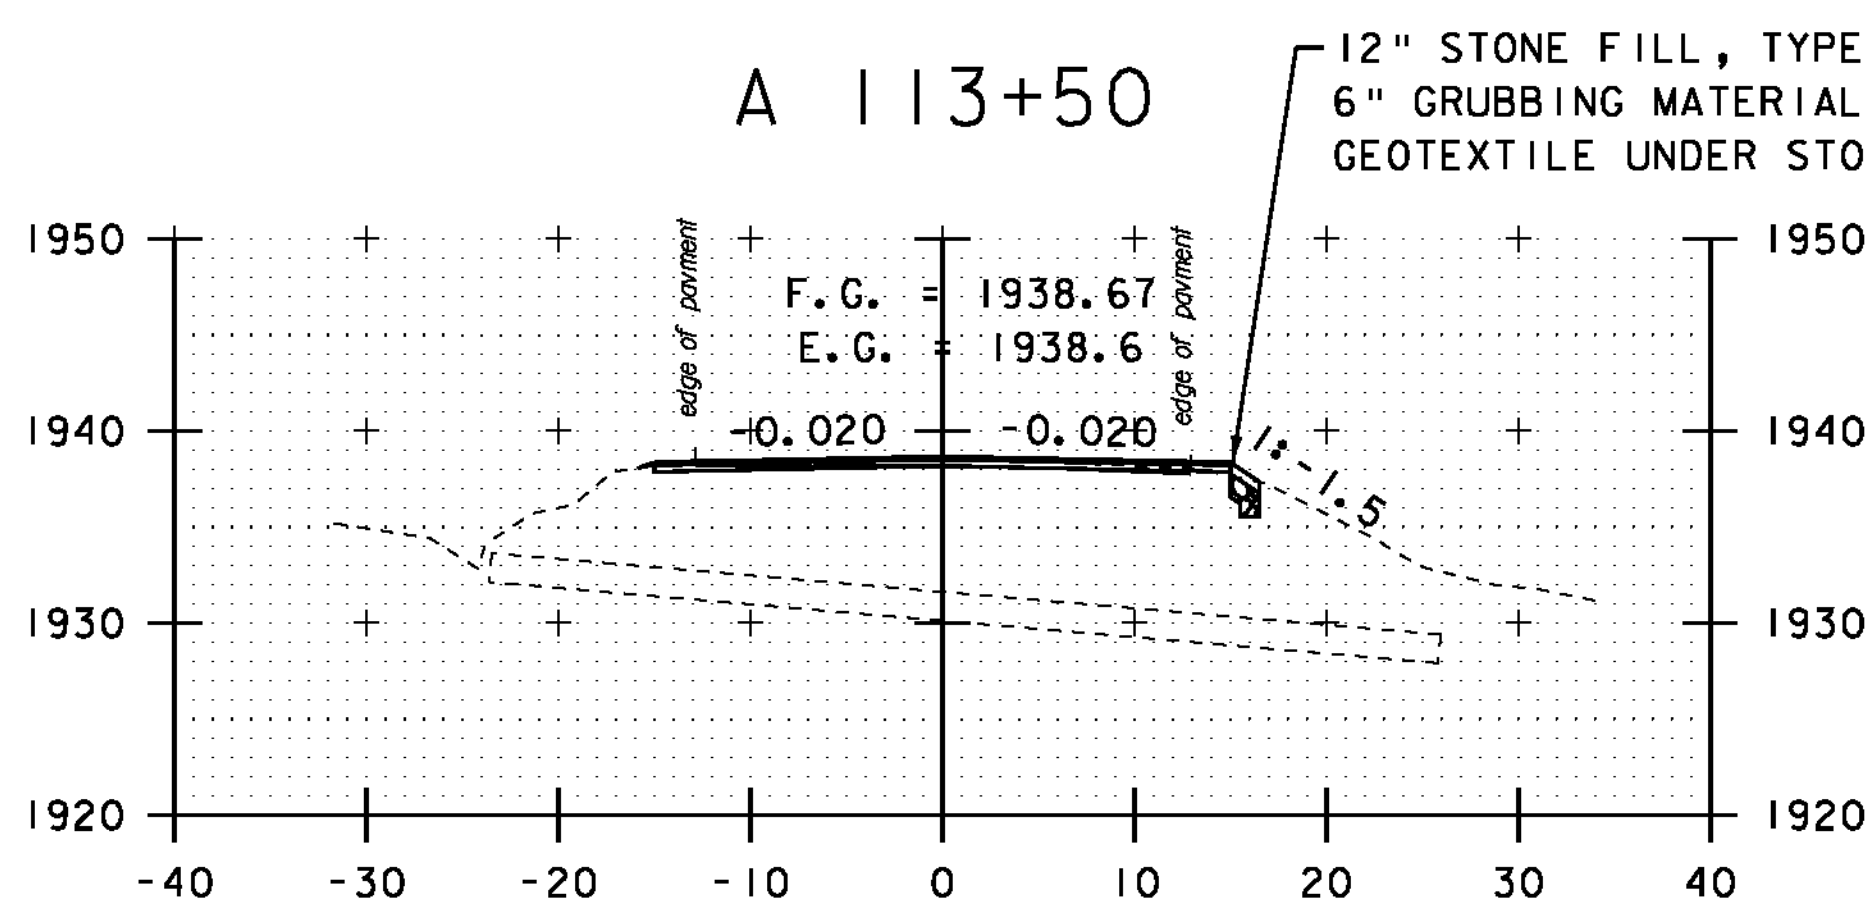


A 113+00

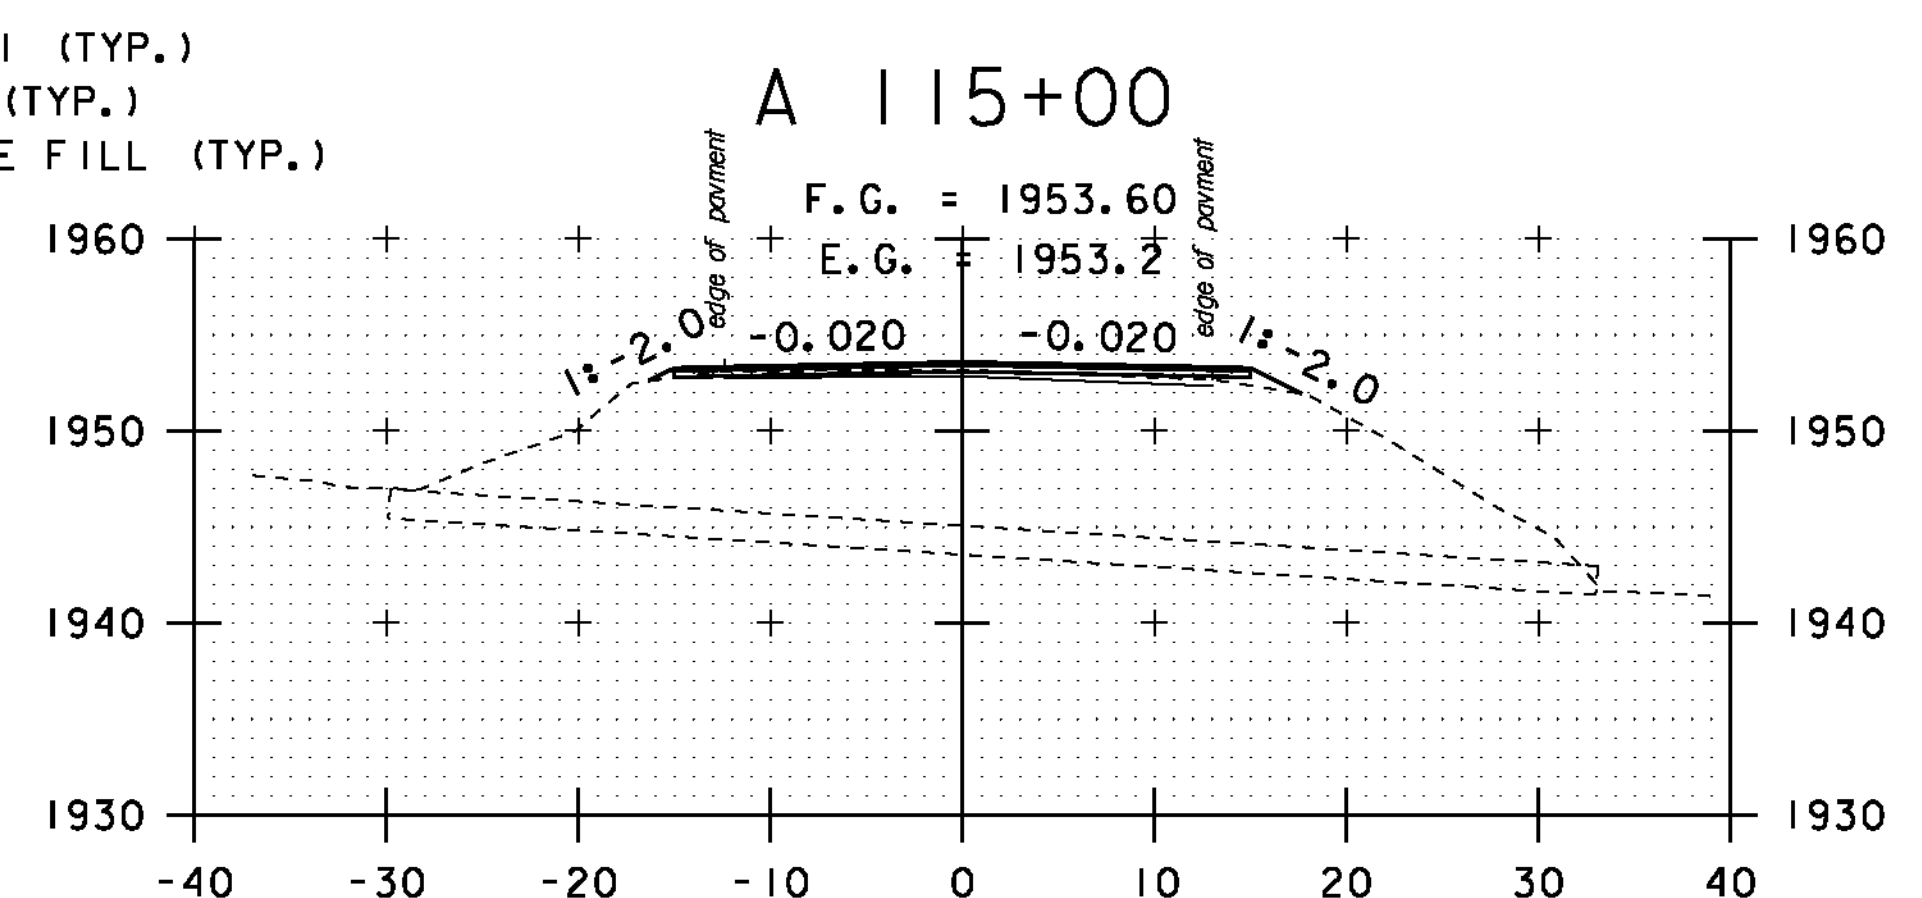

A 114+50

STA. A 111+00 TO STA. A 115+50

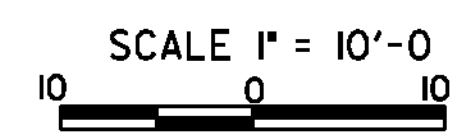

CROSS SECTION SHEET 58

PROJECT NAME: MONTGOMERY-WESTFIELD	
PROJECT NUMBER: STP 2906(I)	
FILE NAME: pi0ci90.dgn	PLOT DATE: 9/5/12
PROJECT LEADER: CDL	DRAWN BY: SJL
DESIGNED BY: SJL	CHECKED BY: CDL
PLOT FILE: pi0ci90_172.1	SHEET 172 OF 178