




A 117+50

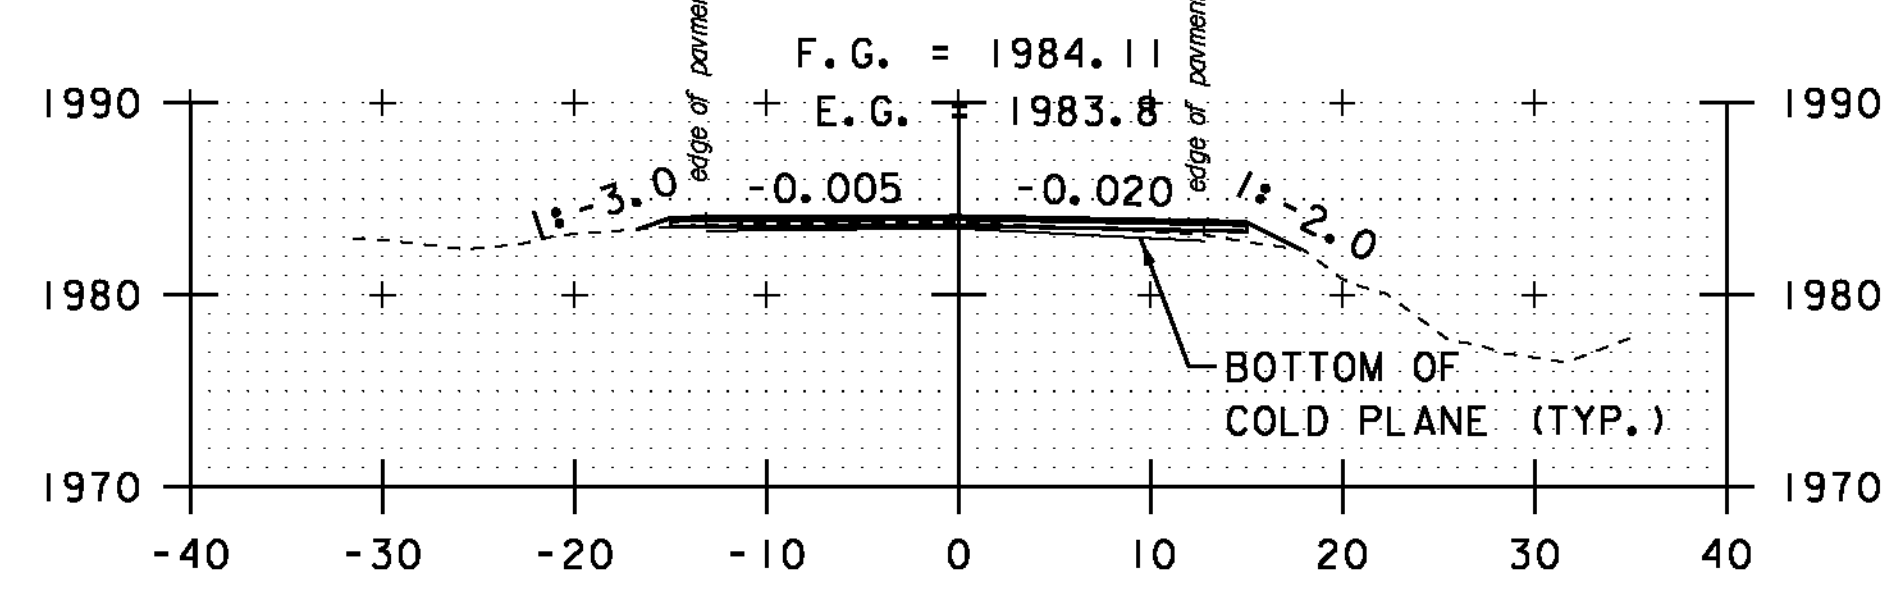


A 117+00

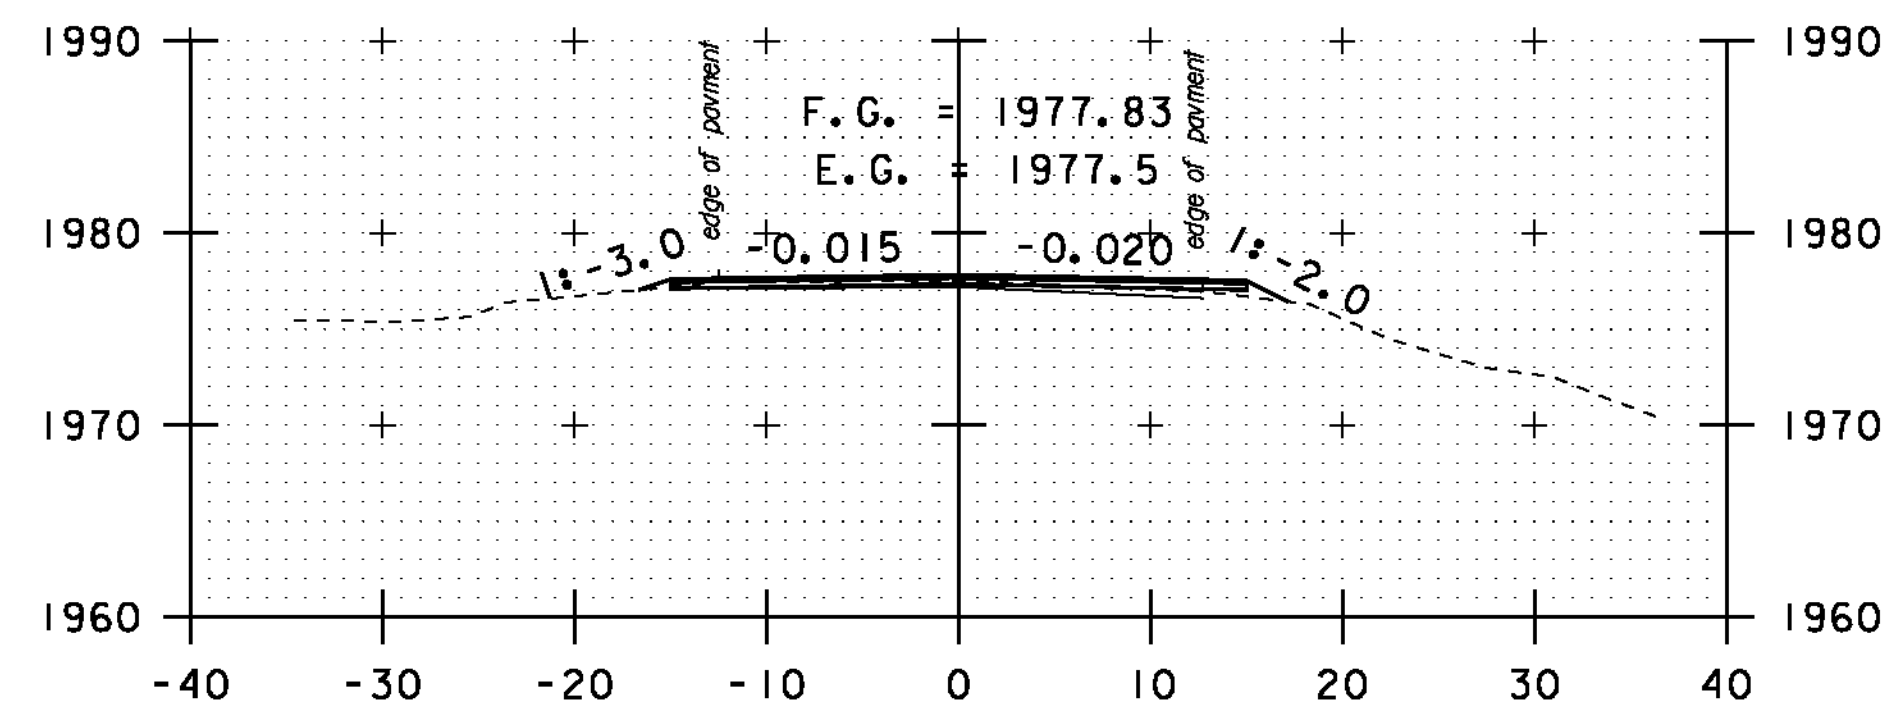


A 116+50

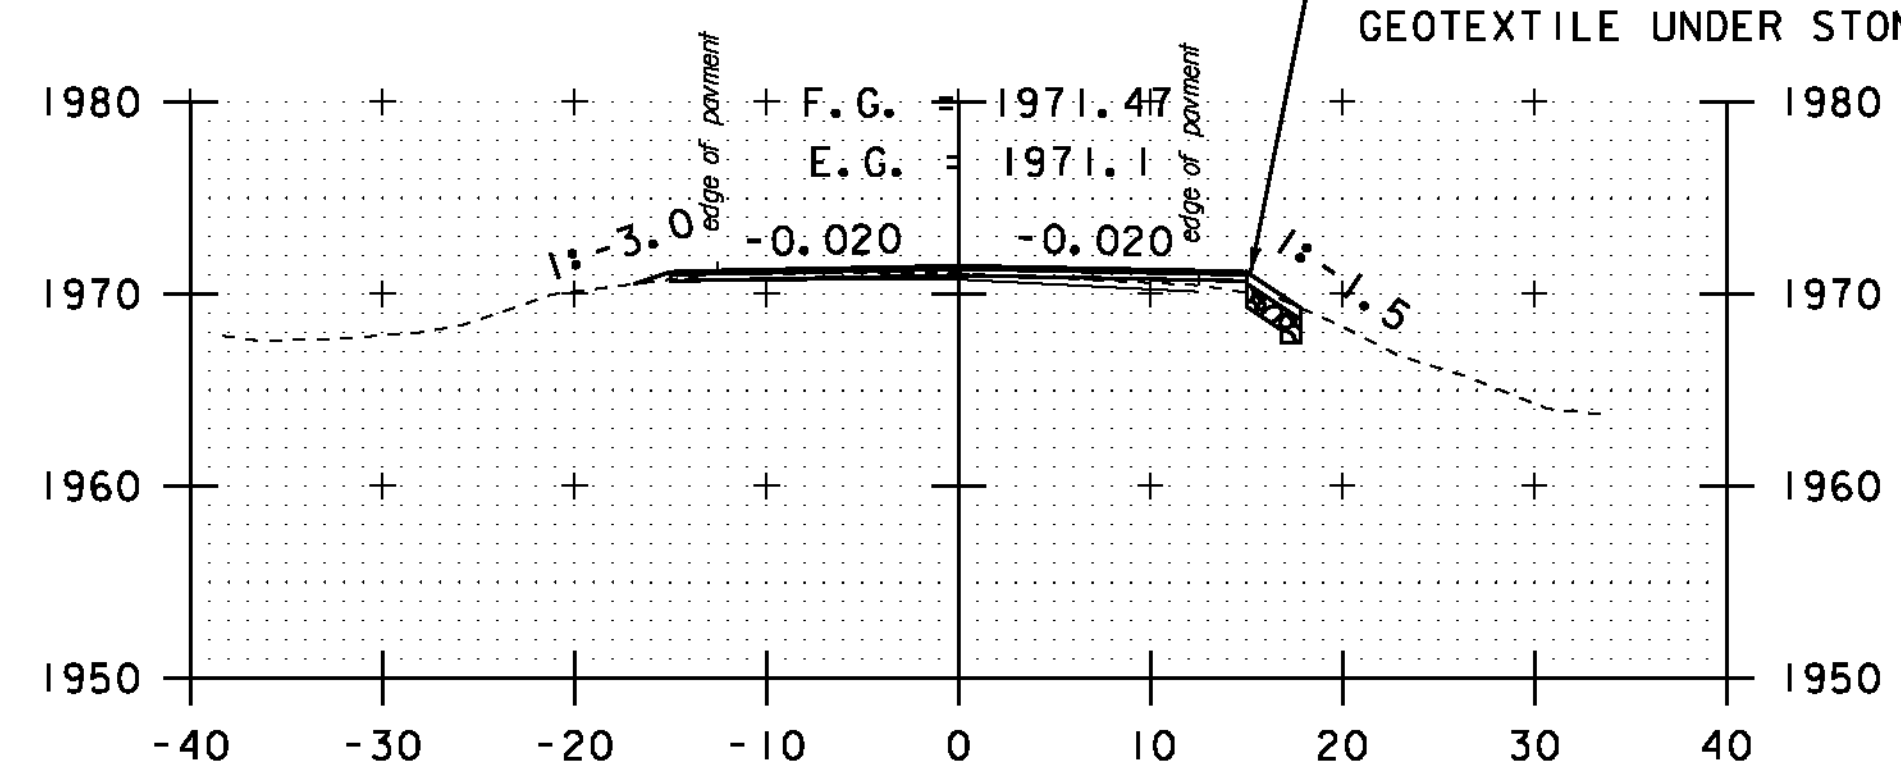


A 116+00

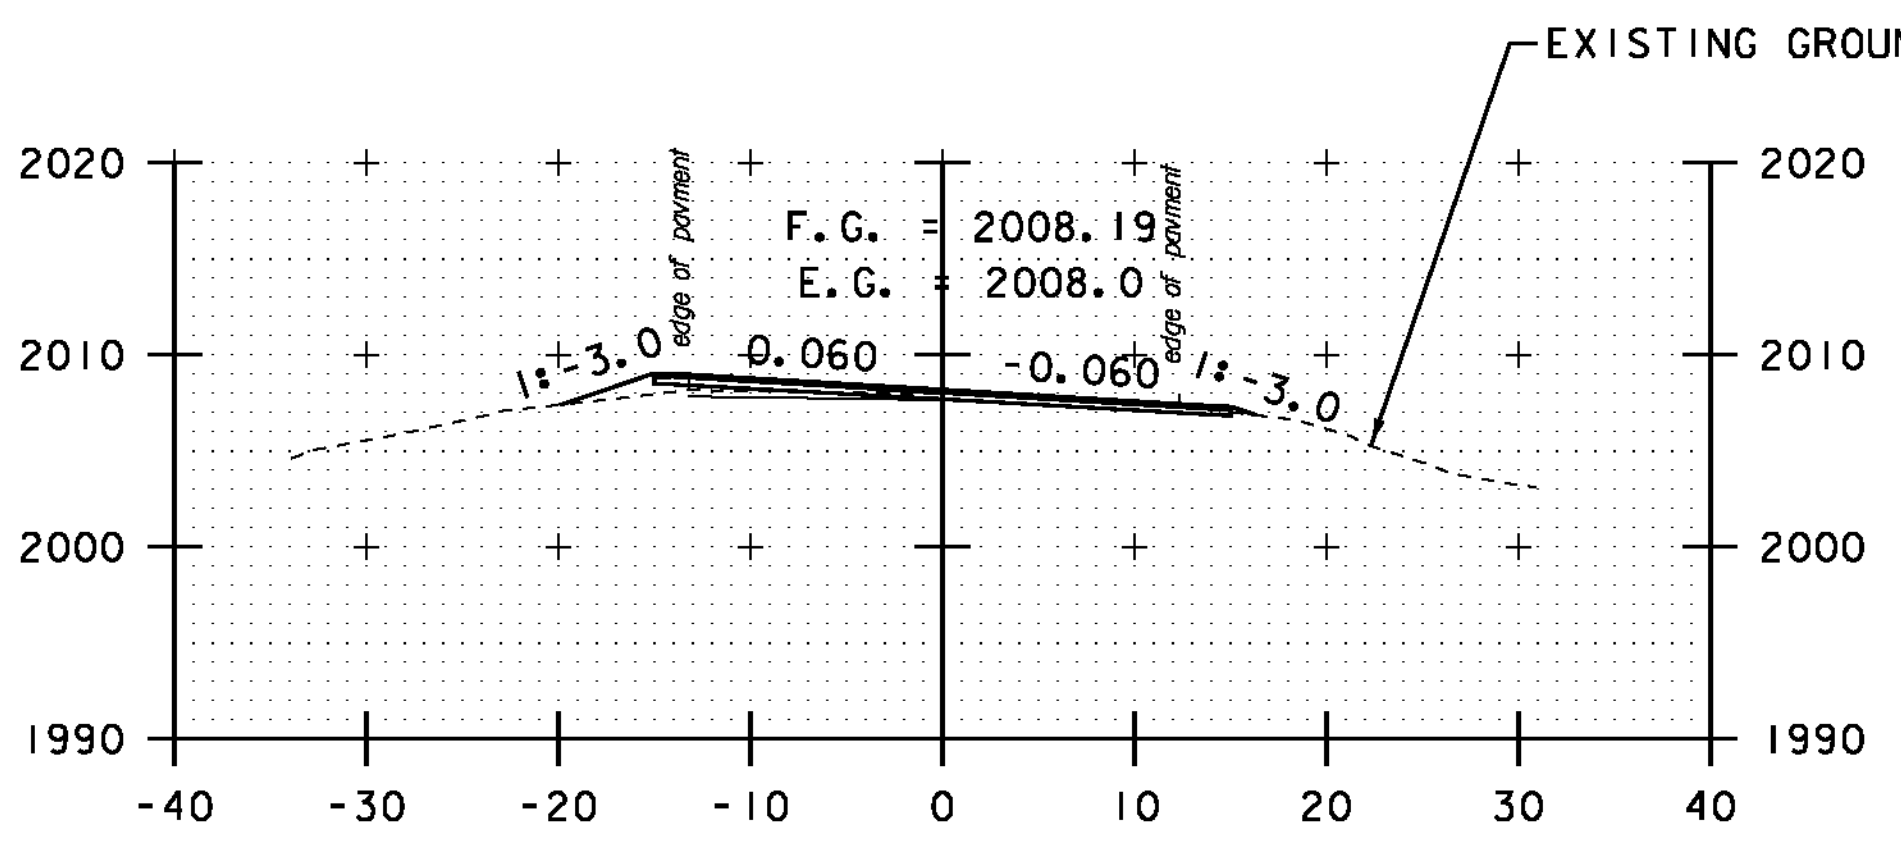


A 119+00

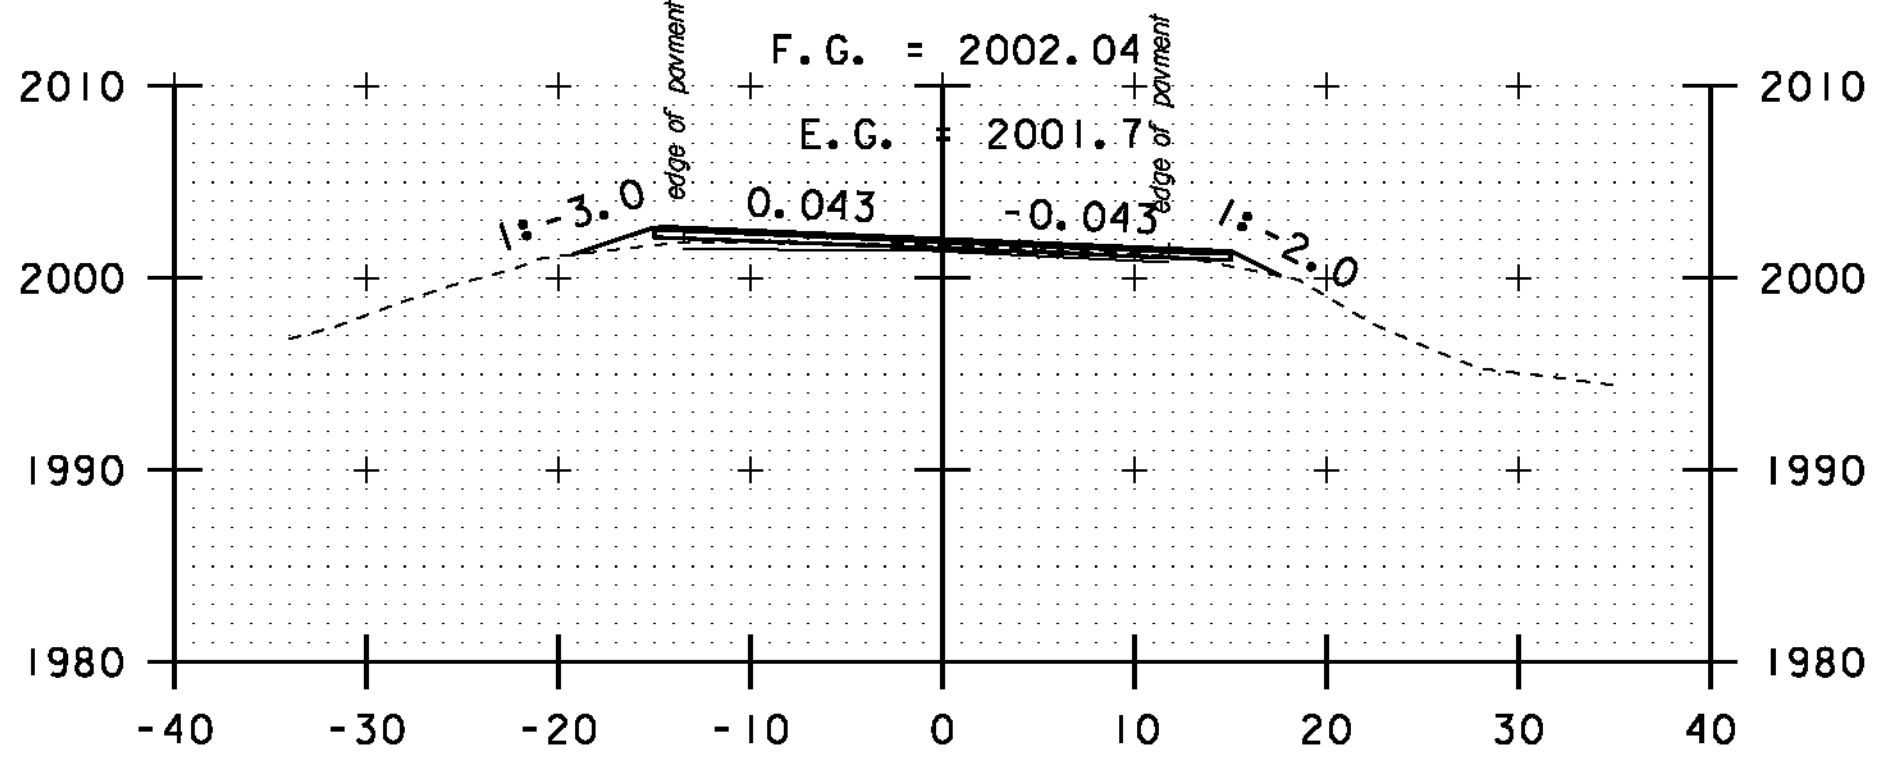


A 118+50

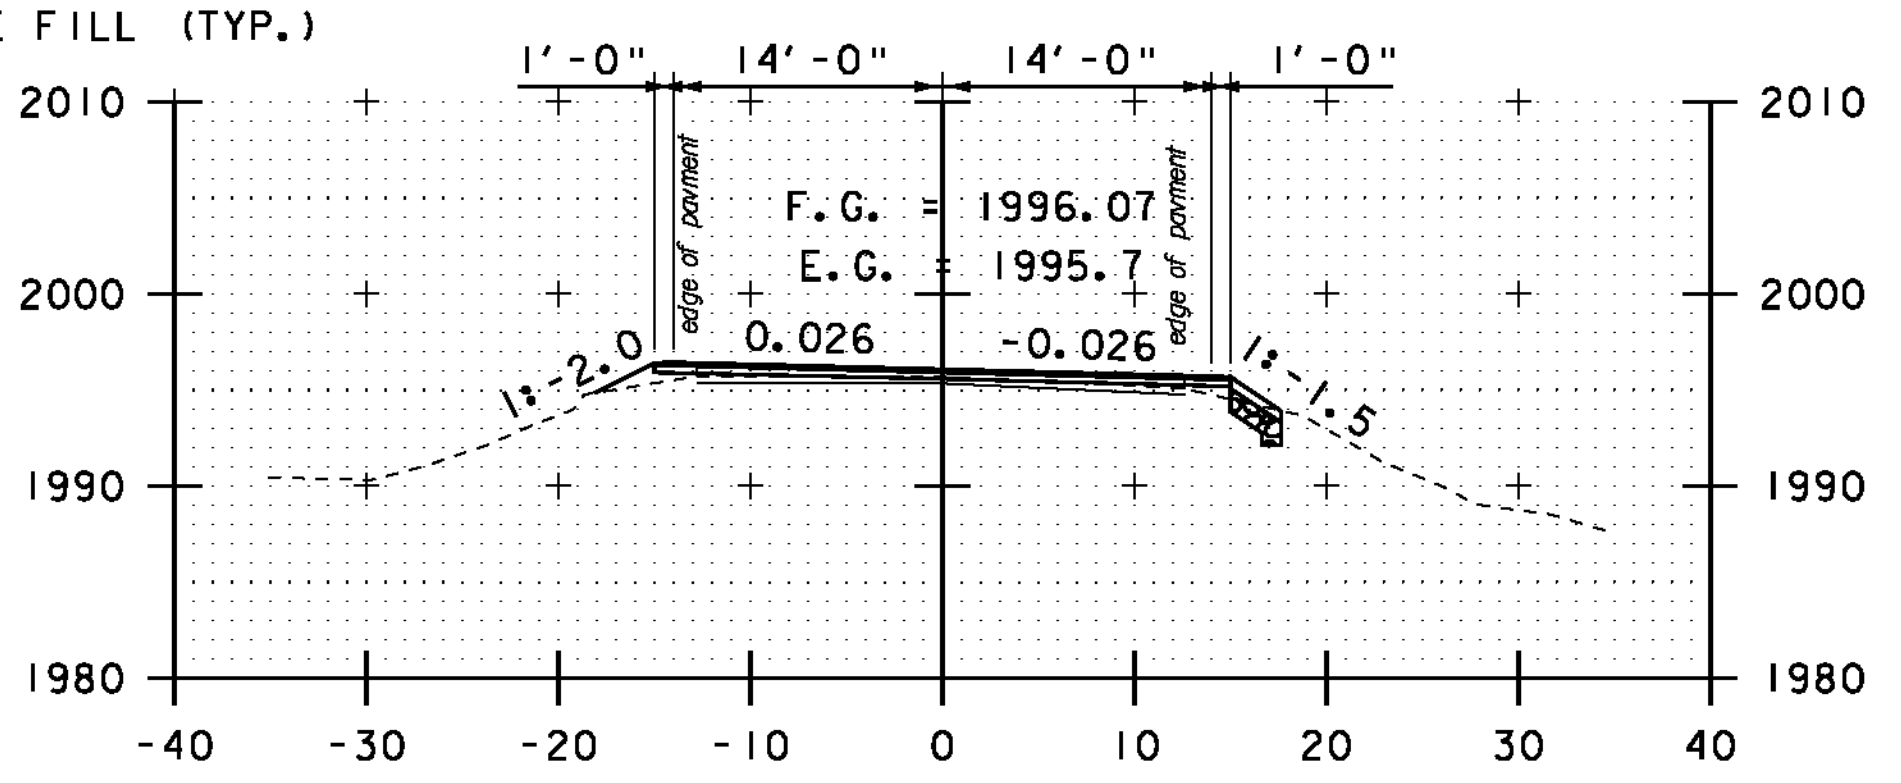


A 118+00

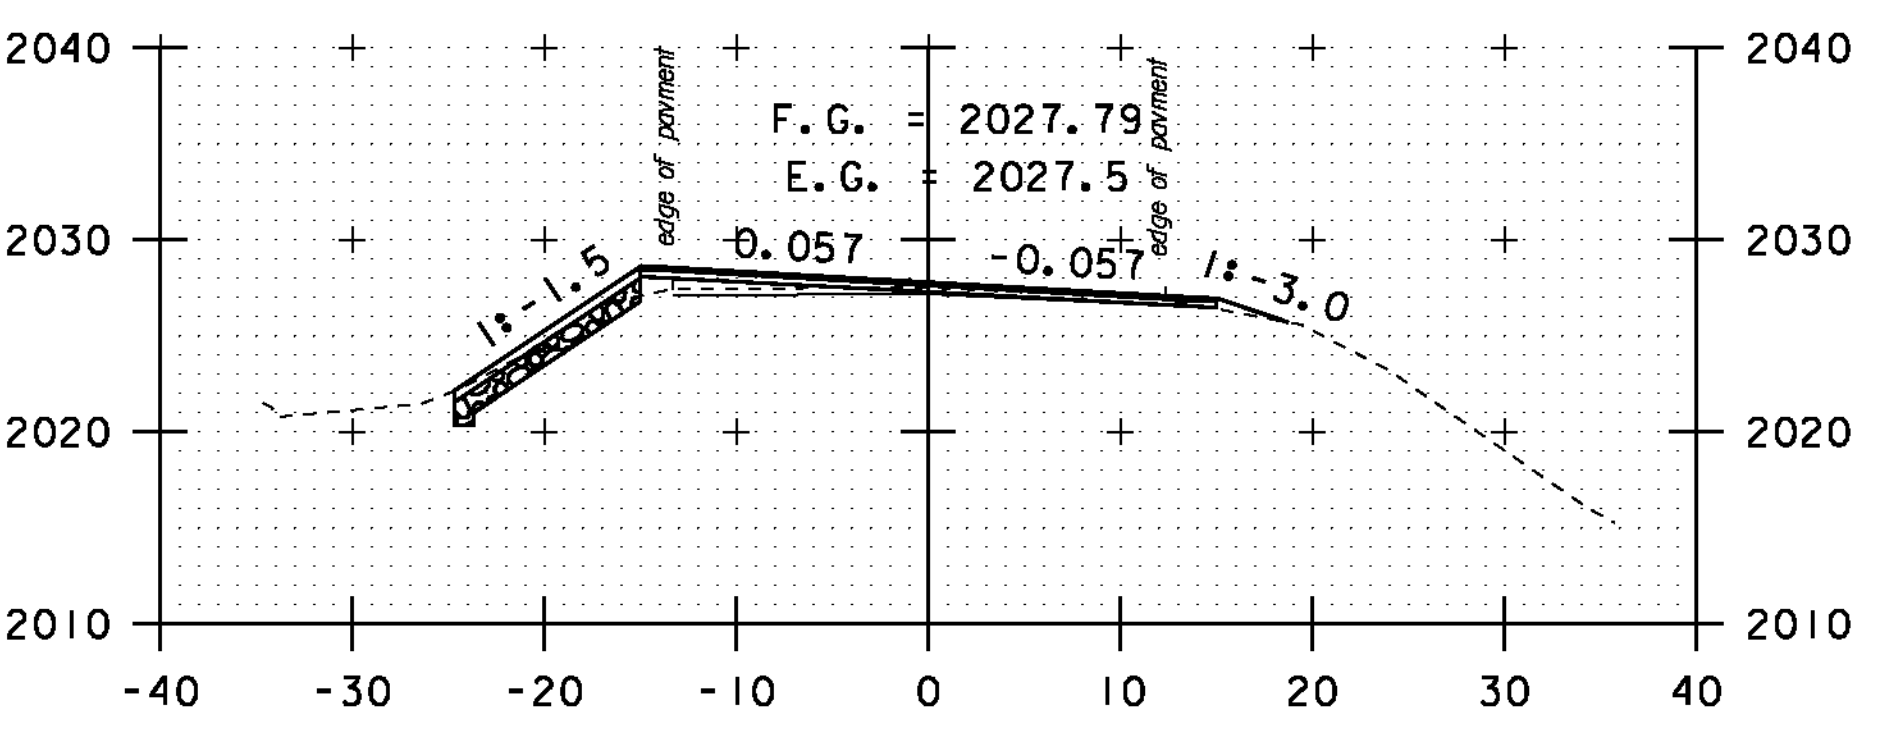

A 120+50

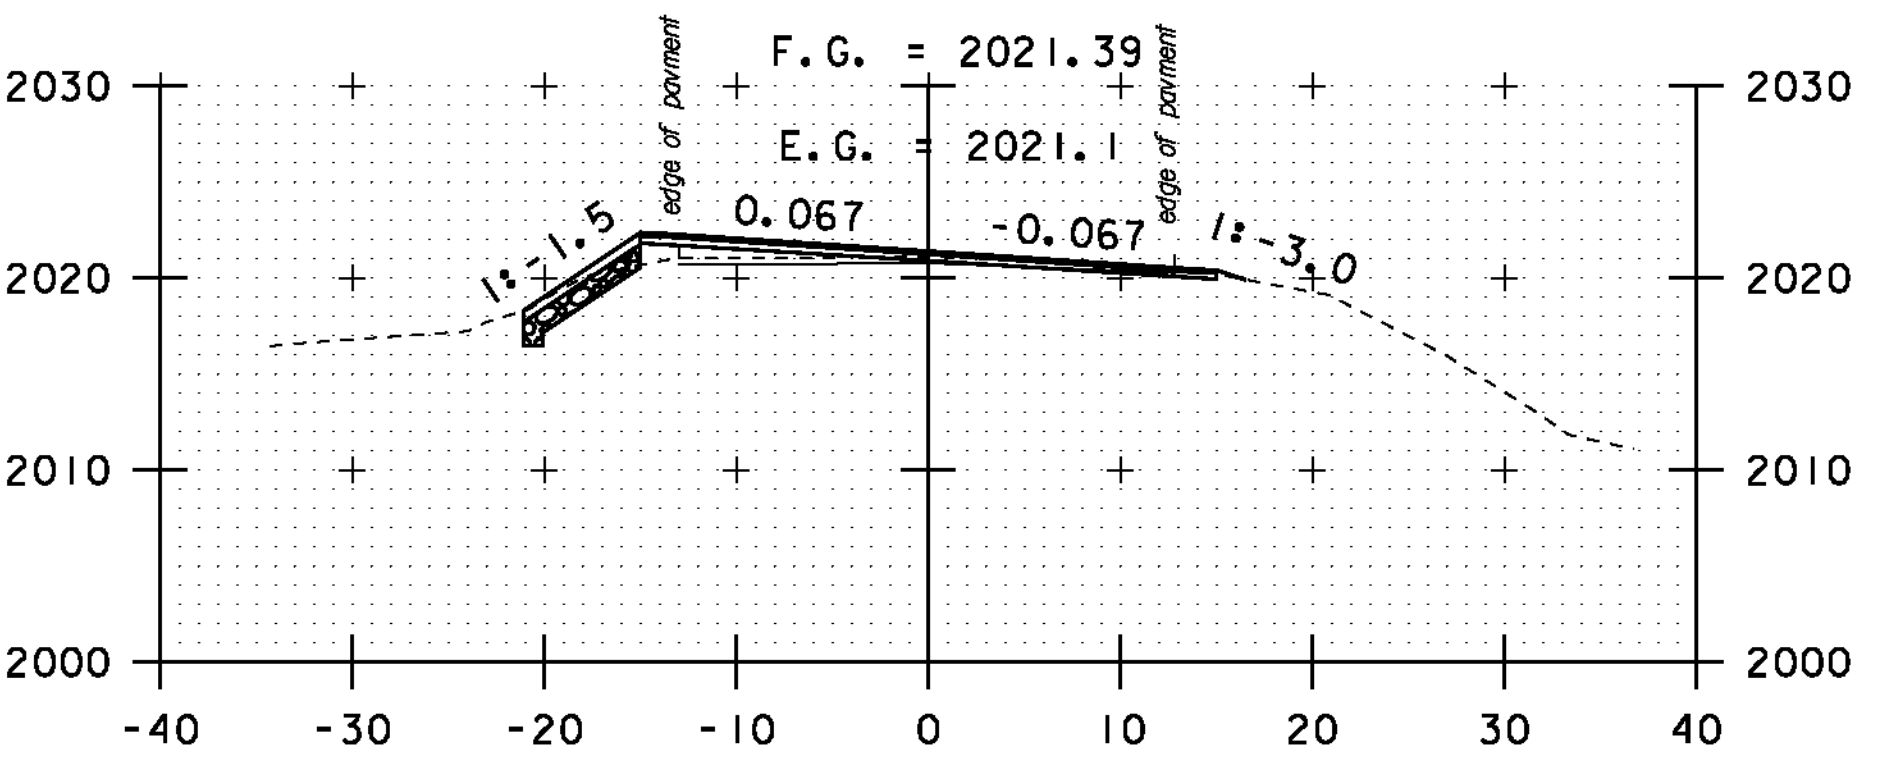


A 120+00

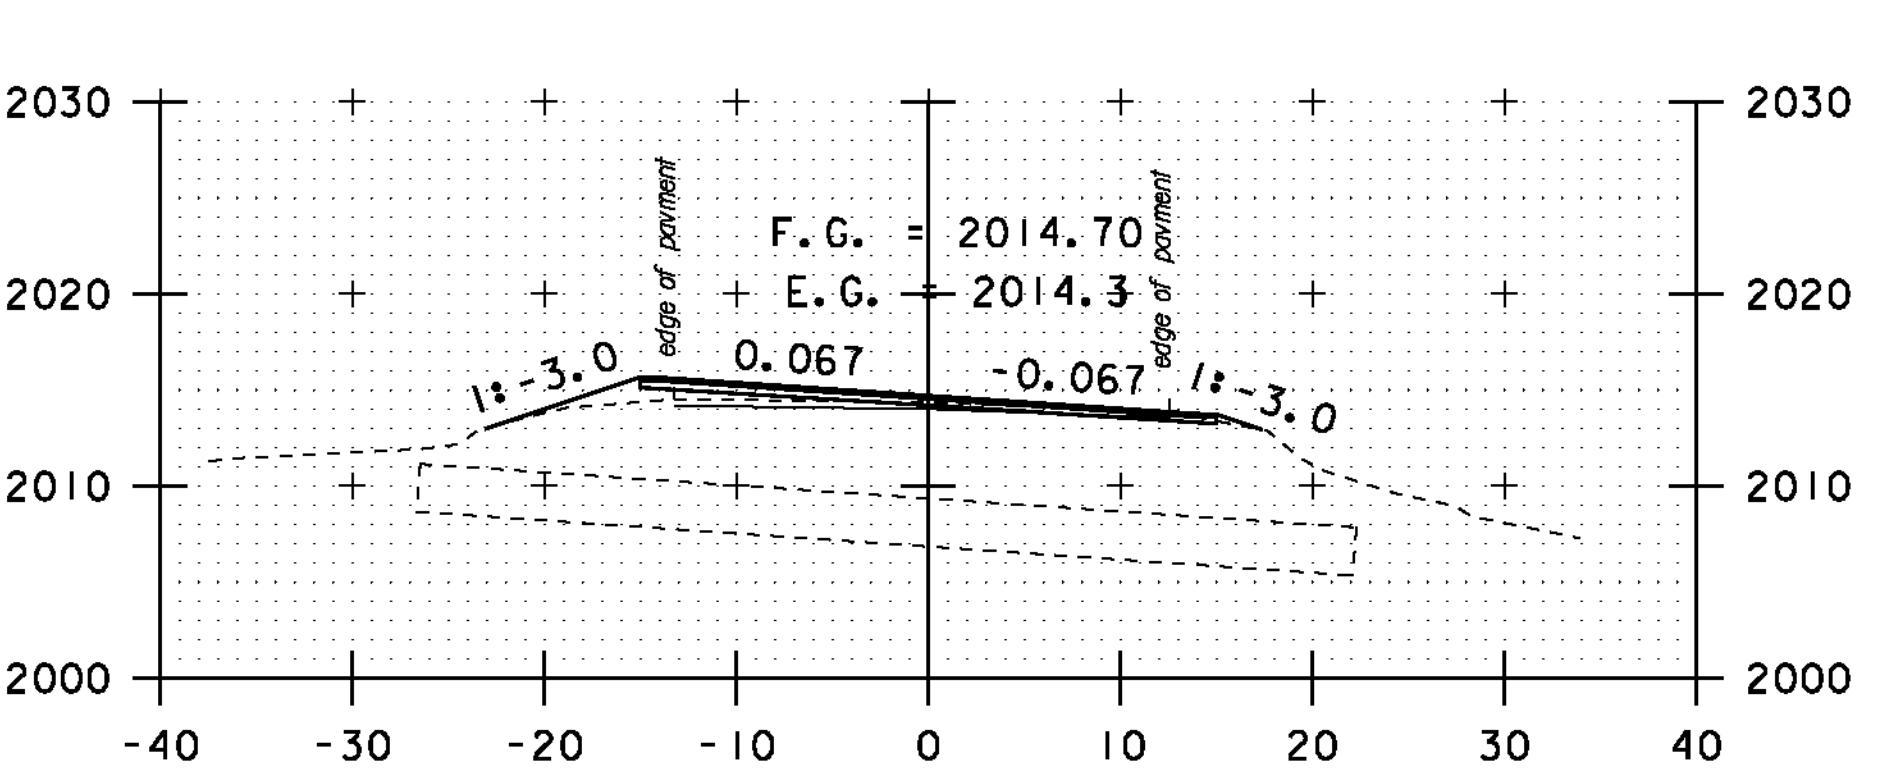

A 119+50

STA. A 116+00 TO STA. A 120+50

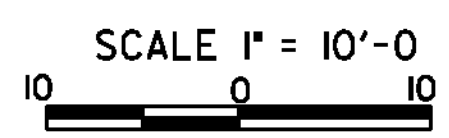

CROSS SECTION SHEET 59	PROJECT NAME: MONTGOMERY-WESTFIELD
	PROJECT NUMBER: STP 2906(I)
	FILE NAME: p10ci90.dgn
	PLOT FILE: p10ci90_173.1
	PLOT DATE: 9/5/12
	DRAWN BY: SJL
	CHECKED BY: CDL
	SHEET 173 OF 178