




A 126+50

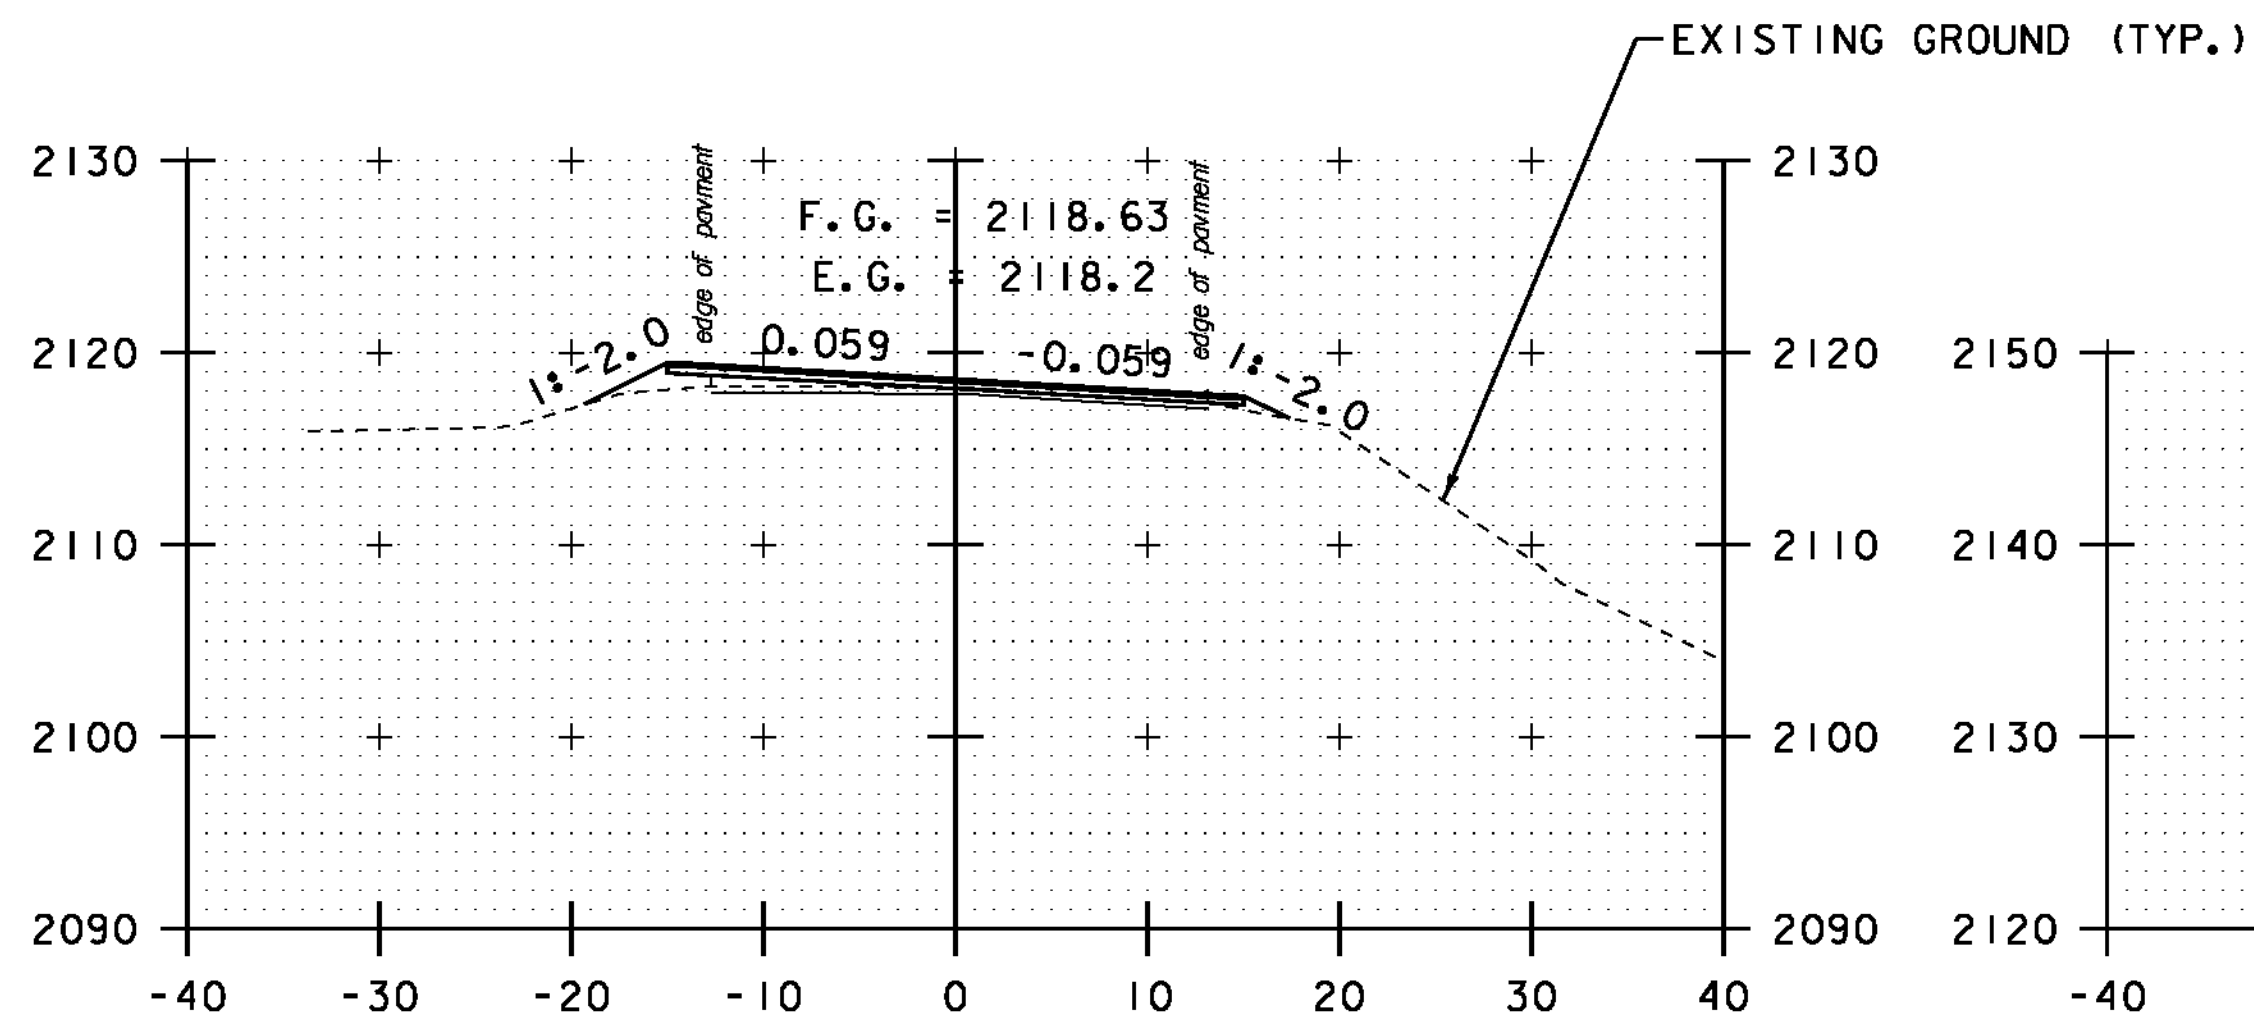


A 128+00

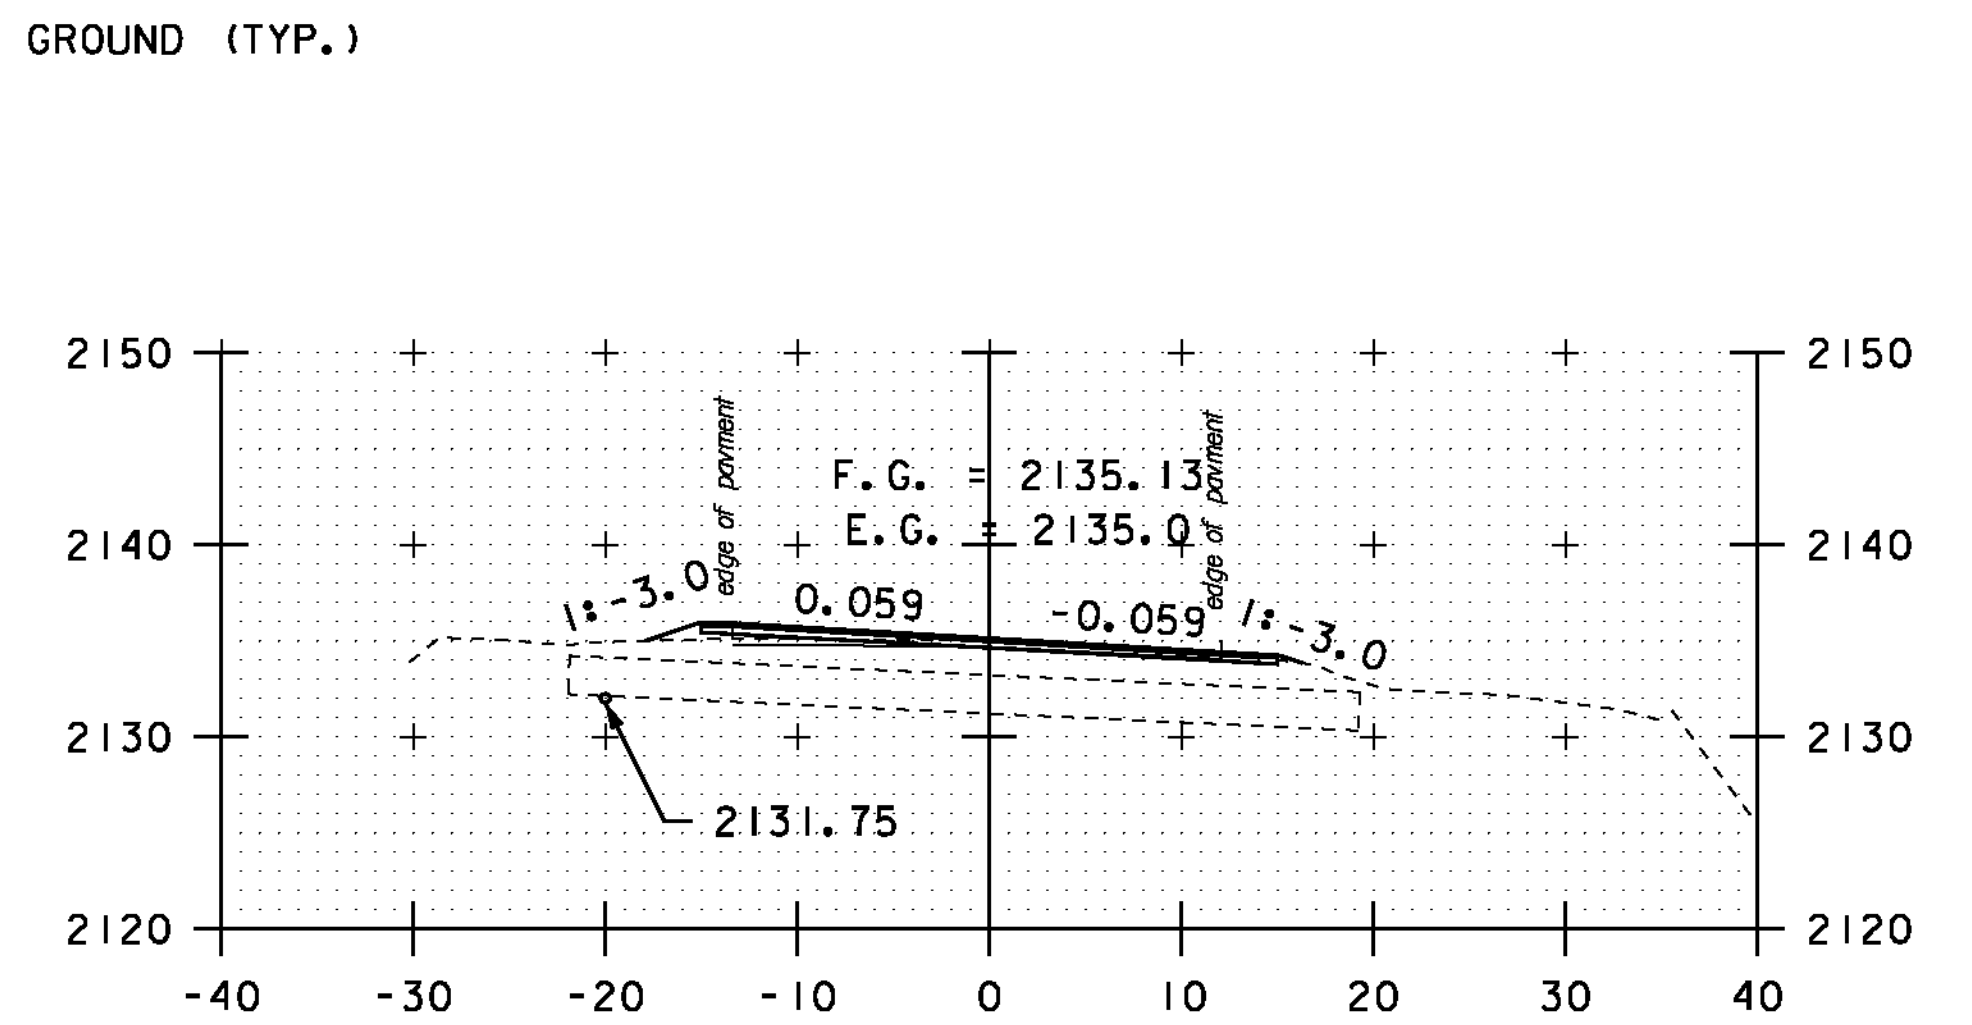


A 129+50

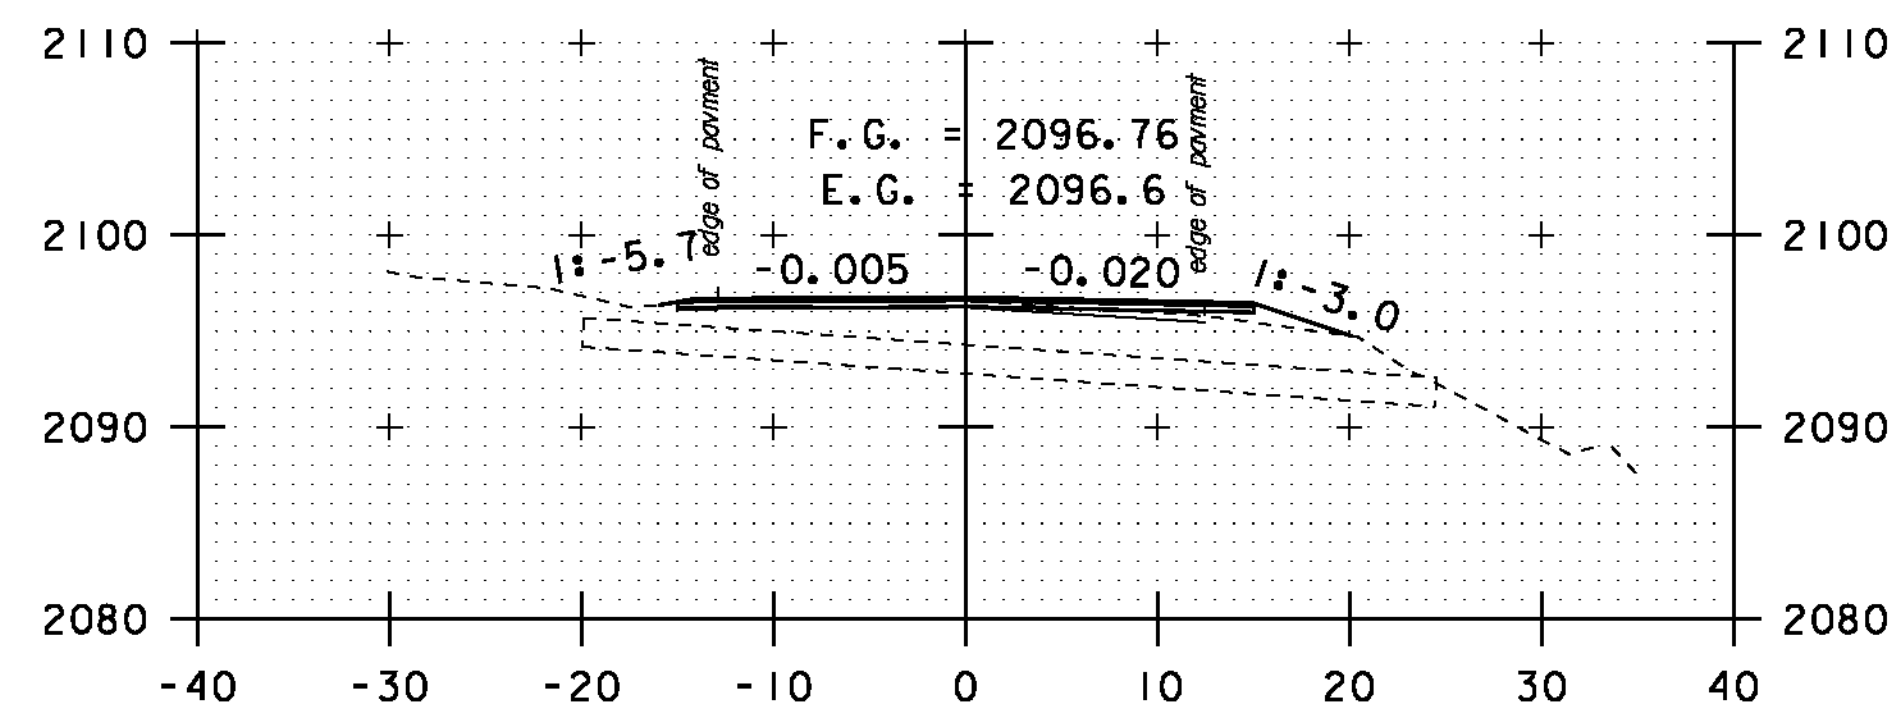


DRIVE LT
A 126+00

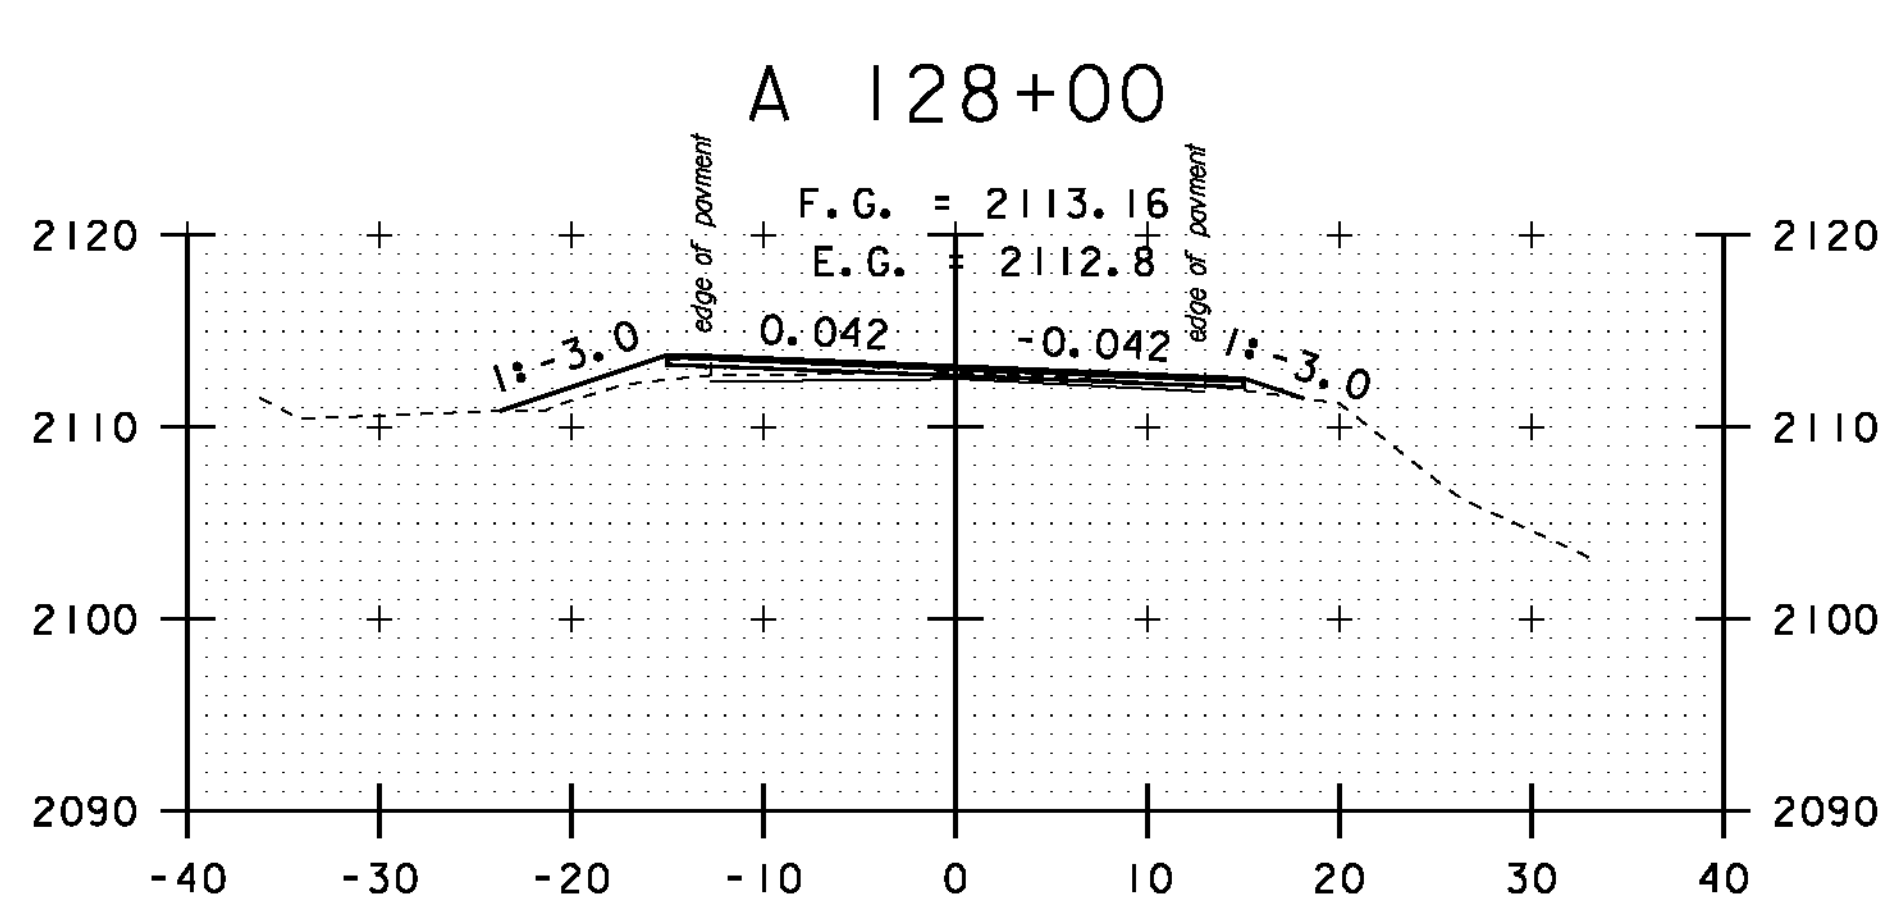


A 127+50

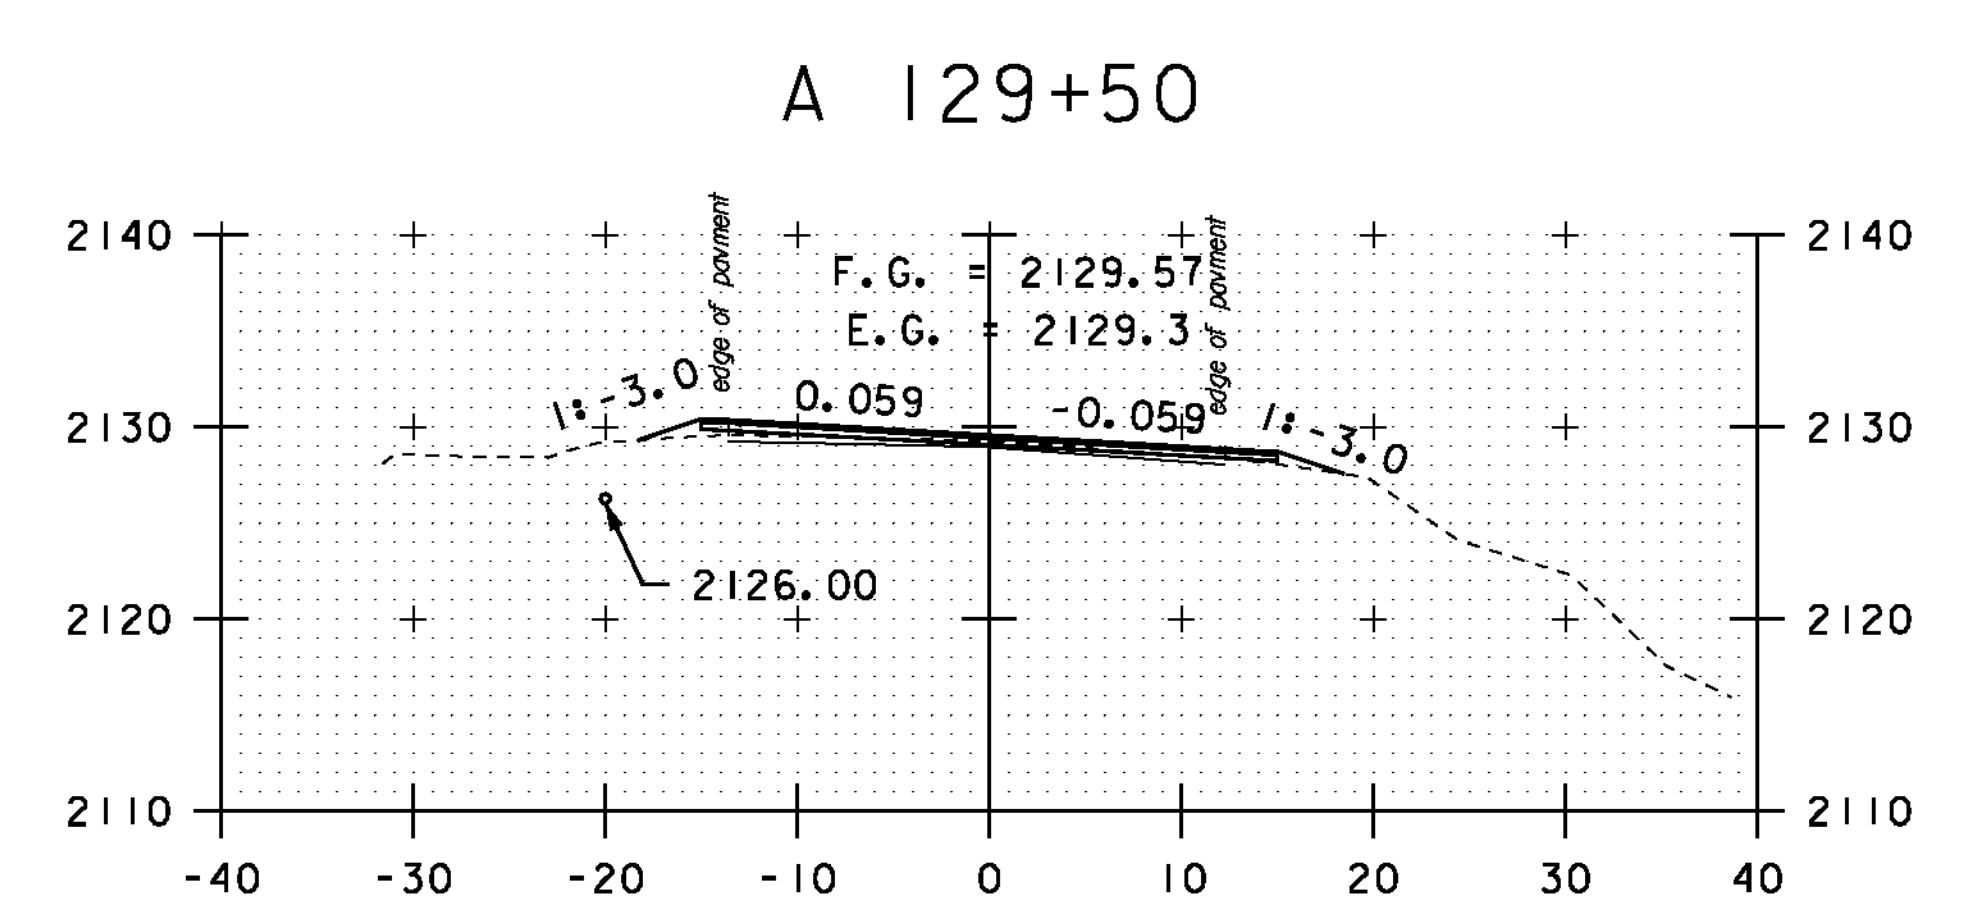


A 129+00

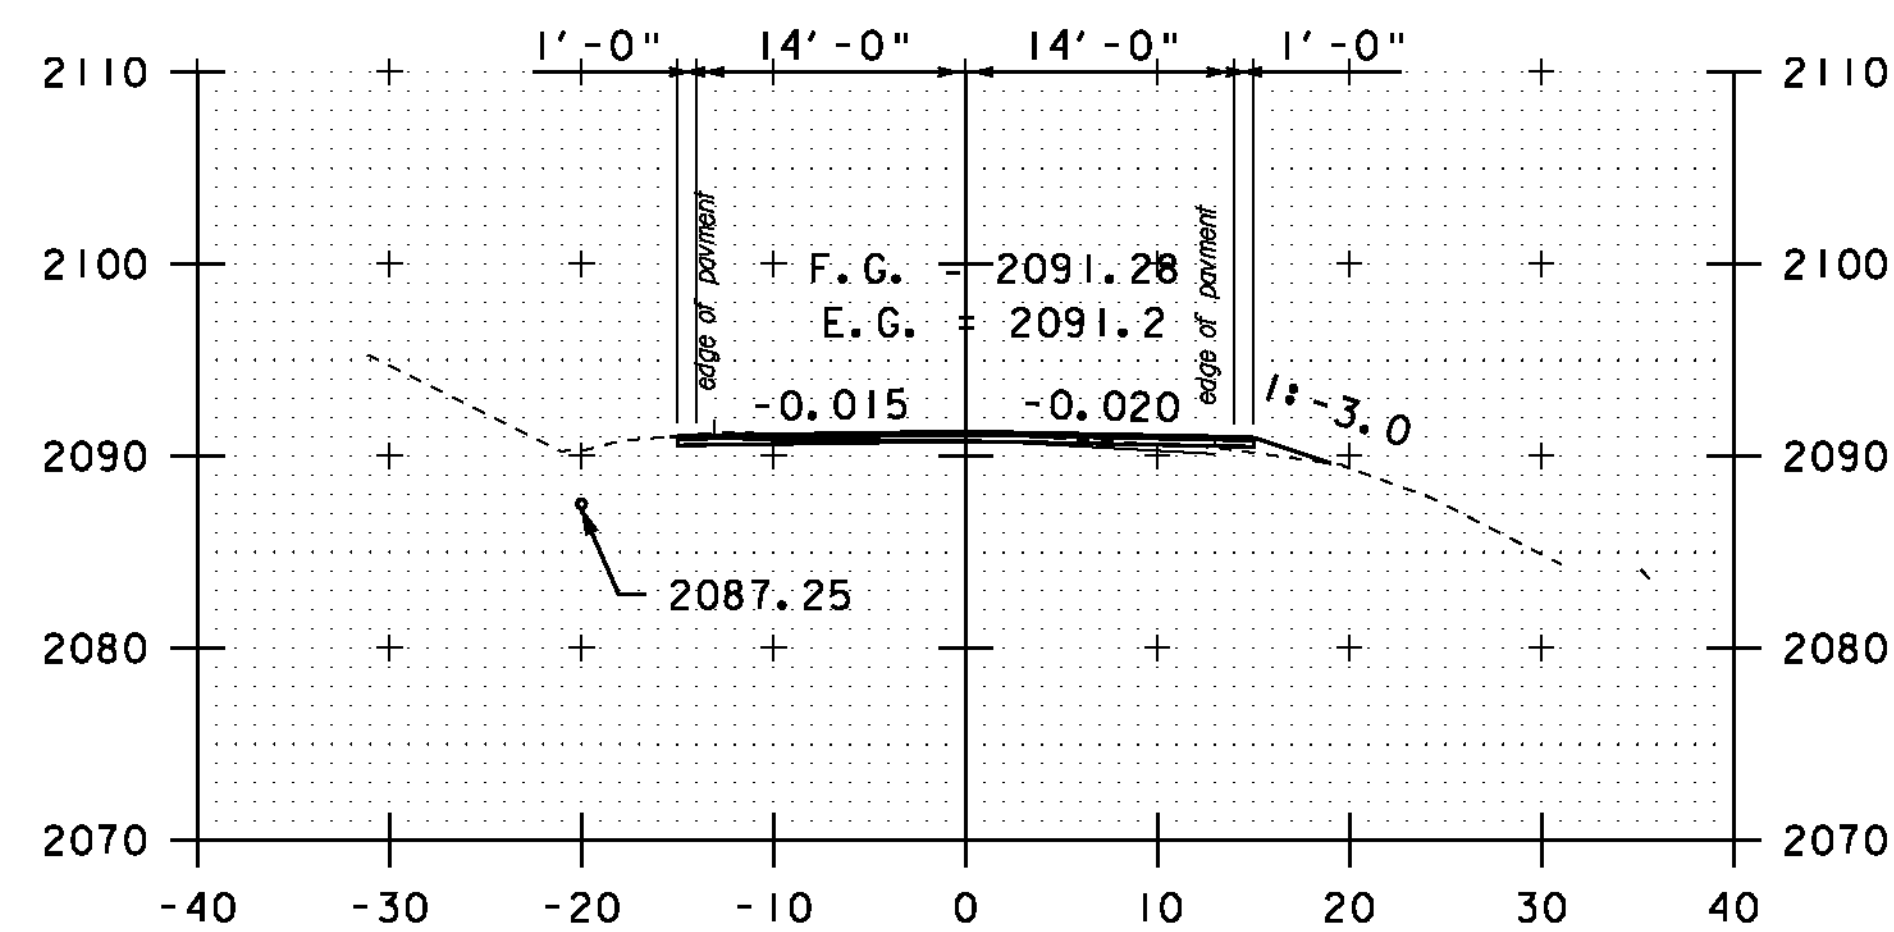

A 125+50

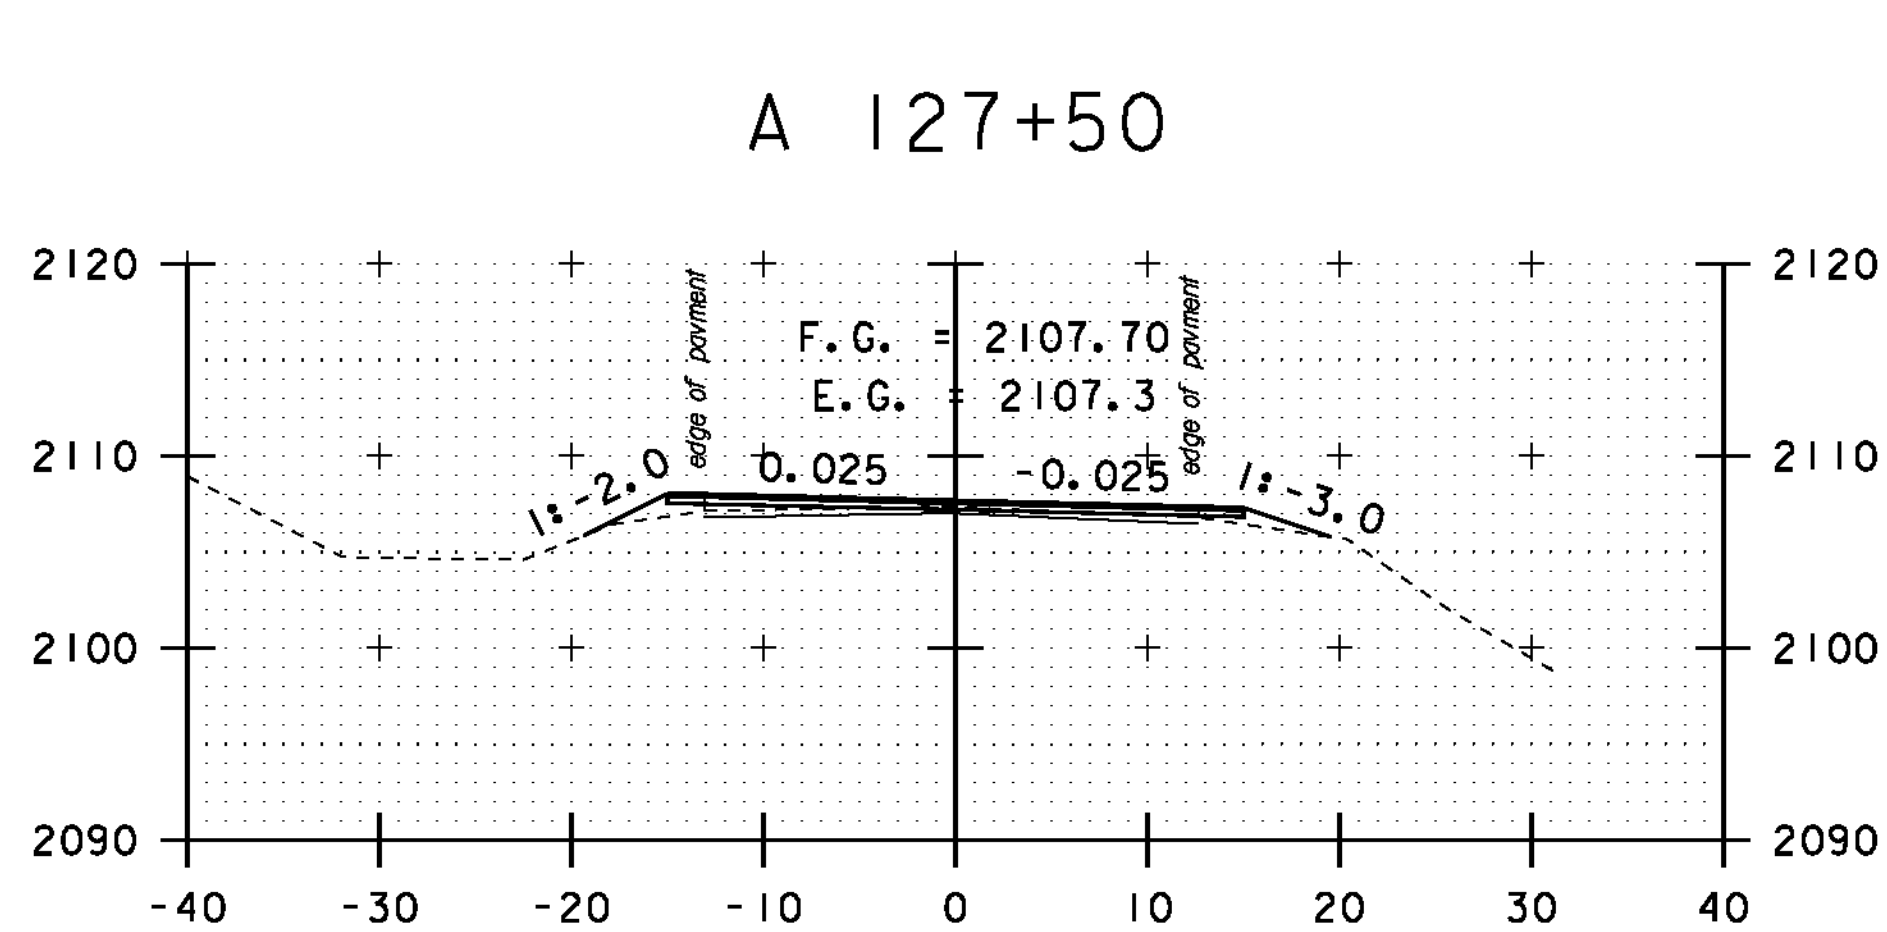

A 127+00

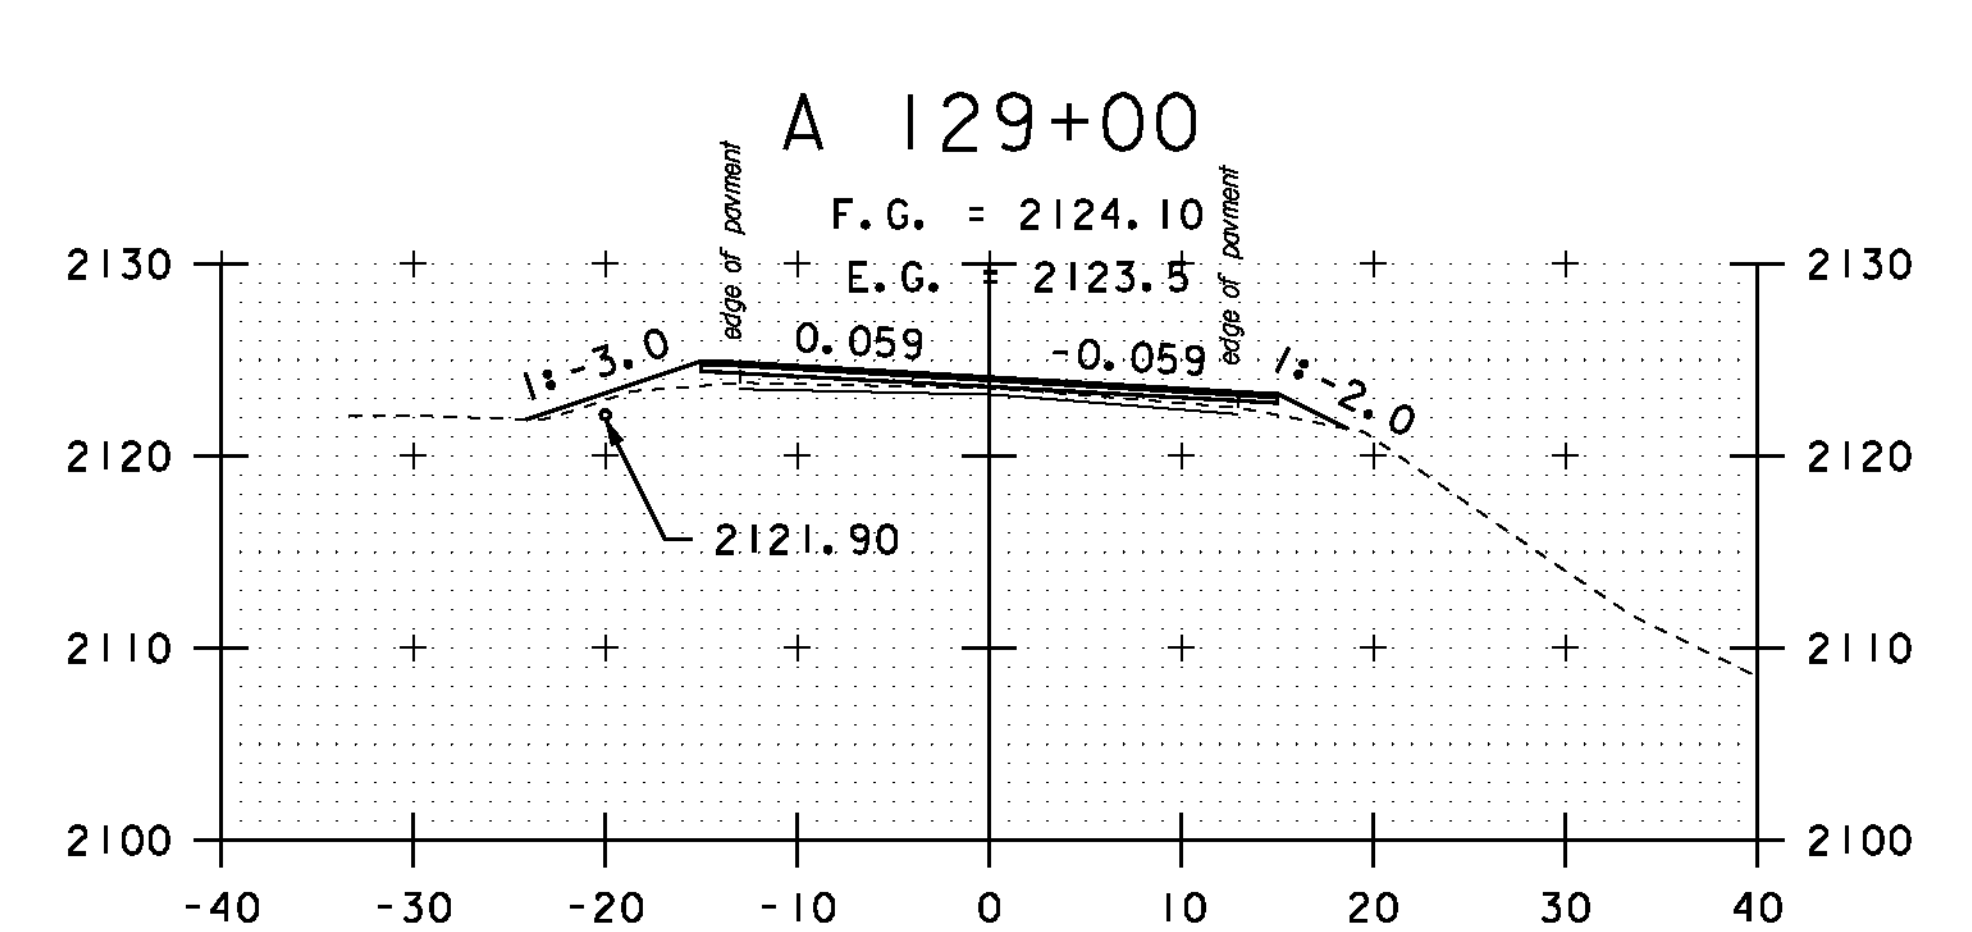

A 128+50

STA. A 125+50 TO STA. A 129+50



CROSS SECTION SHEET 61

PROJECT NAME: MONTGOMERY-WESTFIELD
 PROJECT NUMBER: STP 2906(I)
 FILE NAME: p10CI90.dgn
 PROJECT LEADER: CDL
 DESIGNED BY: SJL
 PLOT FILE: p10CI90_175.I

PLOT DATE: 9/5/12
 DRAWN BY: SJL
 CHECKED BY: CDL
 SHEET 175 OF 178