




A 131+50

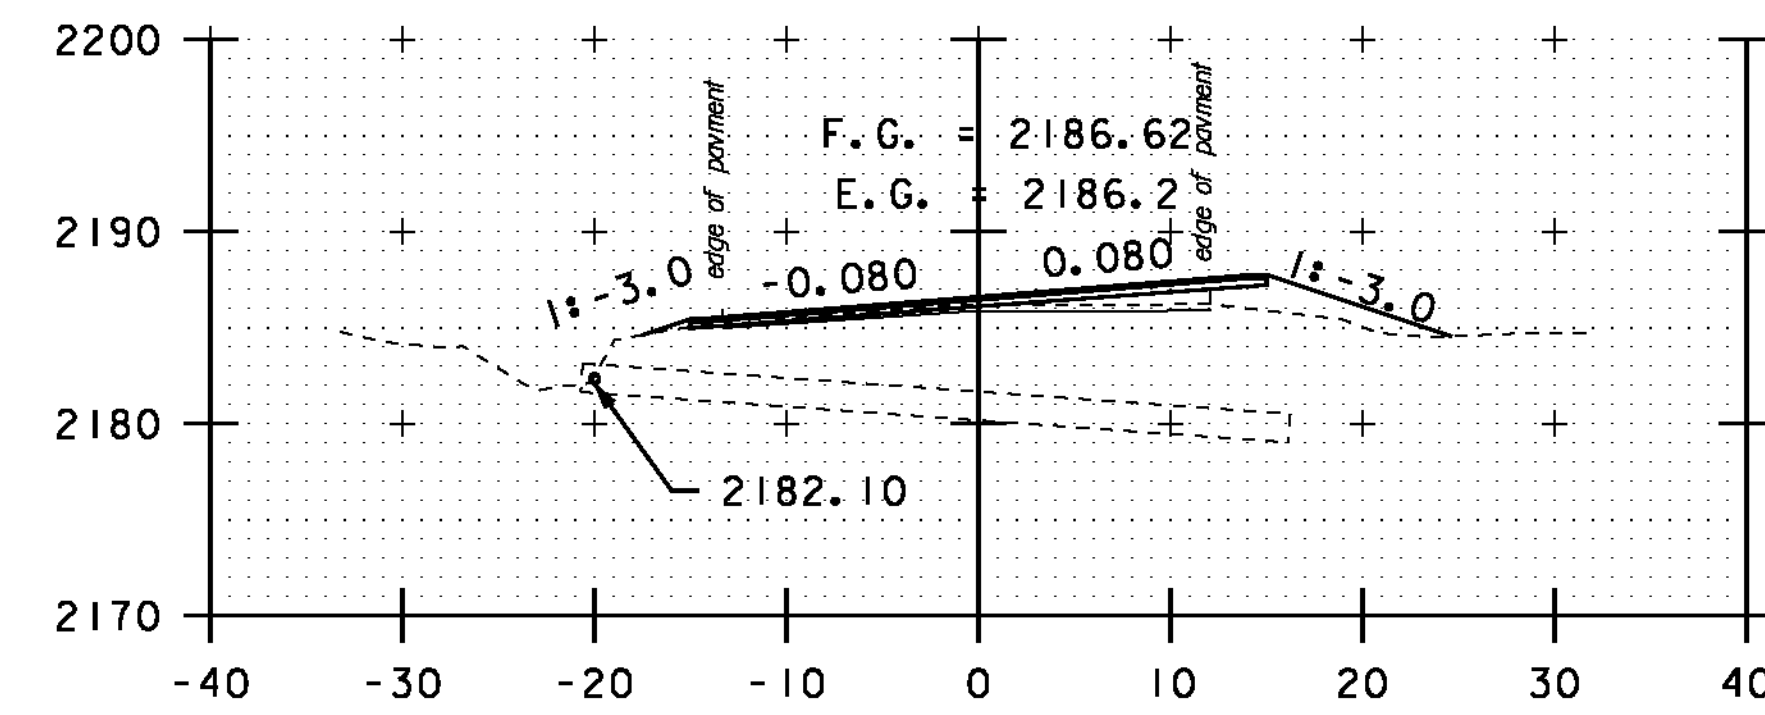


A 133+50

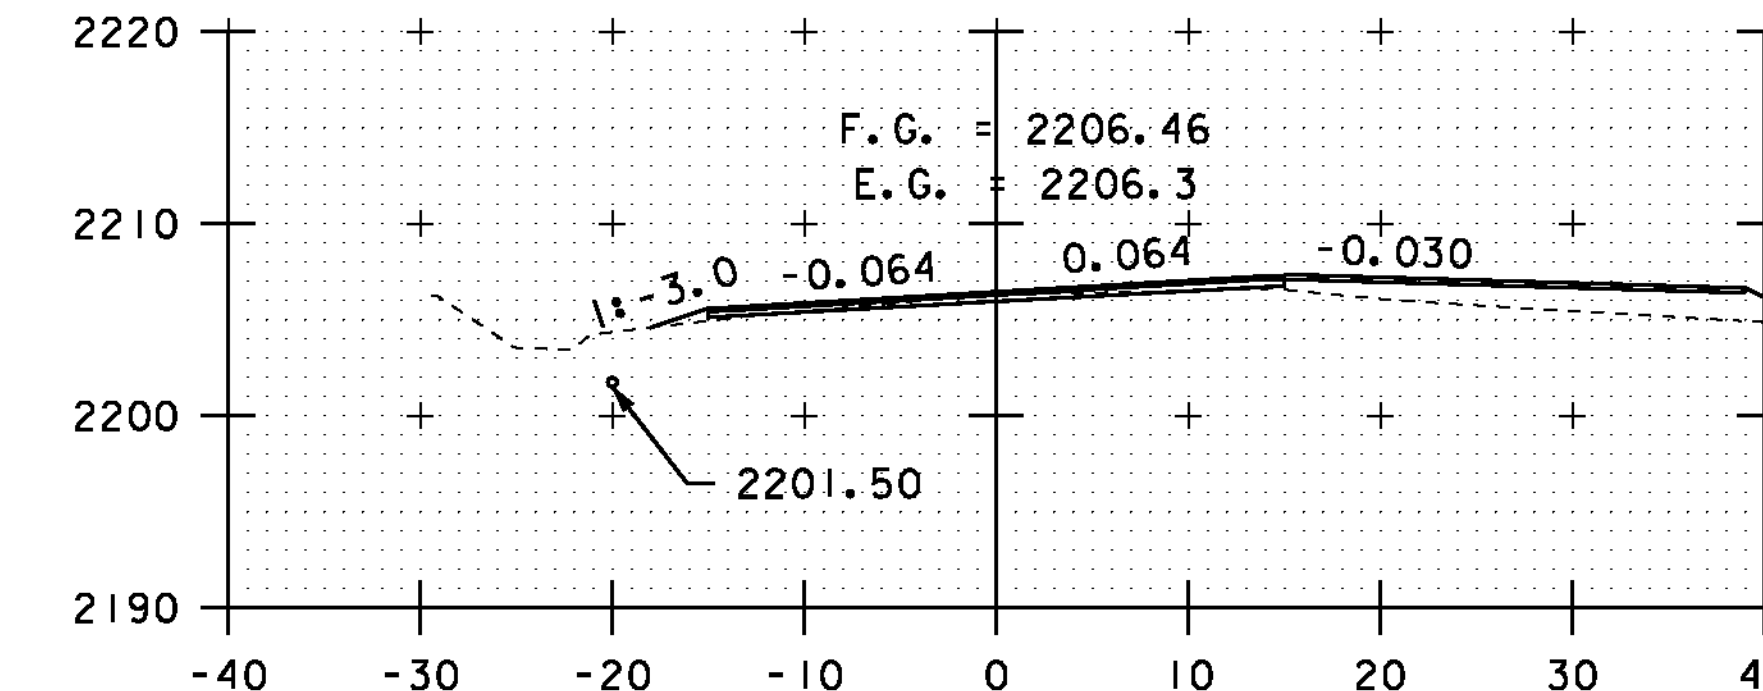


PULL OFF RT  
A 135+50

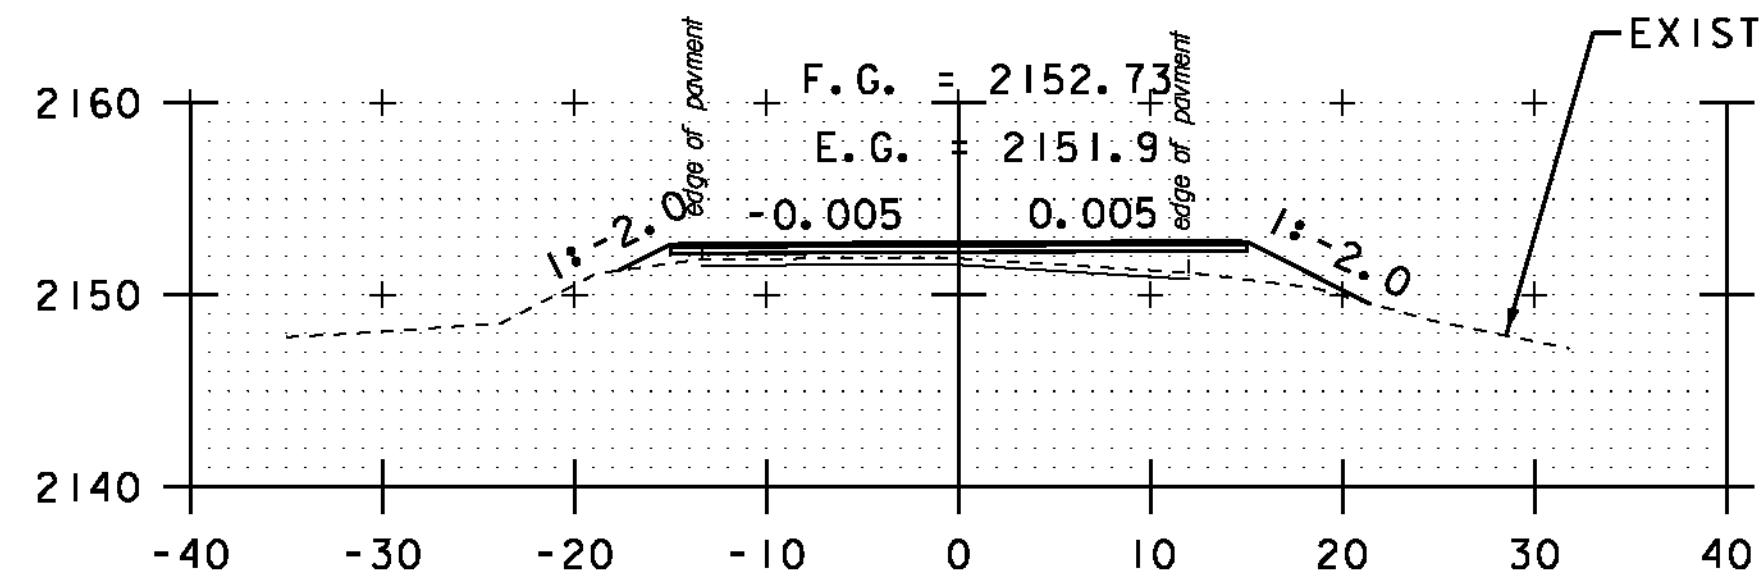


A 131+00

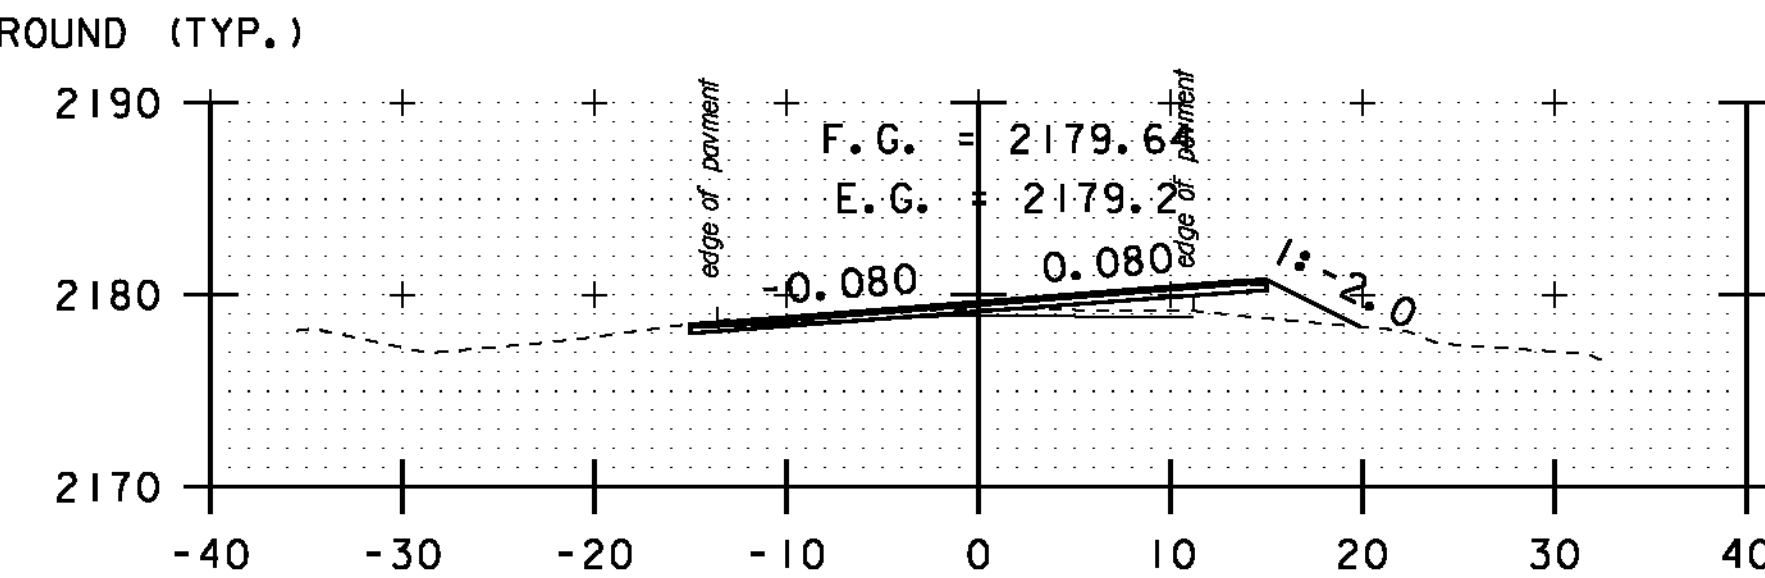


A 133+00

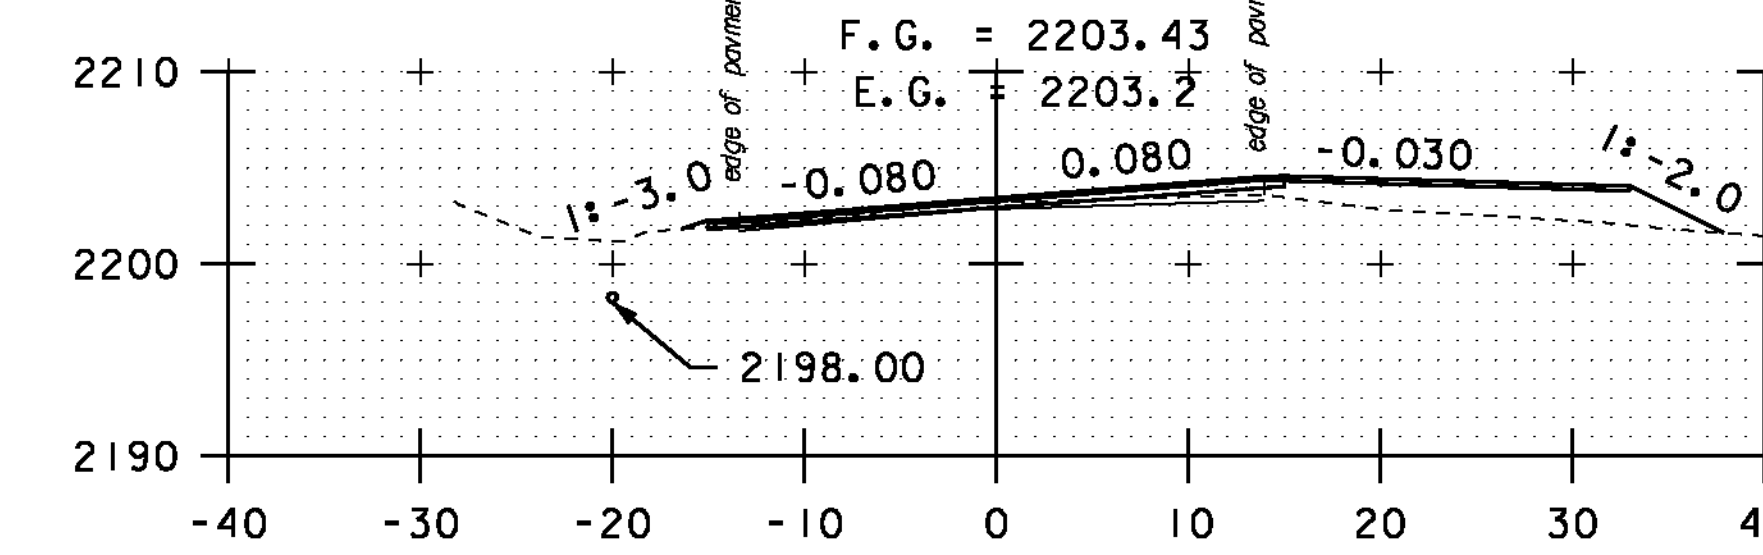


PULL OFF RT  
A 135+00

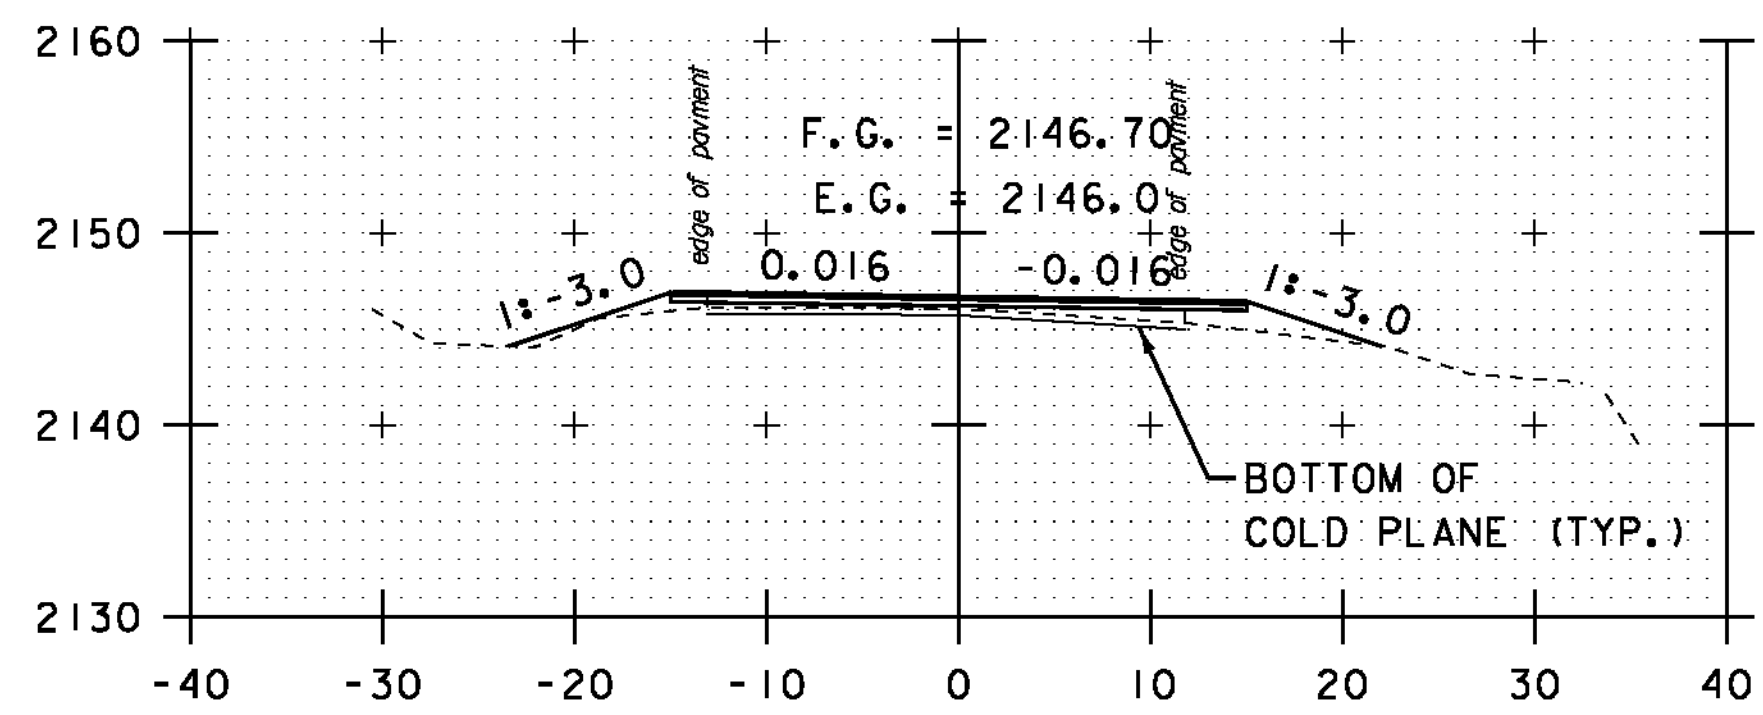


A 130+50

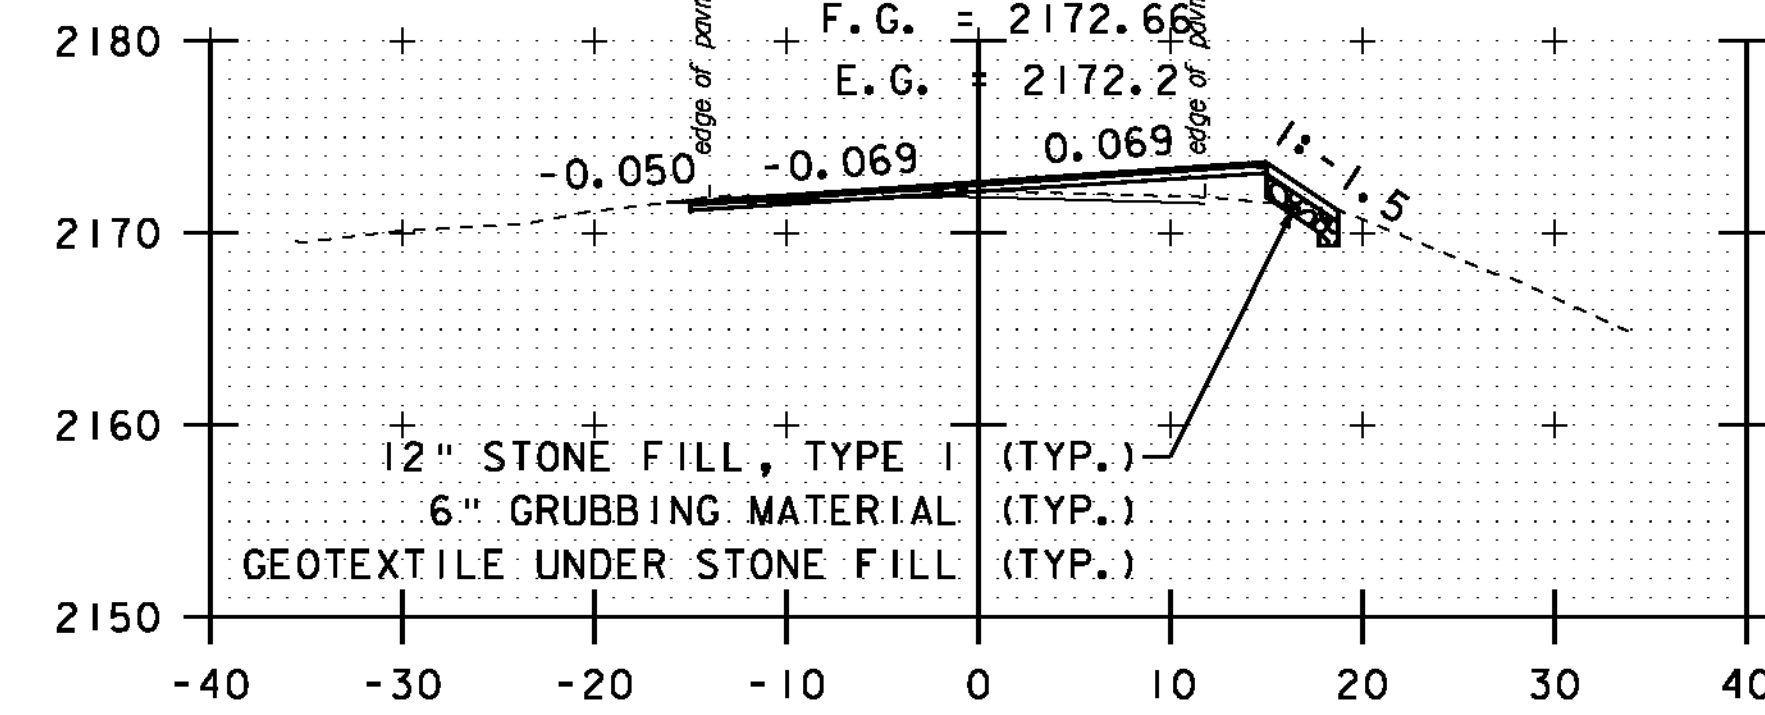


A 132+50

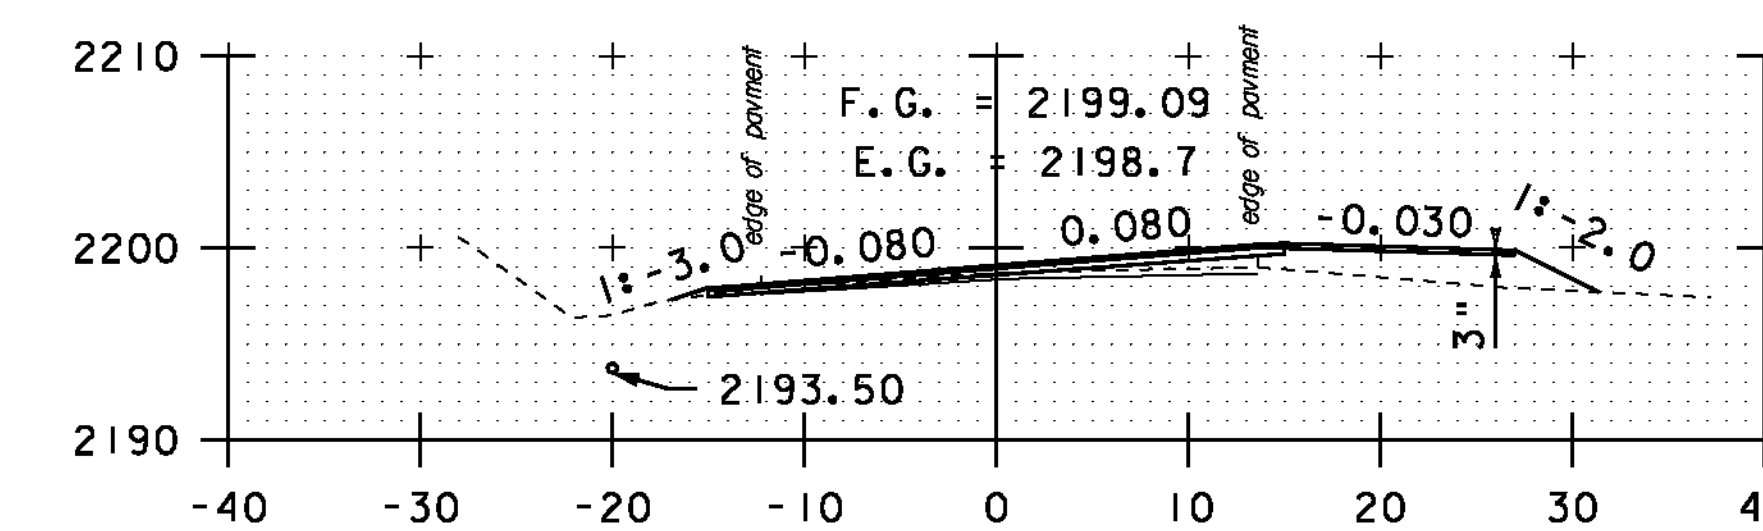


PULL OFF RT  
A 134+50

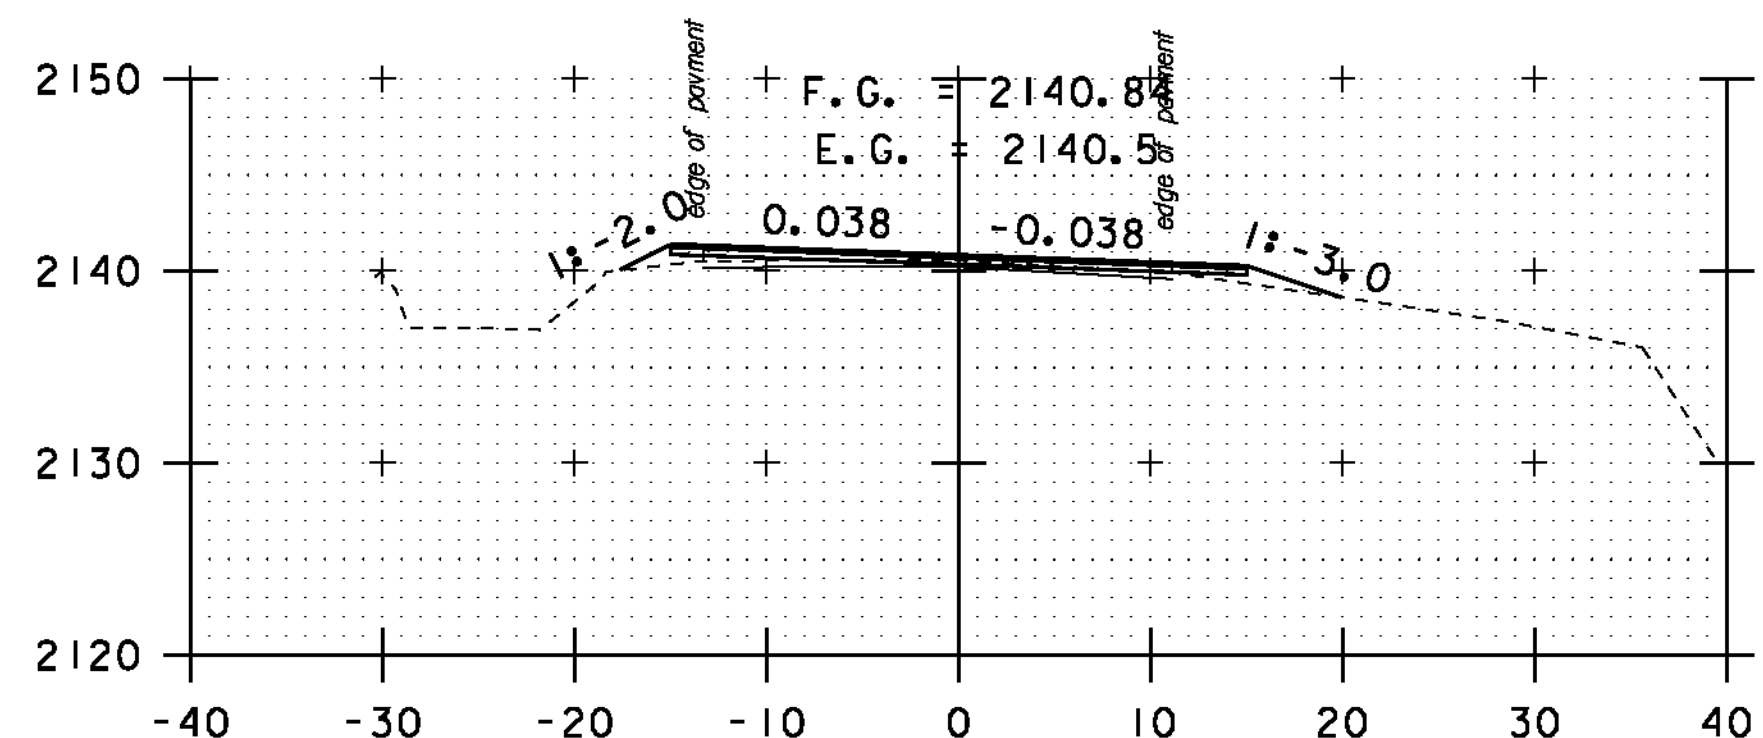

A 130+00

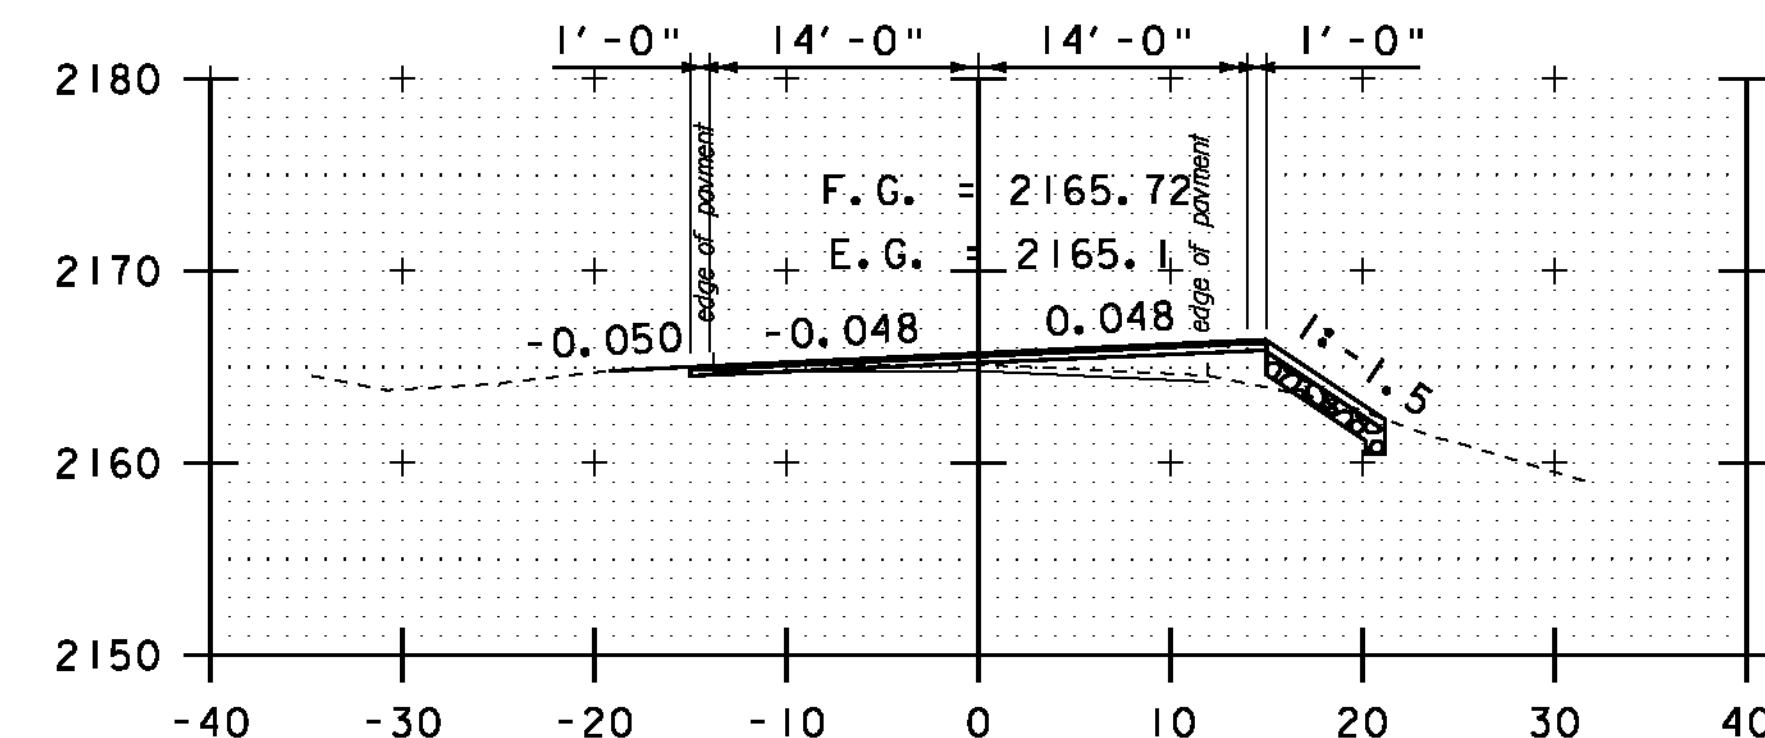


A 132+00

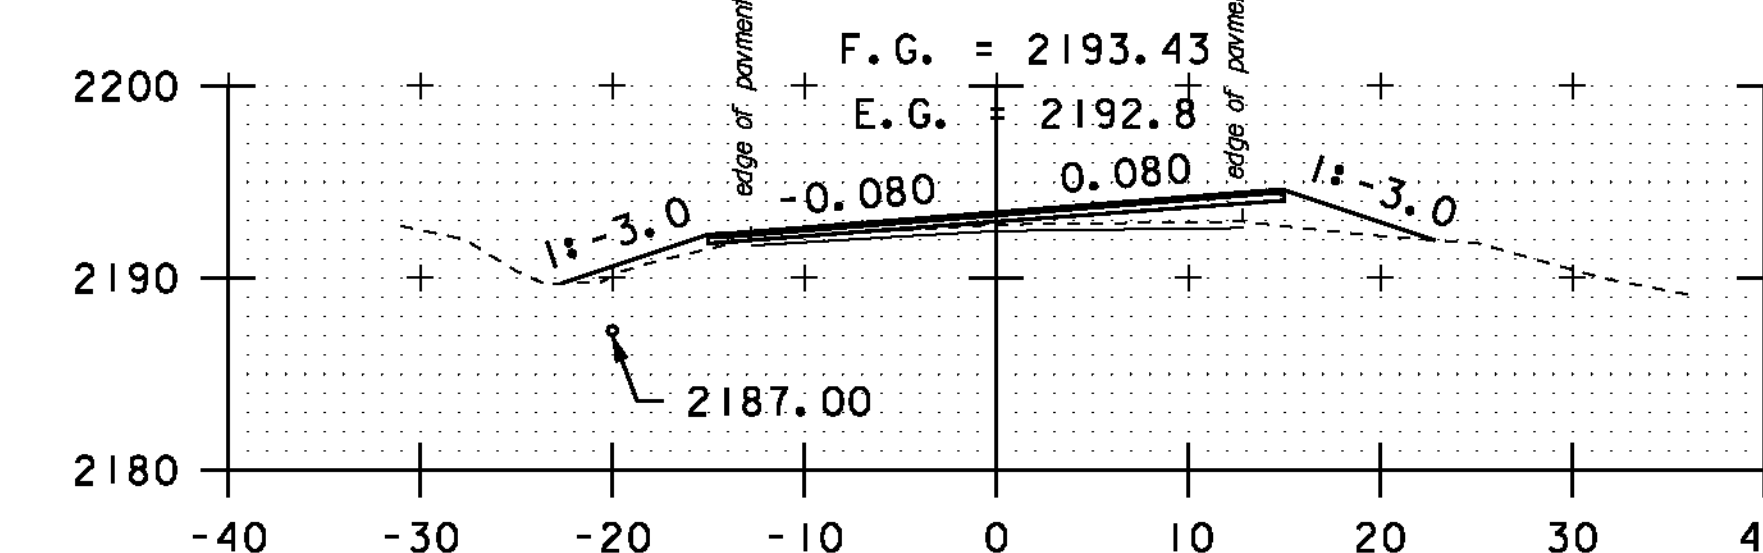

A 134+00

STA. A 130+00 TO STA. A 135+50

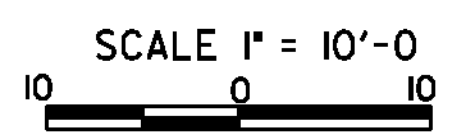

**CROSS SECTION SHEET 62**

PROJECT NAME:	MONTGOMERY-WESTFIELD
PROJECT NUMBER:	STP 2906(I)
FILE NAME:	p10ci90.dgn
PROJECT LEADER:	CDL
DESIGNED BY:	SJL
PLOT FILE:	p10ci90_176.1
PLOT DATE:	9/5/12
DRAWN BY:	SJL
CHECKED BY:	CDL
SHEET	176 OF 178