




PULL OFF RT  
A 137+00

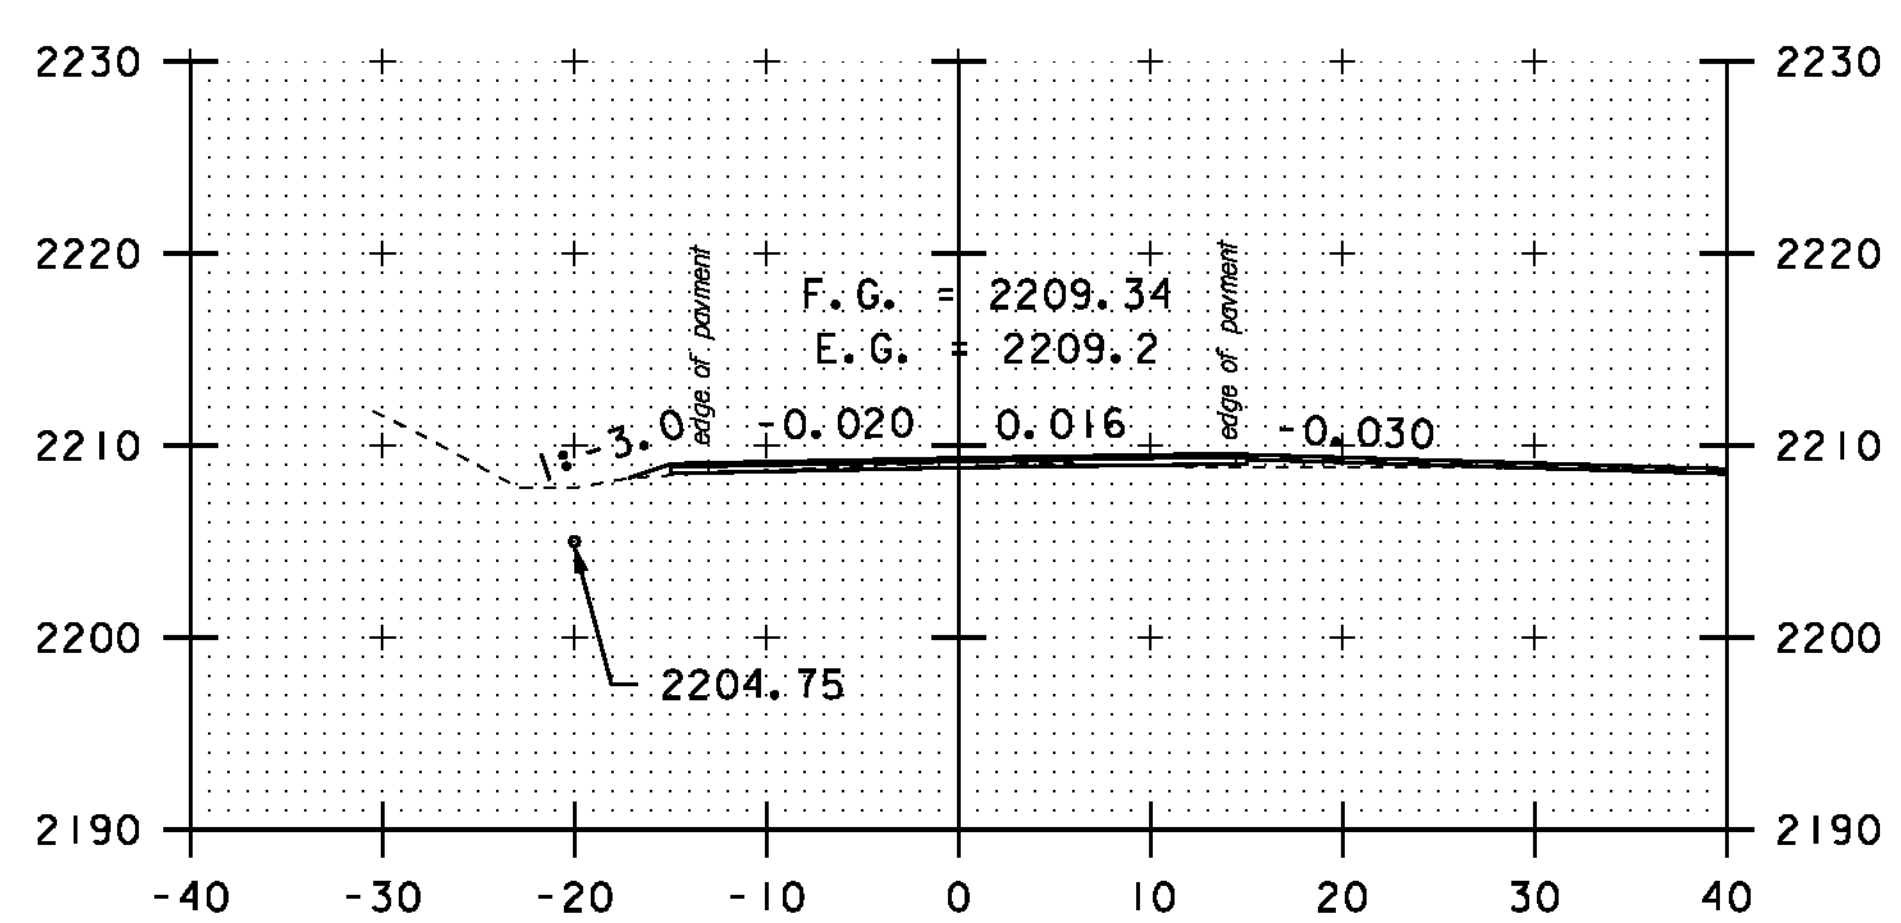


PULL OFF RT  
A 136+50

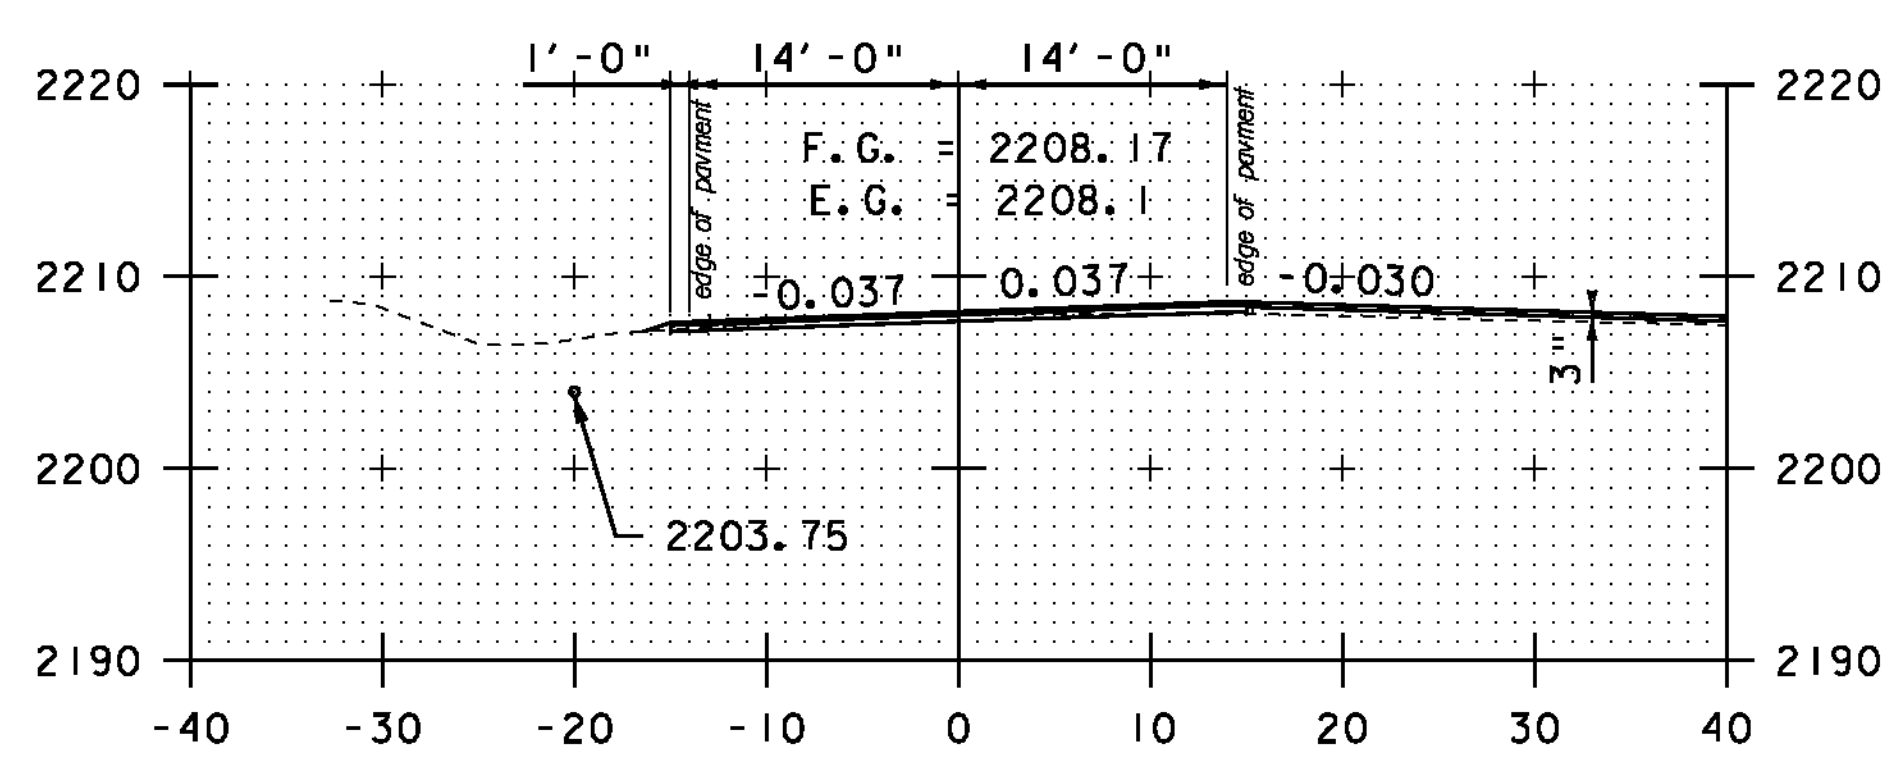


PULL OFF RT  
A 136+00

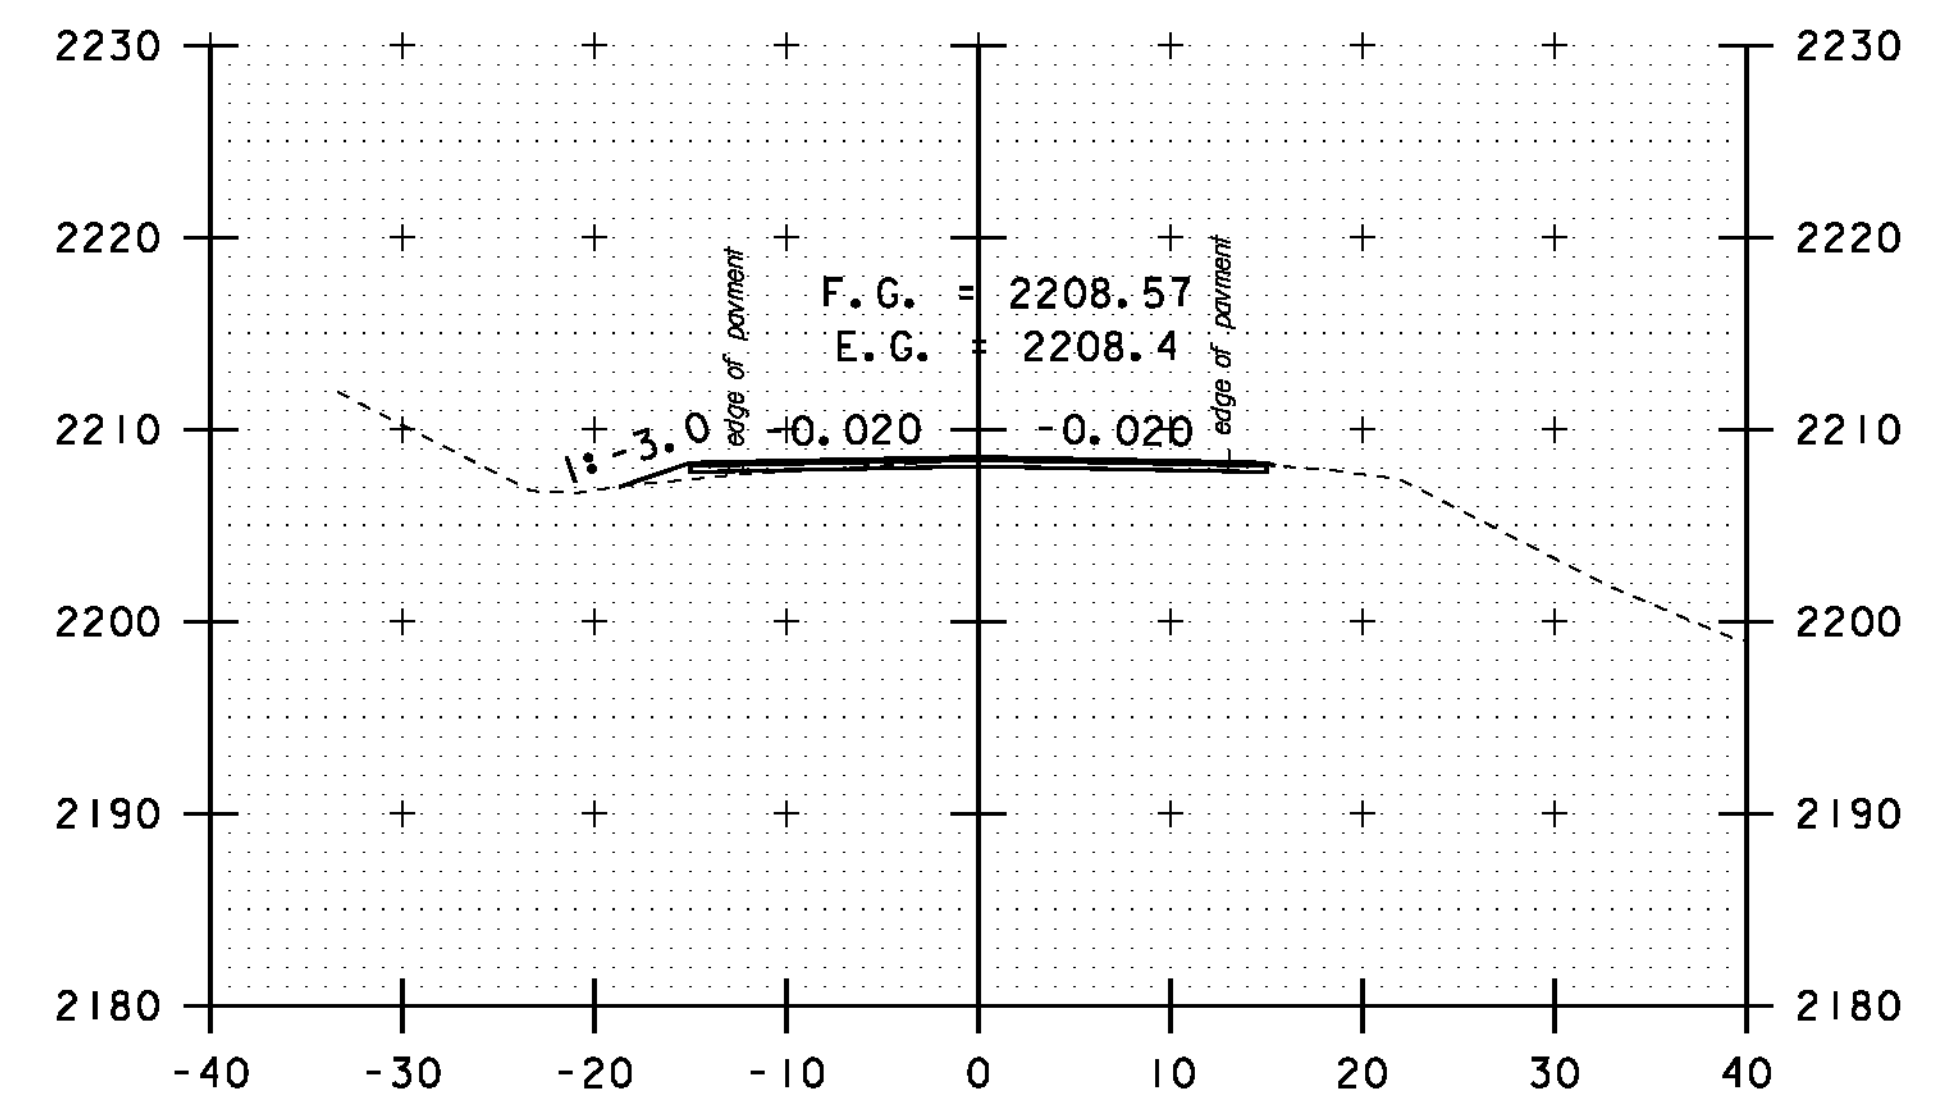


A 138+00

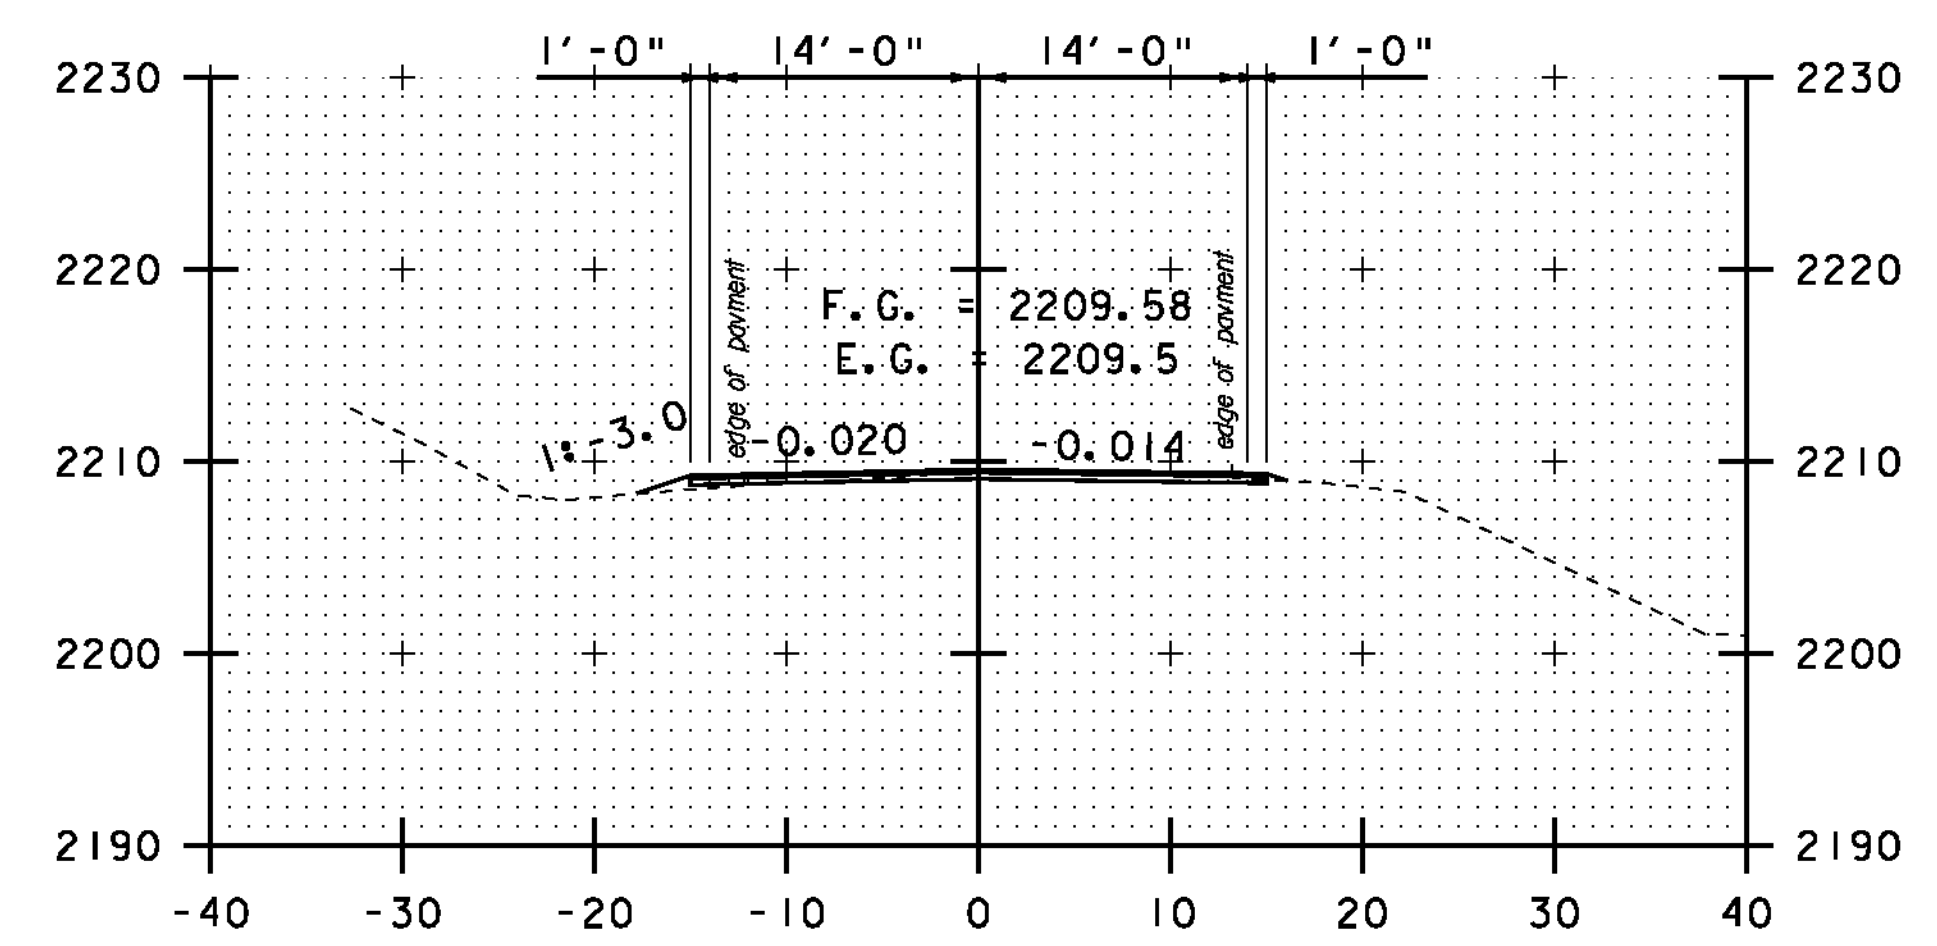


END RECLAIM  
A 137+65

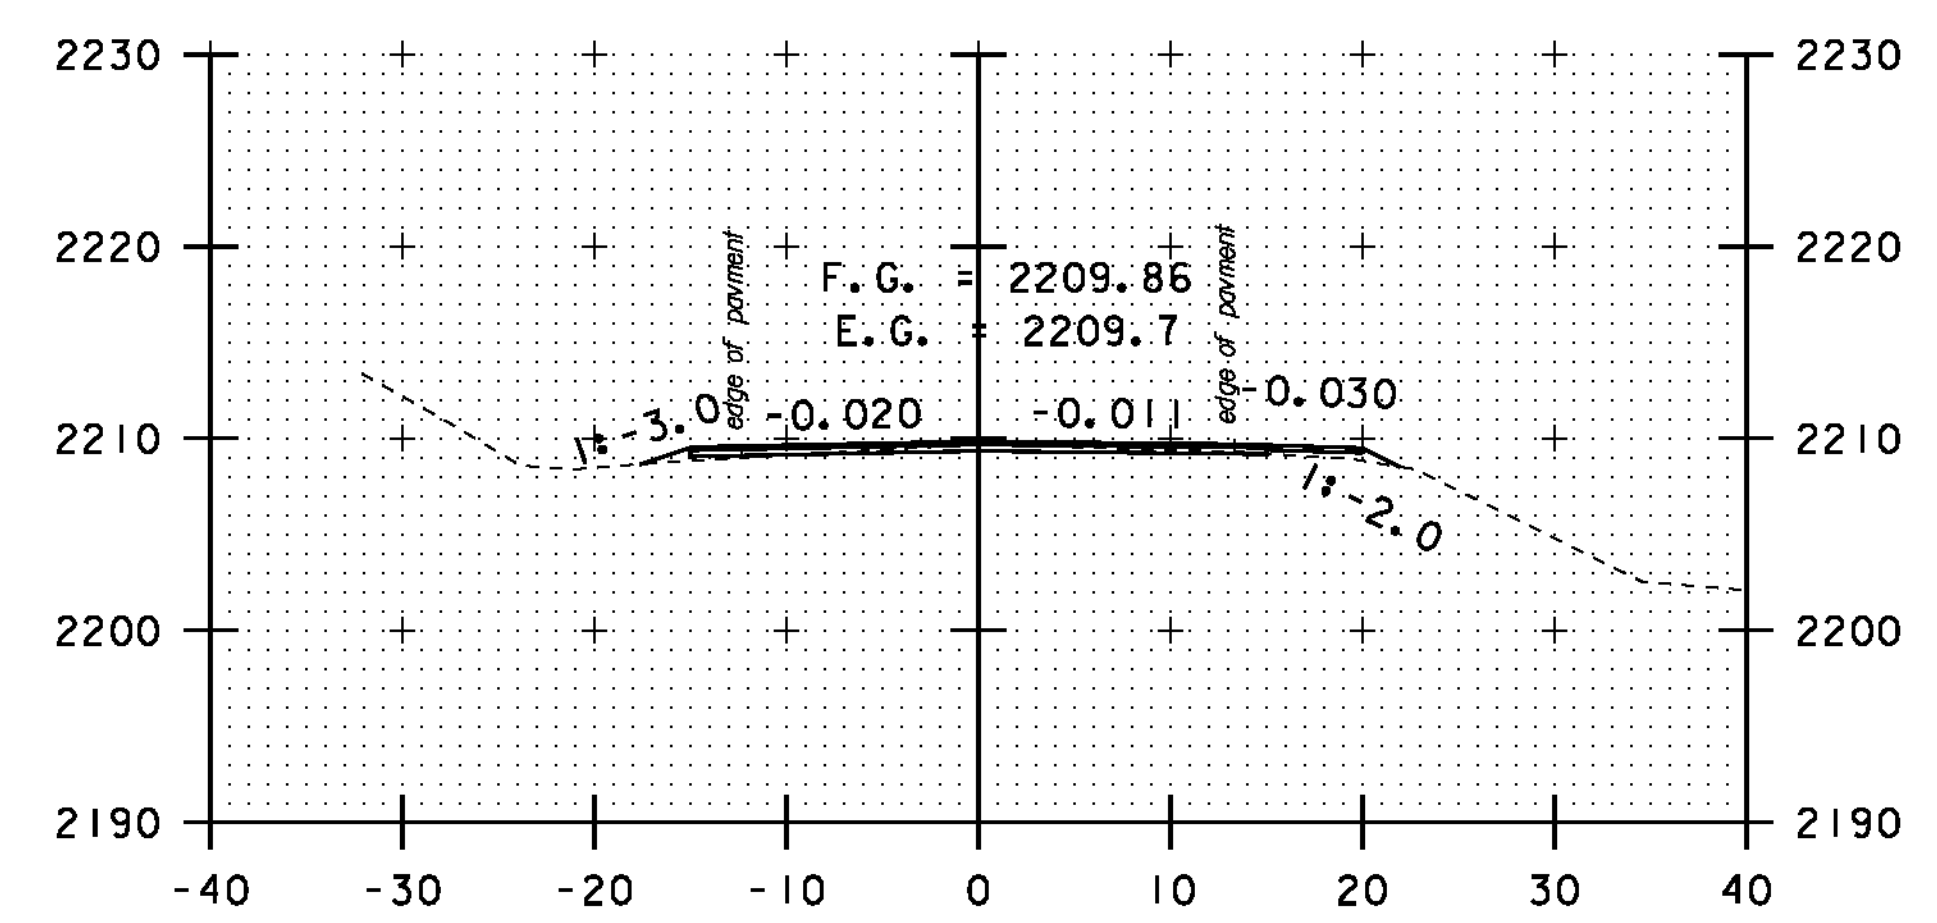


PULL OFF RT  
A 137+50

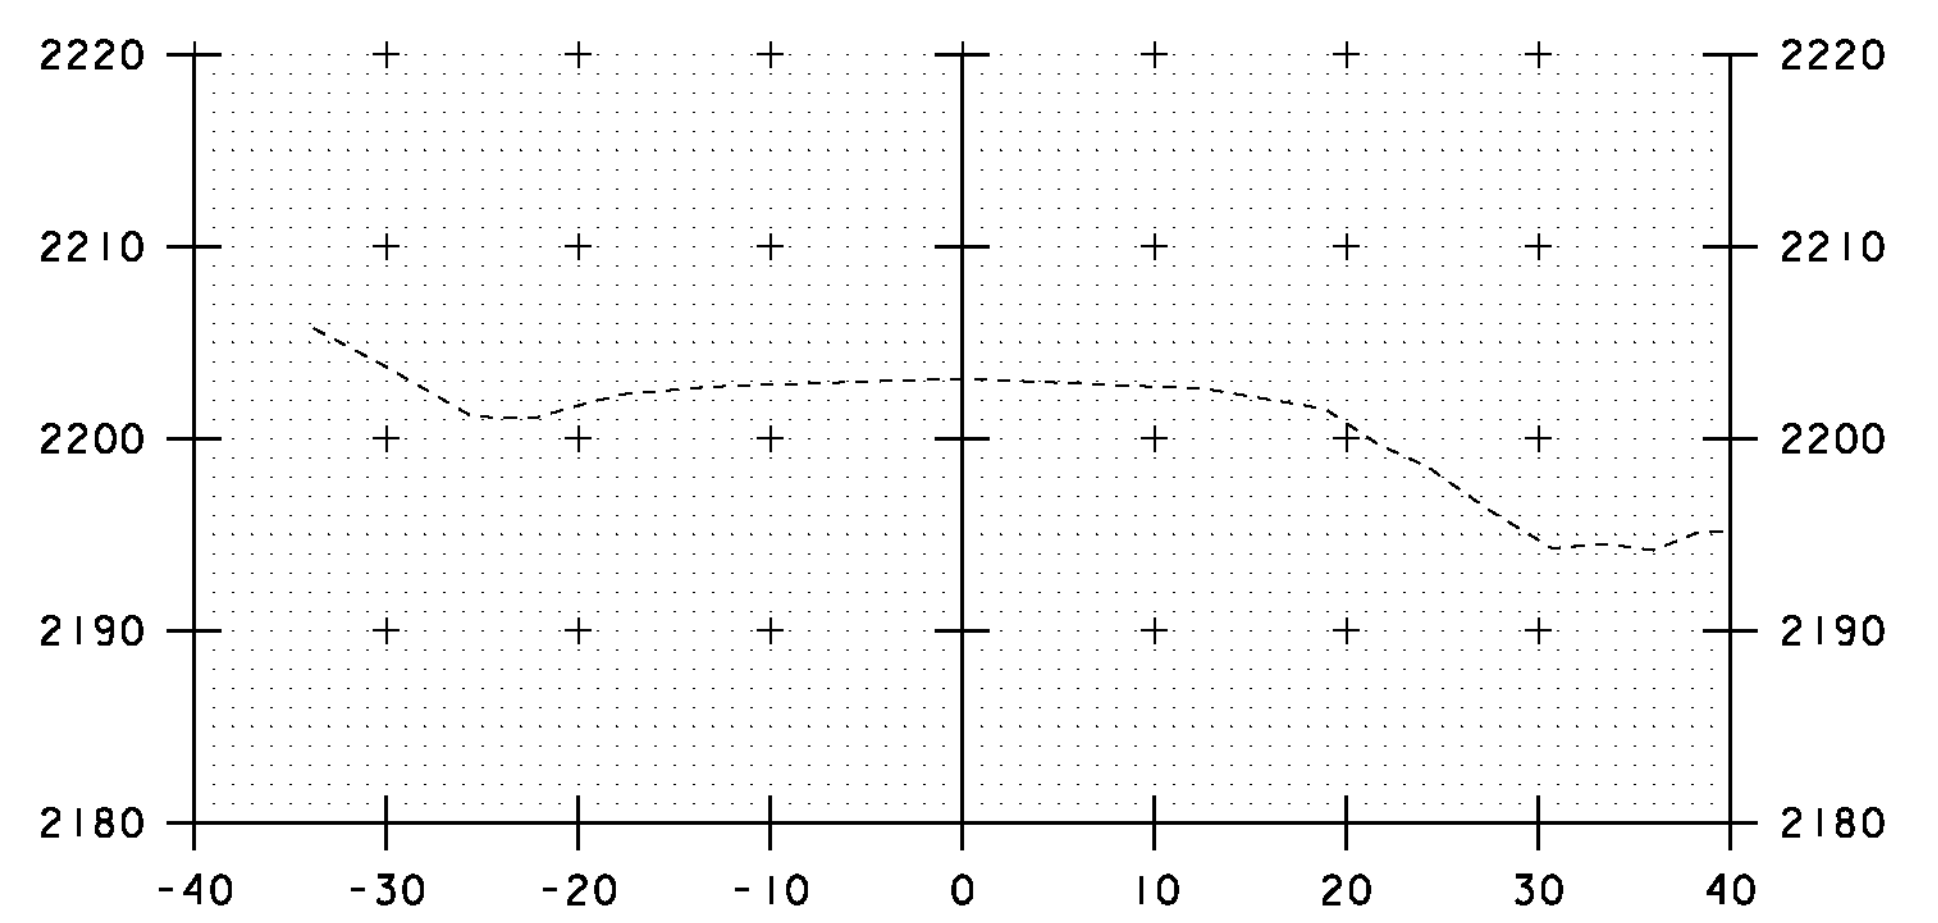

A 139+00

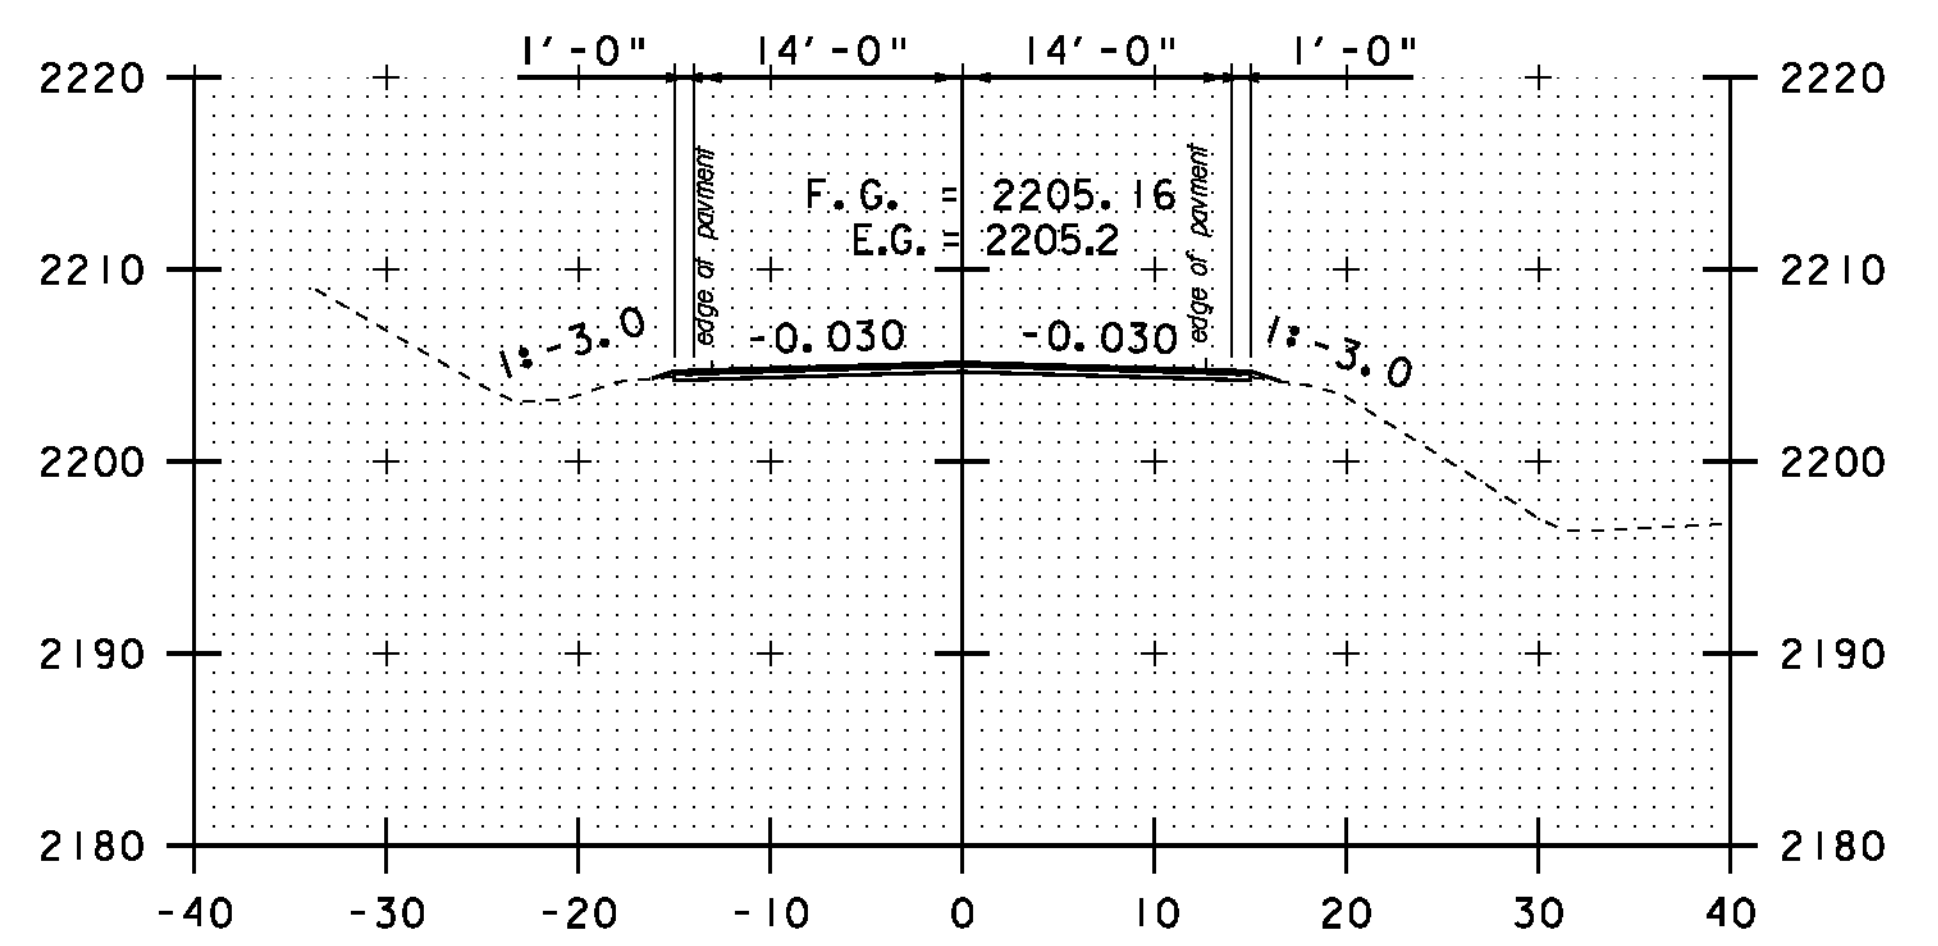

END PROJECT  
A 138+65

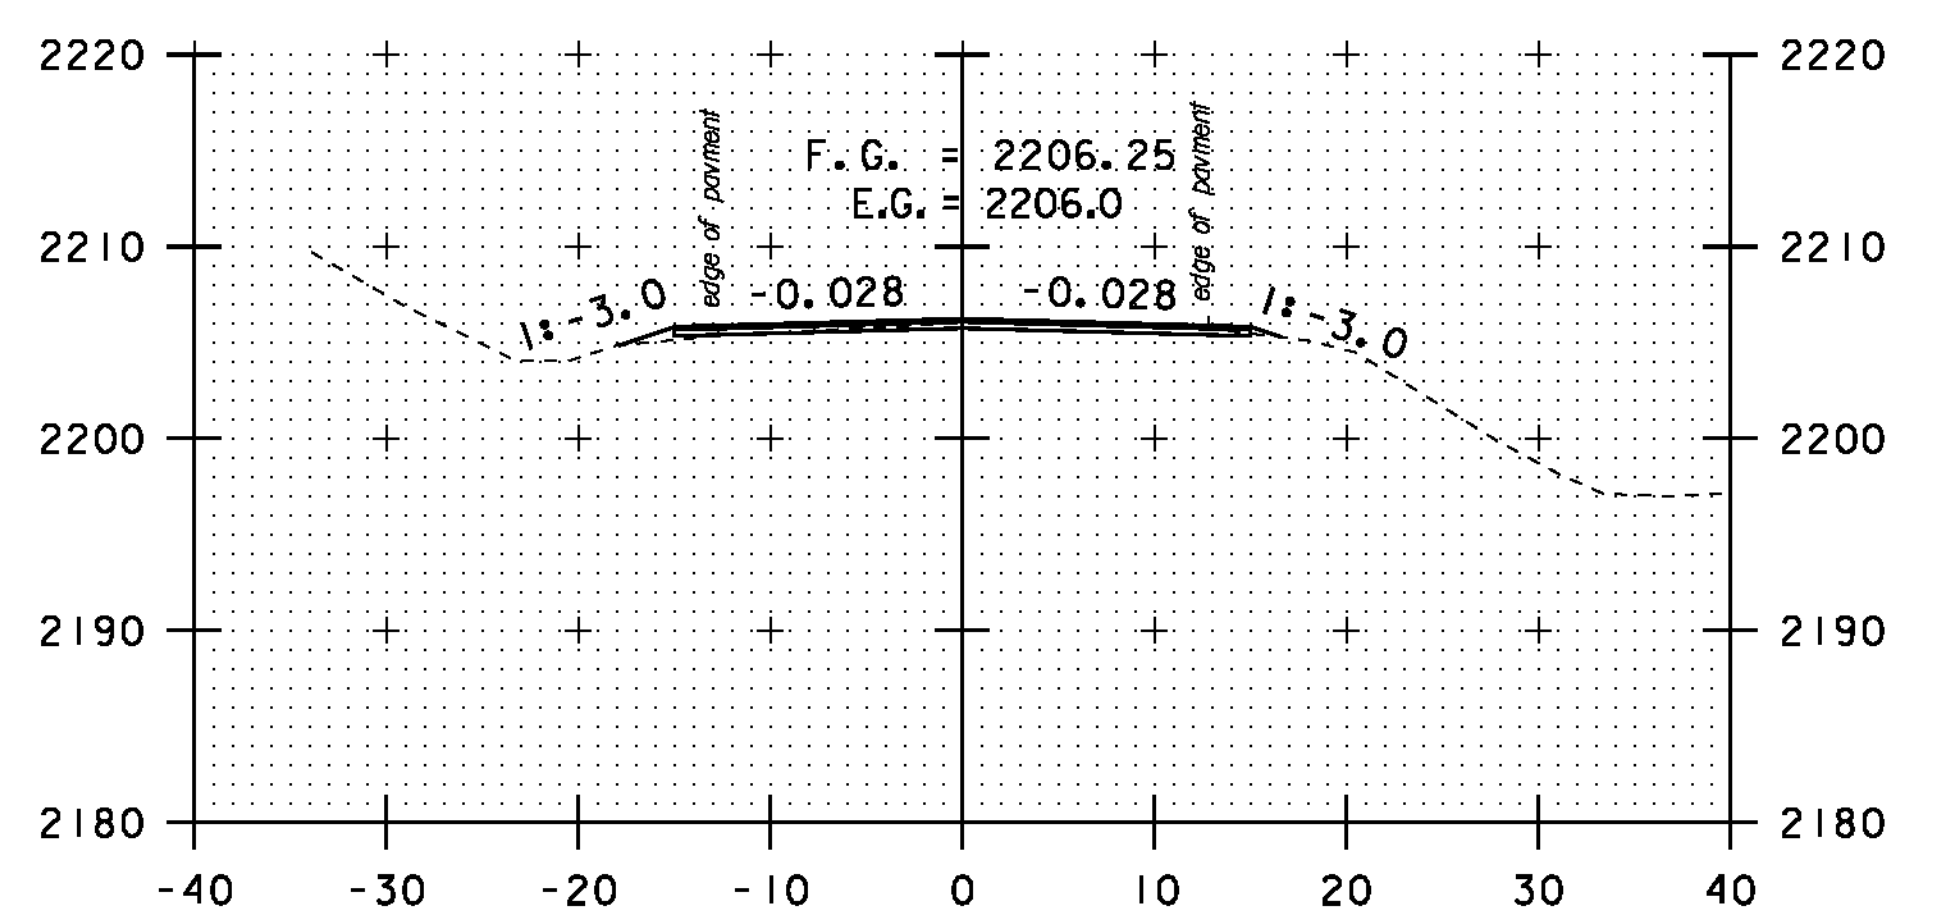

A 138+50

STA. A 136+00 TO STA. A 139+00

SCALE 1" = 10'-0"  
10 0 10

**CROSS SECTION SHEET 63**

PROJECT NAME: MONTGOMERY-WESTFIELD	PLOT DATE: 9/5/12
PROJECT NUMBER: STP 2906(I)	DRAWN BY: SJL
FILE NAME: p10CI90.dgn	CHECKED BY: CDL
PROJECT LEADER: CDL	SHEET 177 OF 178
DESIGNED BY: SJL	
PLOT FILE: p10CI90_177.1	