


TYPICAL SECTIONS

(THIS SHEET NOT TO SCALE)

| | |
|--------|---|
| 1.50" | SUPERPAVE BITUMINOUS CONCRETE PAVEMENT (TYPE IVS) |
| 2.50" | SUPERPAVE BITUMINOUS CONCRETE PAVEMENT (TYPE IIS) |
| 2.50" | SUPERPAVE BITUMINOUS CONCRETE PAVEMENT (TYPE IIS) |
| 24.00" | SUBBASE OF DENSE GRADED CRUSHED STONE |
| 18.00" | SAND BORROW |



THICKNESS TOLERANCES

| | | |
|----------|----------|-------------|
| PAVEMENT | 1/4" +/- | TOTAL DEPTH |
| SUBBASE | 1" +/- | TOTAL DEPTH |
| SAND | 1" +/- | TOTAL DEPTH |

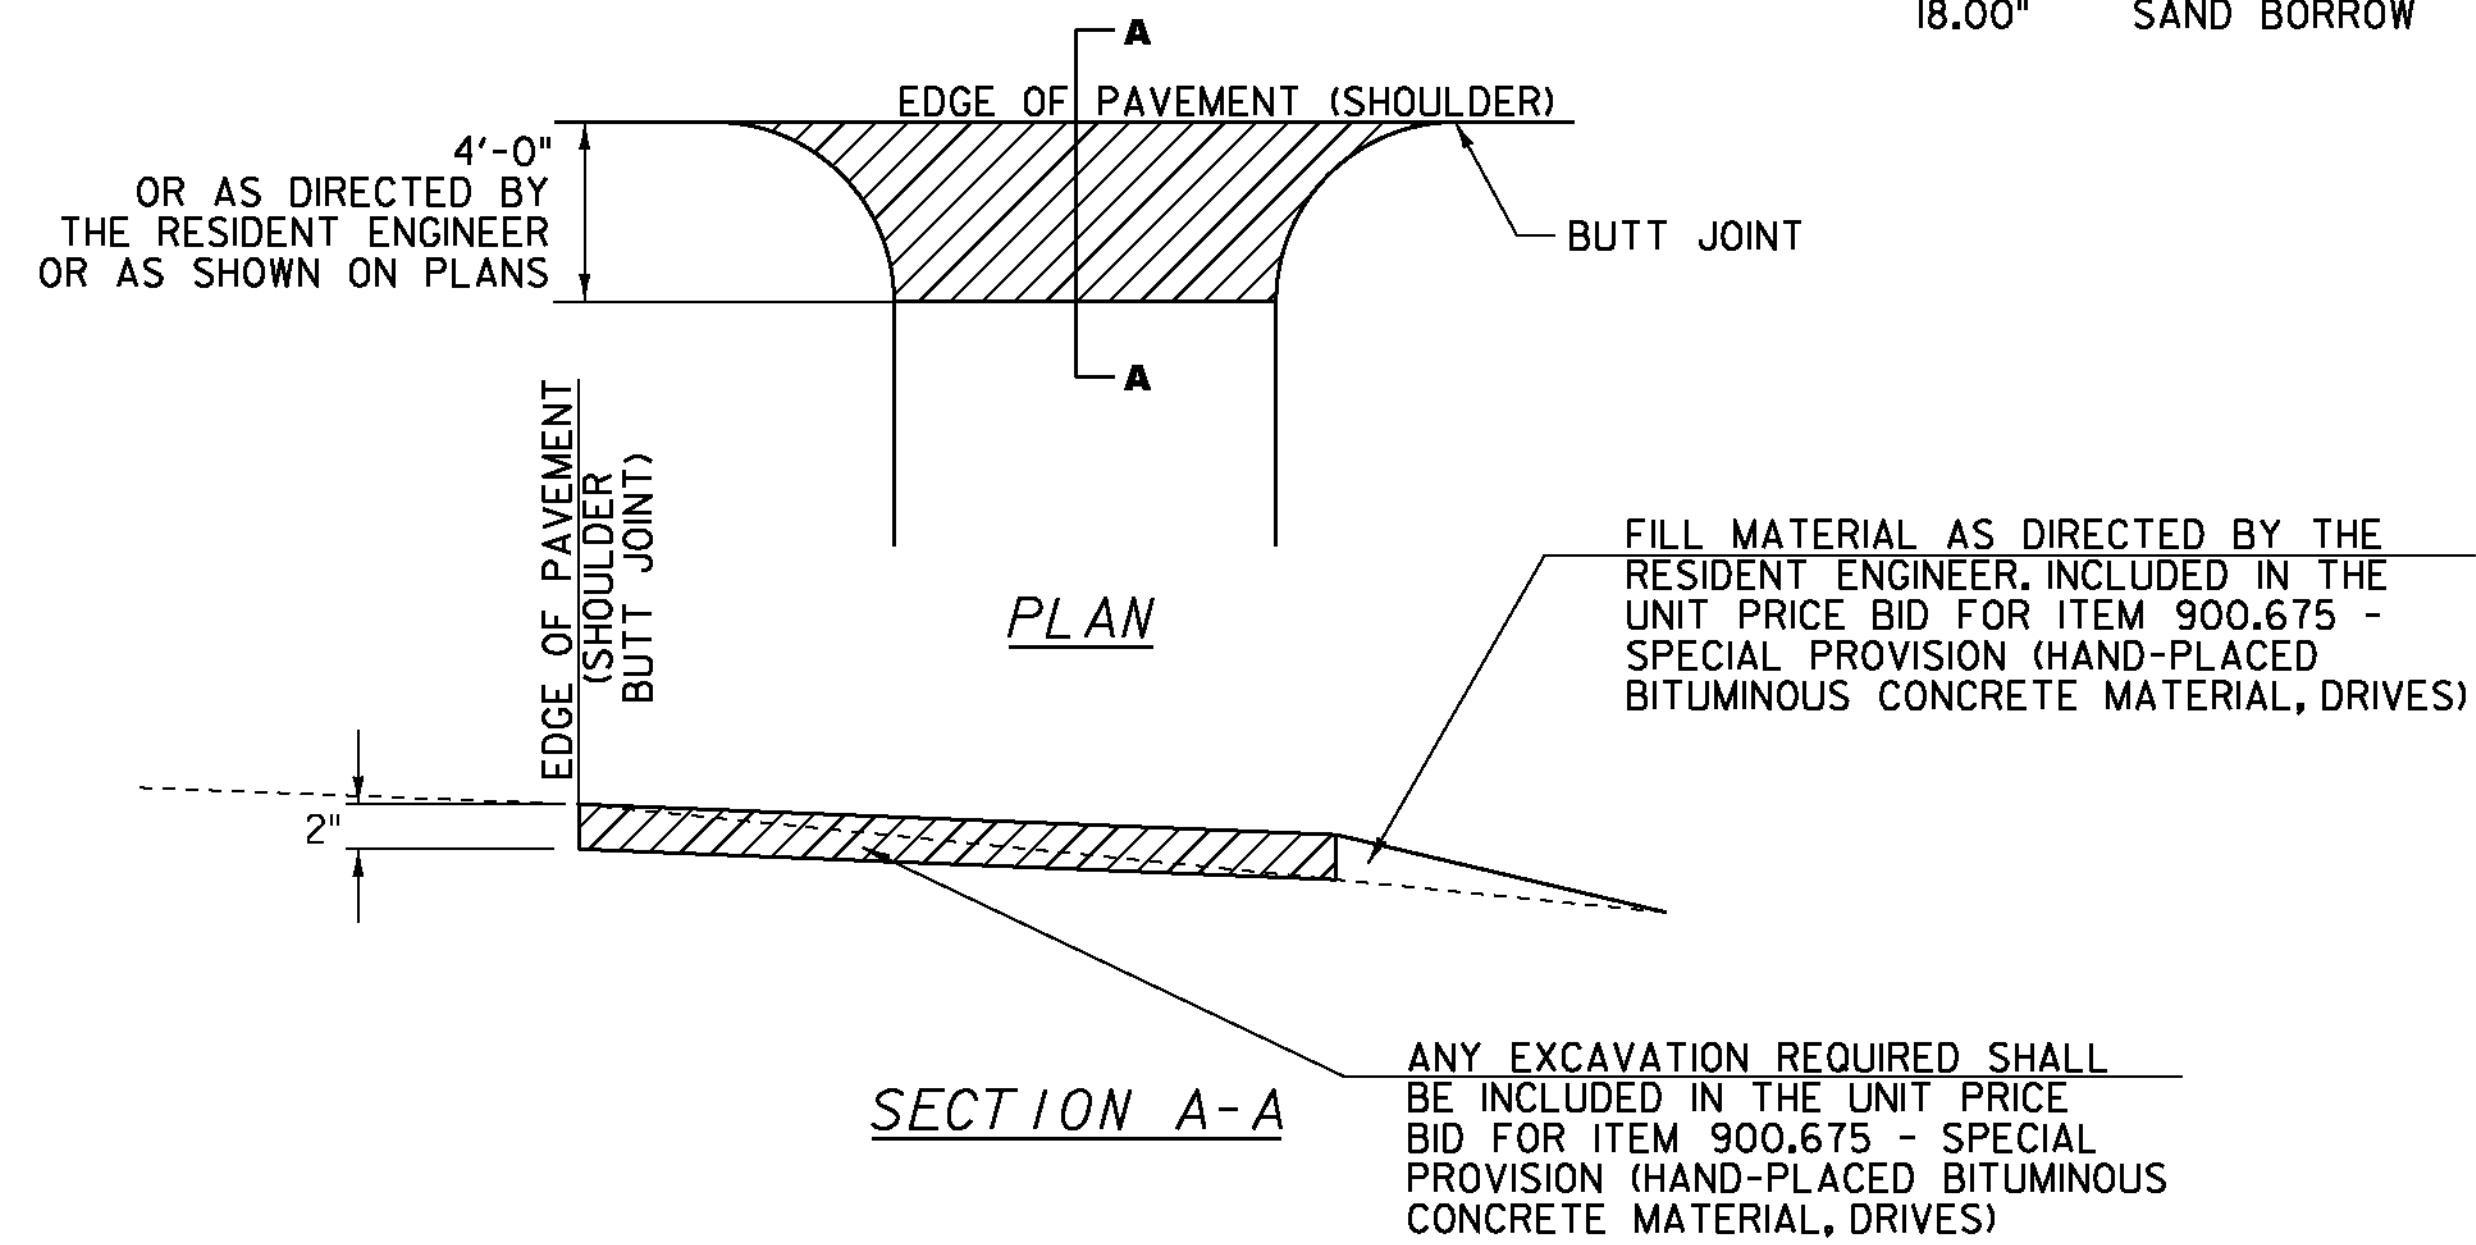


AREAS FOR ITEM 900.675 - SPECIAL PROVISION (HAND-PLACED BITUMINOUS CONCRETE MATERIAL, DRIVES)

HAND-PLACED BITUMINOUS CONCRETE MATERIAL, DRIVES DETAIL NOT TO SCALE

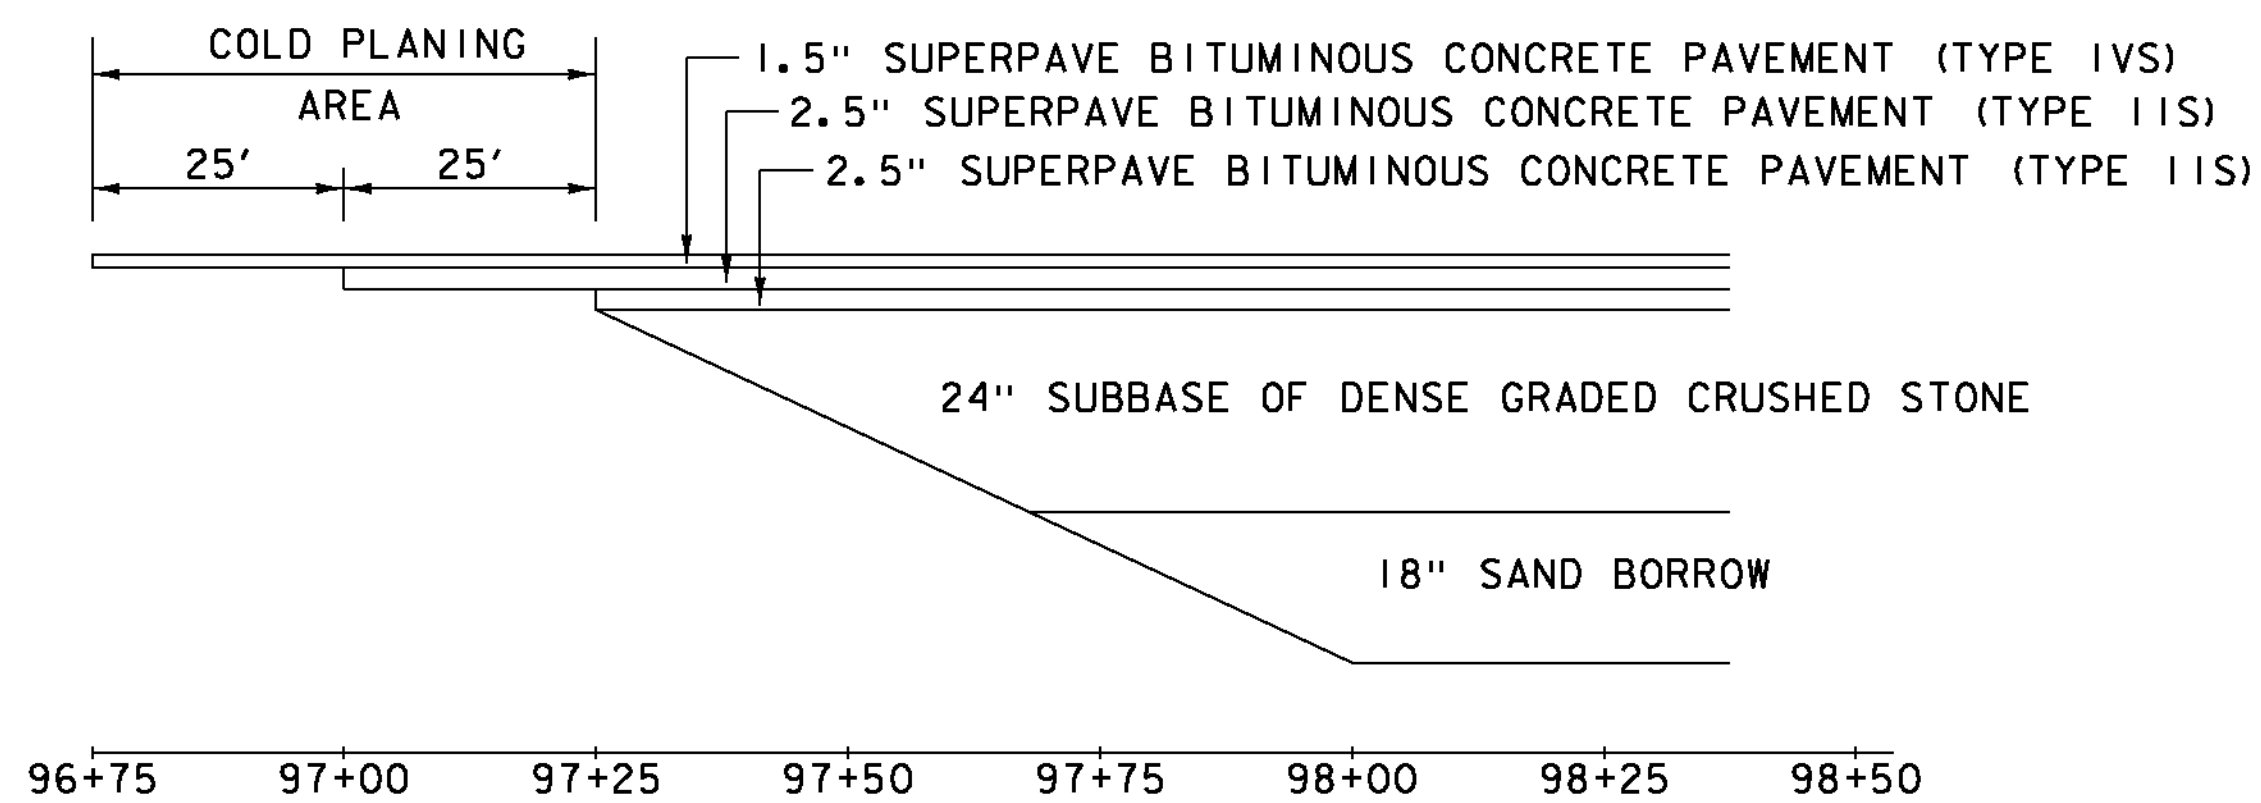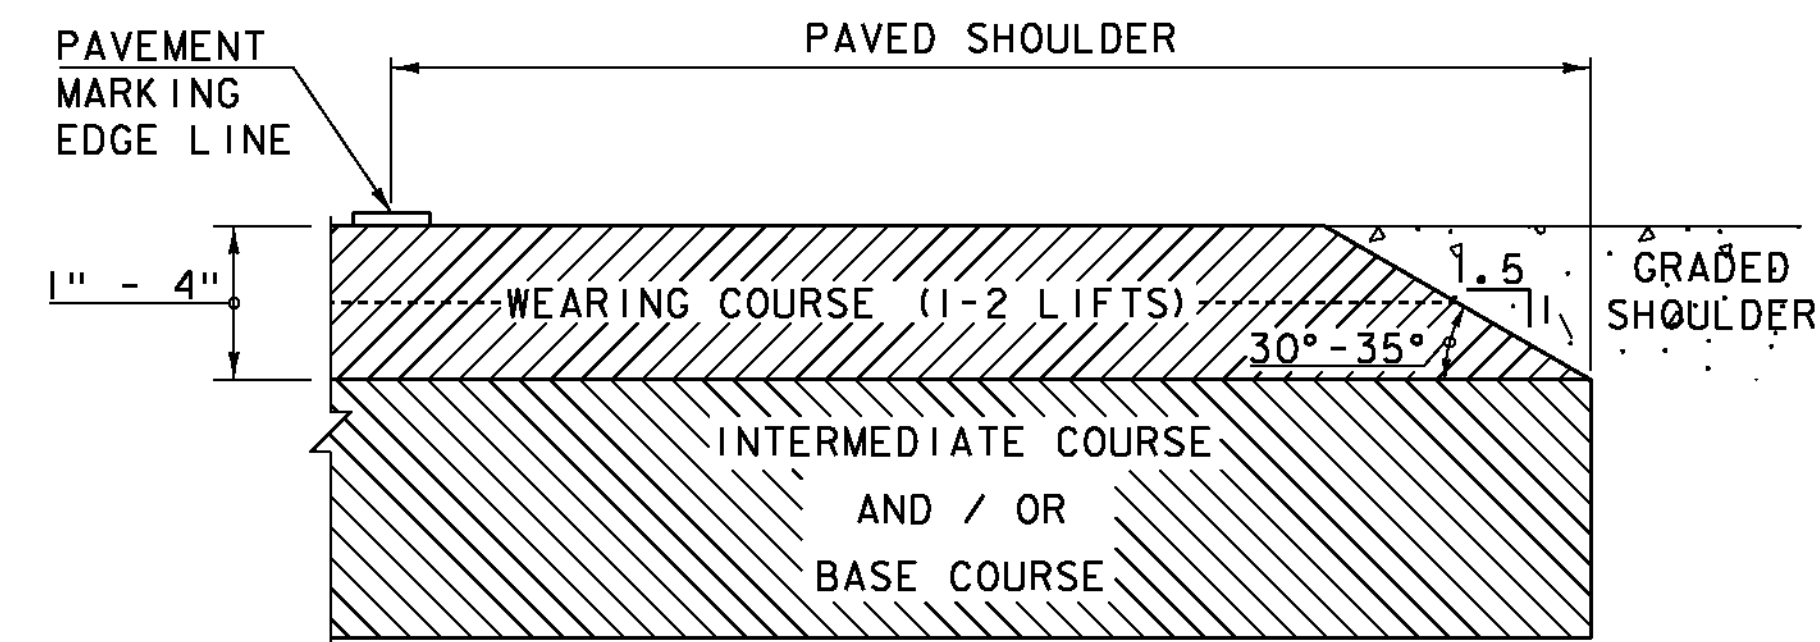

MATERIAL TRANSITION DETAIL BEGIN APPROACH NOT TO SCALE

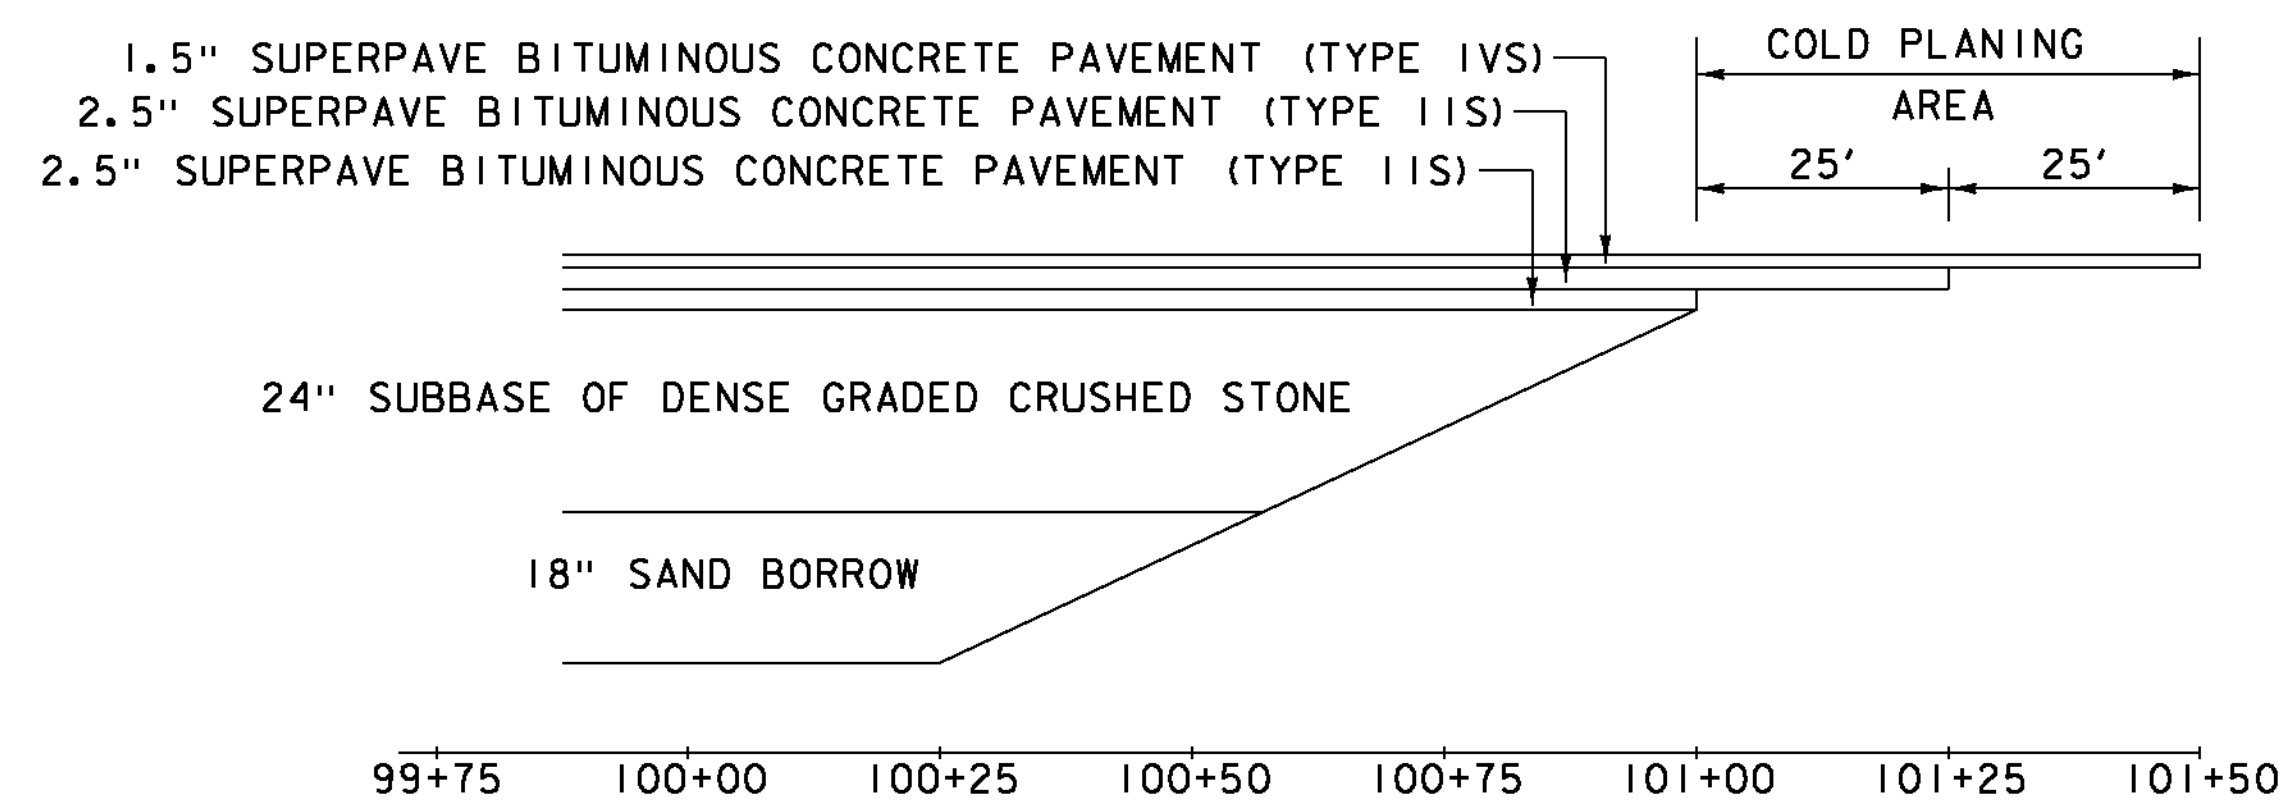

MATERIAL TRANSITION DETAIL END APPROACH NOT TO SCALE

| | |
|----------------------------|------------------------|
| PROJECT NAME: SEARSBURG | |
| PROJECT NUMBER: STP SCR(7) | |
| FILE NAME: dl0cl98.typ.dgn | PLOT DATE: 27-FEB-2013 |
| PROJECT LEADER: K. UPMAL | DRAWN BY: B. MCADAMS |
| DESIGNED BY: B. MCADAMS | CHECKED BY: A. KEMPTON |
| TYPICAL SECTIONS SHEET 2 | SHEET 5 OF 35 |