


MAINLINE PROFILE

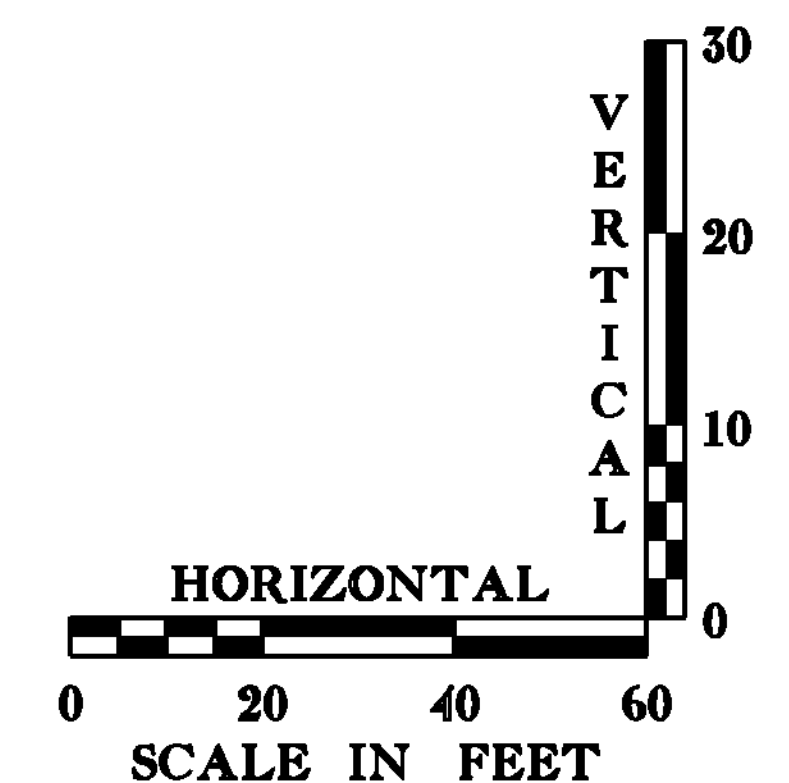

DATUM
 VERTICAL NAVD88
 HORIZONTAL NAD83 (2007)

THE GRADES SHOWN TO THE NEAREST TENTH ARE THE ORIGINAL GROUND ELEVATIONS ALONG THE PROPOSED ALIGNMENT. THE GRADES SHOWN TO THE NEAREST HUNDREDTH ARE THE FINISHED GRADES FOR THE PROPOSED ALIGNMENT.

PROJECT NAME: SEARSBURG
 PROJECT NUMBER: STP SCR(7)
 FILE NAME: d:\0c198_xsec.dgn
 PROJECT LEADER: K. UPMAL
 DESIGNED BY: B. MCADAMS
 MAINLINE PROFILE SHEET
 PLOT DATE: 27-FEB-2013
 DRAWN BY: B. MCADAMS
 CHECKED BY: A. KEMPTON
 SHEET 11 OF 35