



100+50

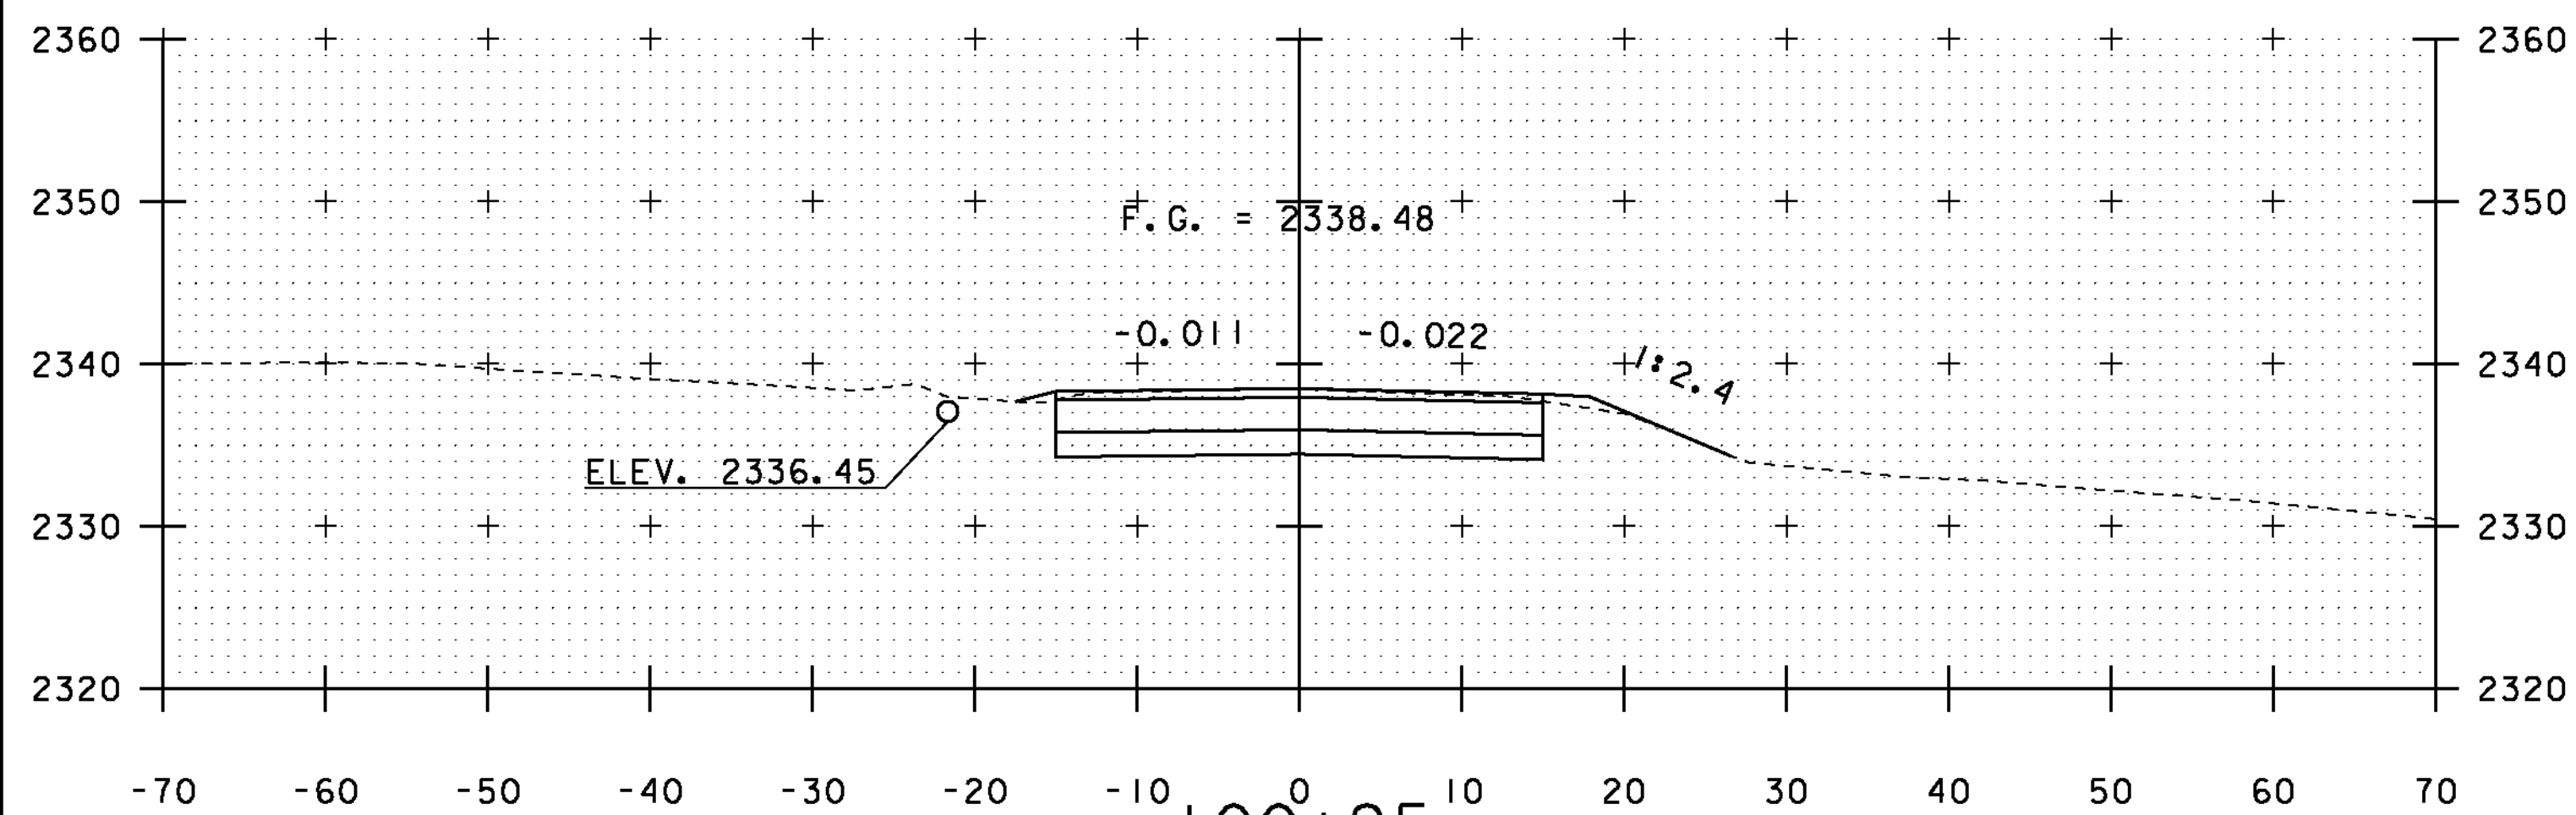


100+25

END PROJECT
BEGIN APPROACH

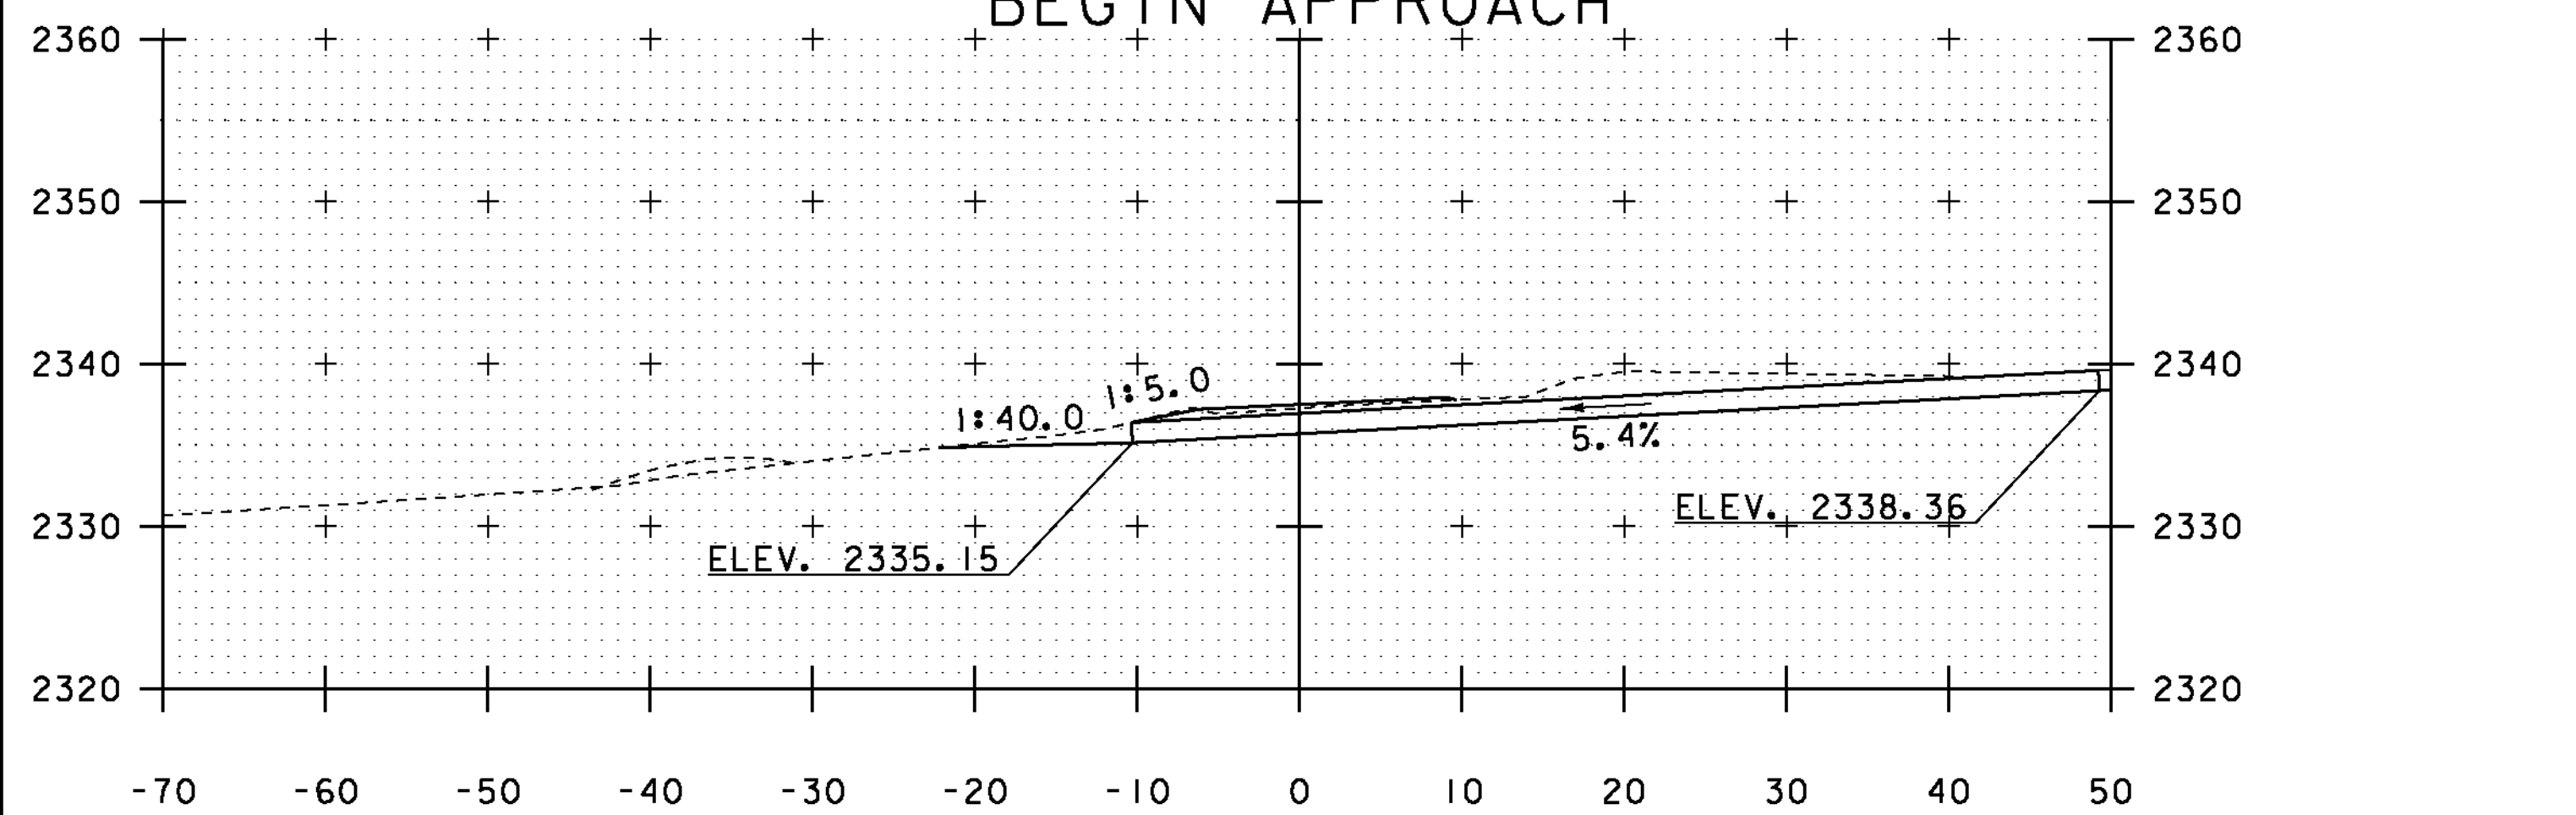


100+11

DRIVE SECTION A-A
SKEW 83.35°

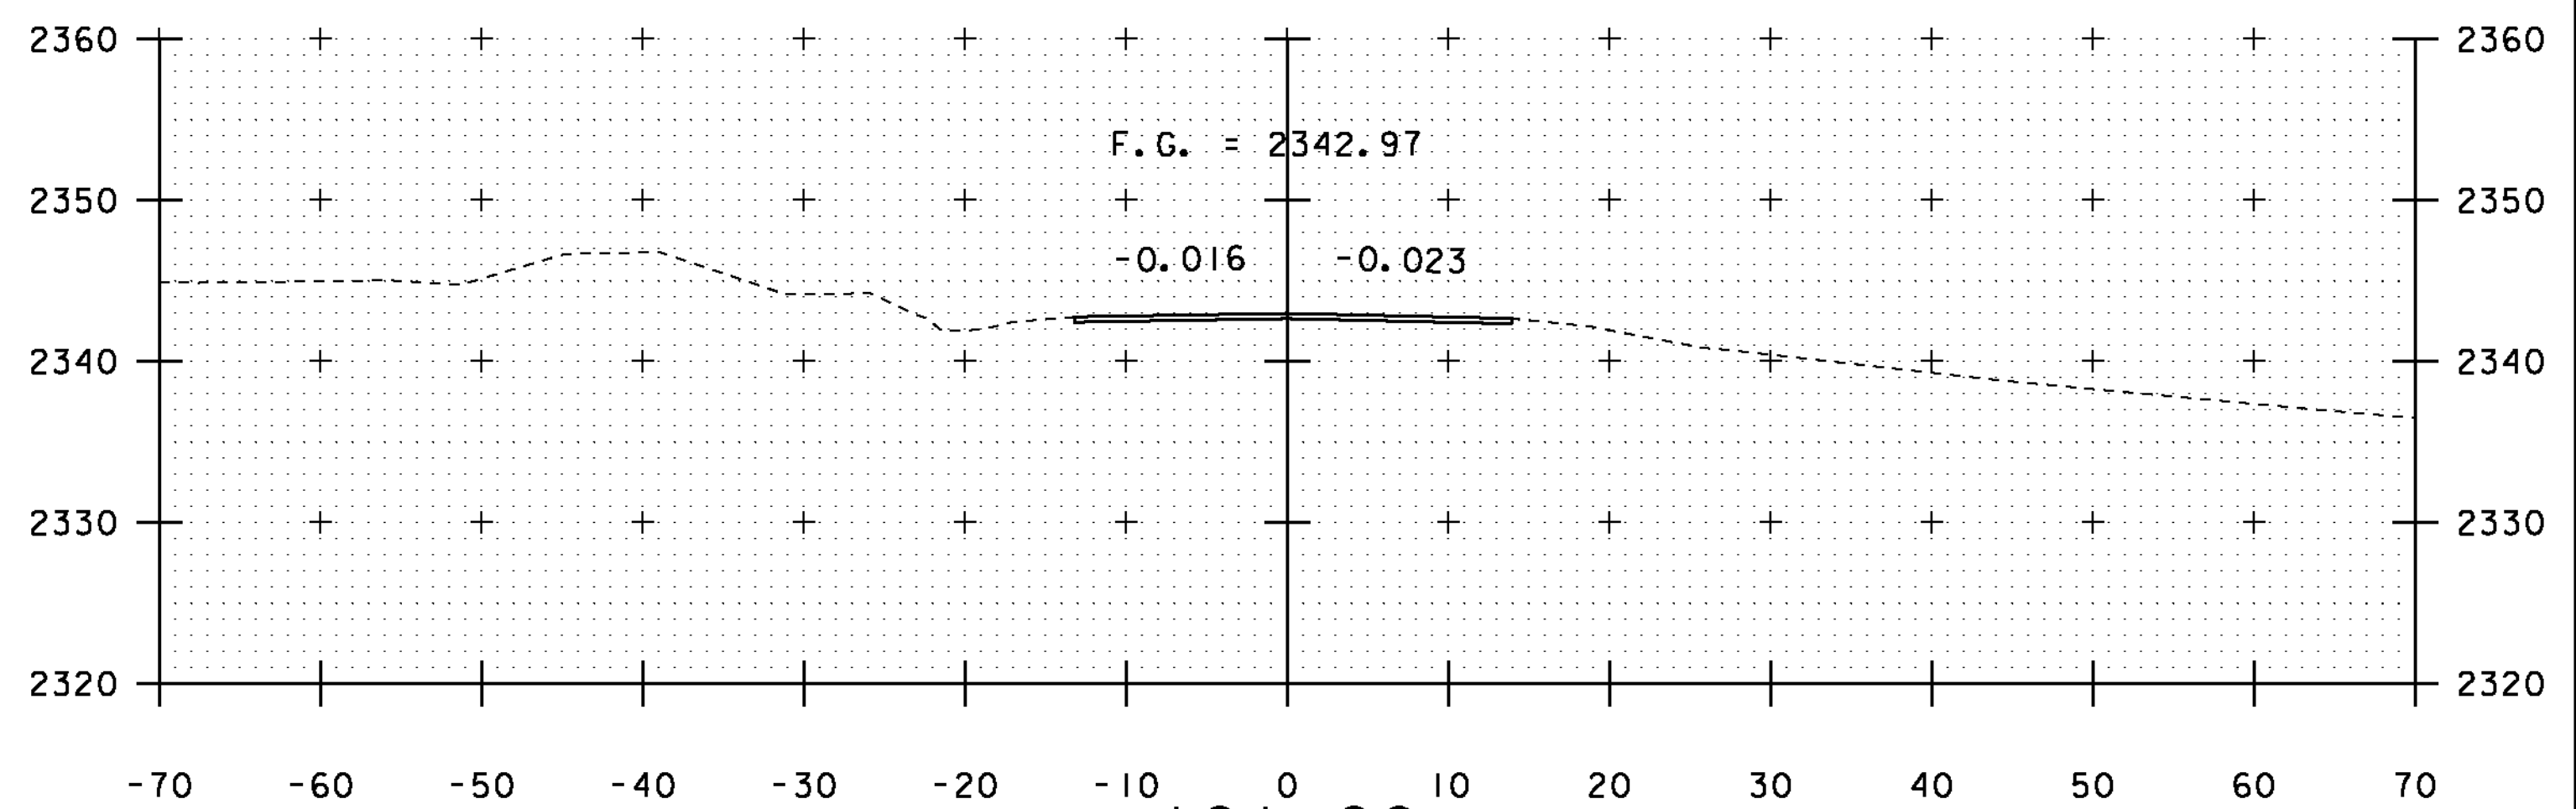

101+00

BEGIN COLD PLANE

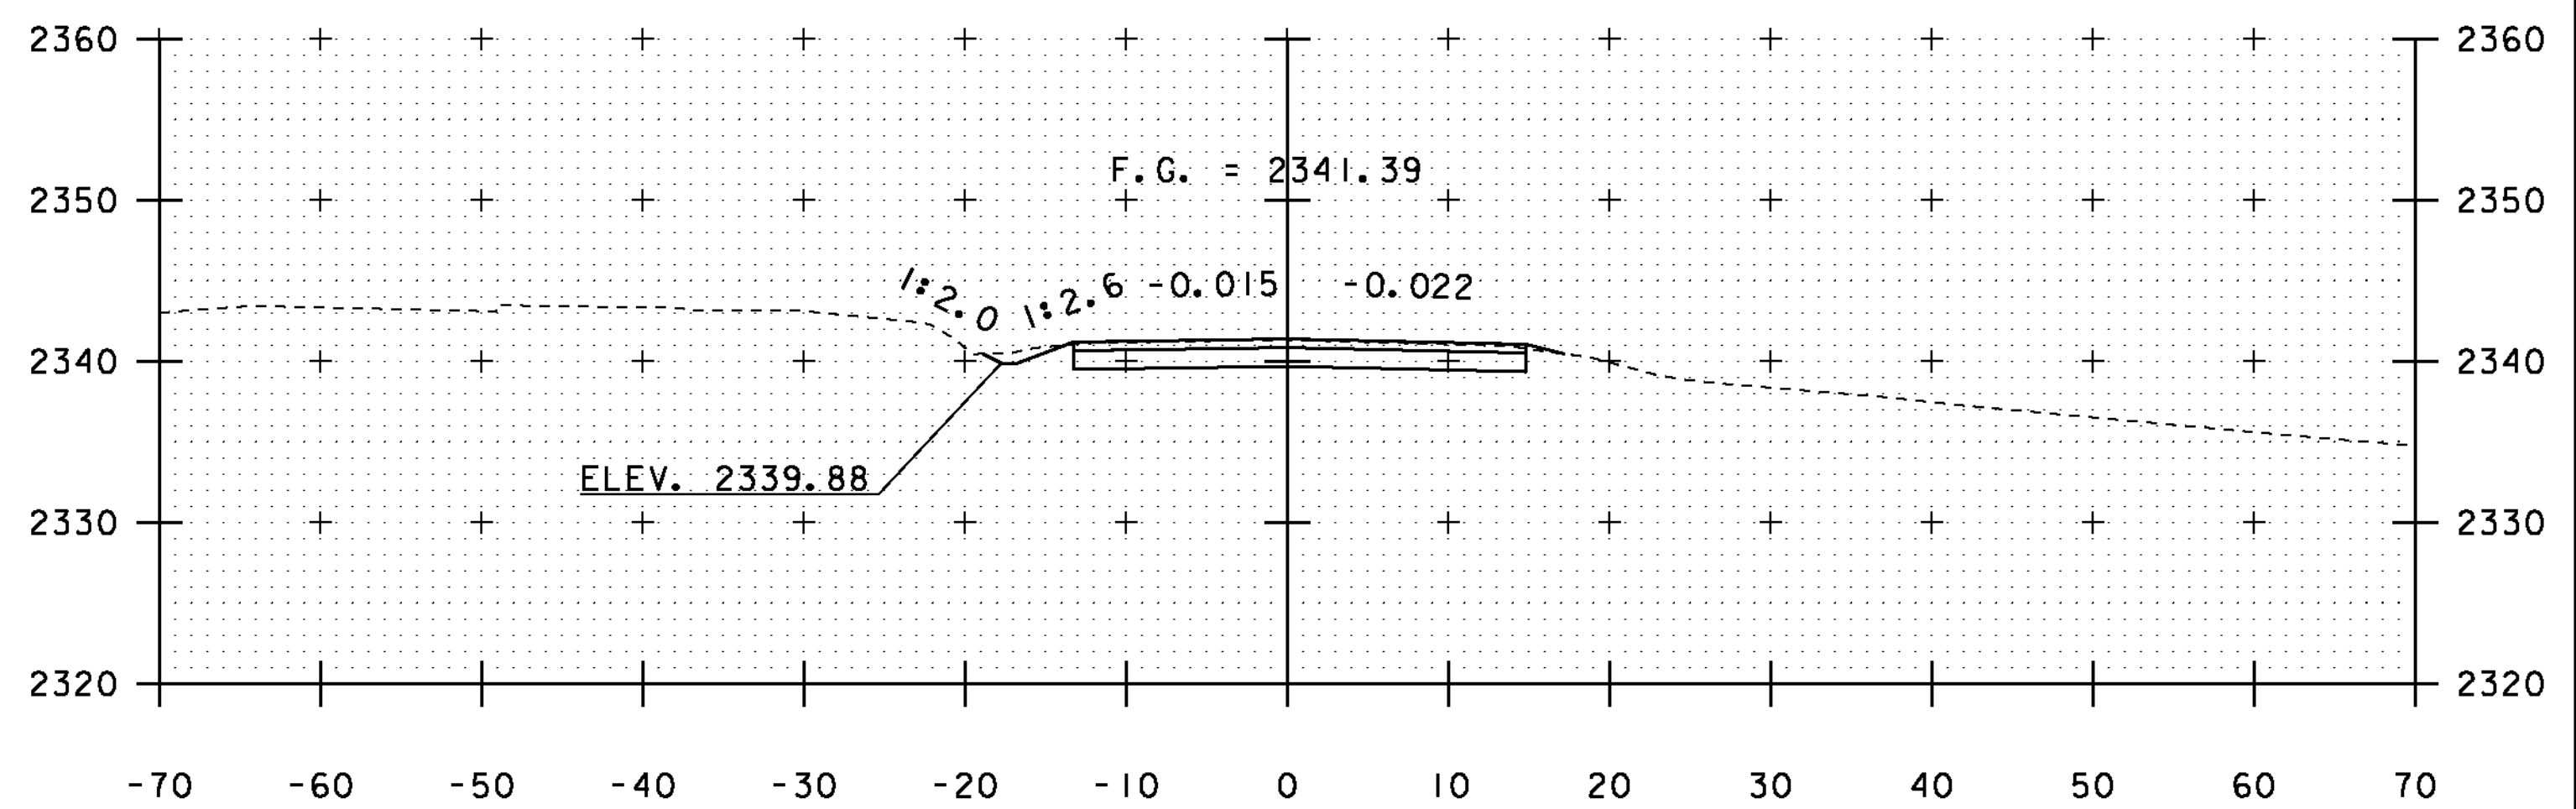

100+75

STA. 100+11 TO STA. 101+00

PROJECT NAME: SEARSBURG	
PROJECT NUMBER: STP SCRP(7)	
FILE NAME: dl0c198_xsec.dgn	PLOT DATE: 27-FEB-2013
PROJECT LEADER: K. UPMAL	DRAWN BY: B.MCADAMS
DESIGNED BY: B. MCADAMS	CHECKED BY: A. KEMPTON
MAINLINE CROSS SECTION 3	SHEET 30 OF 35