



STA 11+24.10
 END STONE FILL, TYPE III
 END GEOTEXTILE UNDER STONE FILL
 END UNCLASSIFIED CHANNEL EXCAVATION

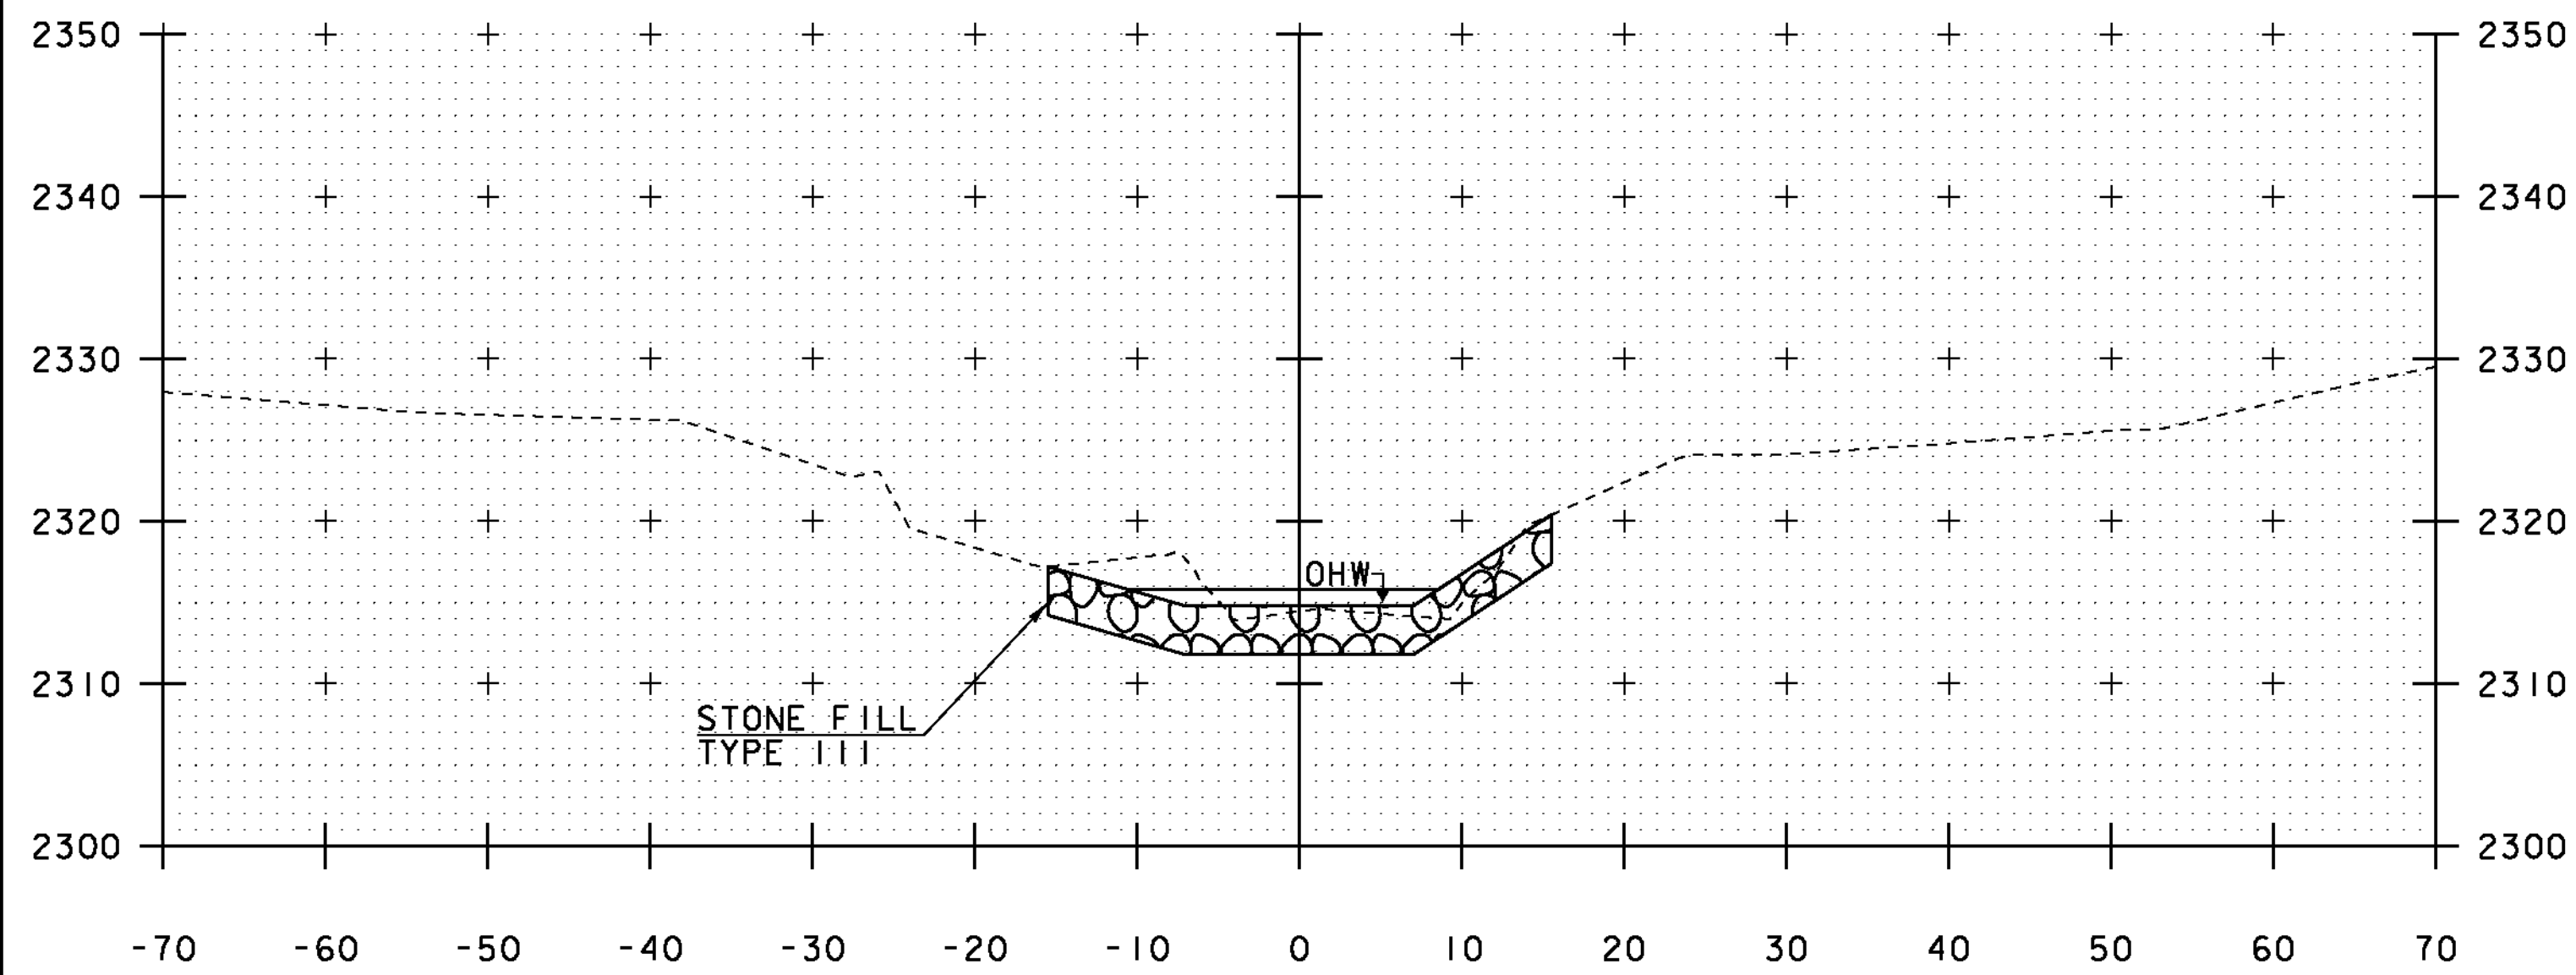


11+20

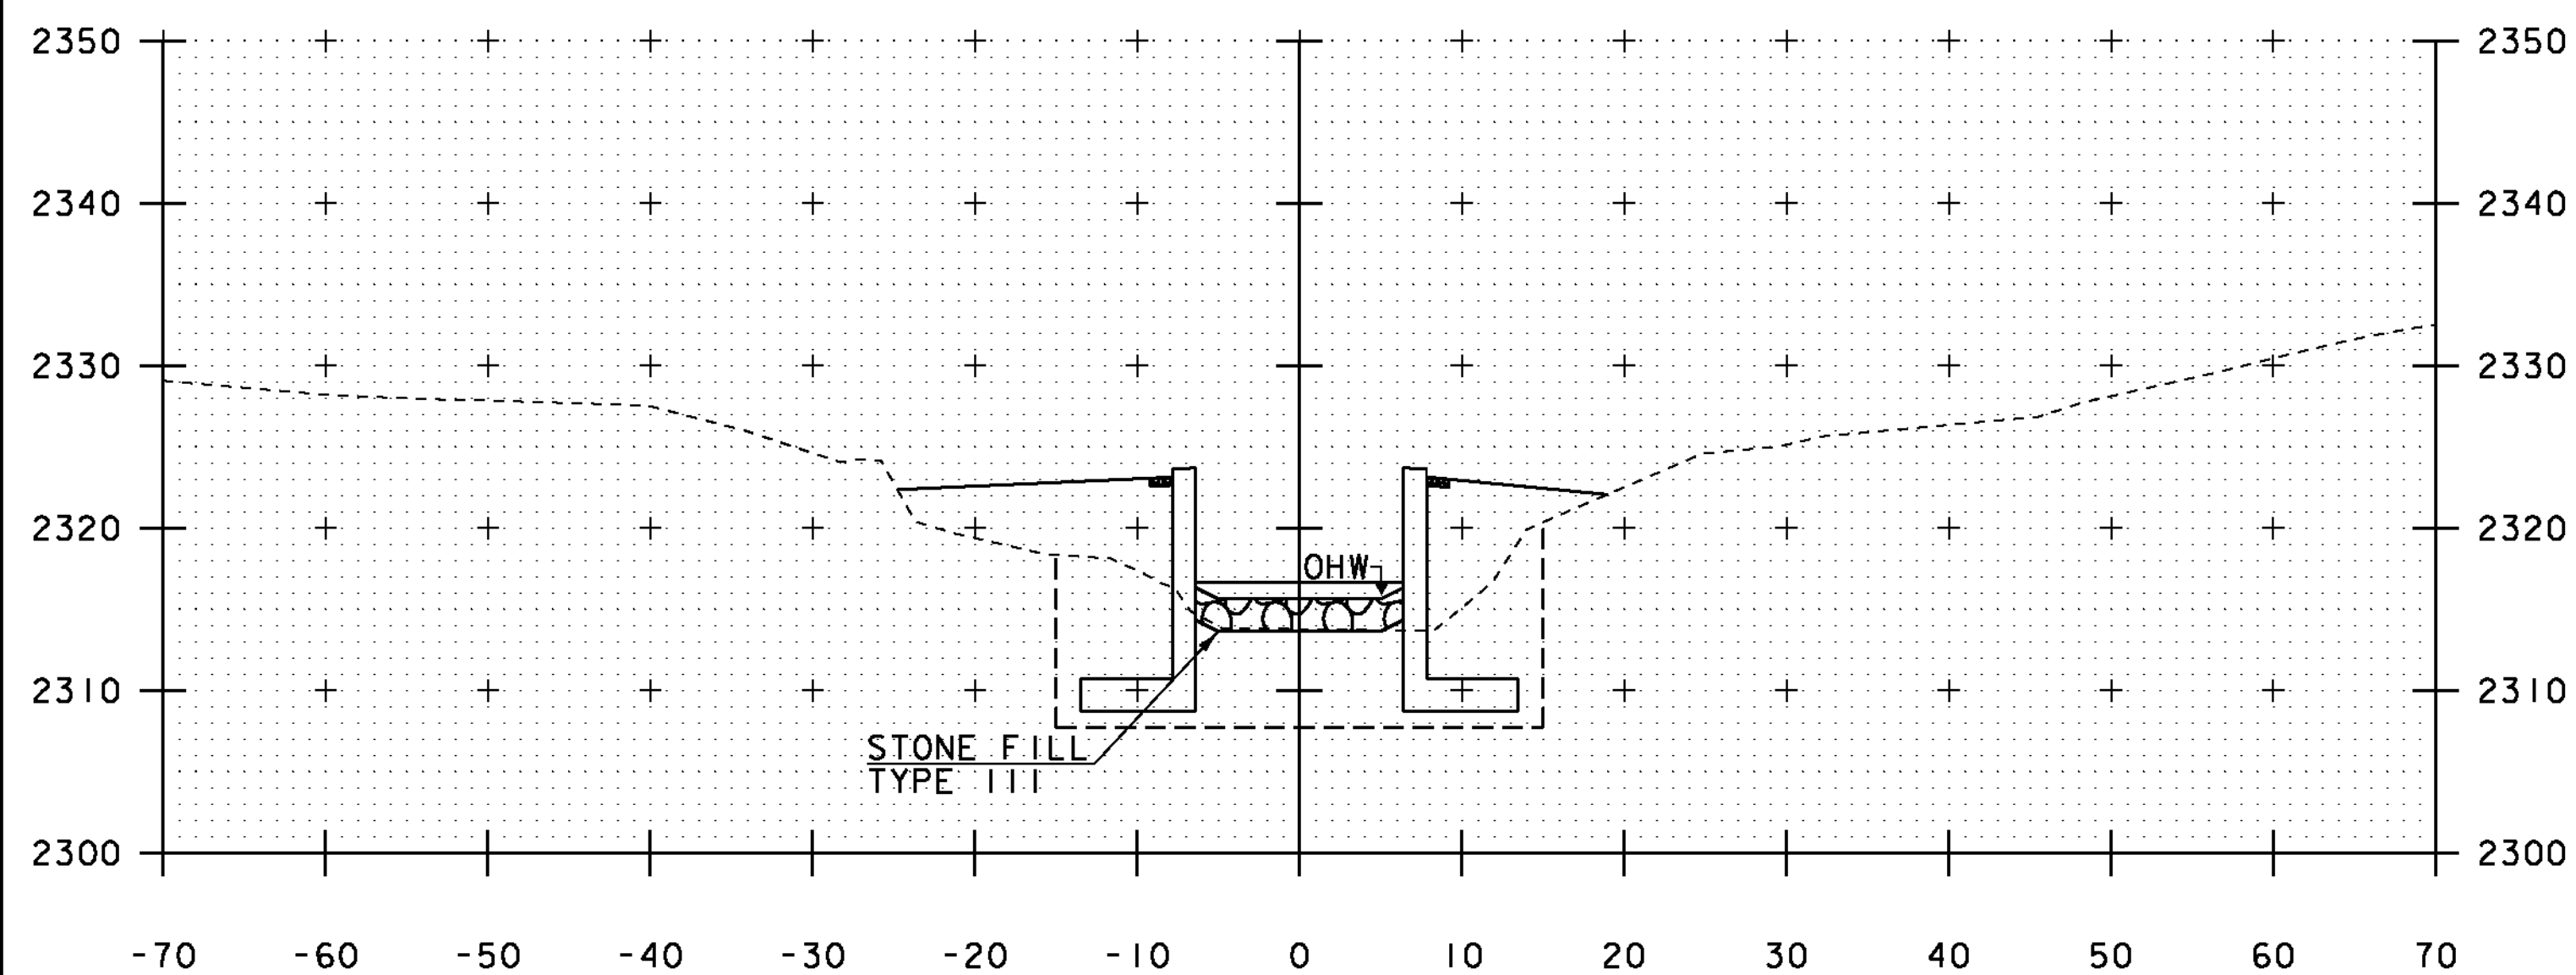

11+10

STA 11+09.20
 BEGIN STONE FILL, TYPE III
 BEGIN GEOTEXTILE UNDER STONE FILL
 BEGIN UNCLASSIFIED CHANNEL EXCAVATION

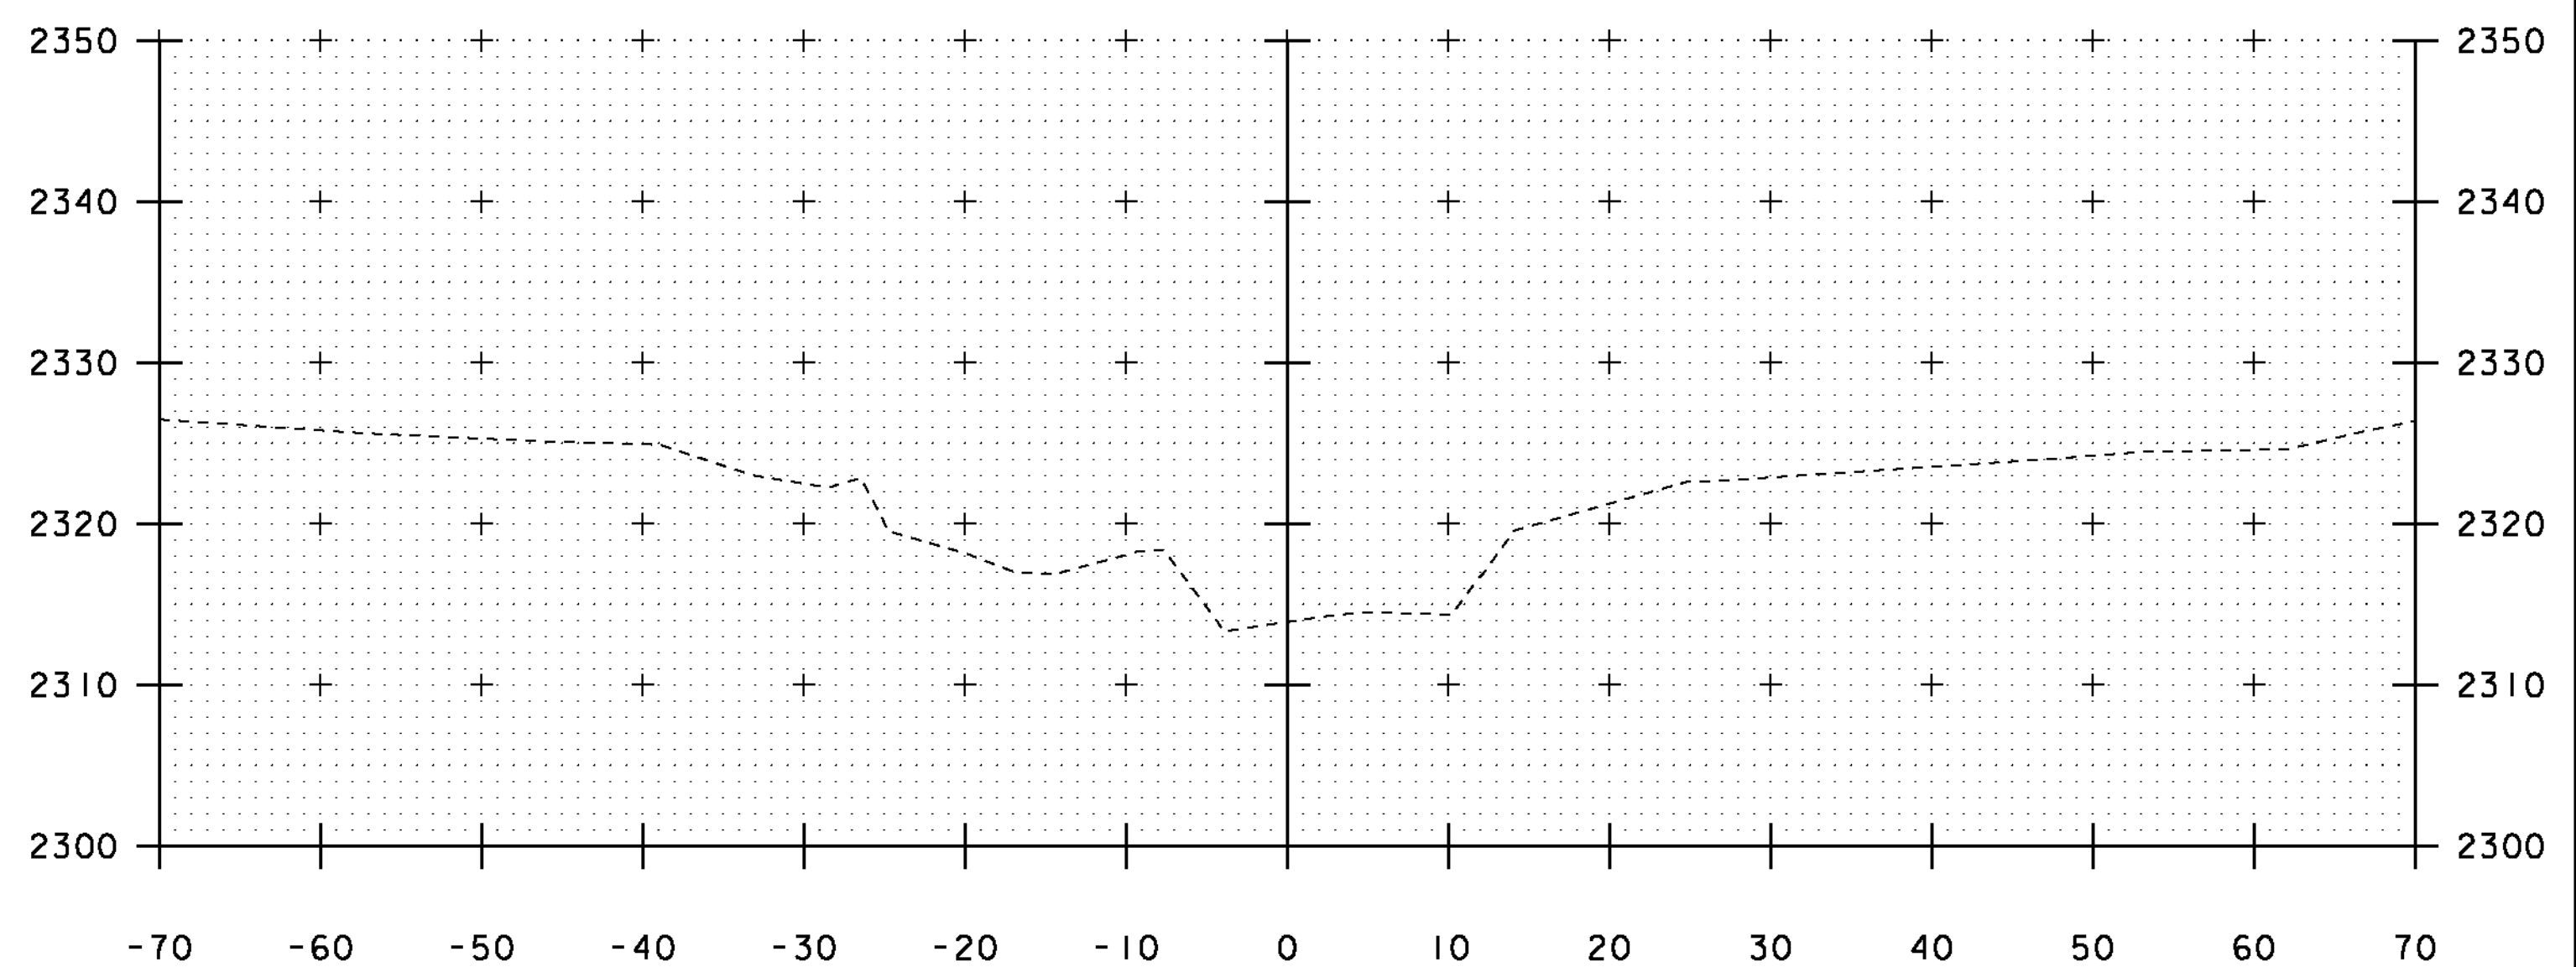

11+30

STA. 11+10 TO STA. 11+30

| | |
|-------------------------|-------------------|
| PROJECT NAME: | SEARSBURG |
| PROJECT NUMBER: | STP SCR(7) |
| FILE NAME: | d:\0c198_xsec.dgn |
| PROJECT LEADER: | K. UPMAL |
| DESIGNED BY: | B. MCADAMS |
| CHANNEL CROSS SECTIONS: | 4 |
| PLOT DATE: | 27-FEB-2013 |
| DRAWN BY: | B. MCADAMS |
| CHECKED BY: | A. KEMPTON |
| SHEET: | 35 OF 35 |