



TYPICAL SECTIONS

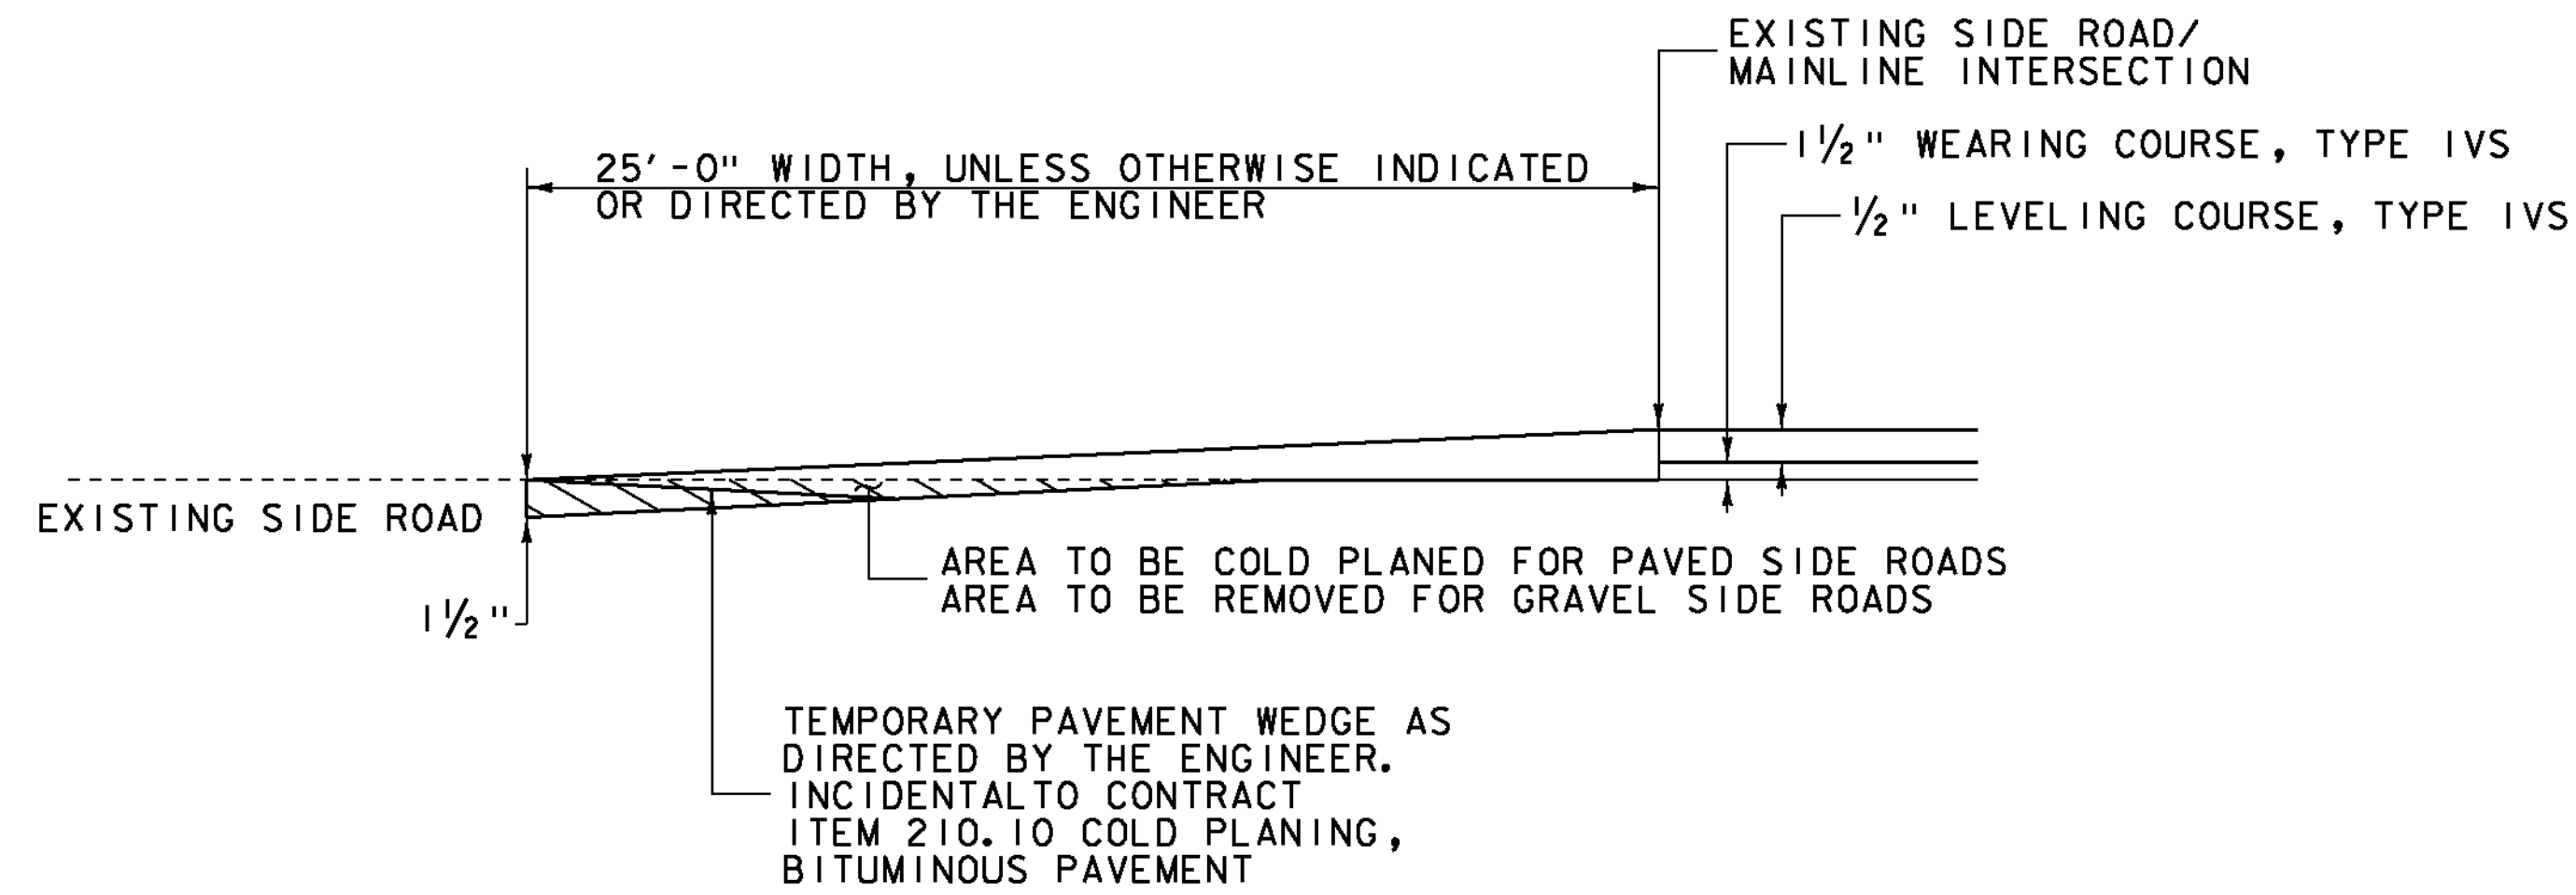

SIDE ROAD TRANSITION IN LEVEL AND OVERLAY AREAS


NOT TO SCALE

SEE LAYOUT SHEETS FOR LOCATIONS

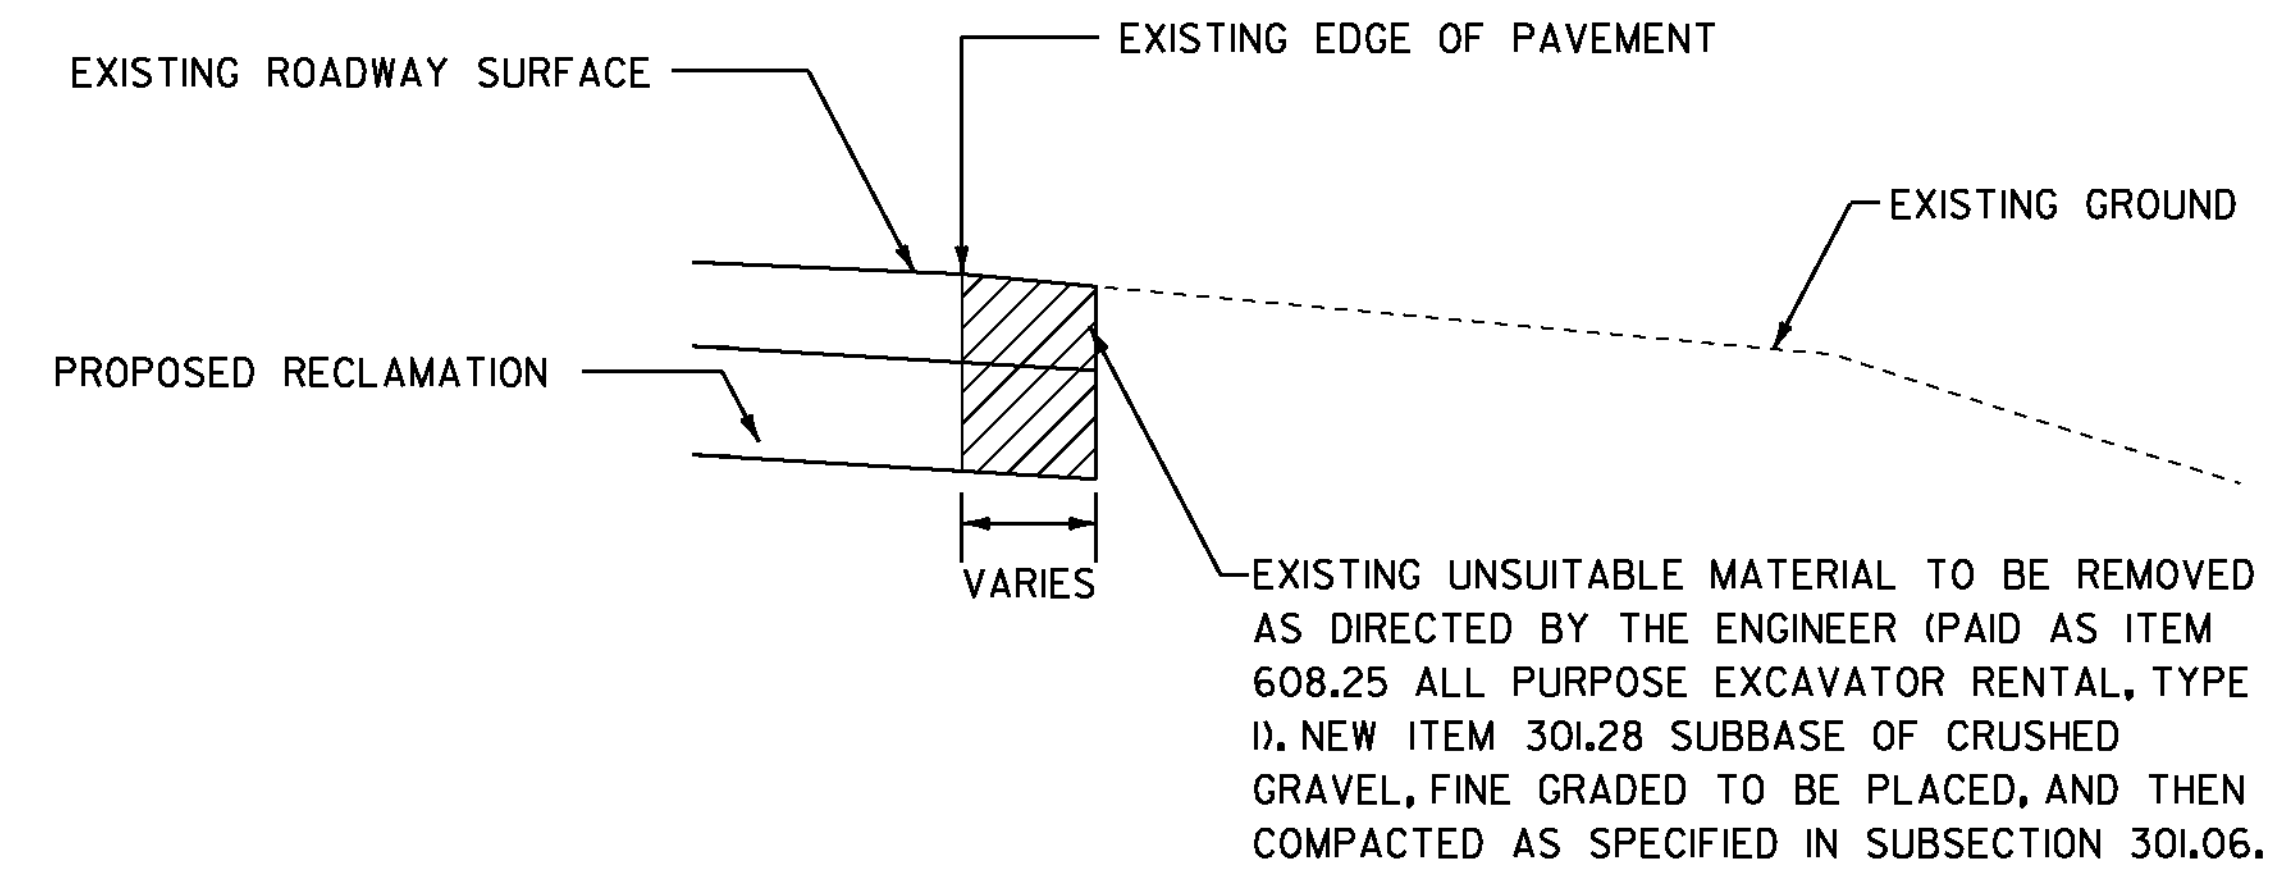

EXISTING SHOULDER RECONSTRUCTION DETAIL

NOT TO SCALE

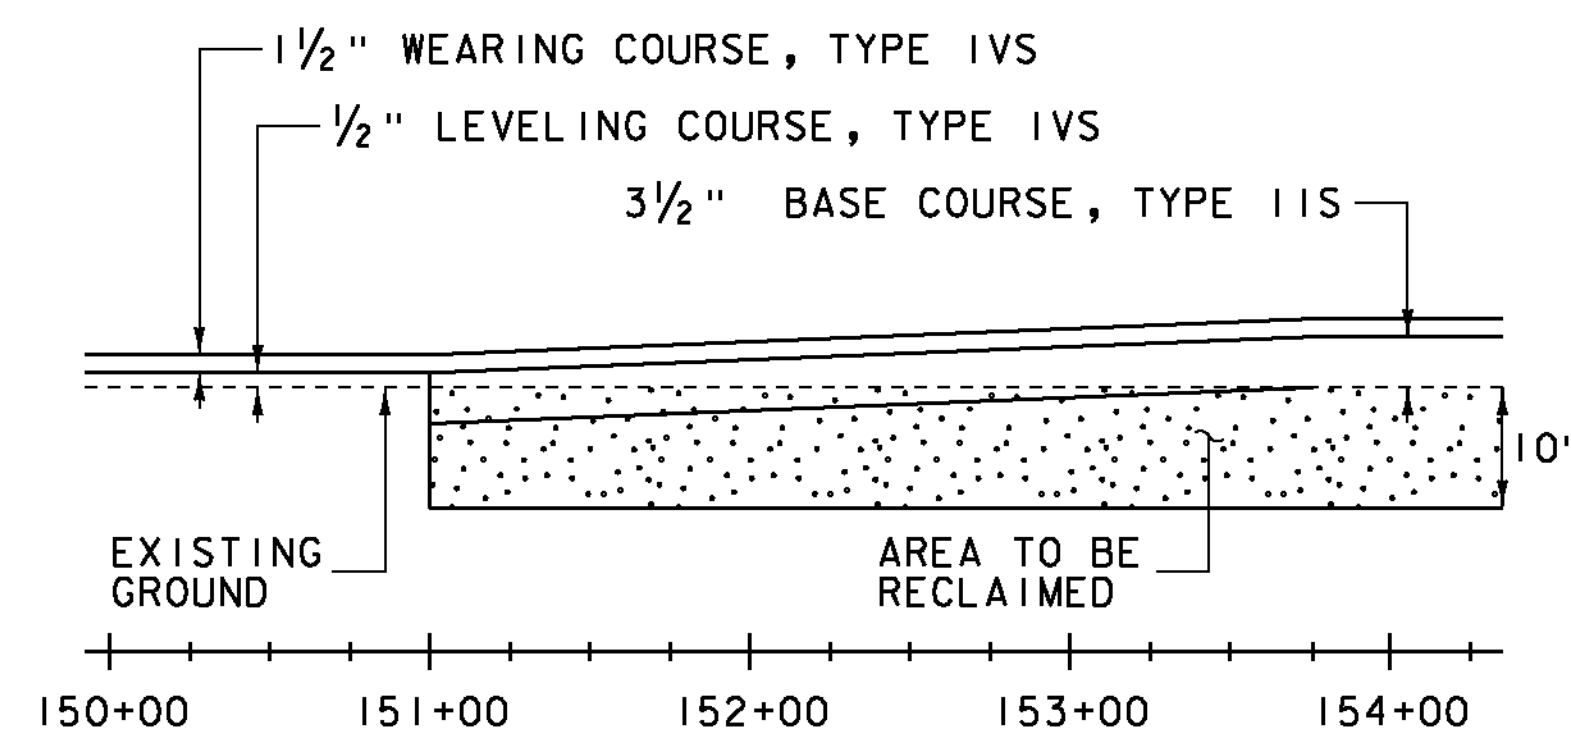


LEVEL AND OVERLAY TO RECLAIM TRANSITION DETAIL

NOT TO SCALE

SUDBURY

STA. 151+00.00 - STA. 153+75.00

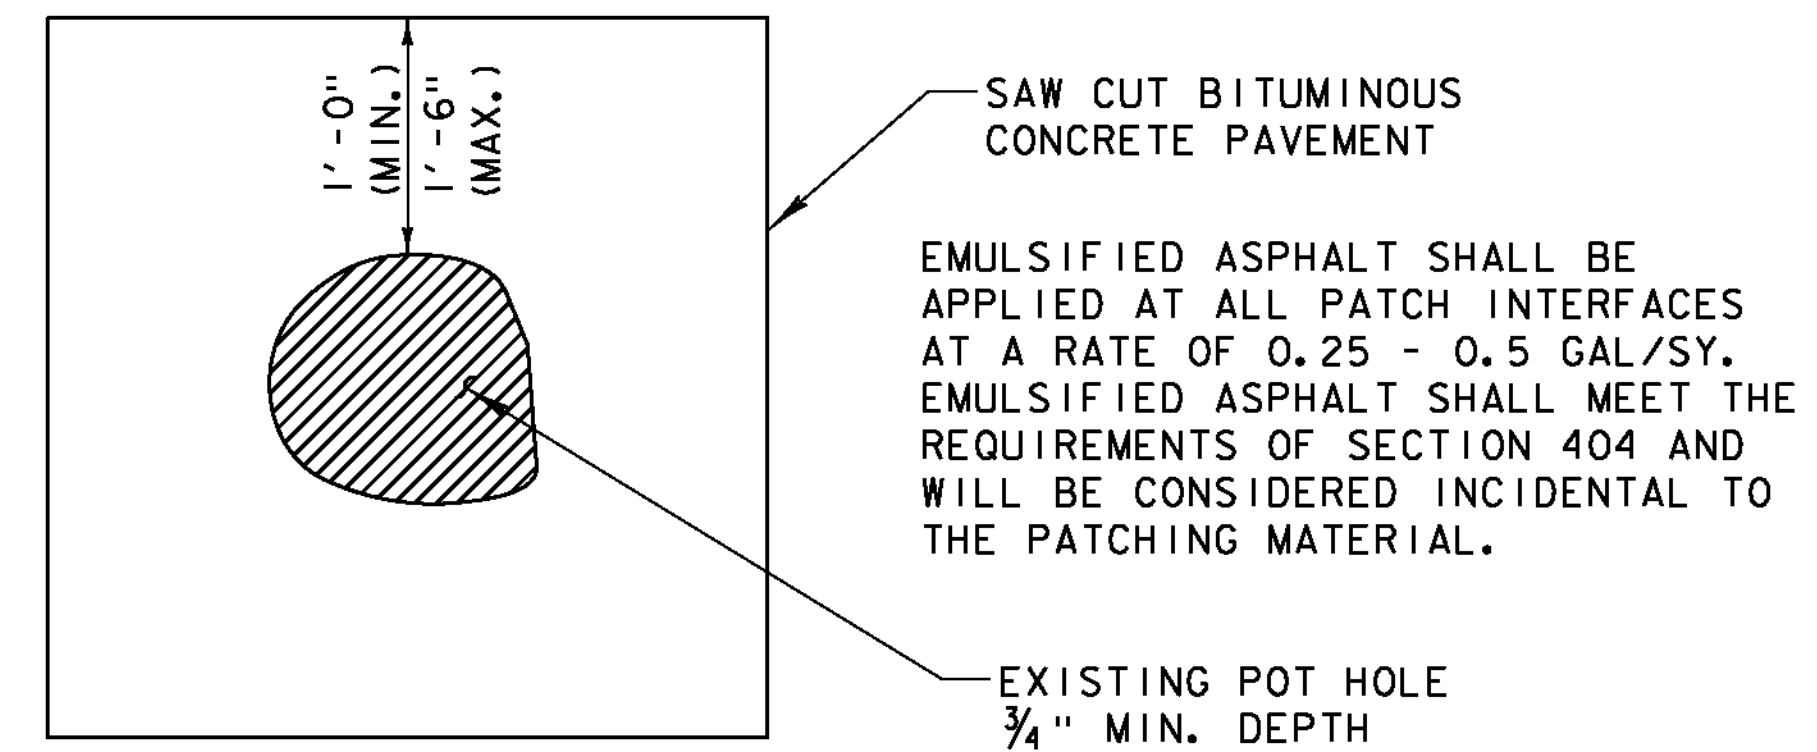

POT HOLE REPAIR DETAIL

NOT TO SCALE

NOTE: SAW CUTTING BITUMINOUS CONCRETE PAVEMENT SHALL BE INCIDENTAL TO ITEM 900.680 SPECIAL PROVISION (BITUMINOUS CONCRETE PAVEMENT SURFACE PREPARATION, TYPE 1)

PROJECT NAME: SUDBURY-BRANDON

PROJECT NUMBER: STP 0158(3)

FILE NAME: dl0c204.typ.dgn

PROJECT LEADER: K. UPMAL

DESIGNED BY: B. MCADAMS

TYPICAL SECTION SHEET 3

PLOT DATE: 13-FEB-2013

DRAWN BY: B. MCADAMS

CHECKED BY: A. KEMPTON

SHEET 5 OF 137