



LOCATION				FEET OF DITCHING			MISC. ITEMS			REMARKS	LOCATION				FEET OF DITCHING			MISC. ITEMS			REMARKS
SITE	STA.	STA.	POS.	PERCENT GRADE			653.20 TEMP. EROS. MATT.	613.10 STONE FILL TYP. 1	649.31 GEOT. UNDER STONE FILL		SITE	STATION	STATION	POS.	PERCENT GRADE			653.20 TEMP. EROS. MATT.	613.10 STONE FILL TYP. 1	649.31 GEOT. UNDER STONE FILL	
				0-1	1-2.5	2.5-10									0-1	1-2.5	2.5-10				
							SY	CY	SY									SY	CY	SY	
VT 73 SUDBURY																					
1	22+05	27+00	LT		495		234														
2	31+00	31+80	LT		80		37														
3	34+10	35+54	LT			144		24	96												
4	58+40	59+50	LT		110		52														
5	61+00	63+00	LT		200		95														
6	68+26	74+35	LT			669		112	446												
	70+16	72+84						24.8	178.67												
7	85+00	88+00	LT		300		142														
8	90+00	101+00	RT		1100		519														
9	119+10	127+00	LT			790		132	526												
	118+78	126+62						81.3	353.78												
SUBTOTAL					2285	1603	1079	268	1068												
ROUNDING							21	2	12												
TOTAL					2285	1603	1100	270	1080												

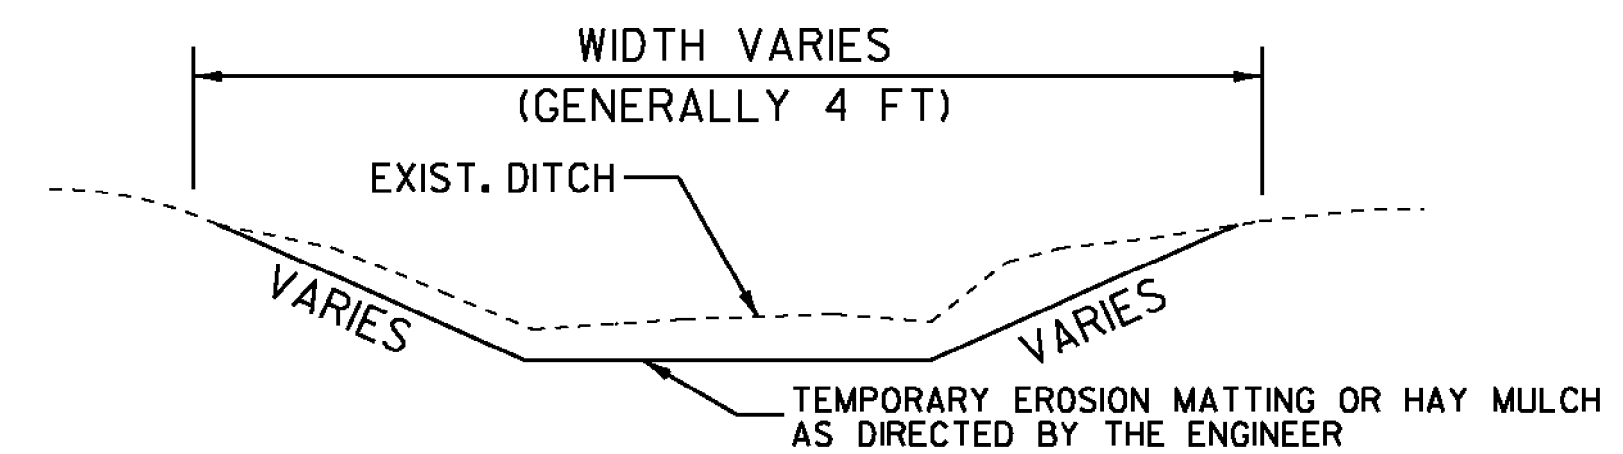

**DITCH DETAIL 0 - 2.5 PERCENT
NOT TO SCALE**

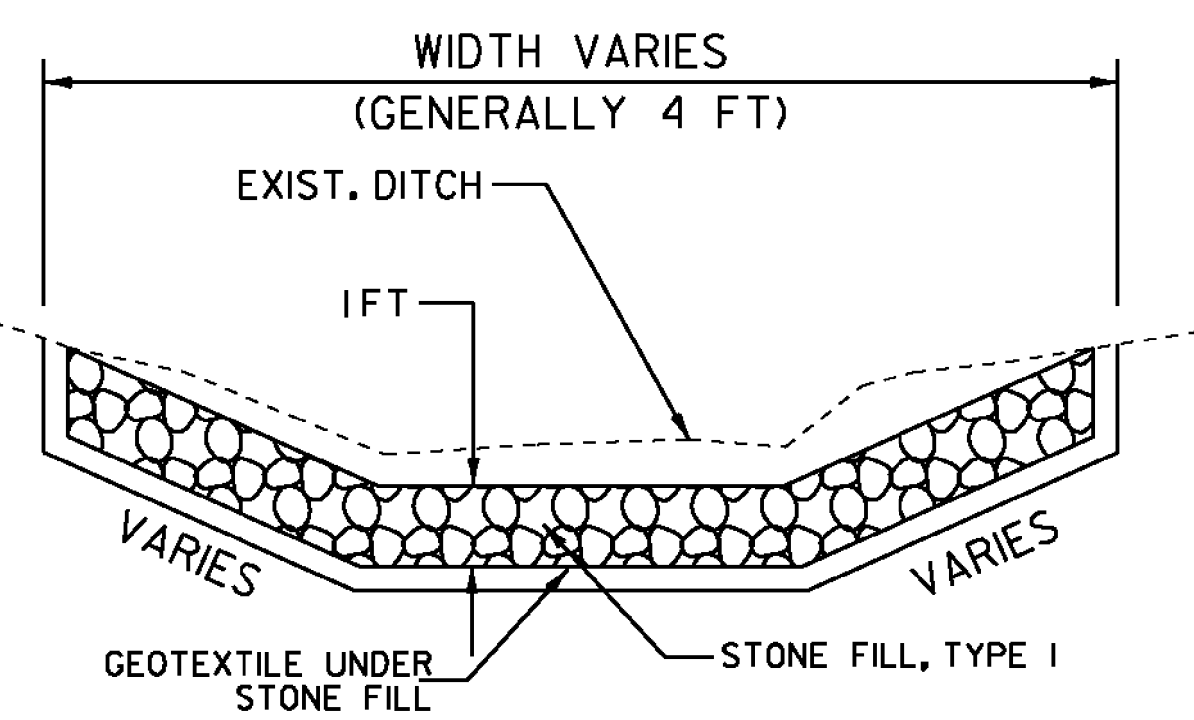

**DITCH DETAIL ≥ 2.5 PERCENT
NOT TO SCALE**

- NOTES:**
- EXCAVATION OF PIPE INLET AND OUTLET AREAS AND DITCH CLEANING THROUGHOUT THE PROJECT SHALL BE PERFORMED AT LOCATIONS IDENTIFIED ON THIS SHEET AND AS DIRECTED BY THE ENGINEER. PAYMENT WILL BE UNDER THE APPLICABLE EQUIPMENT RENTAL ITEM(S).
 - GRADES LESS THAN 1 PERCENT SHALL USE ITEM 651.15, SEED AND ITEM 651.25, HAY MULCH. GRADES BETWEEN 1 AND 2.5 PERCENT SHALL USE ITEM 651.25, HAY MULCH OR ITEM 653.20, TEMPORARY EROSION MATTING AS DIRECTED BY THE RESIDENT ENGINEER. GRADES OVER 2.5 PERCENT SHALL USE ITEM 649.31, GEOTEXTILE UNDER STONE FILL AND ITEM 613.10, STONE FILL TYPE 1 AS DIRECTED BY THE RESIDENT ENGINEER.

NOT TO SCALE

PROJECT NAME: SUDBURY-BRANDON
PROJECT NUMBER: STP 0158(3)
FILE NAME: d10c204_frm.dgn PLOT DATE: 13-FEB-2013
PROJECT LEADER: K. UPMAL DRAWN BY: B. MCADAMS
DESIGNED BY: B. MCADAMS CHECKED BY: B. KIPP
DITCH CLEANING DETAIL SHEET 12 OF 137