

613.10 STONE FILL, TYPE I
STA 34+10 TO 35+50 LT

DURABLE 4 INCH WHITE LINE (SEE OPTION AA)
DURABLE 4 INCH YELLOW LINE (SEE OPTION BB)
STA 30+00 TO 35+50 RT & LT

DURABLE LETTER OR SYMBOL (SEE OPTION DD)
STA 33+40 RT "SCHOOL"

646.602 TEMPORARY 4 INCH WHITE LINE, PAINT
646.612 TEMPORARY 4 INCH YELLOW LINE, PAINT
STA 30+00 TO 35+50 RT & LT



649.31 GEOTEXTILE UNDER STONE FILL
STA 34+10 TO 35+50 LT

675.20 TRAFFIC SIGN, TYPE A
STA 33+99 RT

675.341 SQUARE TUBE SIGN POST AND ANCHOR
STA 33+99 RT

675.50 REMOVING SIGNS
STA 33+99 RT

900.675 SPECIAL PROVISION
(HAND-PLACED BITUMINOUS CONCRETE MATERIAL, DRIVES)
STA 30+92 LT
STA 32+06 LT
STA 33+92 LT
STA 35+10 RT

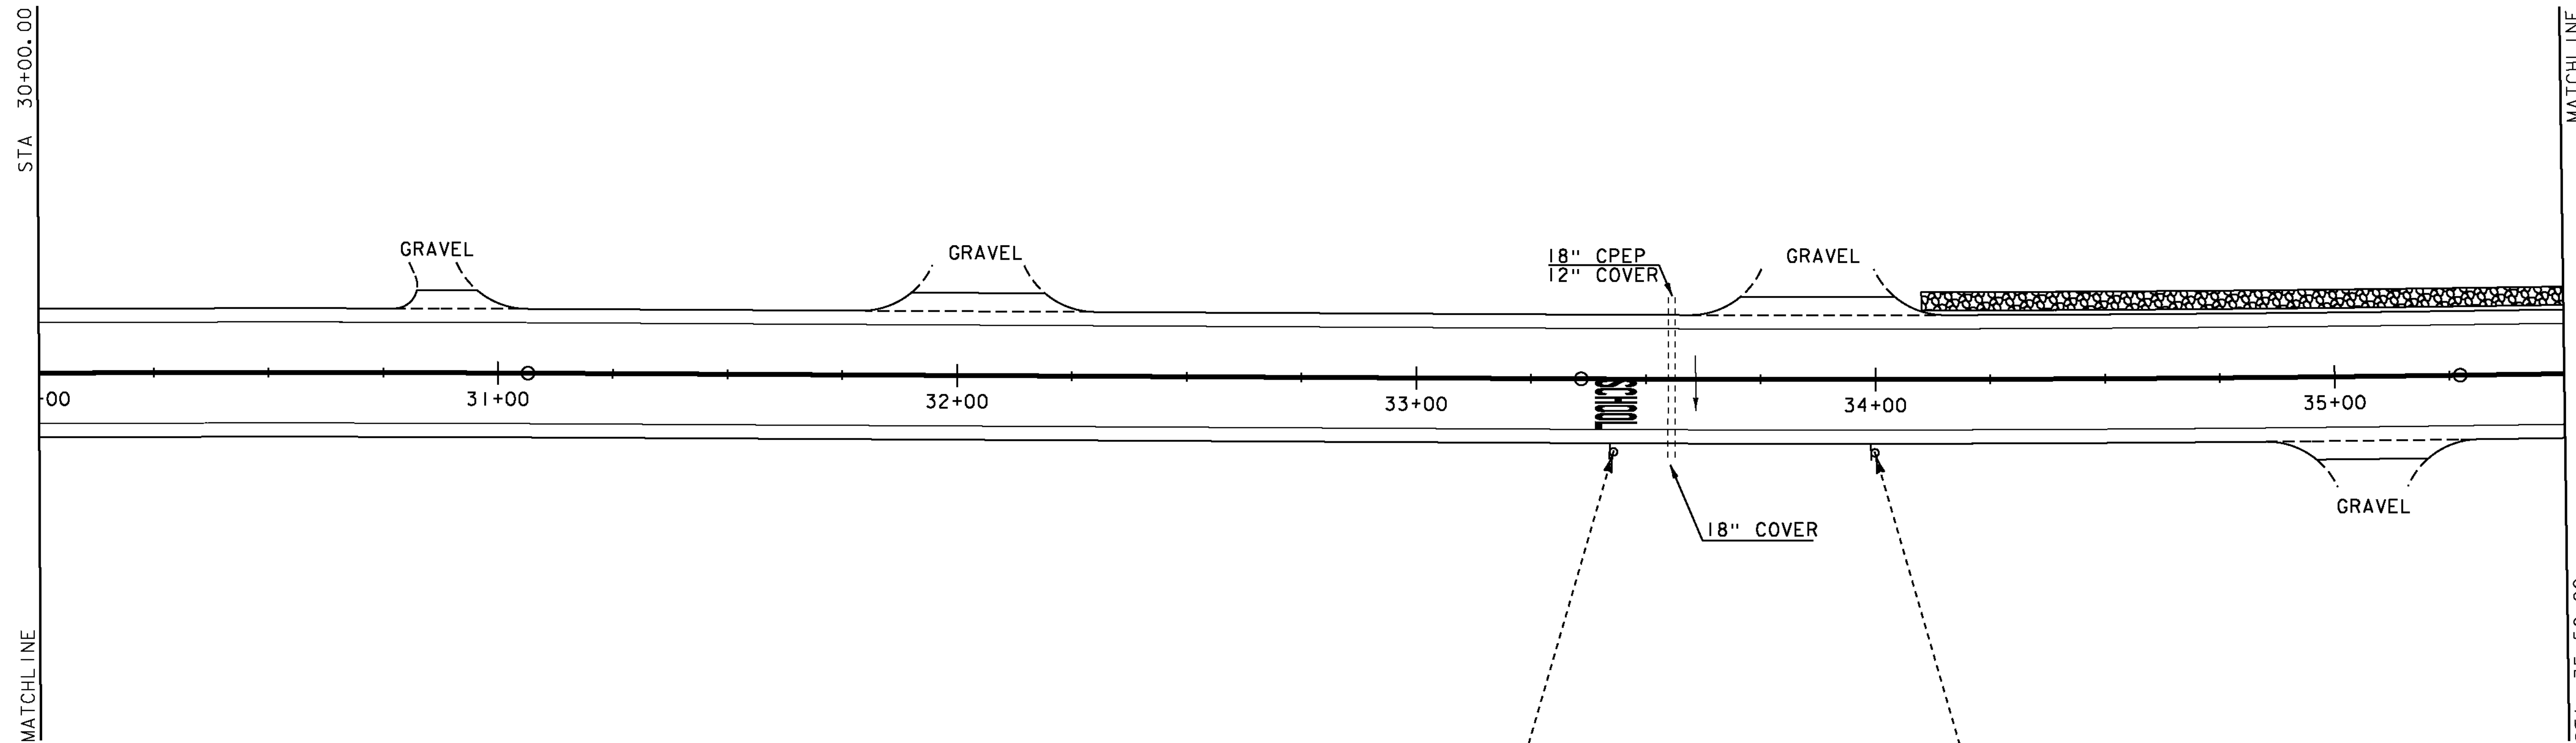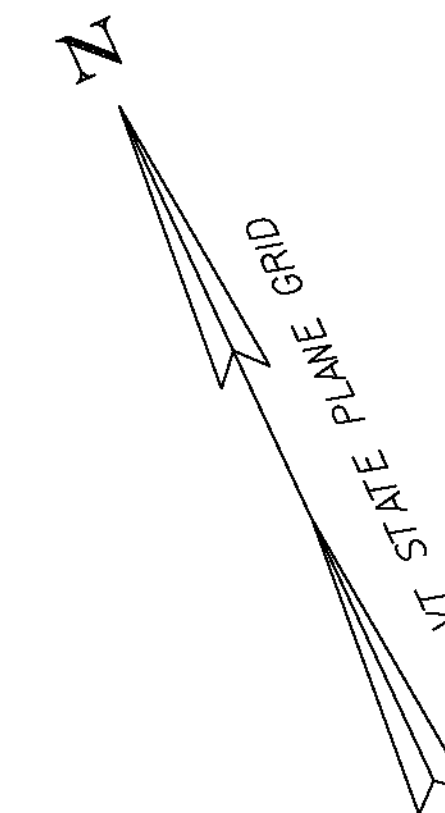

SIGN LEGEND
 R = REMOVE
 S = SALVAGE
 N = NEW
 RET = RETAIN
 T&T = THINNING & TRIMMING
 B-B = BACK TO BACK
 EXISTING = DASHED LINE
 NEW = SOLID LINE

PROJECT NAME:	SUDBURY - BRANDON	FILE NAME:	d10c204_bdr.dgn	PLOT DATE:	13-FEB-2013
PROJECT NUMBER:	STP 0158(3)	PROJECT LEADER:	K. UPMAL	DRAWN BY:	B. MCADAMS
		DESIGNED BY:	B. MCADAMS	CHECKED BY:	A. KEMPTON
		LAYOUT 3		SHEET	21 OF 137