

613.10 STONE FILL, TYPE I  
 STA 74+00 TO 74+95 LT

DURABLE 4 INCH WHITE LINE (SEE OPTION AA)  
 STA 74+00 TO 74+84 RT  
 STA 74+00 TO 75+21 LT  
 STA 75+23 TO 79+50 RT  
 STA 75+42 TO 79+50 LT

DURABLE 4 INCH YELLOW LINE (SEE OPTION BB)  
 STA 74+00 TO 74+85 RT & LT (CENTERLINE)  
 STA 75+50 TO 79+50 RT & LT (CENTERLINE)  
 STA 75+05 RT (CENTERLINE TH #13)  
 STA 75+30 LT (CENTERLINE TH #11)

DURABLE 24 INCH STOP BAR (SEE OPTION CC)  
 STA 75+04 TO 75+23 RT (TH #13)  
 STA 75+09 TO 75+32 LT (TH #11)

DURABLE LETTER OR SYMBOL (SEE OPTION DD)  
 STA 75+08 RT "STOP" (TH #13)  
 STA 75+24 LT "STOP" (TH #11)

646.602 TEMPORARY 4 INCH WHITE LINE, PAINT  
 646.612 TEMPORARY 4 INCH YELLOW LINE, PAINT  
 STA 74+00 TO 79+50 RT & LT



649.31 GEOTEXTILE UNDER STONE FILL  
 STA 74+00 TO 74+95 LT

675.20 TRAFFIC SIGN, TYPE A  
 STA 75+20 LT (3)  
 STA 75+23 RT (2)  
 STA 75+34 RT  
 STA 75+65 LT  
 STA 76+05 RT (3)

675.341 SQUARE TUBE SIGN POST AND ANCHOR  
 STA 75+20 LT  
 STA 75+34 RT (2)  
 STA 76+05 RT (2)

675.50 REMOVING SIGNS  
 STA 74+75 RT  
 STA 75+20 LT (2)  
 STA 75+23 RT (2)  
 STA 75+65 LT  
 STA 75+70 LT  
 STA 76+05 RT (3)

SIDE ROAD  
 STA 75+05 RT (TH #13)  
 STA 75+30 LT (TH #11)

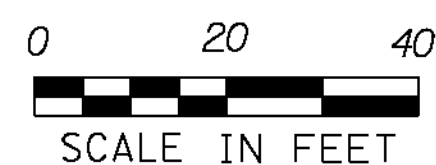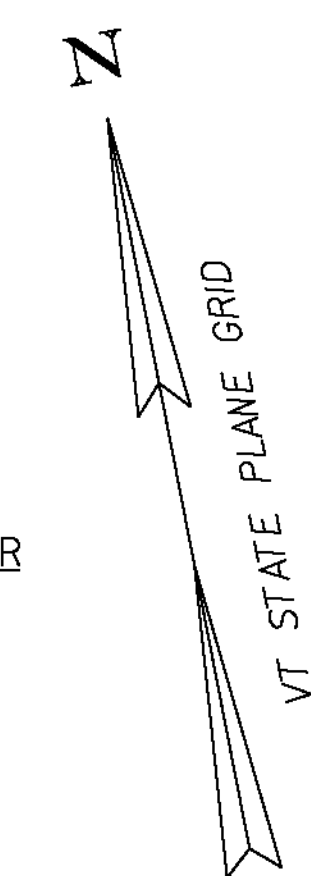

**SIGN LEGEND**

R	= REMOVE
S	= SALVAGE
N	= NEW
RET	= RETAIN
T&T	= THINNING & TRIMMING
B-B	= BACK TO BACK
EXISTING	-----
NEW	_____

PROJECT NAME:	SUDBURY - BRANDON
PROJECT NUMBER:	STP 0158(3)
FILE NAME:	d:\0c204.bdr.dgn
PROJECT LEADER:	K. UPMAL
DESIGNED BY:	B. MCADAMS
LAYOUT II	
PLOT DATE:	13-FEB-2013
DRAWN BY:	B. MCADAMS
CHECKED BY:	A. KEMPTON
SHEET	29 OF 137