

621.20 STEEL BEAM GUARDRAIL, GALVANIZED
STA 151+00 TO 153+47 RT

621.51 MANUFACTURED TERMINAL SECTION, TANGENT
STA 153+47 TO 153+97 RT

621.80 REMOVAL AND DISPOSAL OF GUARDRAIL
STA 151+00 TO 153+47 RT

DURABLE 4 INCH WHITE LINE (SEE OPTION AA)
STA 151+00 TO 156+50 RT & LT

DURABLE 4 INCH YELLOW LINE (SEE OPTION BB)
STA 151+00 TO 156+50 RT (DASHED, CENTERLINE)
STA 151+00 TO 156+50 LT (CENTERLINE)



646.602 TEMPORARY 4 INCH WHITE LINE, PAINT
STA 151+00 TO 156+50 RT & LT

646.612 TEMPORARY 4 INCH YELLOW LINE, PAINT
STA 151+00 TO 156+50 RT (DASHED)
STA 151+00 TO 156+50 LT

675.612 REMOVING SIGNS
STA. 155+46 RT

SIGN LEGEND

- R = REMOVE
- S = SALVAGE
- N = NEW
- RET = RETAIN
- T&T = THINNING & TRIMMING
- B-B = BACK TO BACK
- EXISTING = DASHED LINE
- NEW = SOLID LINE

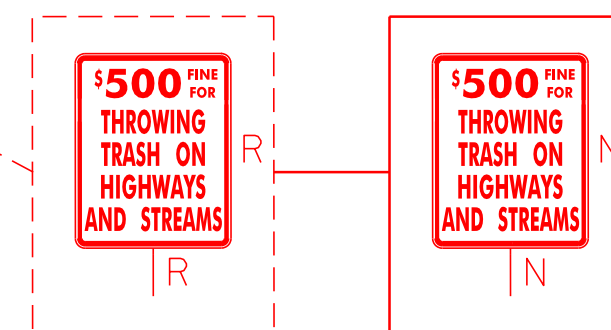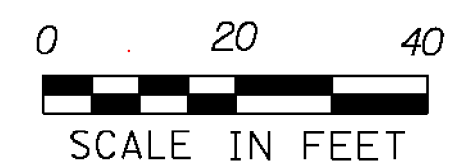

PROJECT NAME: SUDBURY - BRANDON
PROJECT NUMBER: STP 0158(3)

FILE NAME: dl0c204_bdr.dgn
PROJECT LEADER: K. UPMAL
DESIGNED BY: B. MCADAMS
LAYOUT 25

PLOT DATE: 13-FEB-2013
DRAWN BY: B. MCADAMS
CHECKED BY: A. KEMPTON
SHEET 43 OF 137