
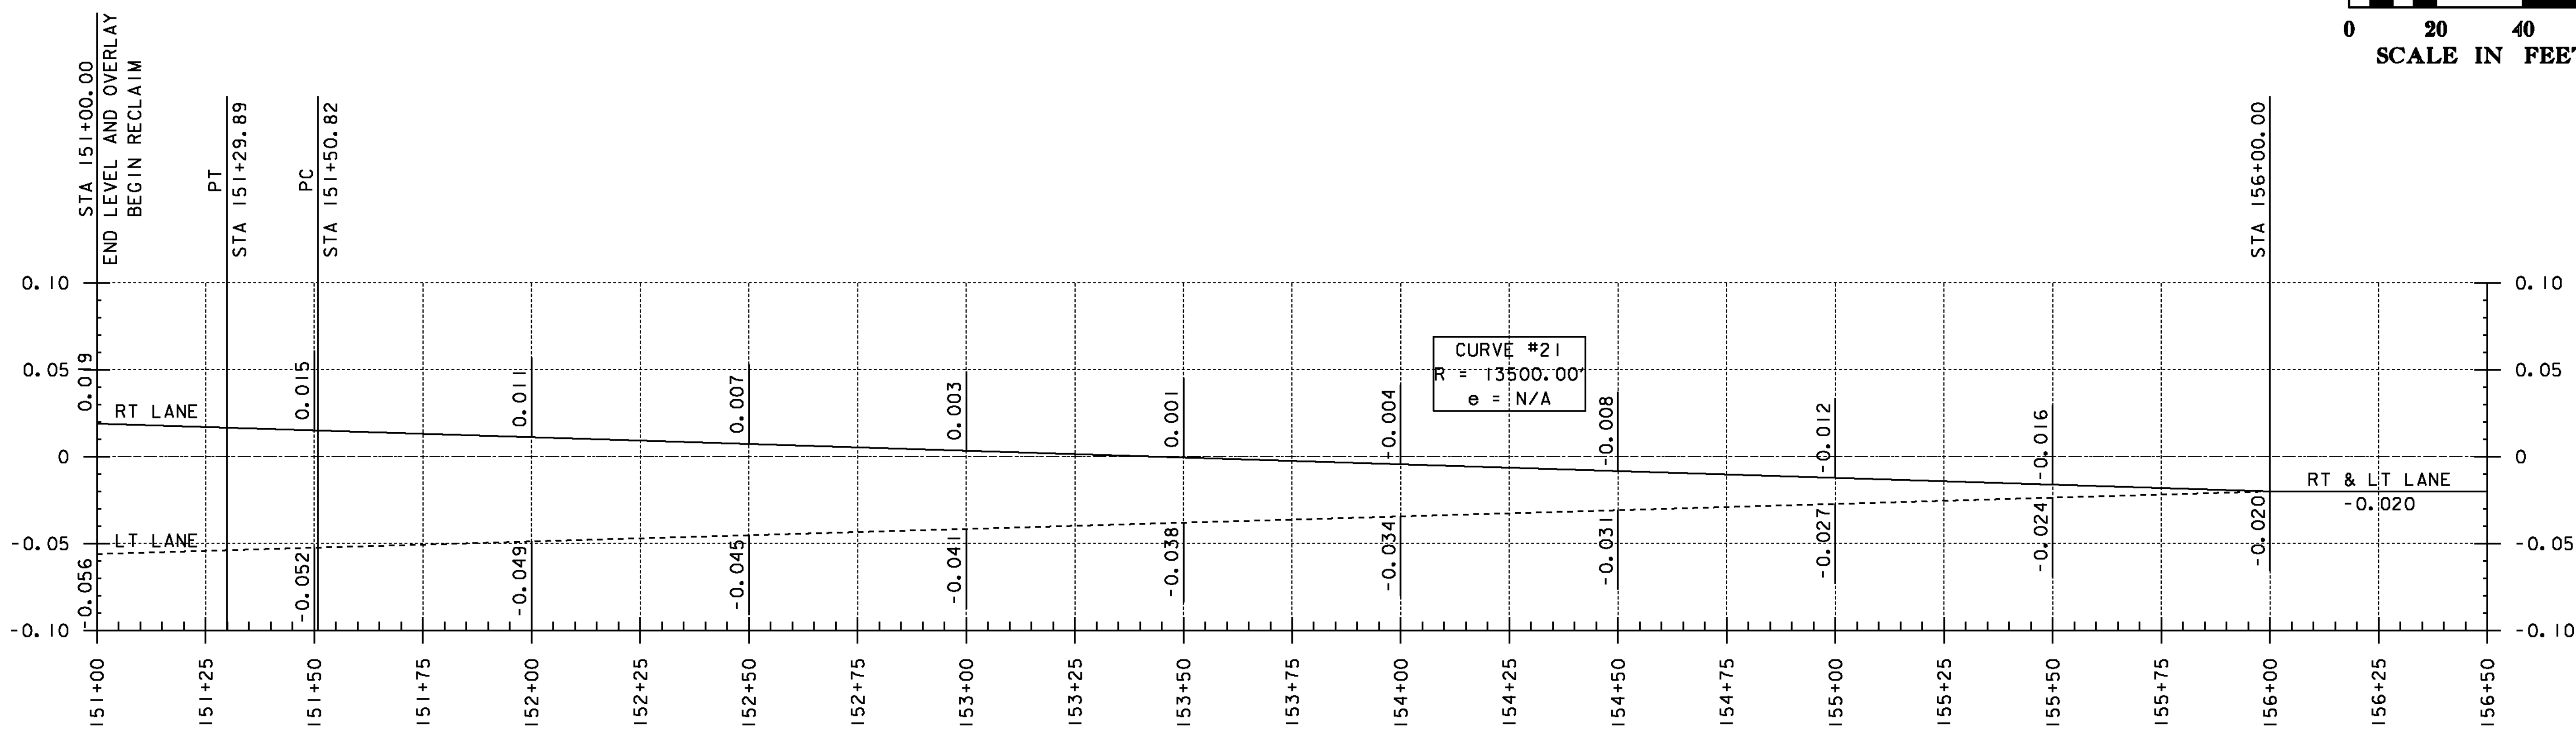


PROFILE

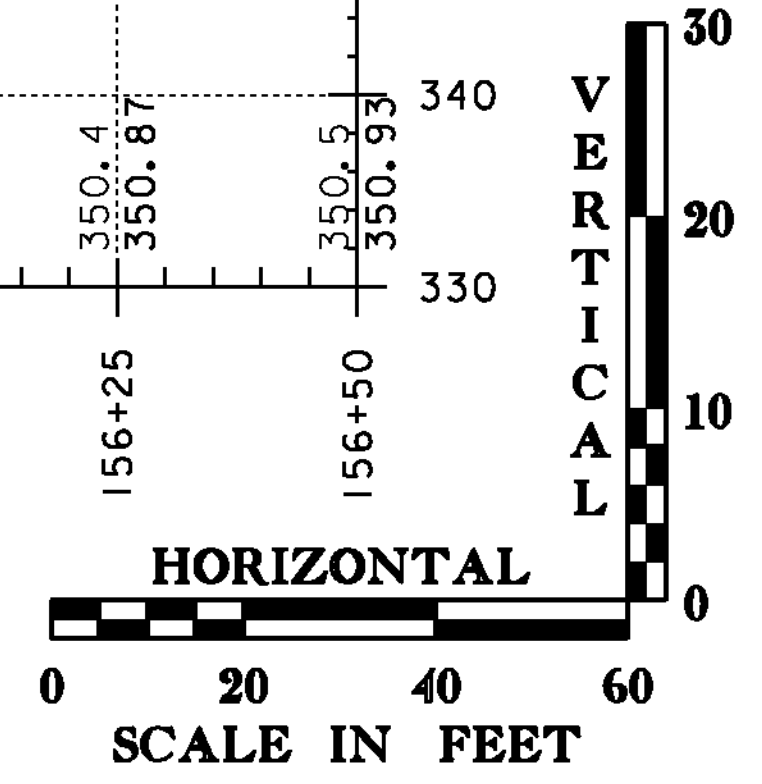

BANKING DIAGRAM

THE GRADES SHOWN TO THE NEAREST TENTH ARE THE ORIGINAL GROUND ELEVATIONS ALONG THE PROPOSED ALIGNMENT. THE GRADES SHOWN TO THE NEAREST HUNDRETH ARE THE FINISHED GRADES FOR THE PROPOSED ALIGNMENT.

PROJECT NAME:	SUDBURY - BRANDON
PROJECT NUMBER:	STP 0158(3)
FILE NAME:	d10c204.pro.dgn
PROJECT LEADER:	K. UPMAL
DESIGNED BY:	B. MCADAMS
VT 73 PROFILE & BANKING DIAGRAM 25	
PLOT DATE:	13-FEB-2013
DRAWN BY:	B. MCADAMS
CHECKED BY:	N. PAPPAS
SHEET	44 OF 137