





621.205 STEEL BEAM GUARDRAIL, GALVANIZED W/8 FEET POSTS  
 STA 26+50 TO 32+00 RT

621.80 REMOVAL AND DISPOSAL OF GUARDRAIL  
 STA 26+50 TO 32+00 RT

DURABLE 4 INCH WHITE LINE (SEE OPTION AA)  
 DURABLE 4 INCH YELLOW LINE (SEE OPTION BB)  
 STA 26+50 TO 32+00 RT & LT

646.602 TEMPORARY 4 INCH WHITE LINE, PAINT  
 646.612 TEMPORARY 4 INCH YELLOW LINE, PAINT  
 STA 26+50 TO 32+00 RT & LT

675.50 REMOVING SIGNS  
 STA 30+00 LT (2)  
 STA 31+87 RT (3)

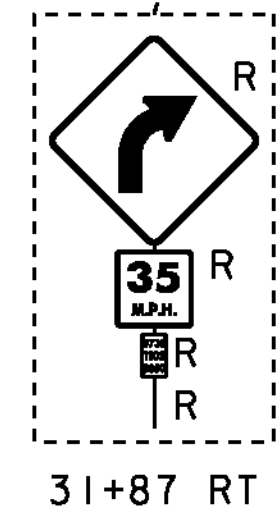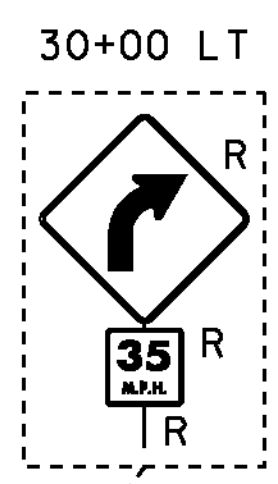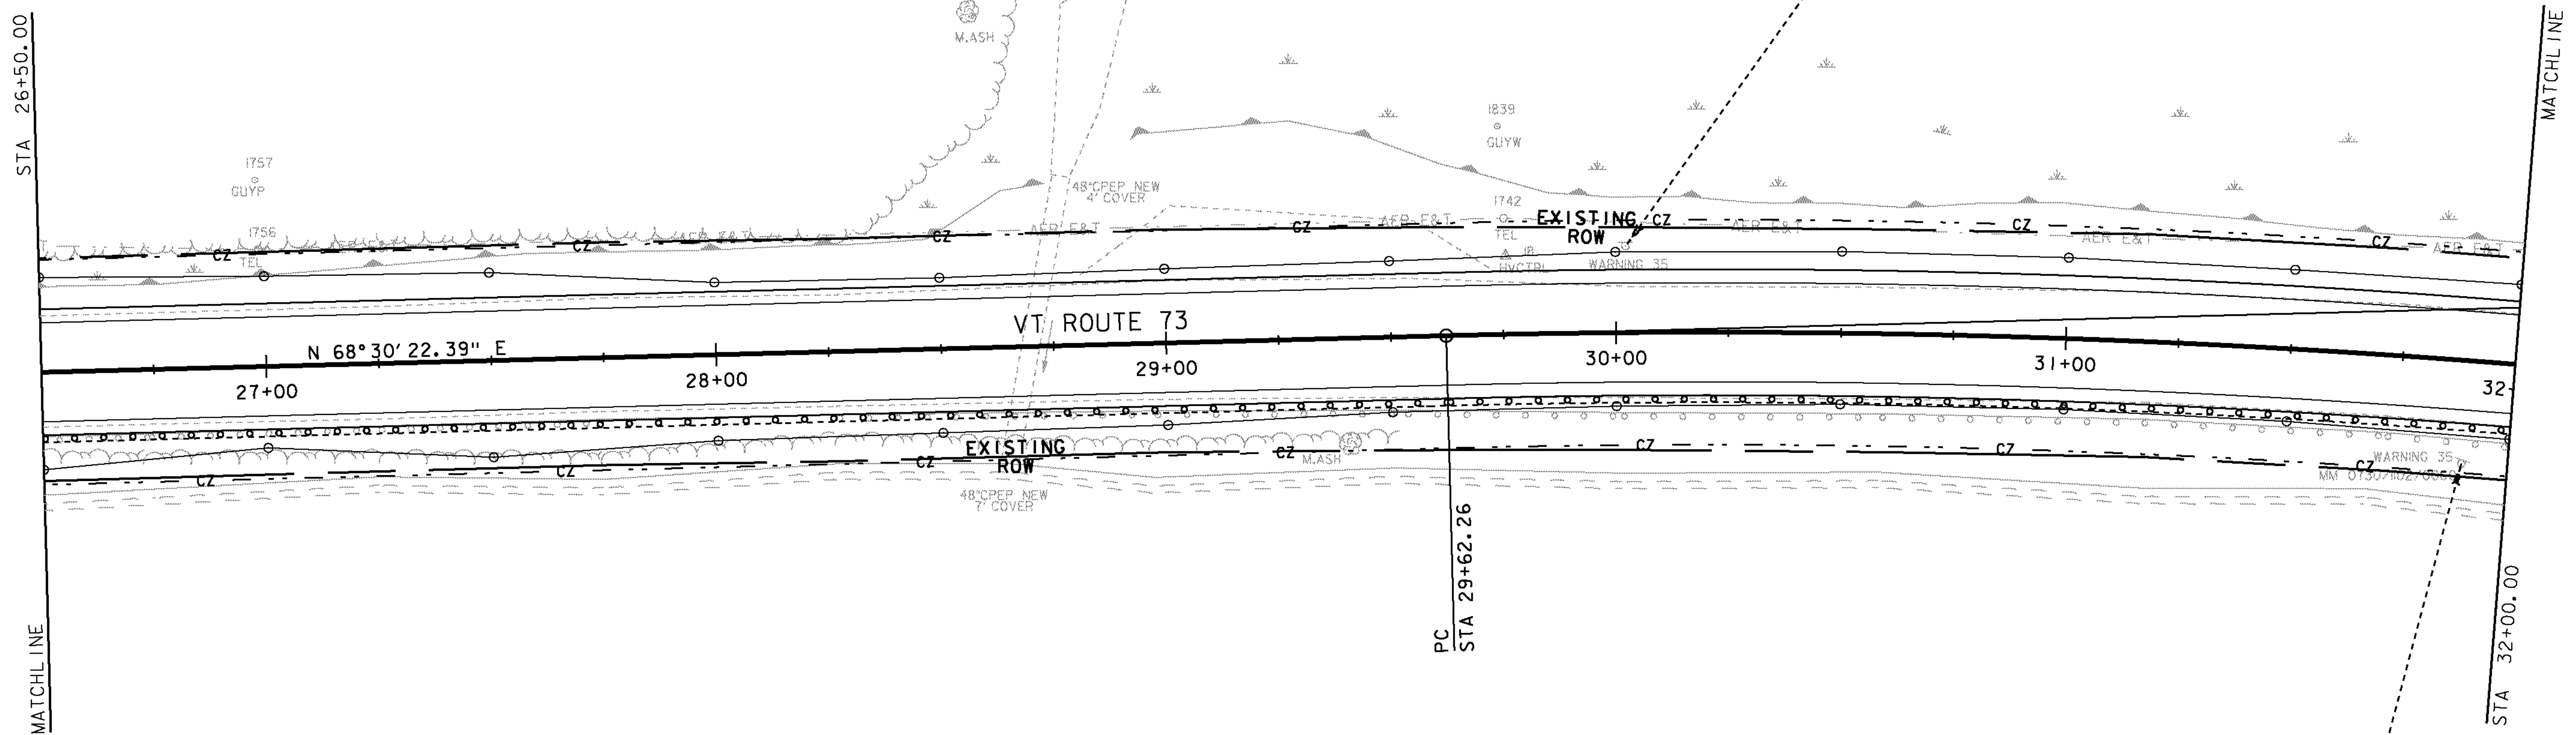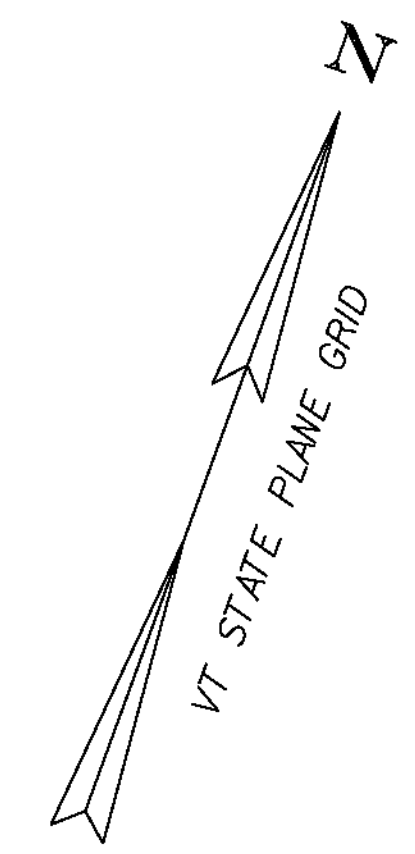

**SIGN LEGEND**

R	= REMOVE
S	= SALVAGE
N	= NEW
RET	= RETAIN
T&T	= THINNING & TRIMMING
B-B	= BACK TO BACK
EXISTING	-----
NEW	-----

PROJECT NAME:	SUDBURY - BRANDON
PROJECT NUMBER:	STP 0158(3)
FILE NAME:	d10c204_bdr.dgn
DESIGNED BY:	B. MCADAMS
LAYOUT	33
PLOT DATE:	13-FEB-2013
DRAWN BY:	B. MCADAMS
CHECKED BY:	A. KEMPTON
SHEET	59 OF 137