
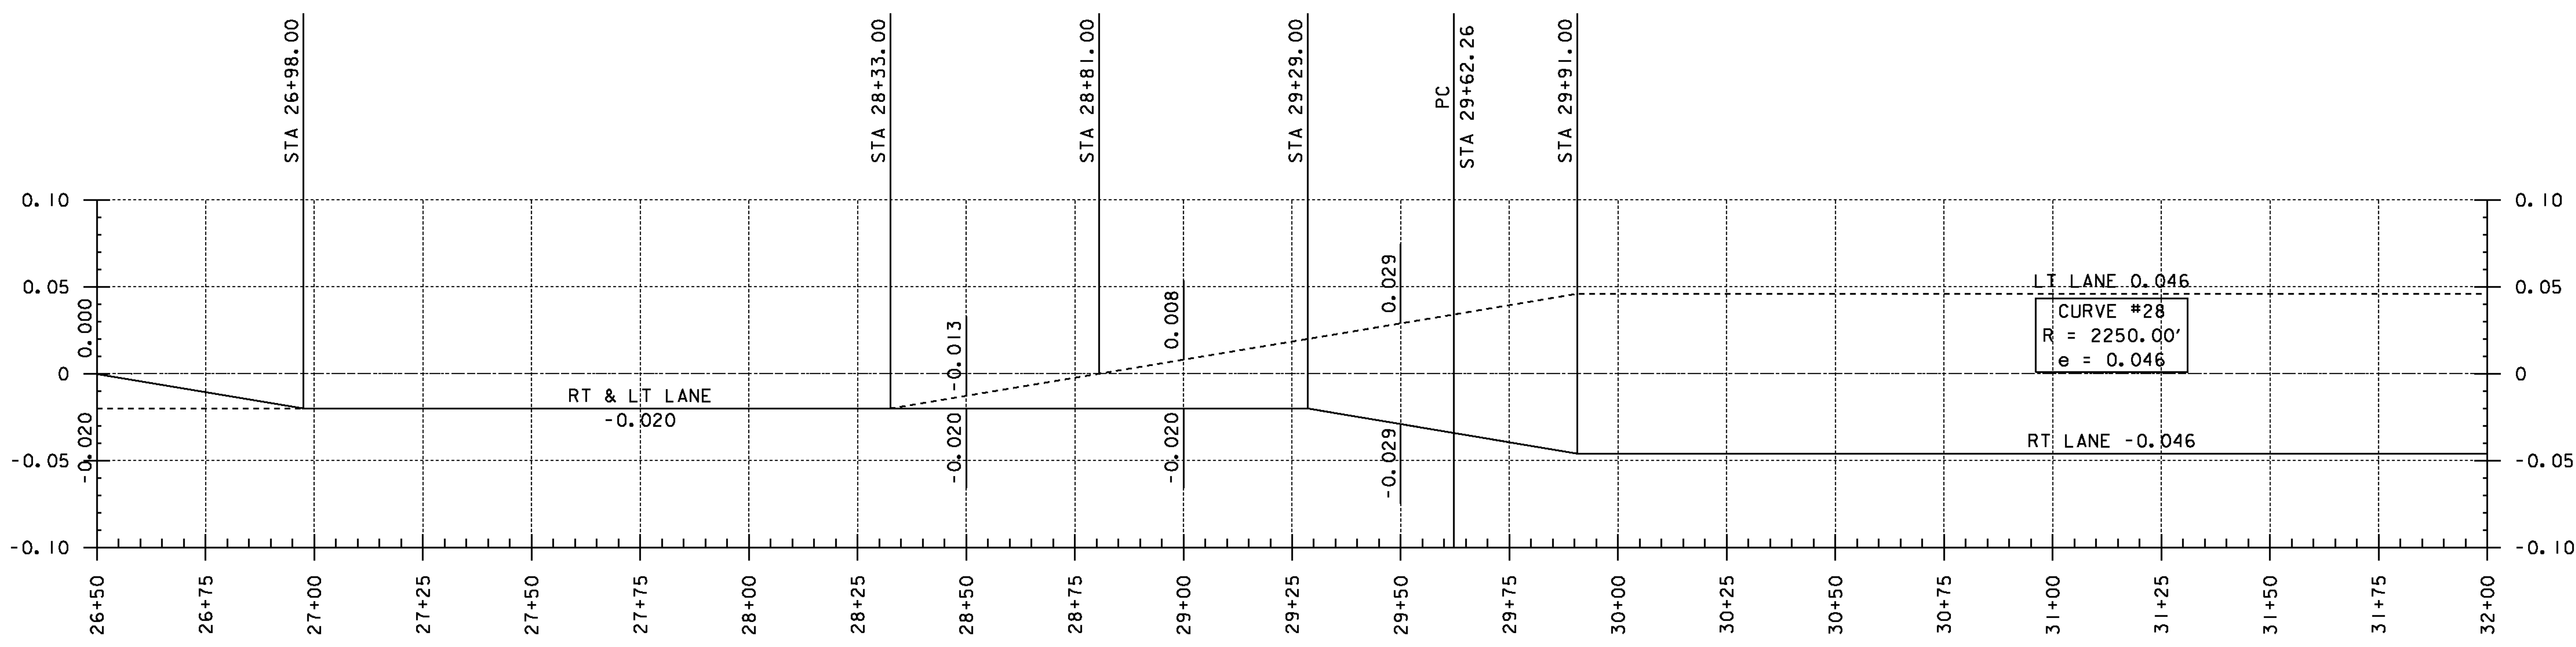


**PROFILE**

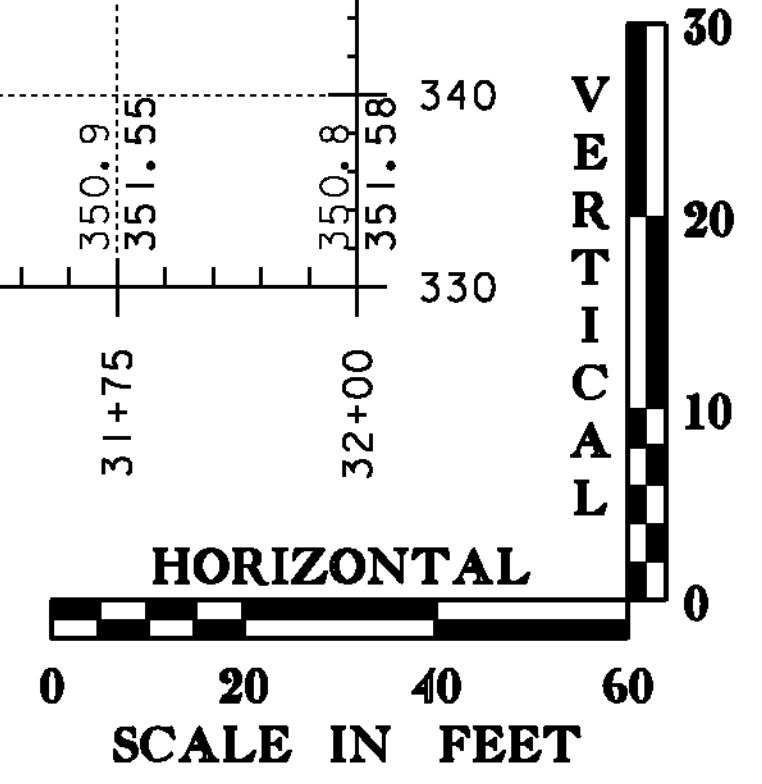

**BANKING DIAGRAM**

THE GRADES SHOWN TO THE NEAREST TENTH ARE THE ORIGINAL GROUND ELEVATIONS ALONG THE PROPOSED ALIGNMENT. THE GRADES SHOWN TO THE NEAREST HUNDRETH ARE THE FINISHED GRADES FOR THE PROPOSED ALIGNMENT.

PROJECT NAME: SUDBURY - BRANDON	PROJECT NUMBER: STP 0158(3)
FILE NAME: dl0c204.pro.dgn	PLOT DATE: 13-FEB-2013
PROJECT LEADER: K. UPMAL	DRAWN BY: B. MCADAMS
DESIGNED BY: B. MCADAMS	CHECKED BY: N. PAPPAS
VT 73 PROFILE & BANKING DIAGRAM 33	SHEET 60 OF 137