

621.20 STEEL BEAM GUARDRAIL, GALVANIZED  
STA 59+41 TO 59+50 RT

621.51 MANUFACTURED TERMINAL SECTION, TANGENT  
STA 58+91 TO 59+41 RT


DURABLE 4 INCH WHITE LINE (SEE OPTION AA)  
DURABLE 4 INCH YELLOW LINE (SEE OPTION BB)  
STA 54+00 TO 59+50 RT & LT

646.602 TEMPORARY 4 INCH WHITE LINE, PAINT  
646.612 TEMPORARY 4 INCH YELLOW LINE, PAINT  
STA 54+00 TO 59+50 RT & LT


675.20 TRAFFIC SIGN, TYPE A  
STA 54+28 RT (2)

675.341 SQUARE TUBE SIGN POST AND ANCHOR  
STA 54+28 RT

900.675 SPECIAL PROVISION  
(HAND-PLACED BITUMINOUS CONCRETE MATERIAL, DRIVES)  
STA 57+84 RT

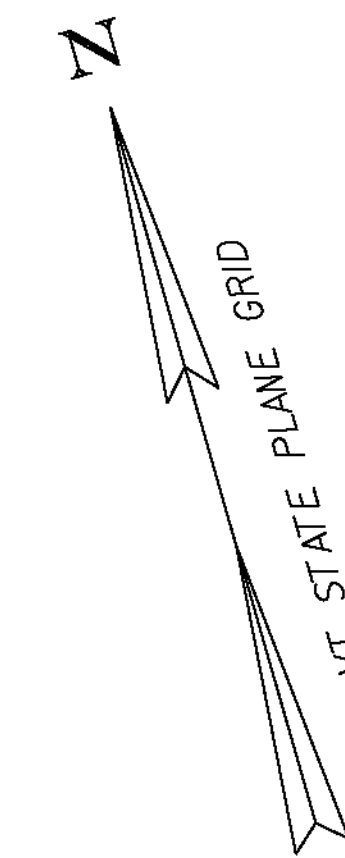

CURVE (33)	
$\Delta$	= 74°31'31"LT
D	= 17°21'44"
R	= 330.00'
T	= 251.05'
L	= 429.23'
E	= 84.64'
BANK	= 0.080

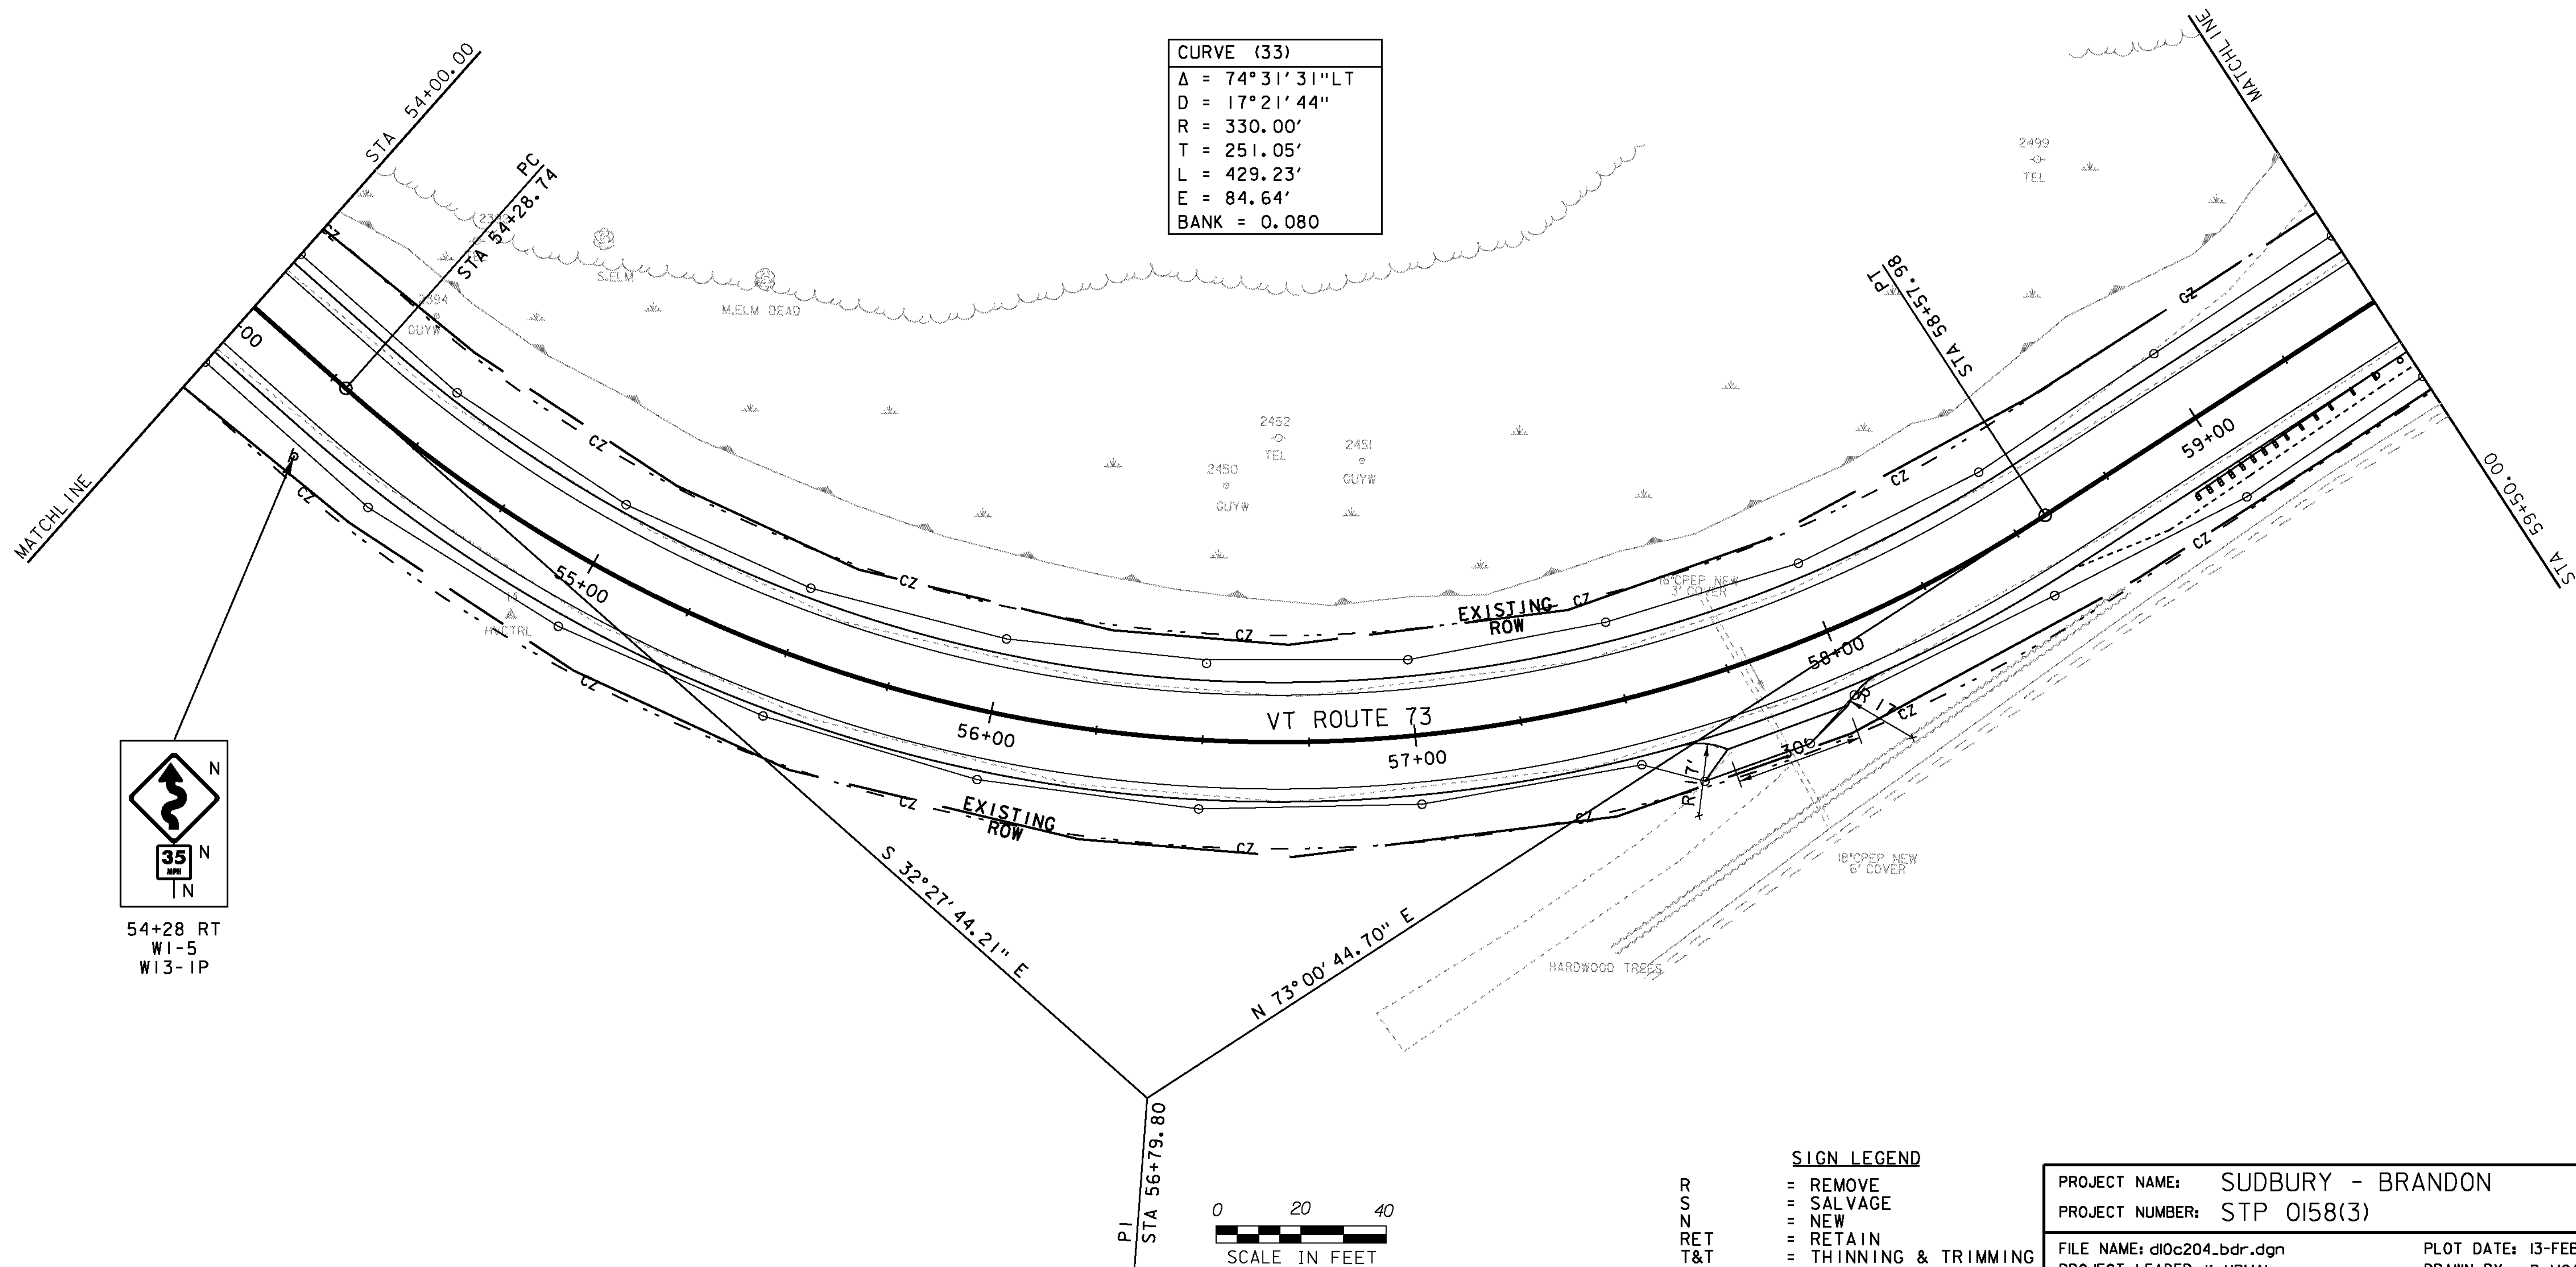

54+28 RT  
W1-5  
W13-1P

SIGN LEGEND	
R	= REMOVE
S	= SALVAGE
N	= NEW
RET	= RETAIN
T&T	= THINNING & TRIMMING
B-B	= BACK TO BACK
EXISTING	-----
NEW	_____

PROJECT NAME:	SUDBURY - BRANDON	FILE NAME:	d10c204.bdr.dgn	PLOT DATE:	13-FEB-2013
PROJECT NUMBER:	STP 0158(3)	PROJECT LEADER:	K. UPMAL	DRAWN BY:	B. MCADAMS
		DESIGNED BY:	B. MCADAMS	CHECKED BY:	A. KEMPTON
		LAYOUT	38	SHEET	69 OF 137