

621.20 STEEL BEAM GUARDRAIL, GALVANIZED
STA 59+50 TO 65+00 RT



DURABLE 4 INCH WHITE LINE (SEE OPTION AA)
DURABLE 4 INCH YELLOW LINE (SEE OPTION BB)
STA 59+50 TO 65+00 RT & LT

646.602 TEMPORARY 4 INCH WHITE LINE, PAINT
646.612 TEMPORARY 4 INCH YELLOW LINE, PAINT
STA 59+50 TO 65+00 RT & LT



675.20 TRAFFIC SIGN, TYPE A
STA 63+60 RT

675.341 SQUARE TUBE SIGN POST AND ANCHOR
STA 63+60 RT

~~675.50 REMOVING SIGNS
STA 63+60 RT~~

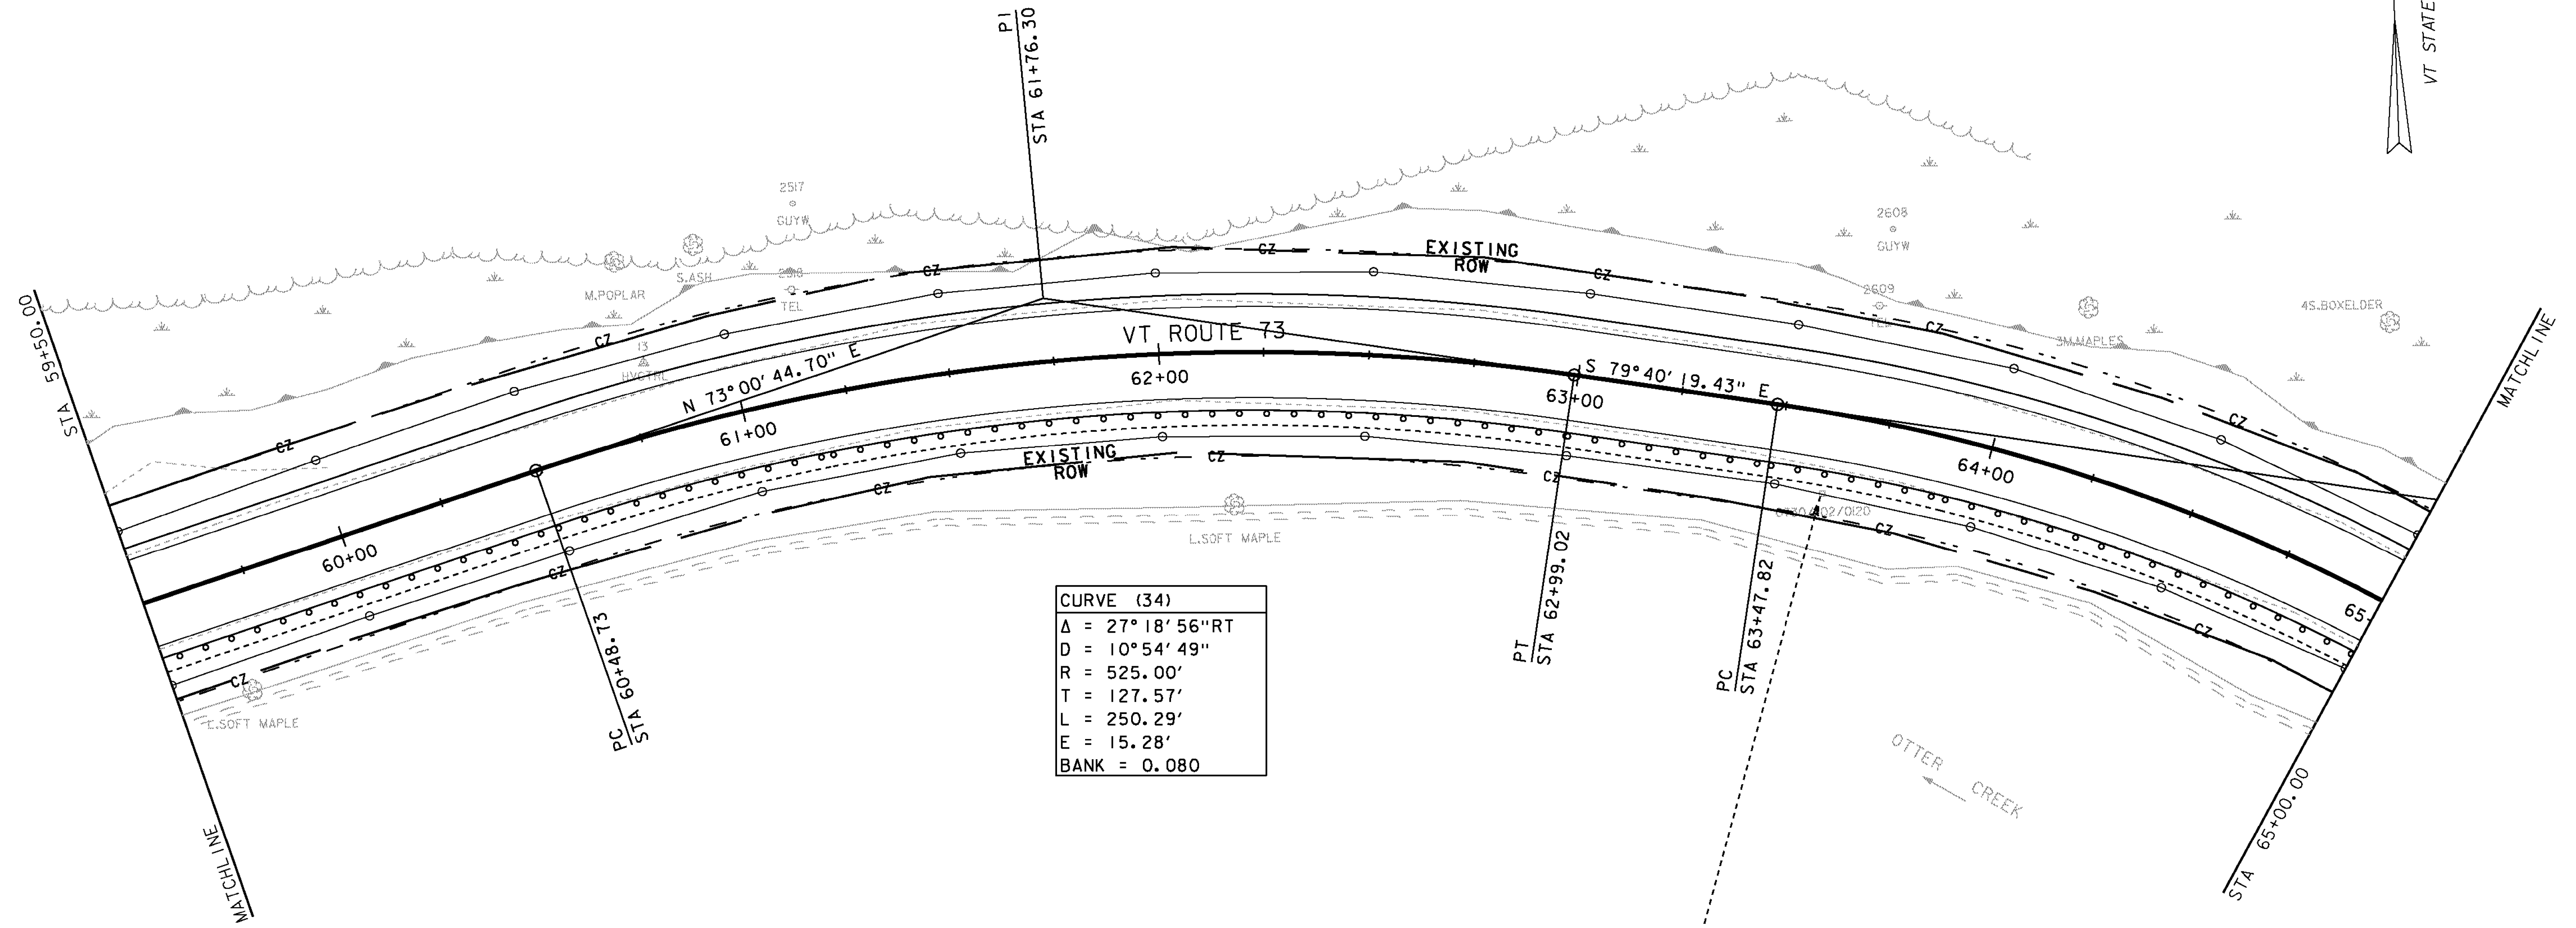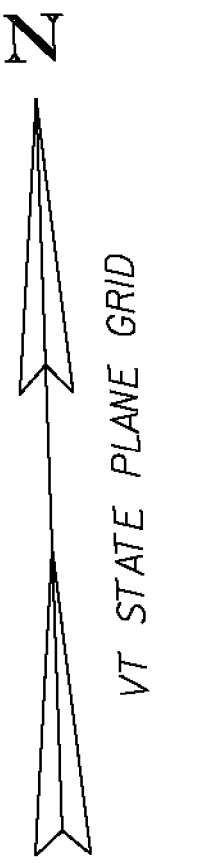

| CURVE (34) | |
|------------|------------------|
| Δ | = 27° 18' 56" RT |
| D | = 10° 54' 49" |
| R | = 525.00' |
| T | = 127.57' |
| L | = 250.29' |
| E | = 15.28' |
| BANK | = 0.080 |

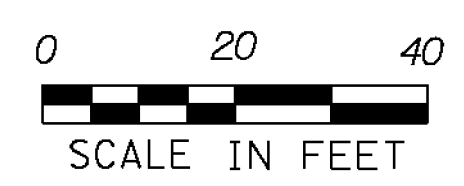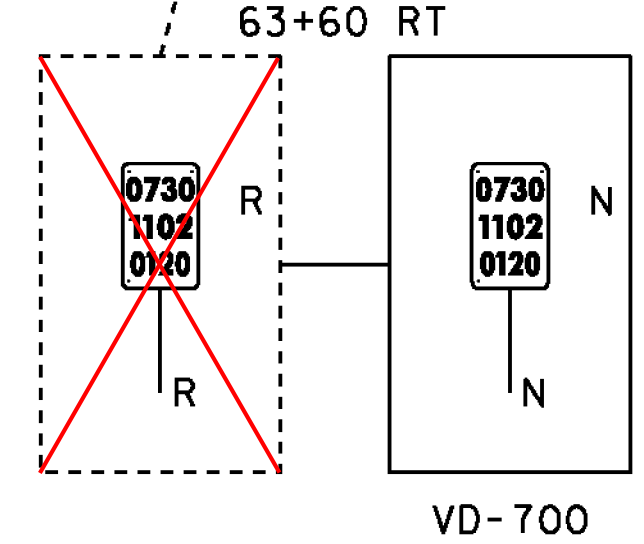

| SIGN LEGEND | |
|-------------|-----------------------|
| R | = REMOVE |
| S | = SALVAGE |
| N | = NEW |
| RET | = RETAIN |
| T&T | = THINNING & TRIMMING |
| B-B | = BACK TO BACK |
| EXISTING | ----- |
| NEW | ————— |

| | | | |
|-----------------|-------------------|-------------|-------------|
| PROJECT NAME: | SUDBURY - BRANDON | PLOT DATE: | 13-FEB-2013 |
| PROJECT NUMBER: | STP 0158(3) | DRAWN BY: | B. MCADAMS |
| FILE NAME: | d10c204_bdr.dgn | CHECKED BY: | A. KEMPTON |
| PROJECT LEADER: | K. UPMAL | LAYOUT | 39 |
| DESIGNED BY: | B. MCADAMS | SHEET | 71 OF 137 |