
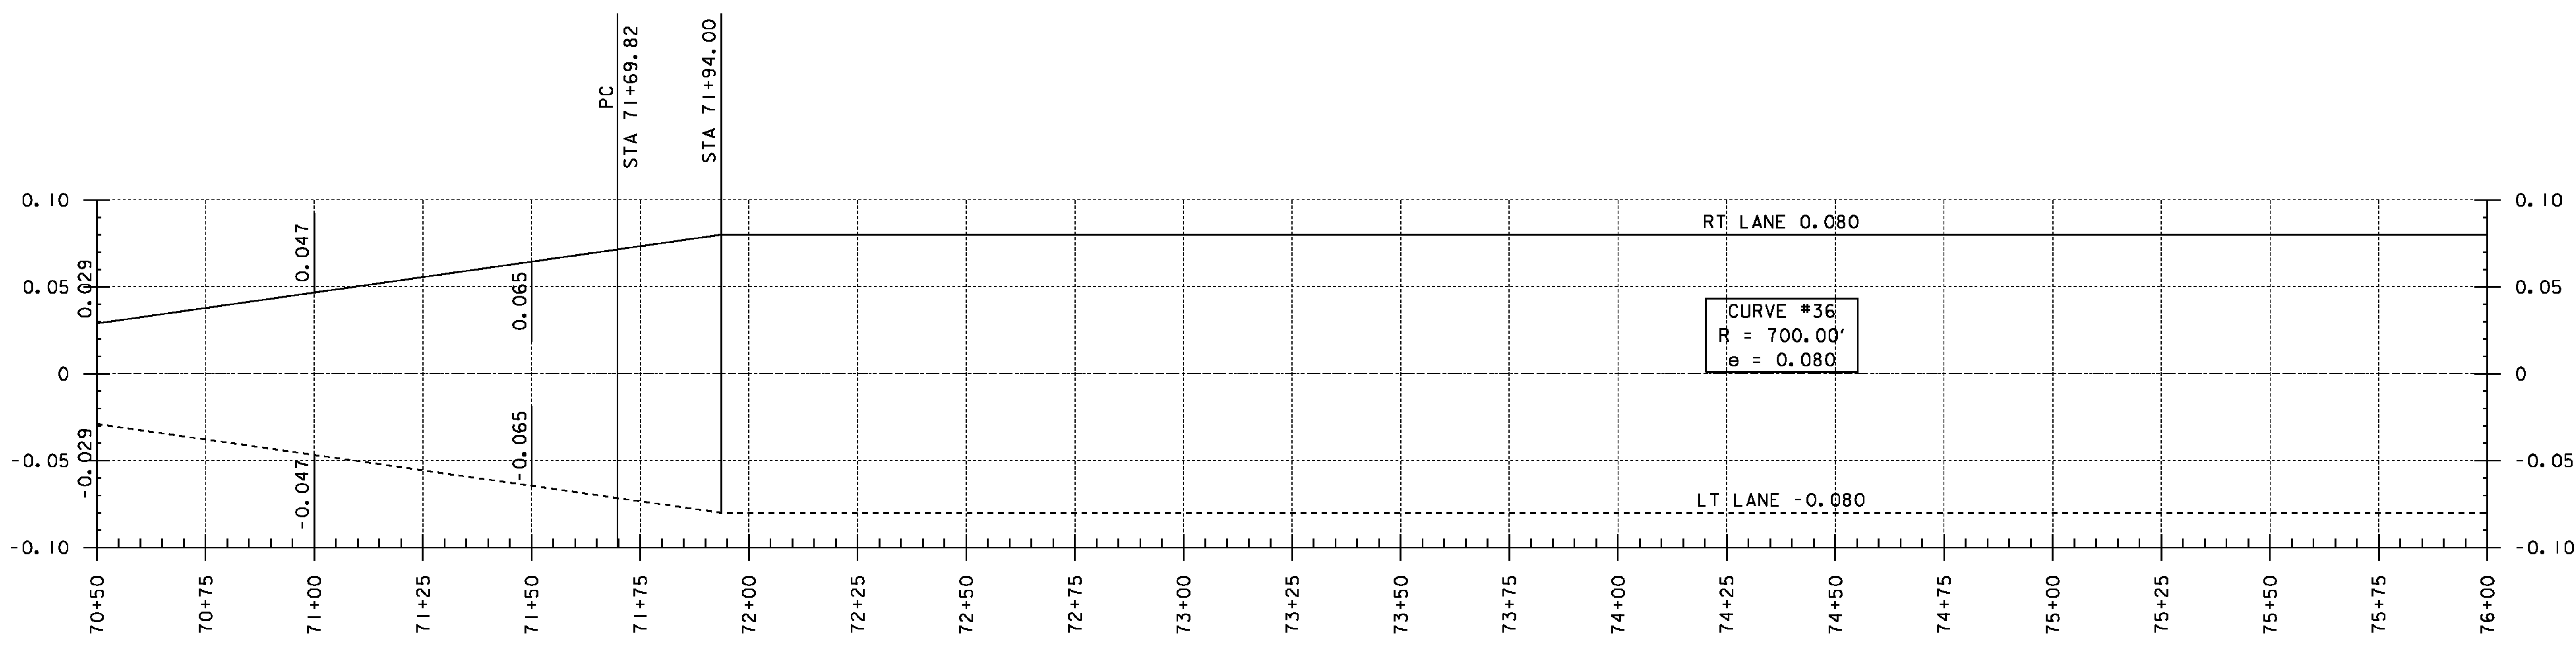


PROFILE

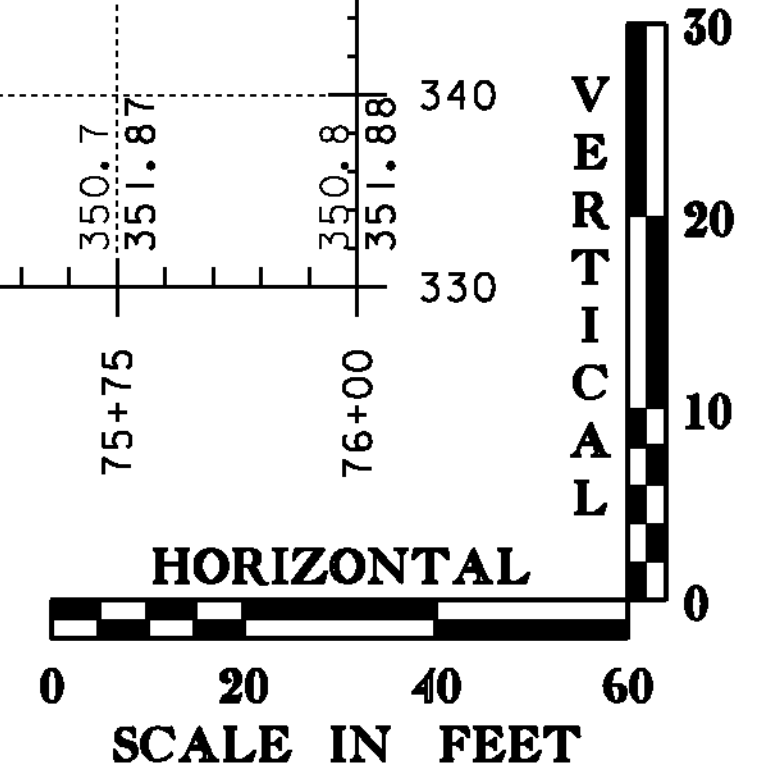

BANKING DIAGRAM

THE GRADES SHOWN TO THE NEAREST TENTH ARE THE ORIGINAL GROUND ELEVATIONS ALONG THE PROPOSED ALIGNMENT. THE GRADES SHOWN TO THE NEAREST HUNDRETH ARE THE FINISHED GRADES FOR THE PROPOSED ALIGNMENT.

| | |
|------------------------------------|-------------------|
| PROJECT NAME: | SUDBURY - BRANDON |
| PROJECT NUMBER: | STP 0158(3) |
| FILE NAME: | d10c204_pro.dgn |
| PROJECT LEADER: | K. UPMAL |
| DESIGNED BY: | B. MCADAMS |
| VT 73 PROFILE & BANKING DIAGRAM 41 | |
| PLOT DATE: | 13-FEB-2013 |
| DRAWN BY: | B. MCADAMS |
| CHECKED BY: | N. PAPPAS |
| SHEET | 76 OF 137 |