



DURABLE 4 INCH WHITE LINE (SEE OPTION AA)
 DURABLE 4 INCH YELLOW LINE (SEE OPTION BB)
 STA 76+00 TO 81+50 RT & LT

646.602 TEMPORARY 4 INCH WHITE LINE, PAINT
 646.612 TEMPORARY 4 INCH YELLOW LINE, PAINT
 STA 76+00 TO 81+50 RT & LT

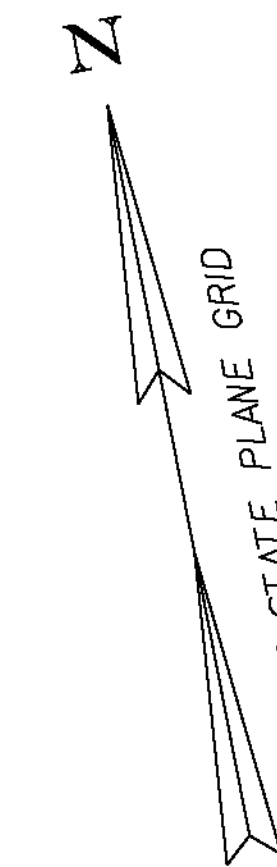

CURVE (37)	
Δ	= 19° 44' 36" LT
D	= 5° 43' 46"
R	= 1000.00'
T	= 174.02'
L	= 344.58'
E	= 15.03'
BANK	= 0.076

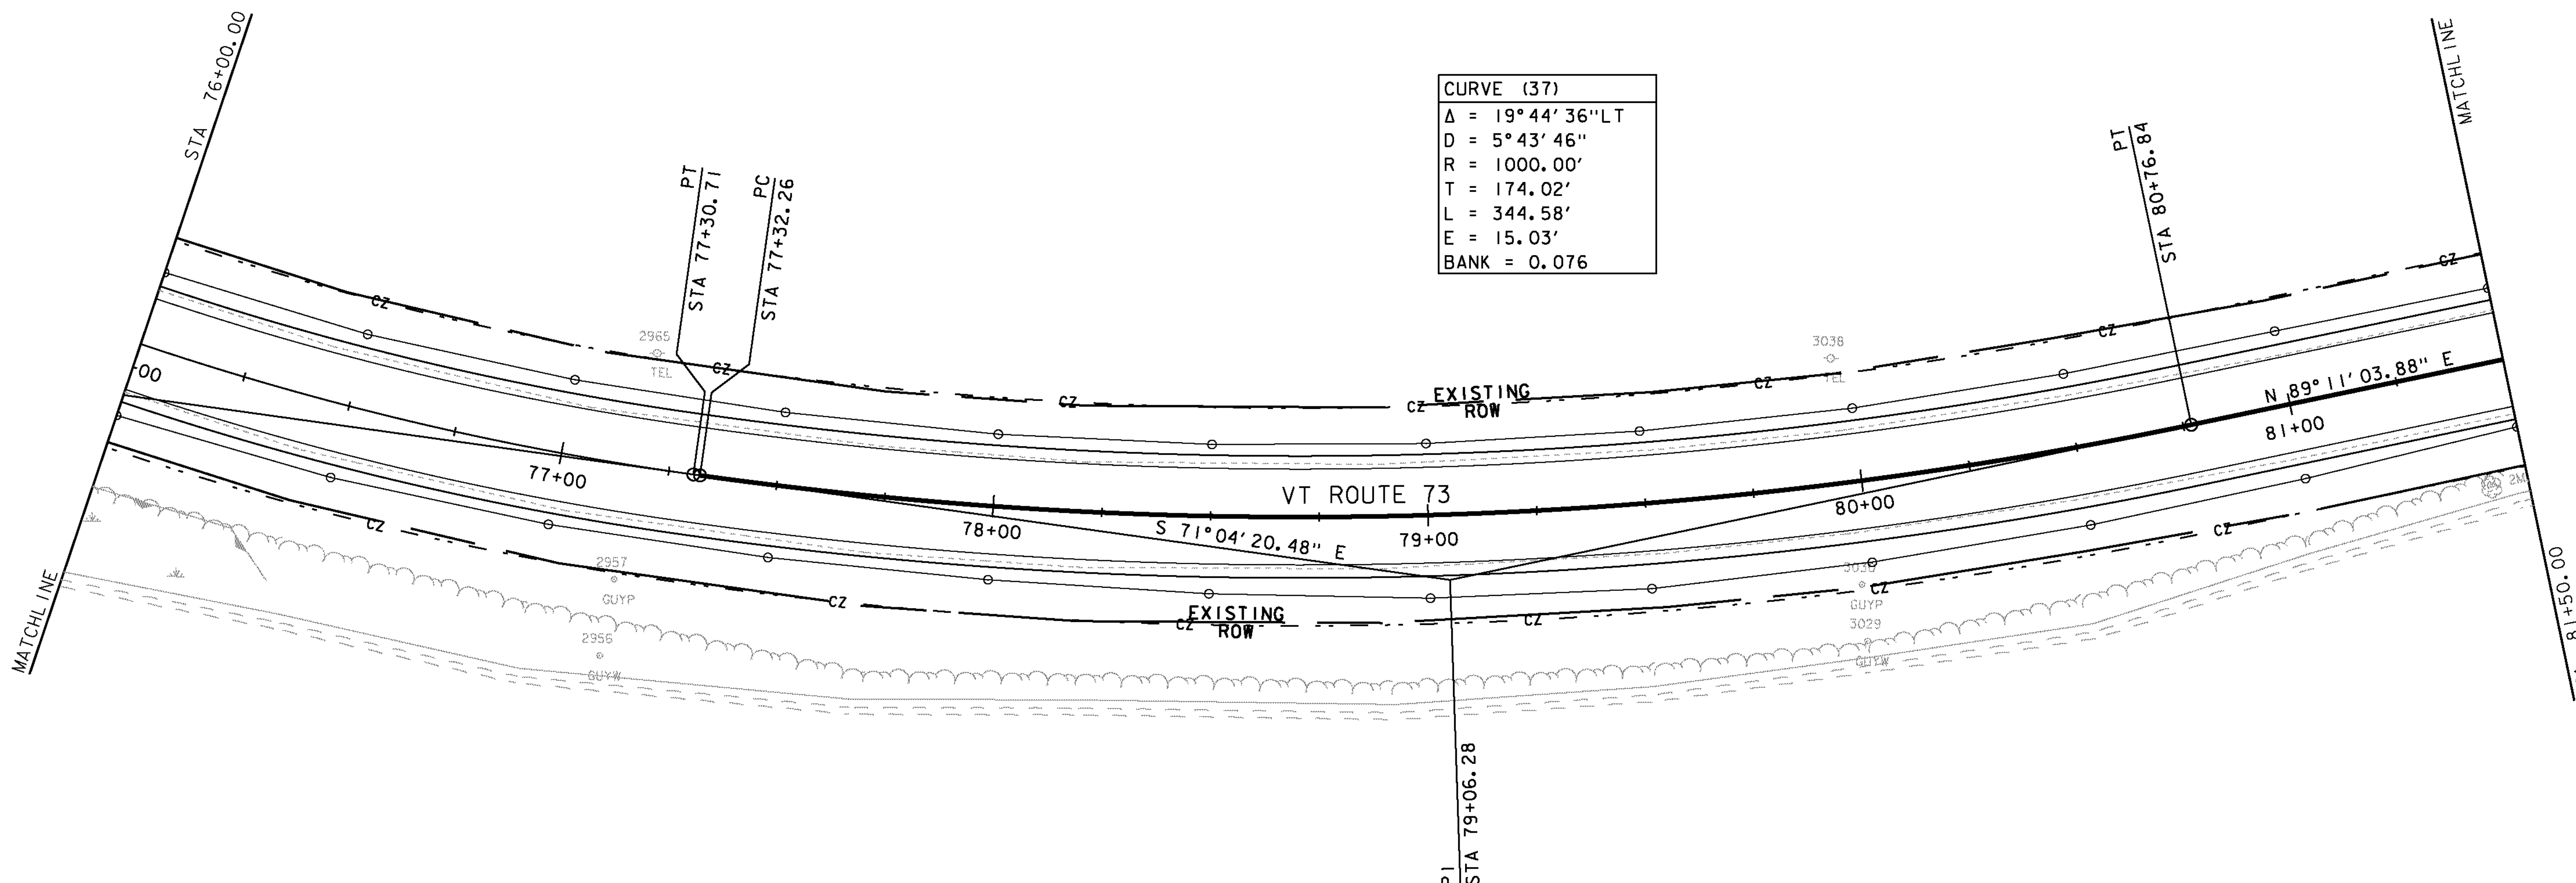

SIGN LEGEND	
R	= REMOVE
S	= SALVAGE
N	= NEW
RET	= RETAIN
T&T	= THINNING & TRIMMING
B-B	= BACK TO BACK
EXISTING	-----
NEW	_____

PROJECT NAME:	SUDBURY - BRANDON	FILE NAME:	d:\0c204_bdr.dgn	PLOT DATE:	13-FEB-2013
PROJECT NUMBER:	STP 0158(3)	PROJECT LEADER:	K. UPMAL	DRAWN BY:	B. MCADAMS
DESIGNED BY:	B. MCADAMS	CHECKED BY:	A. KEMPTON	LAYOUT 42	SHEET 77 OF 137