




155+00

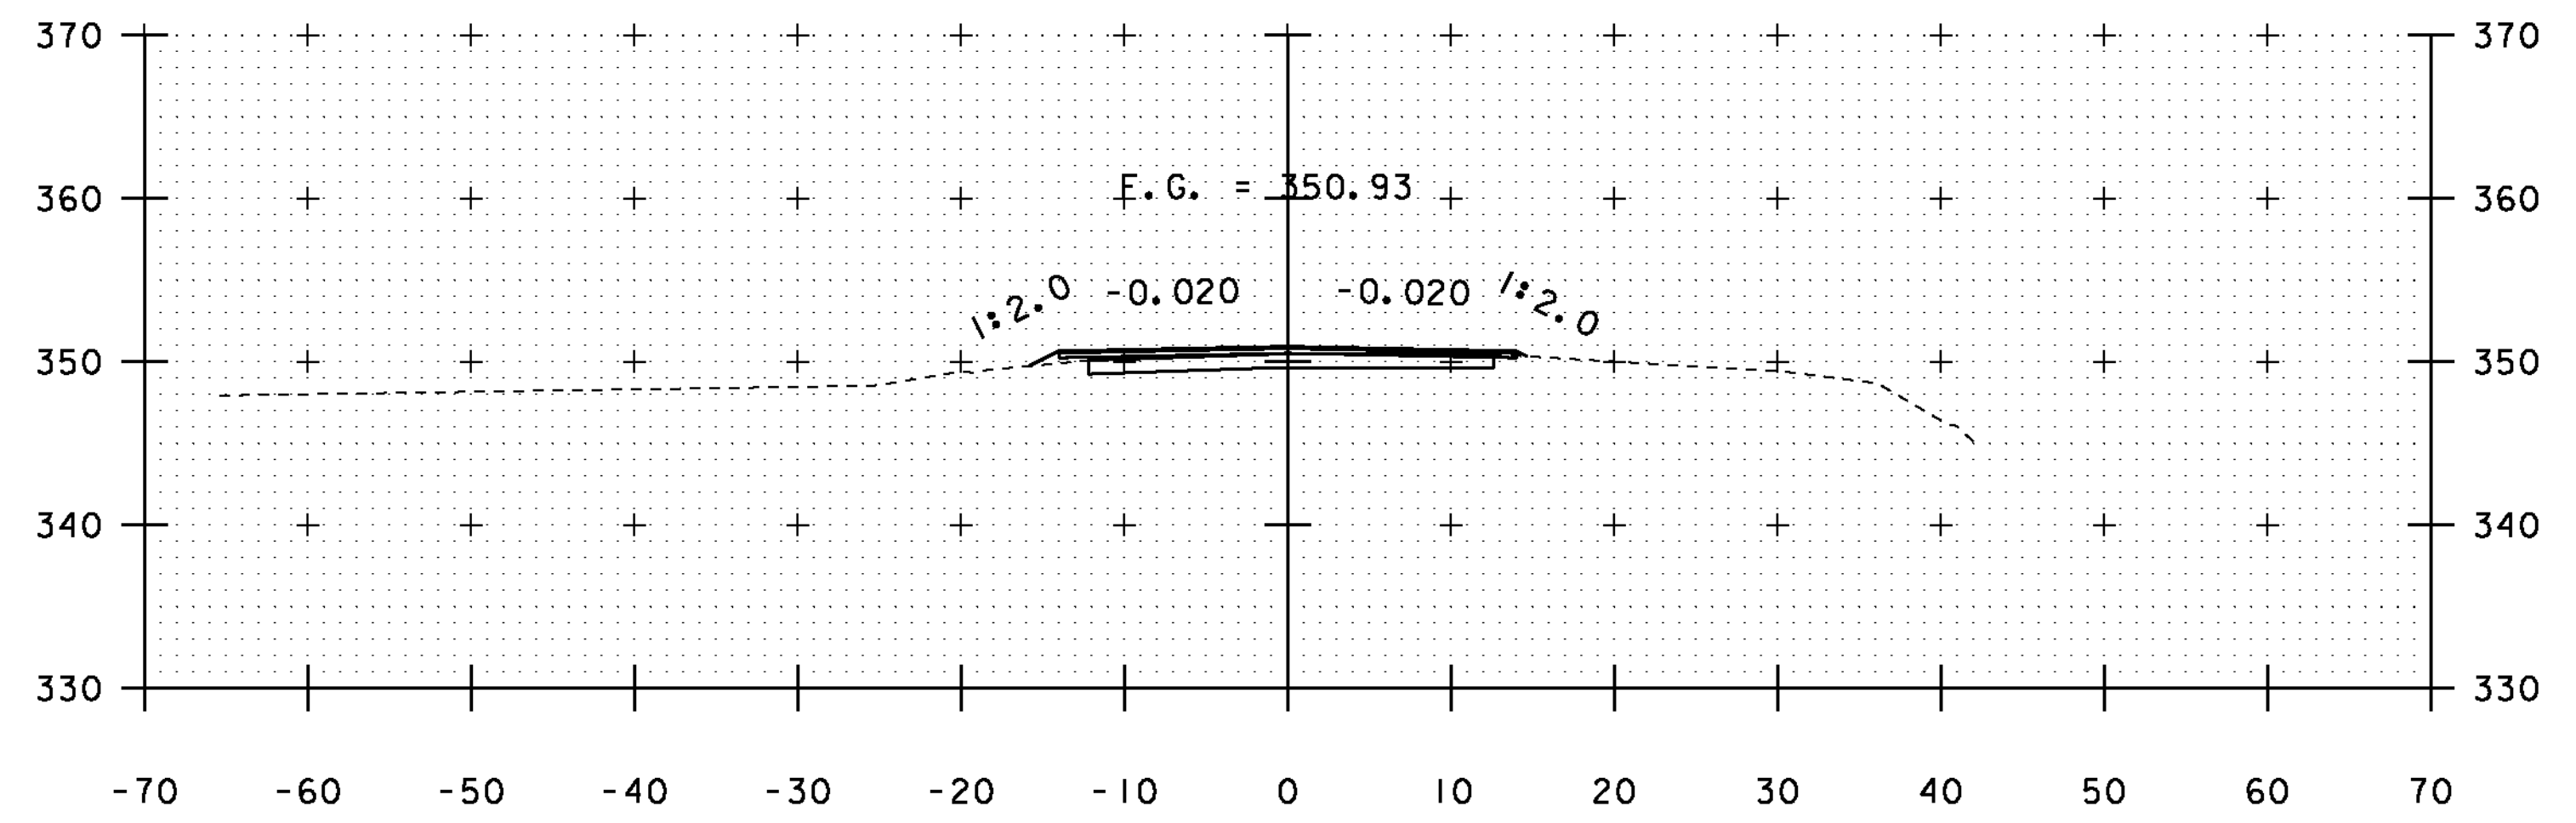


156+50

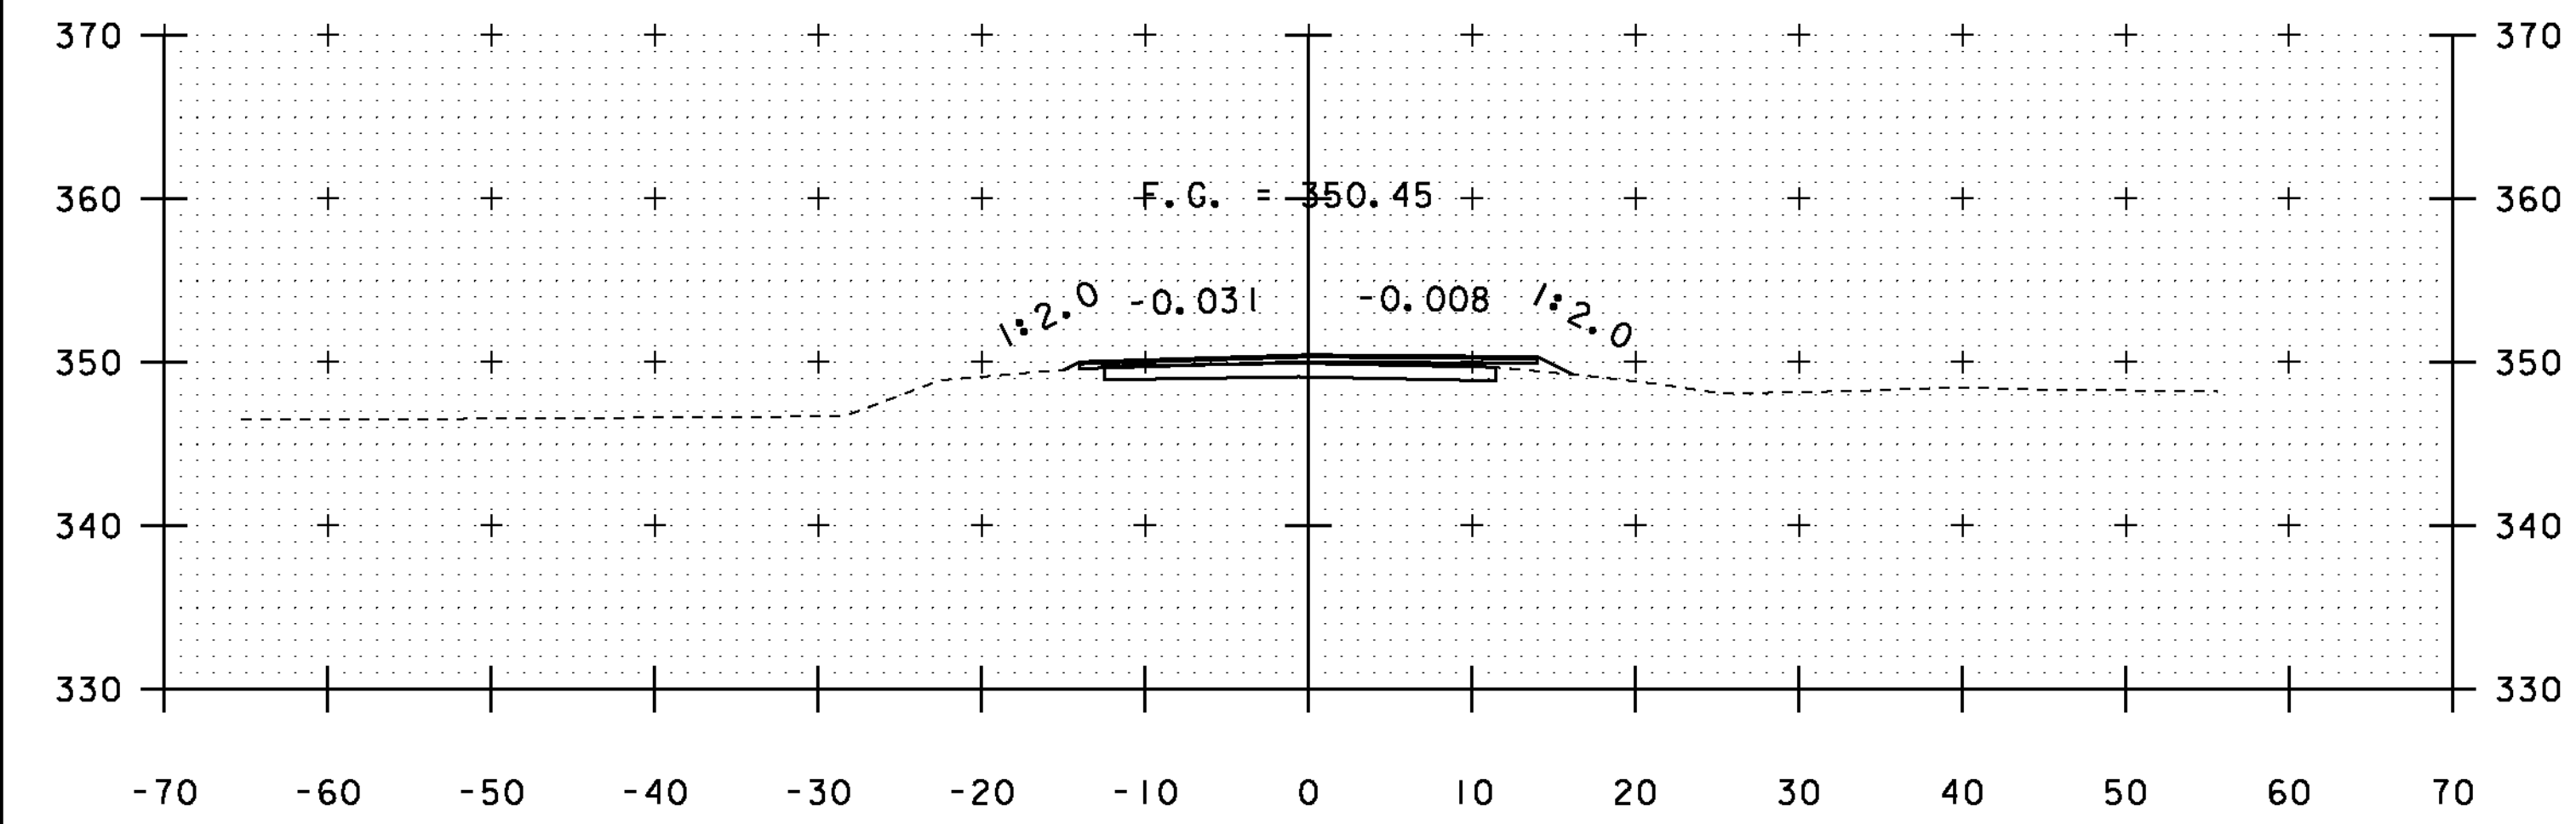


154+50

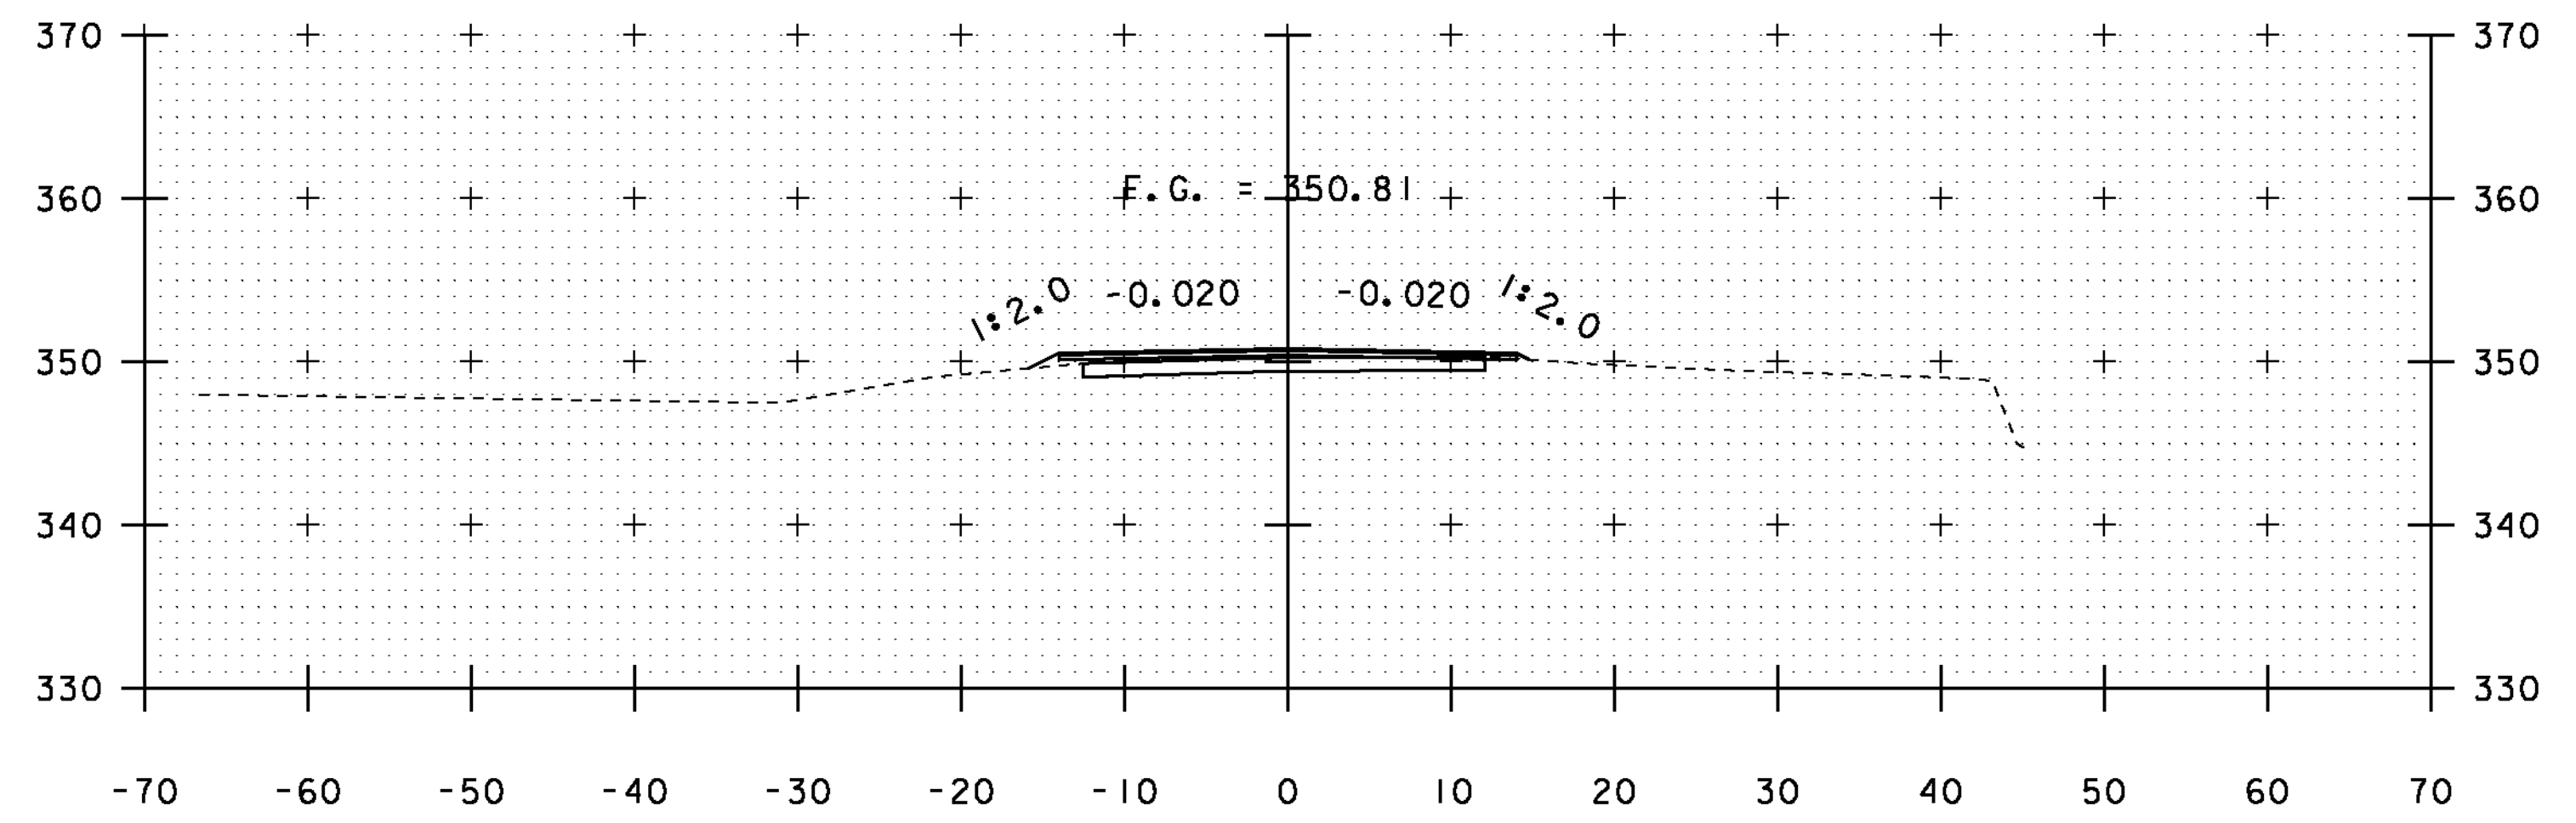


156+00

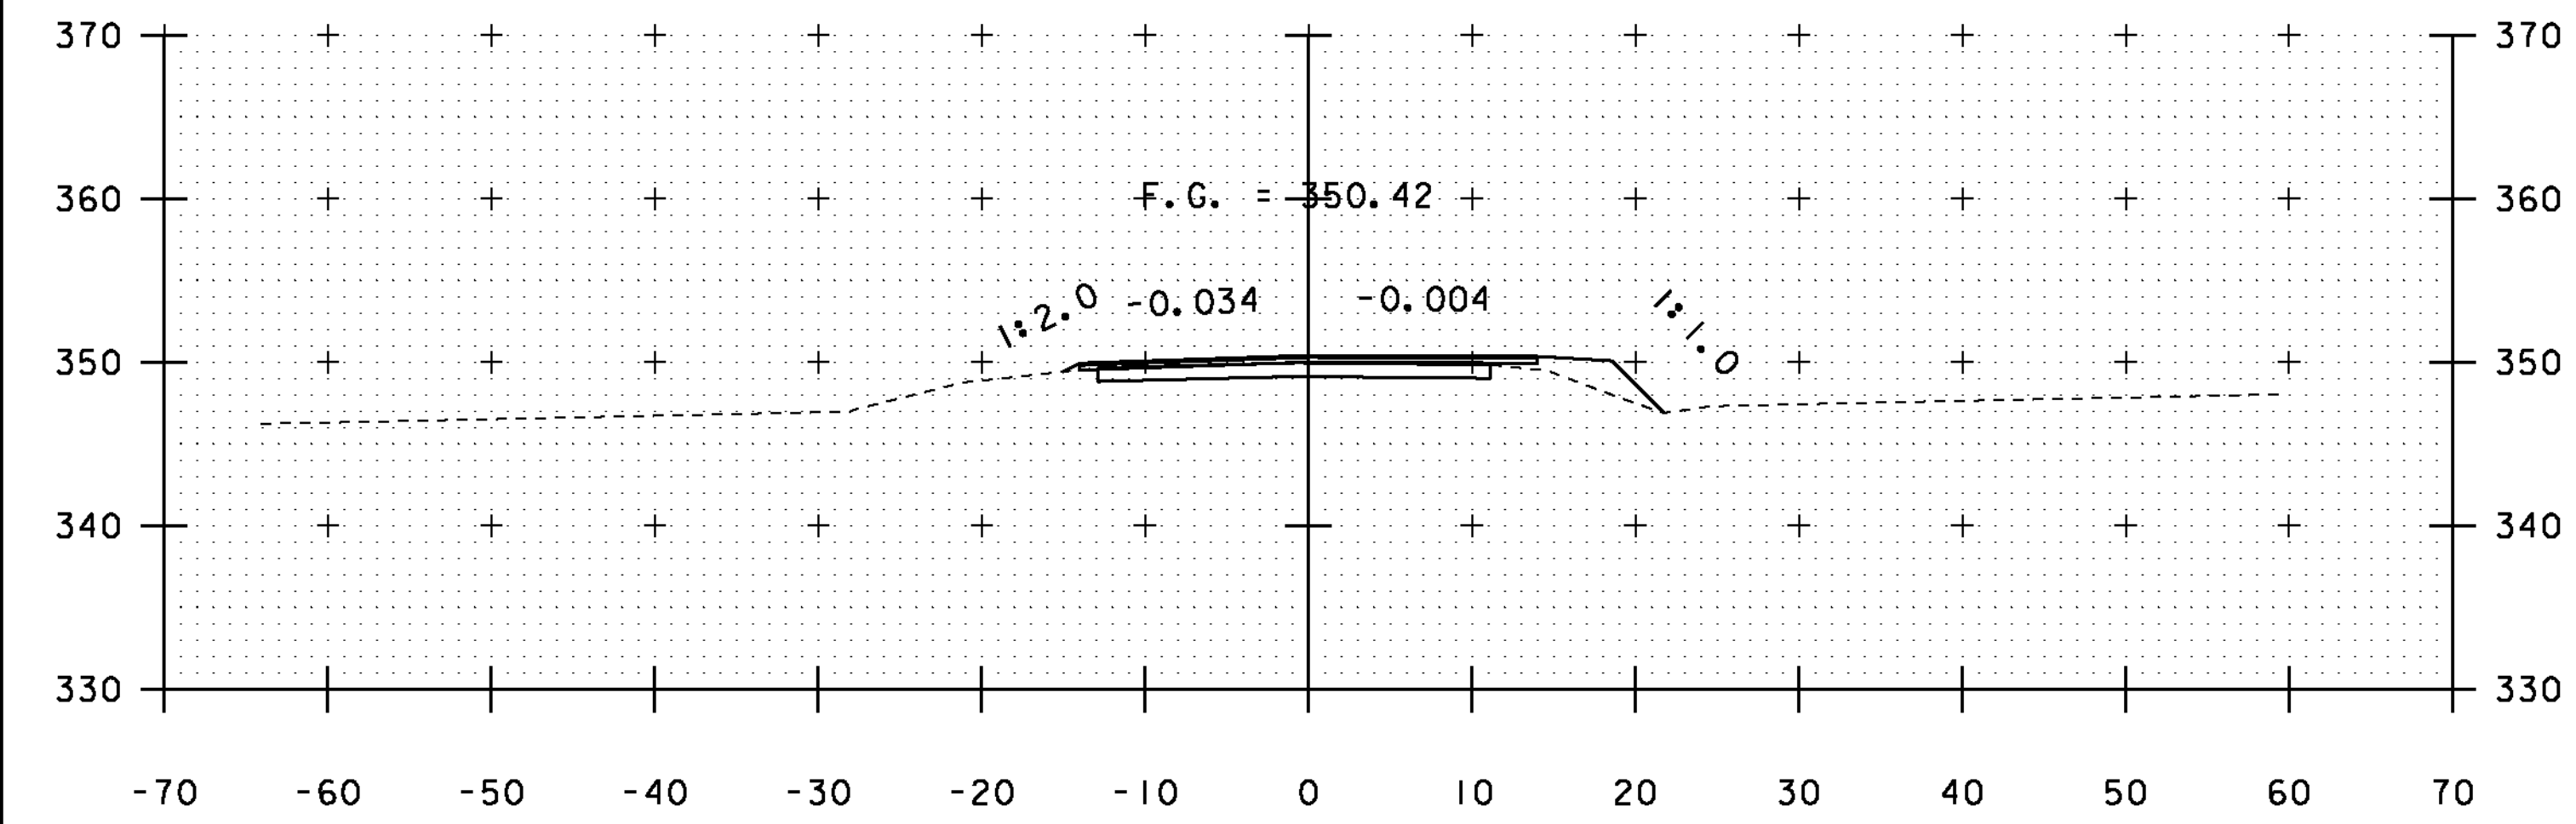

154+00

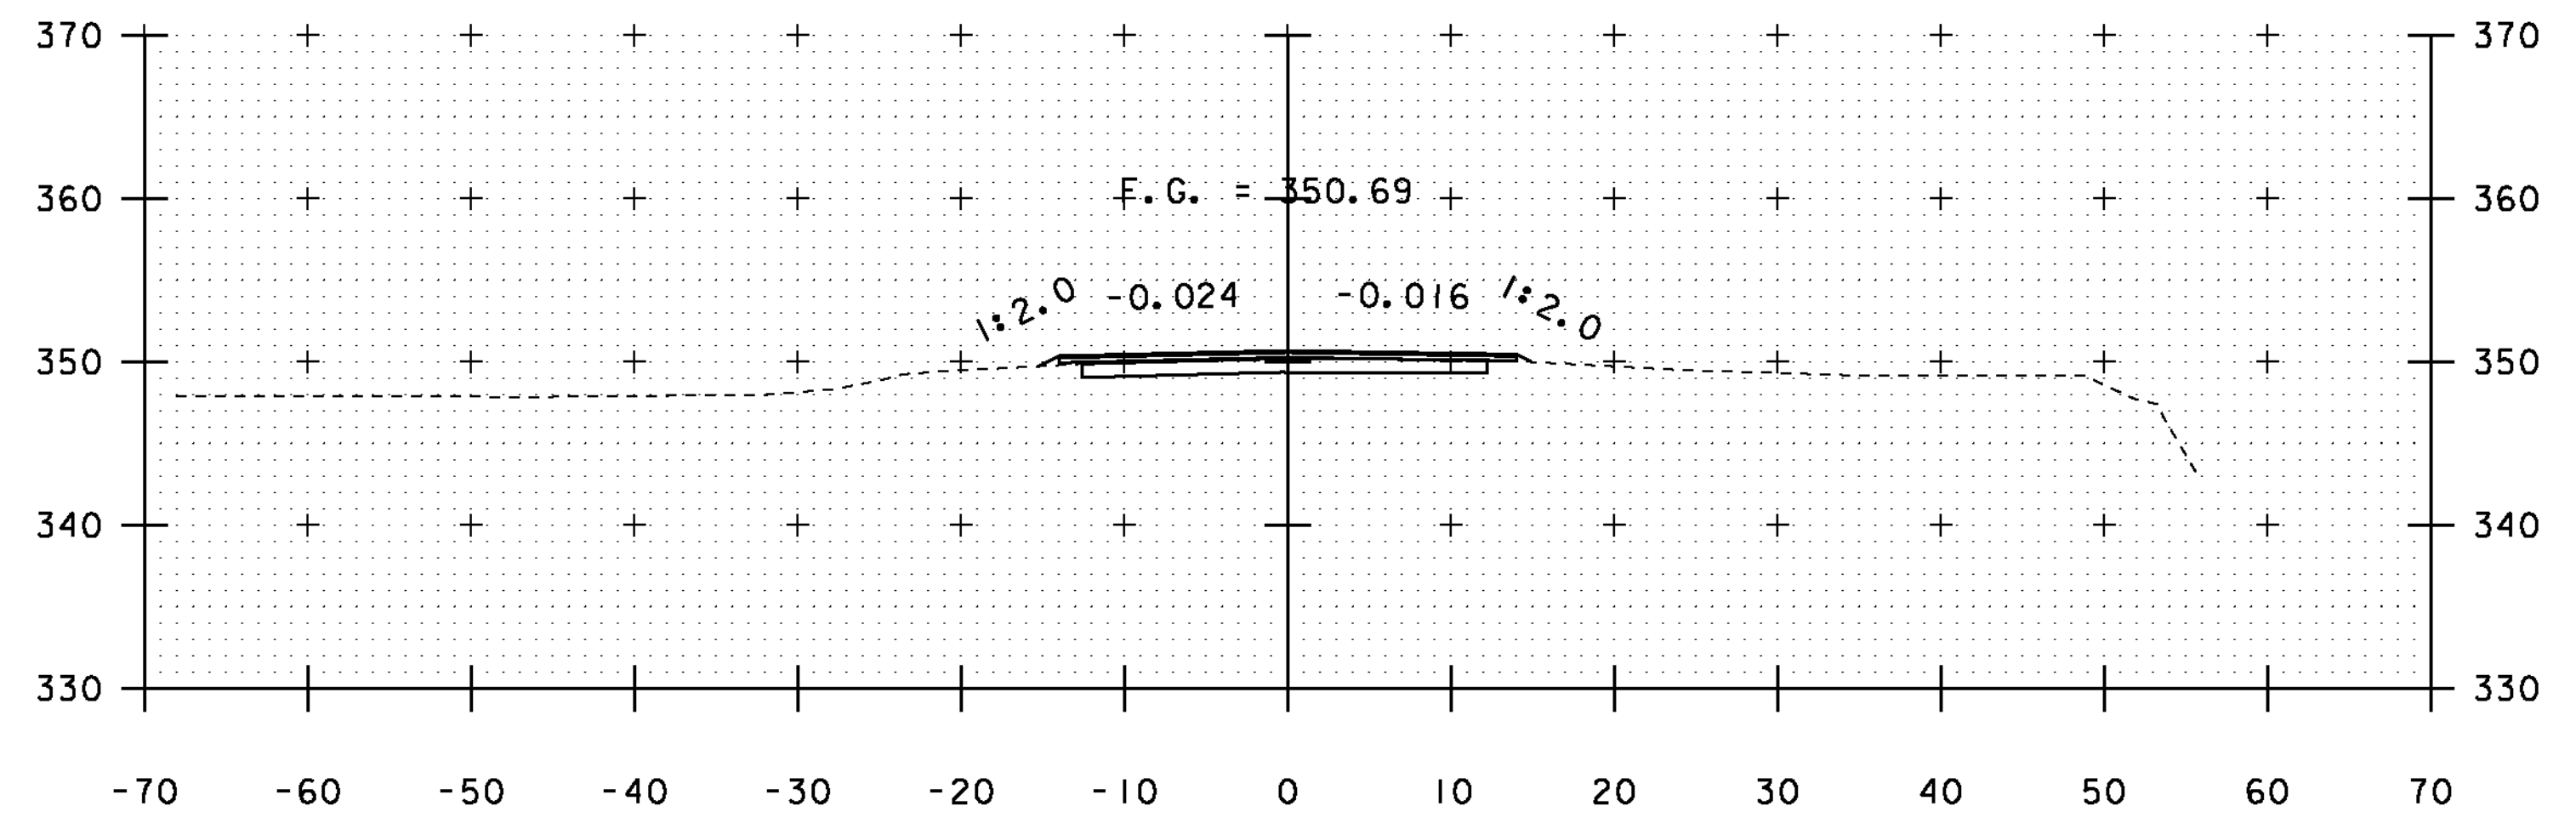

155+50

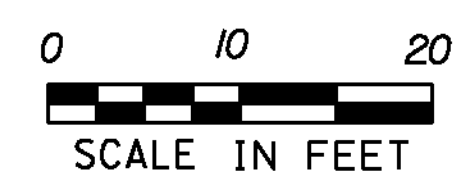

STA. 154+00 TO STA. 156+50

PROJECT NAME:	SUDBURY - BRANDON
PROJECT NUMBER:	STP 0158(3)
FILE NAME:	d10c204_xs.dgn
PROJECT LEADER:	K. UPMAL
DESIGNED BY:	B. MCADAMS
VT 73 CROSS SECTIONS 2	
PLOT DATE:	13-FEB-2013
DRAWN BY:	A. KEMPTON
CHECKED BY:	N. PAPPAS
SHEET	97 OF 137