




160+50

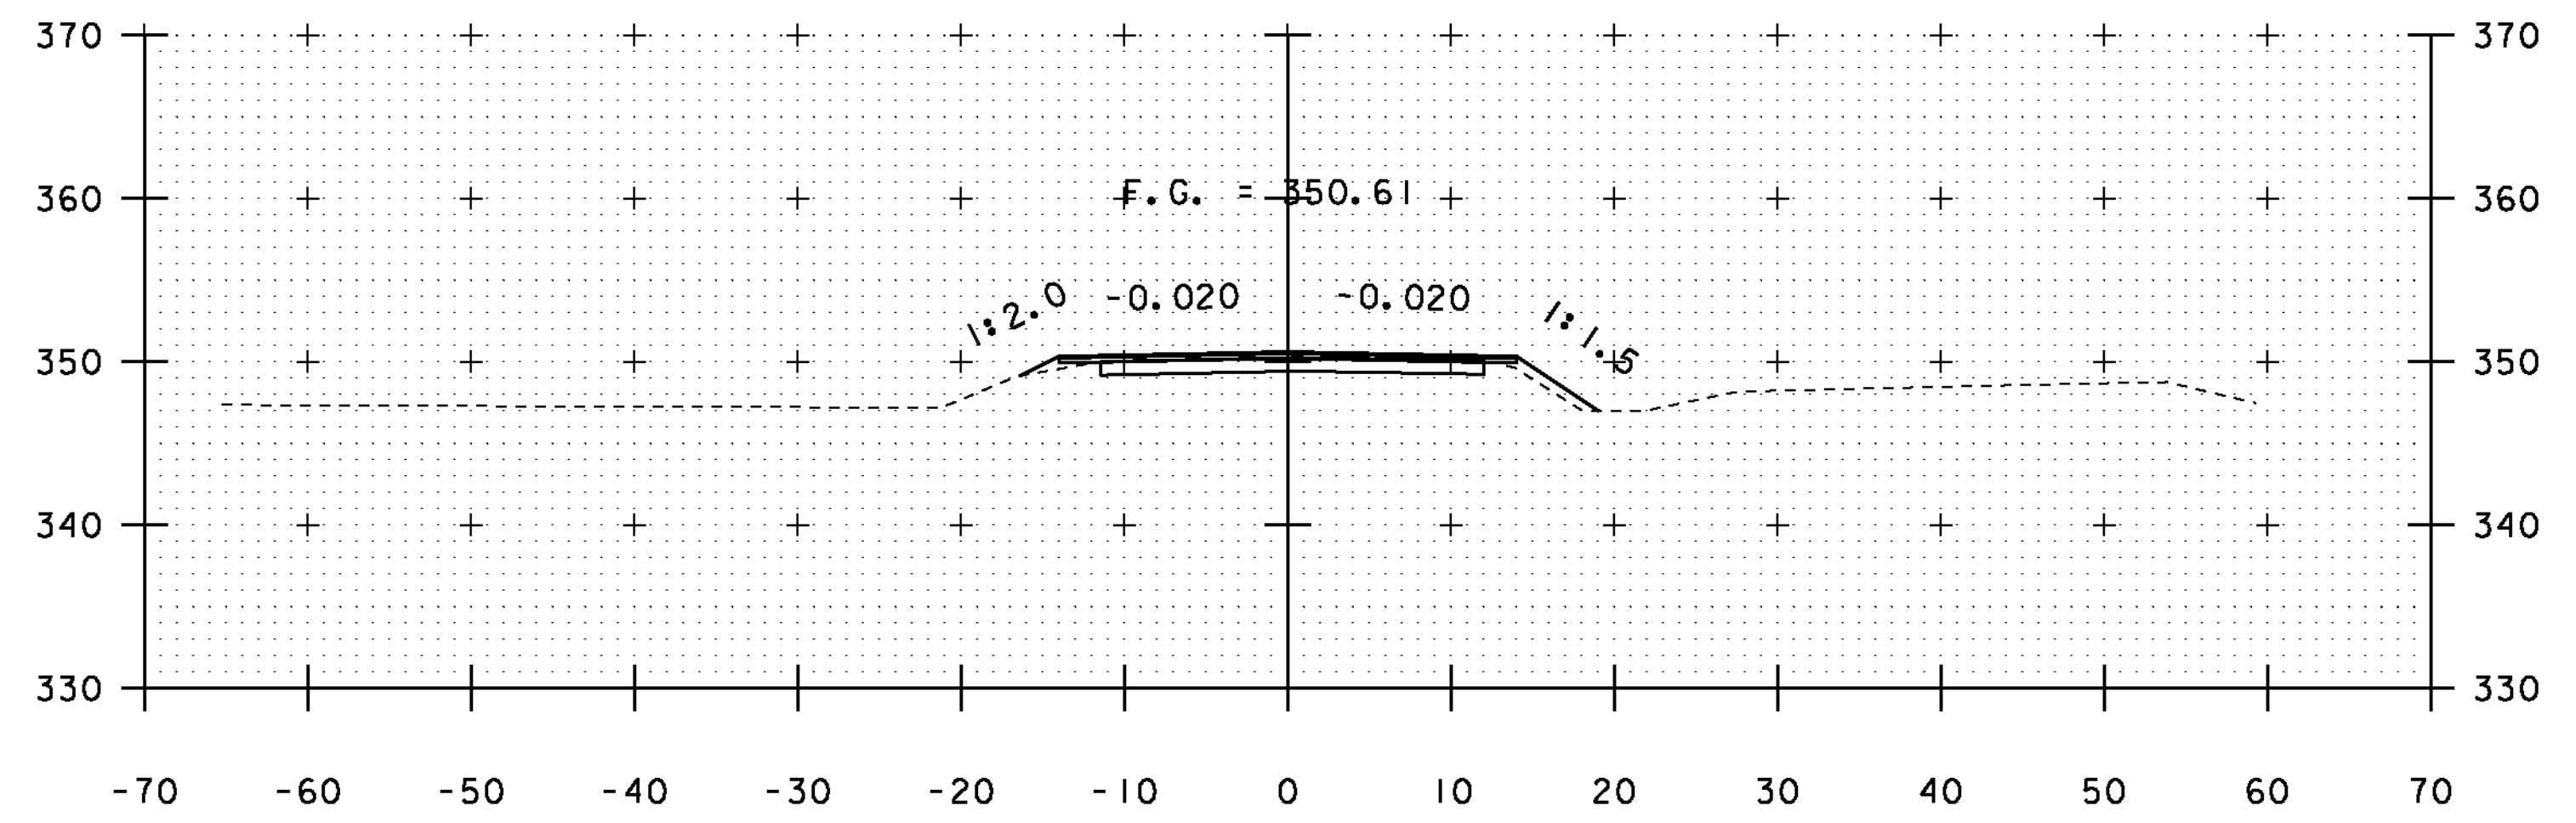


162+00

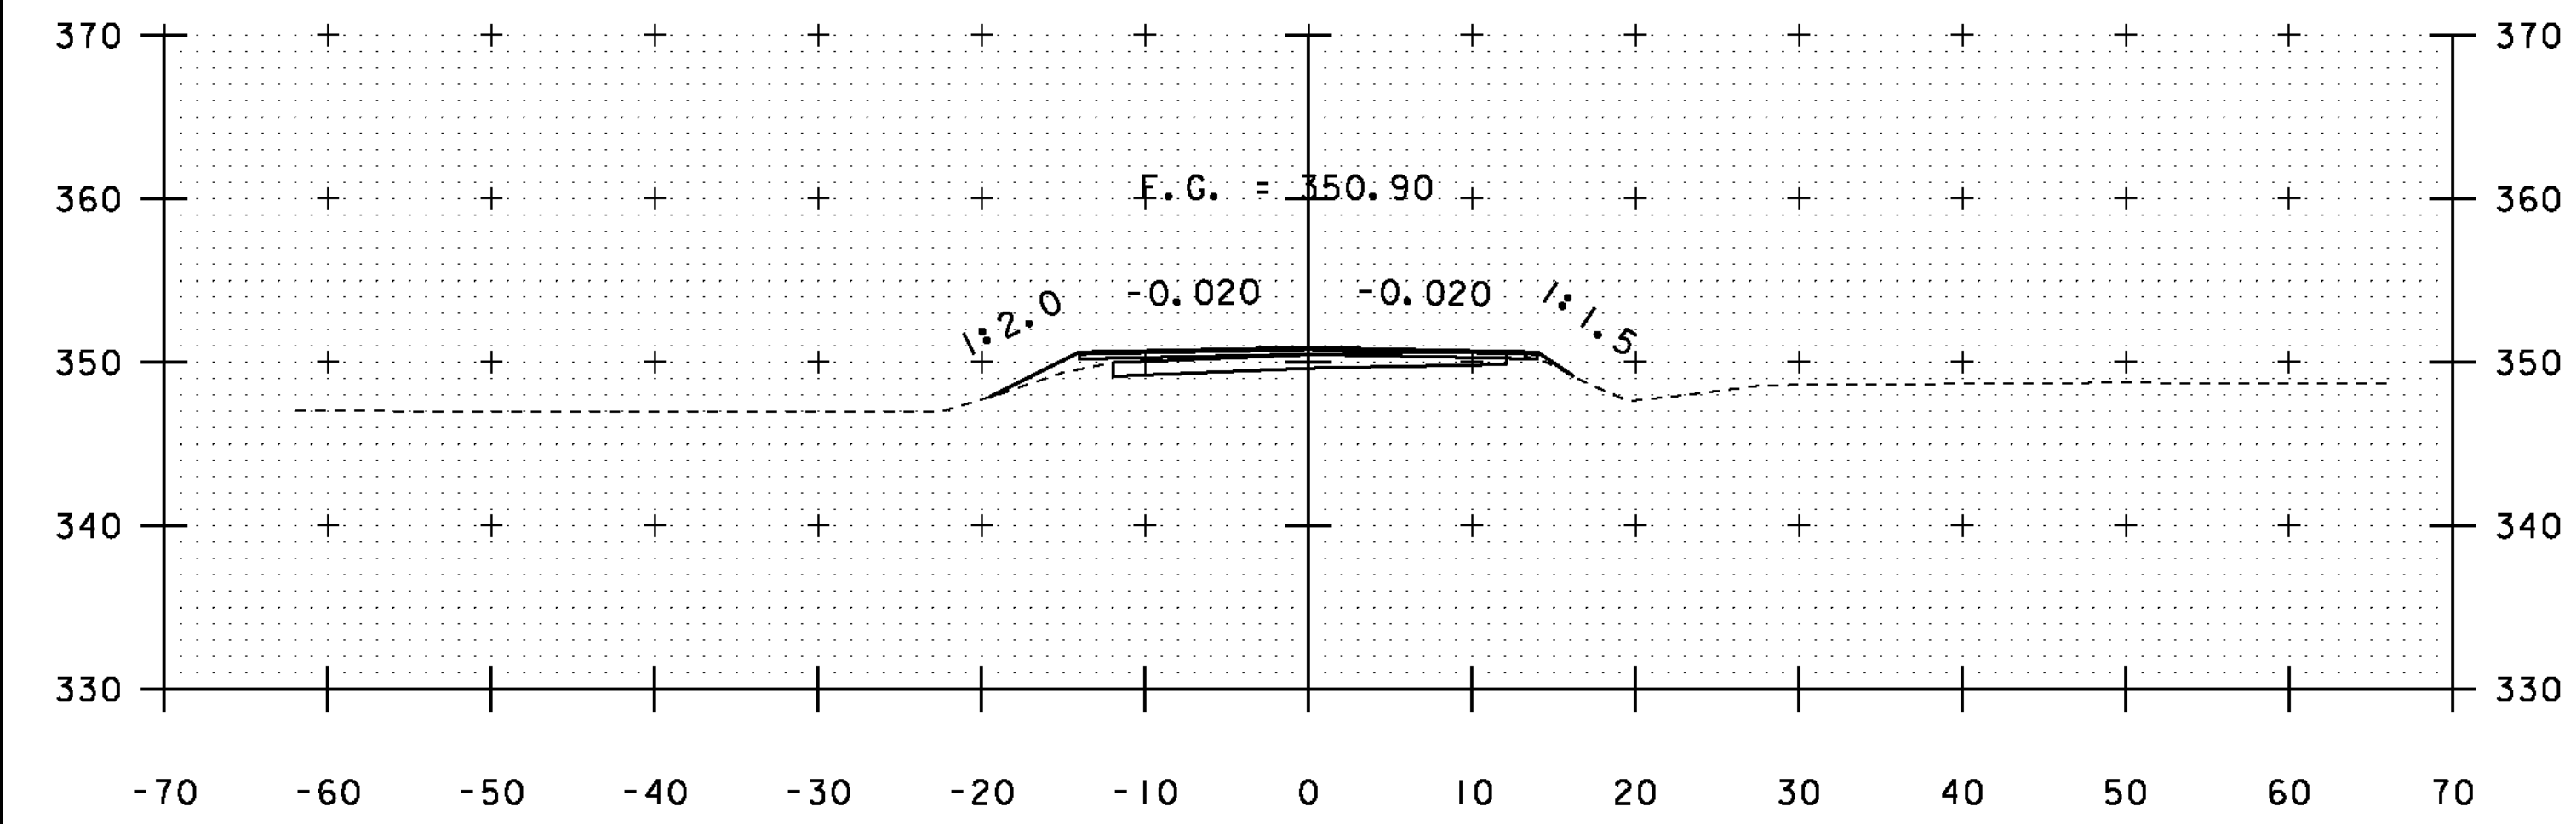


160+00

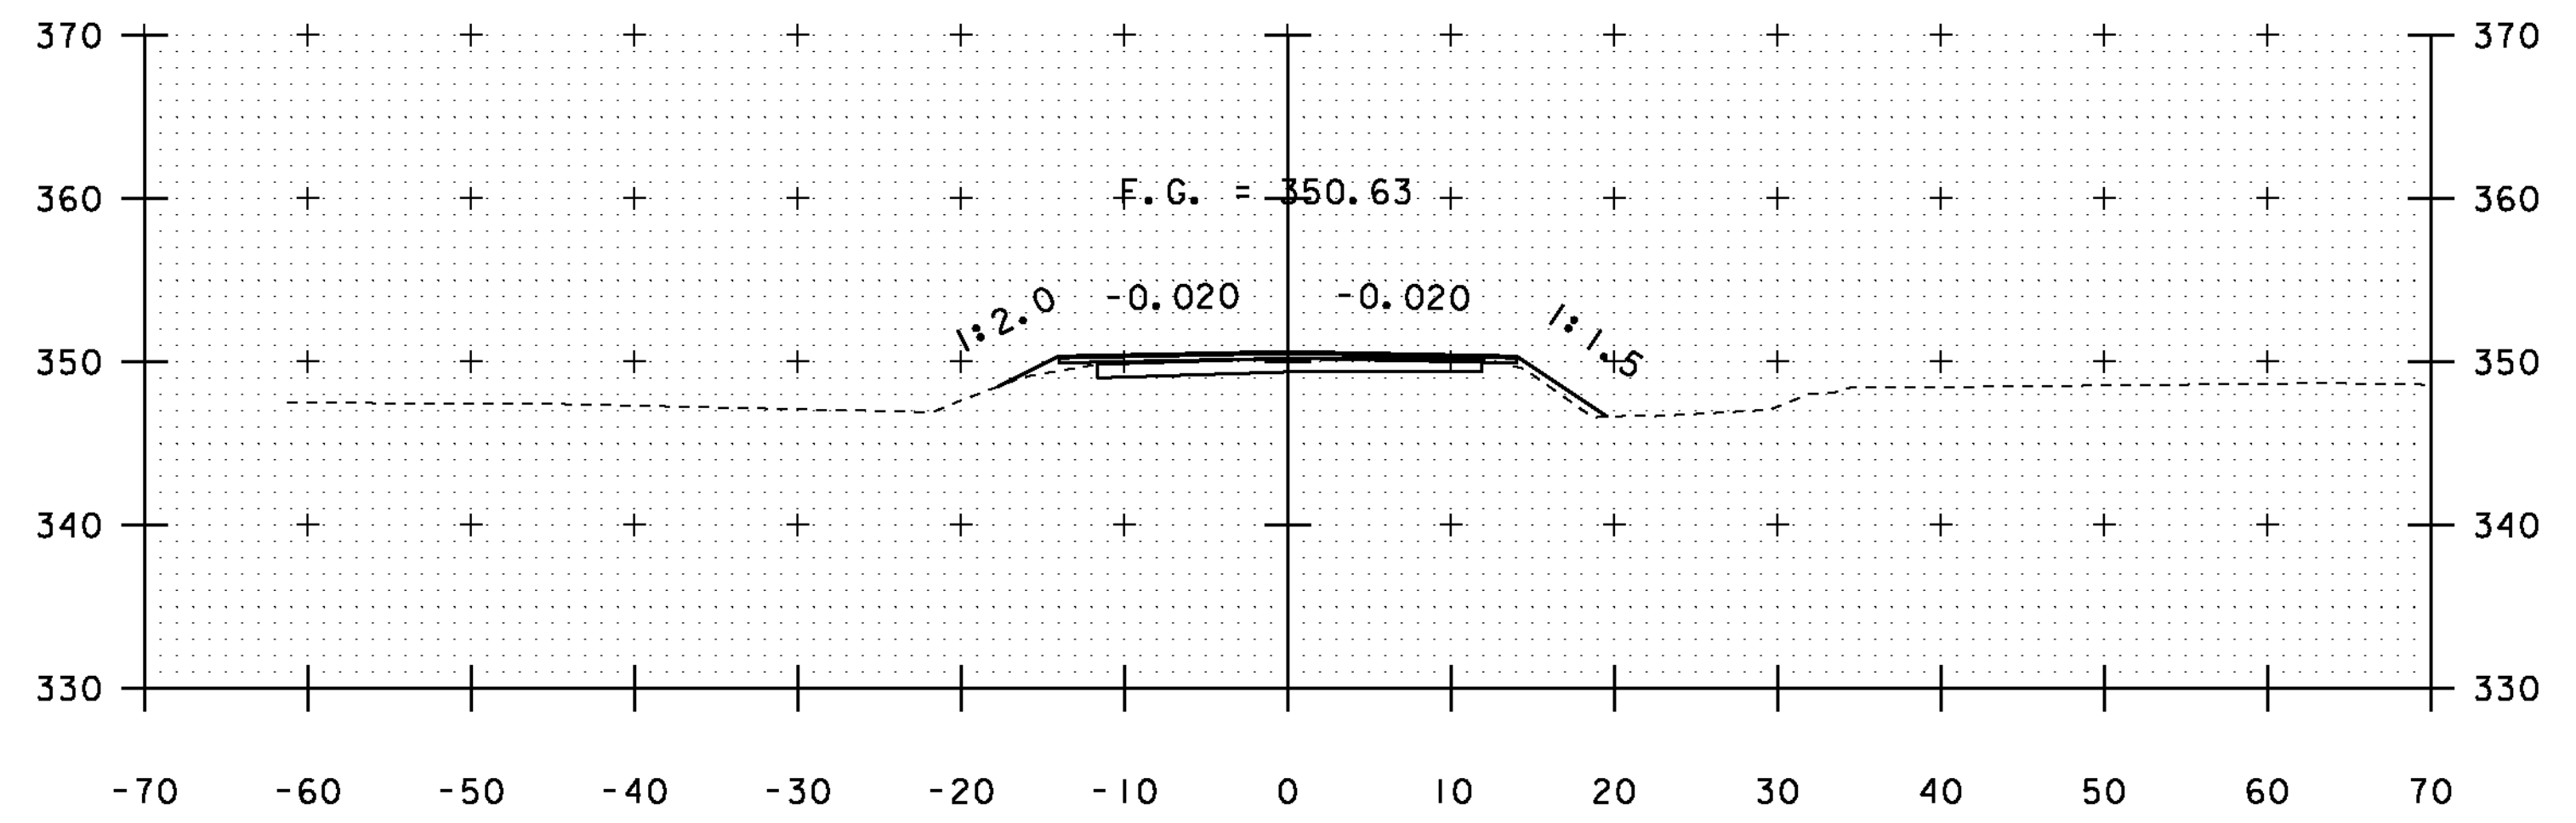


161+50

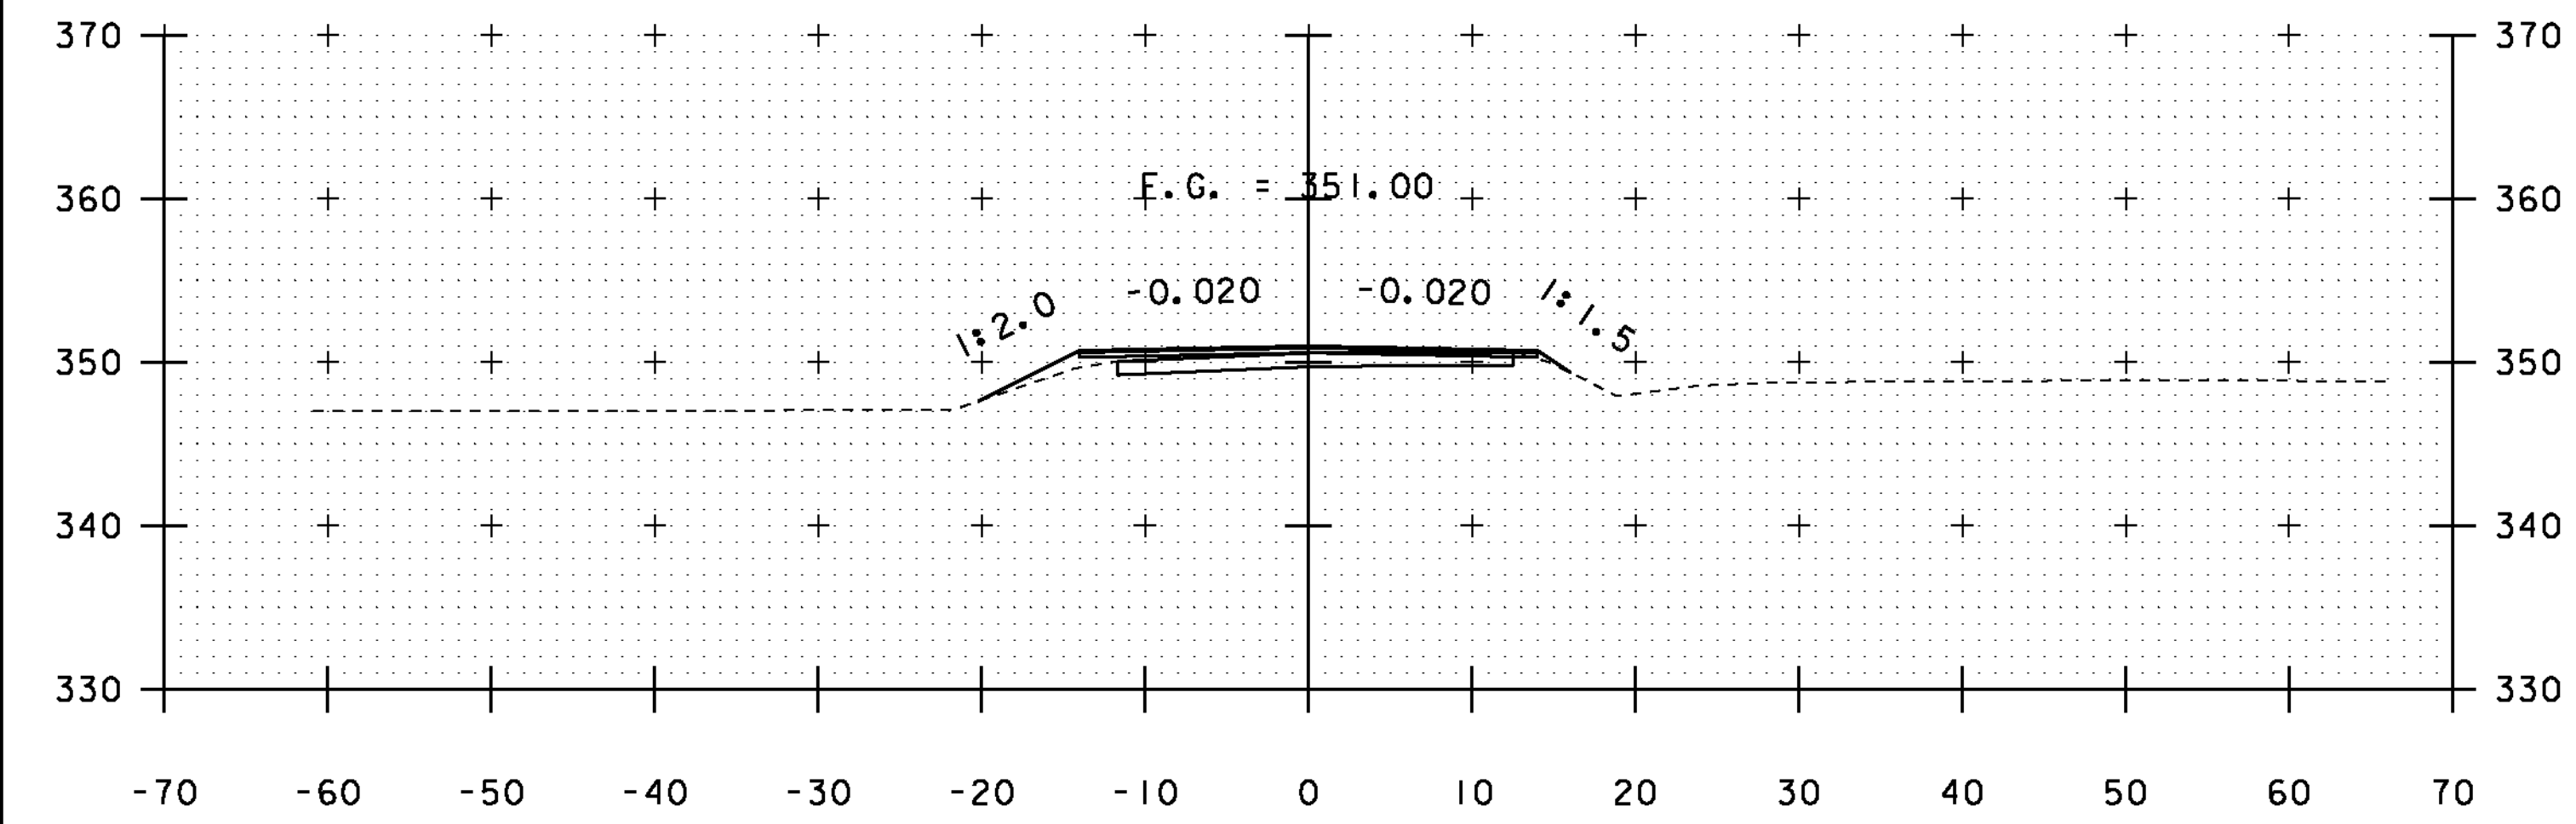

159+50

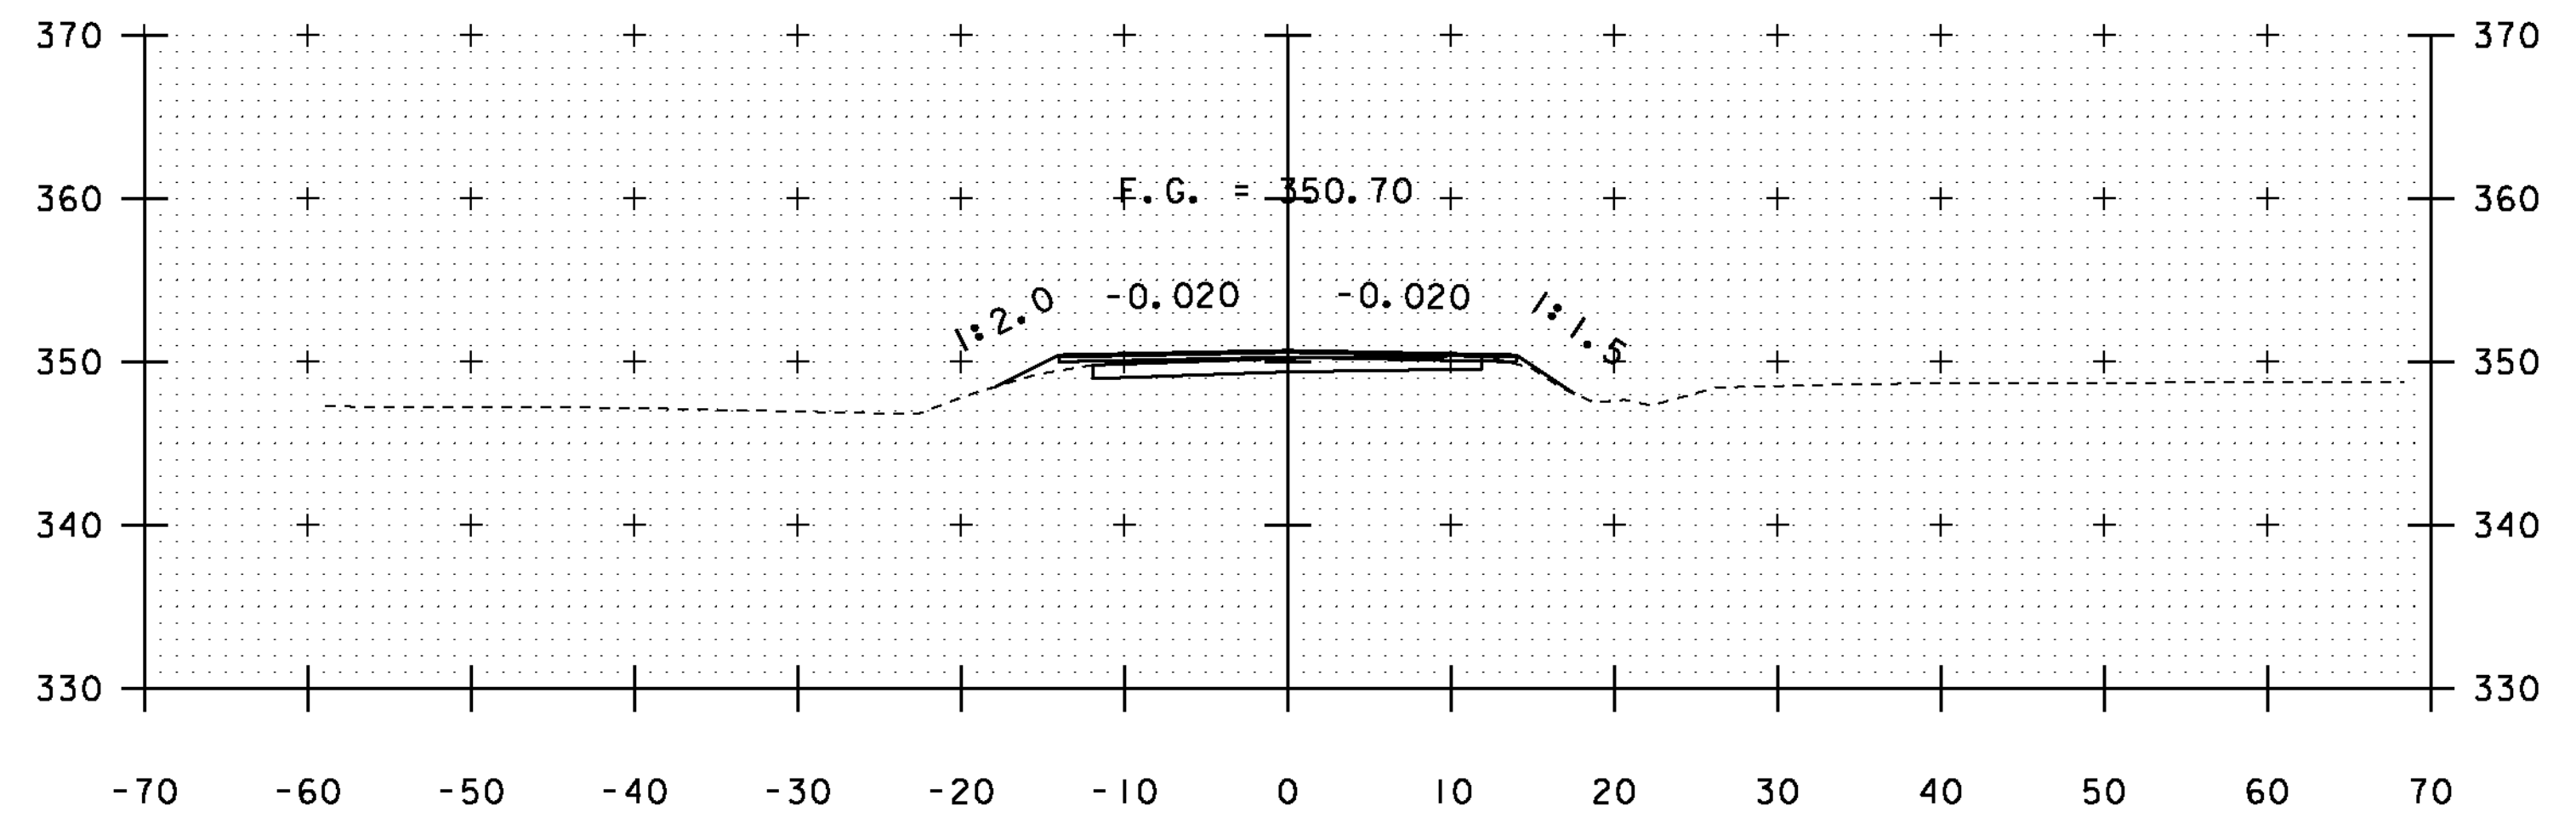

161+00

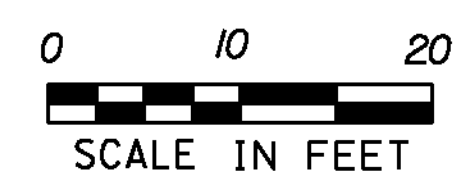

STA. 159+50 TO STA. 162+00

PROJECT NAME:	SUDBURY - BRANDON
PROJECT NUMBER:	STP 0158(3)
FILE NAME:	d:\0c204_xs.dgn
PROJECT LEADER:	K. UPMAL
DESIGNED BY:	B. MCADAMS
VT 73 CROSS SECTIONS	4
PLOT DATE:	13-FEB-2013
DRAWN BY:	A. KEMPTON
CHECKED BY:	N. PAPPAS
SHEET	99 OF 137