




8+50

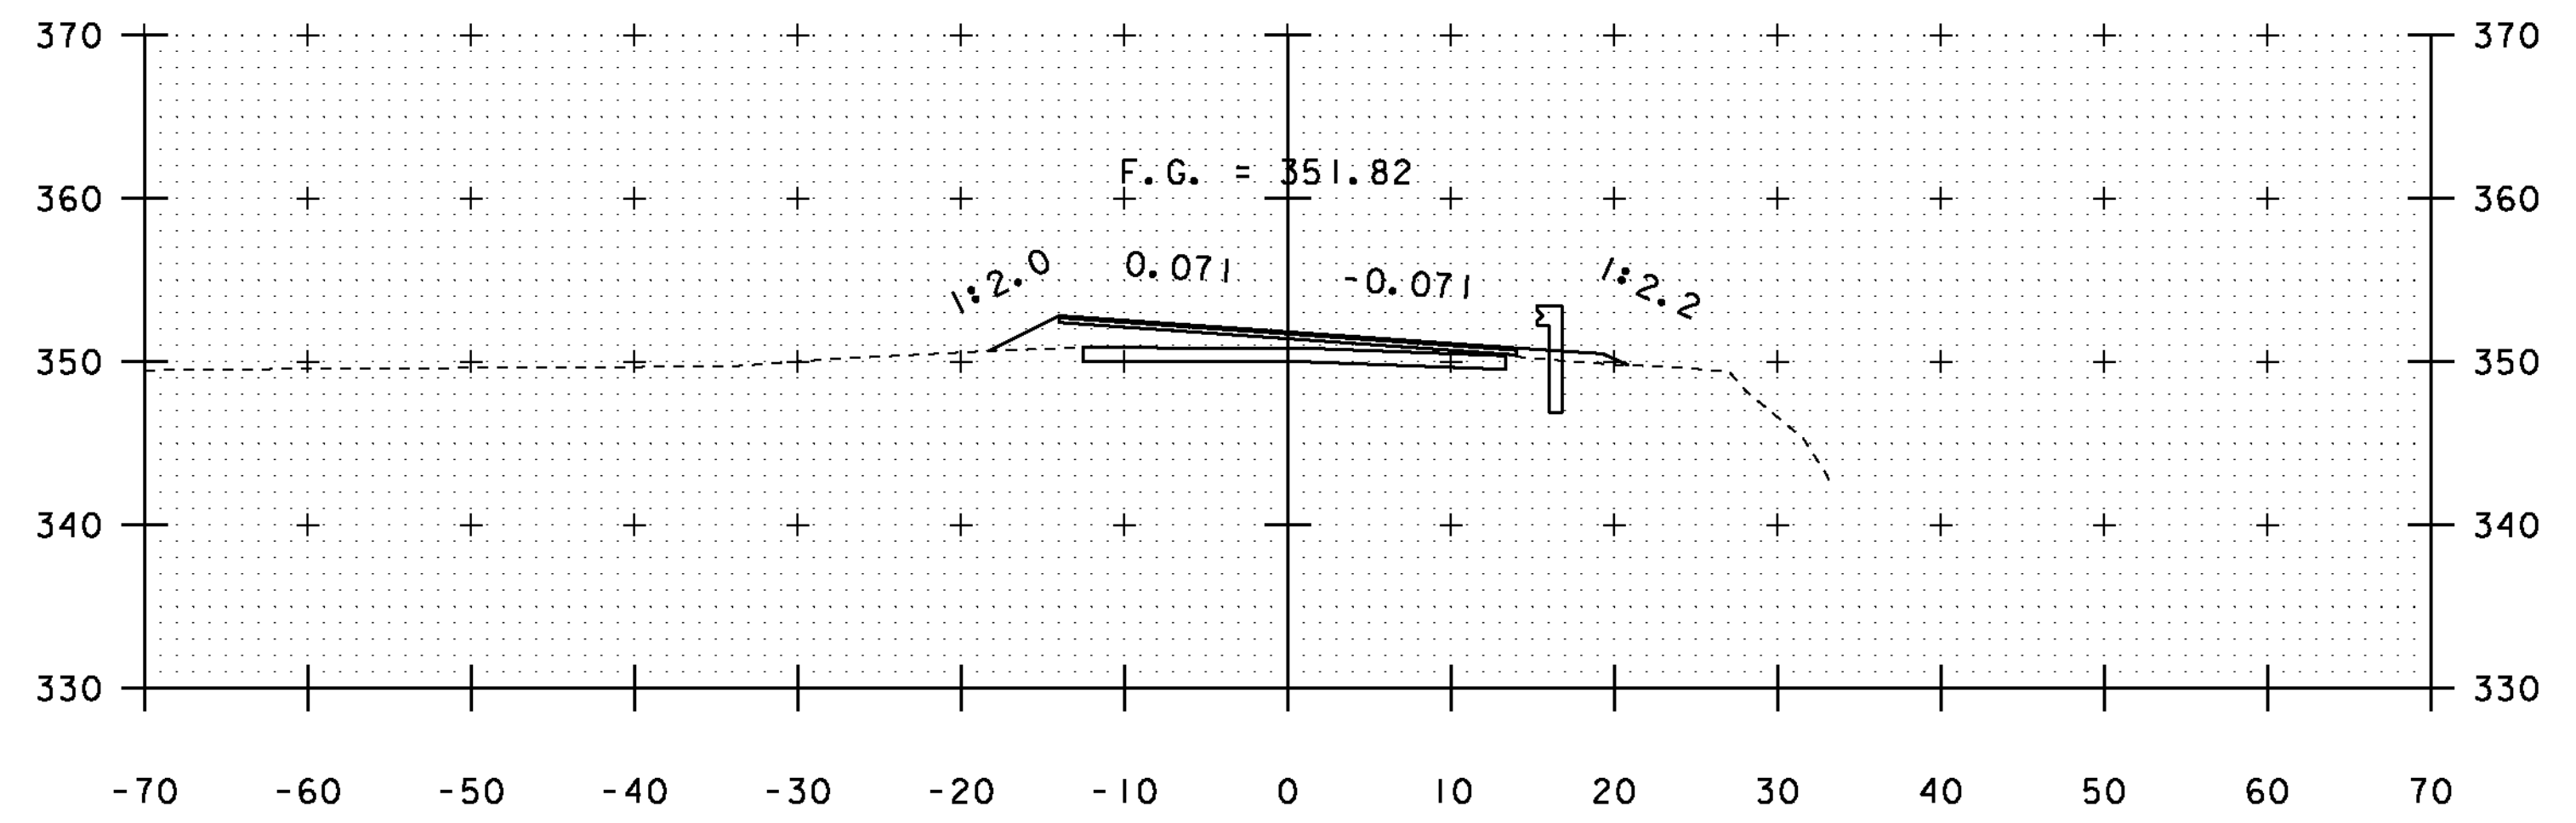


10+00

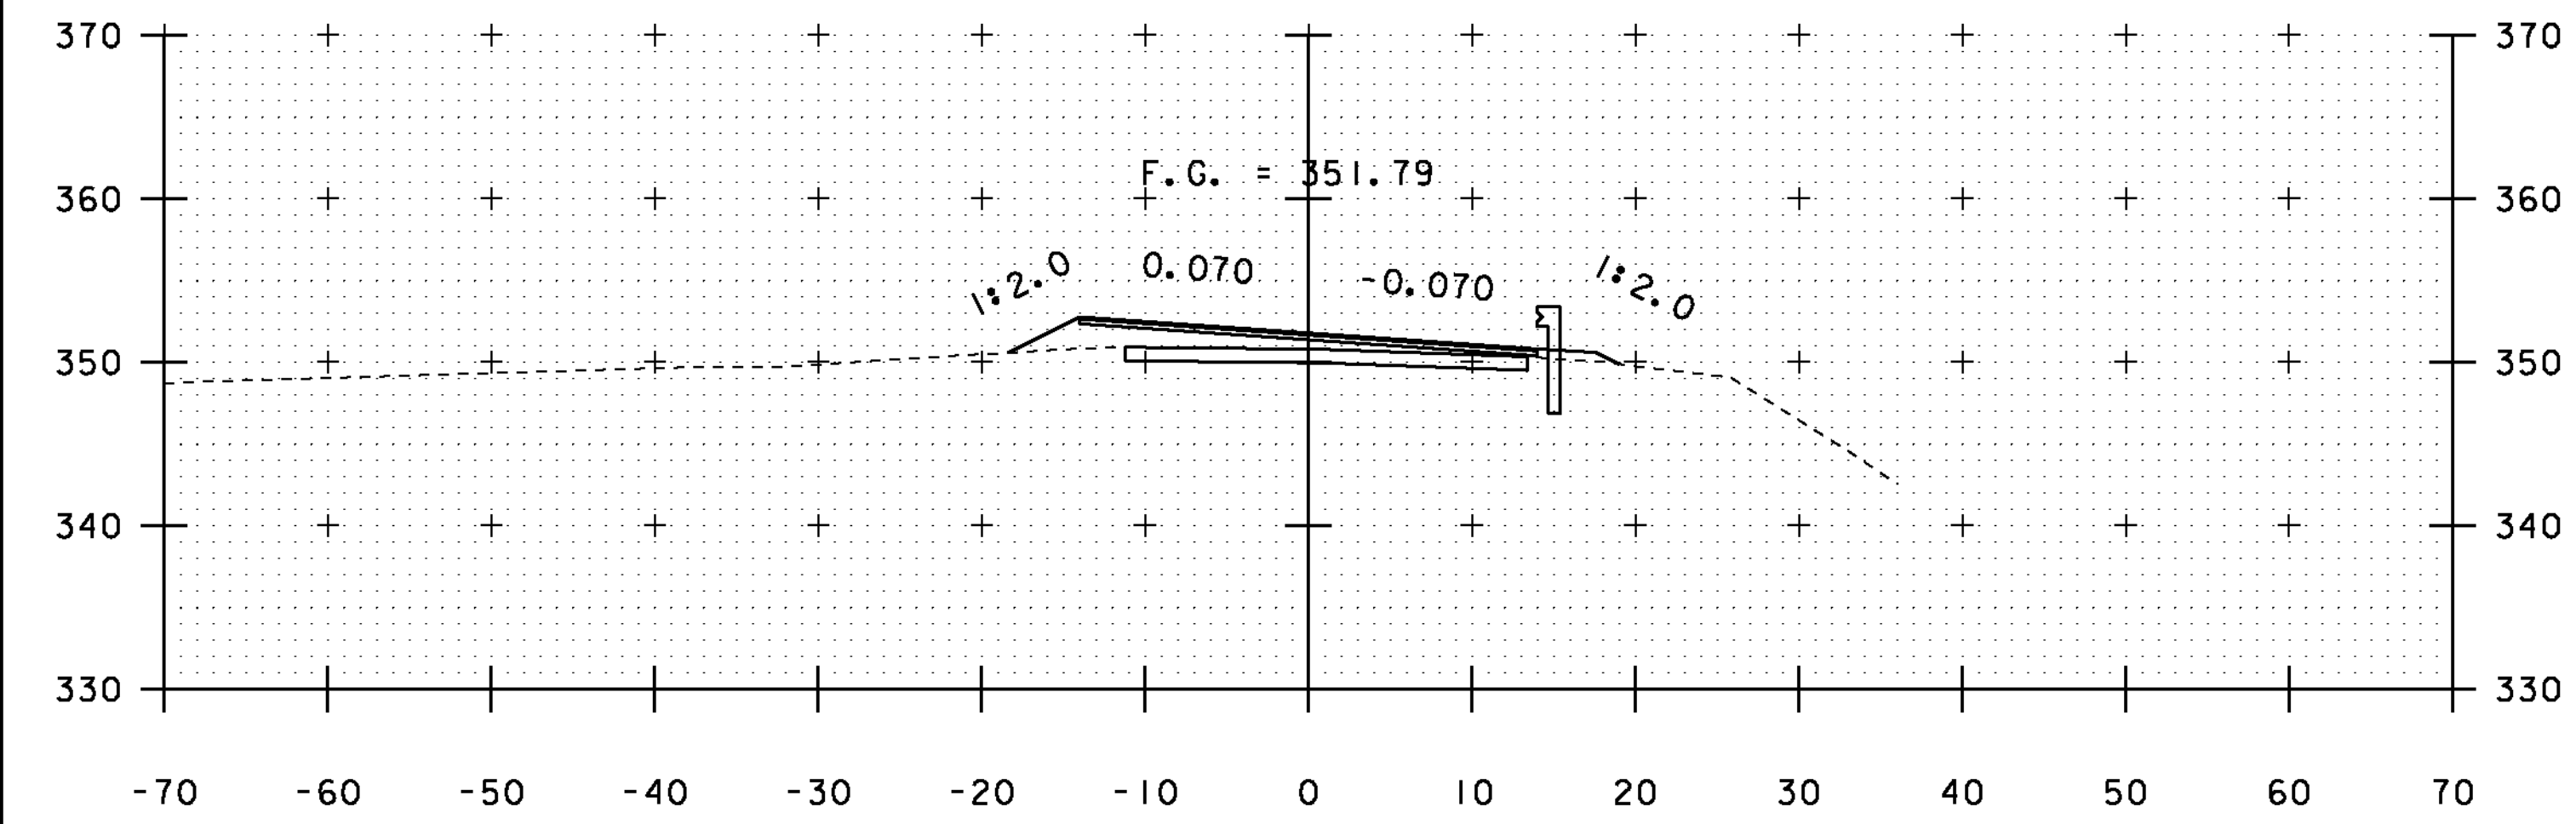


8+00

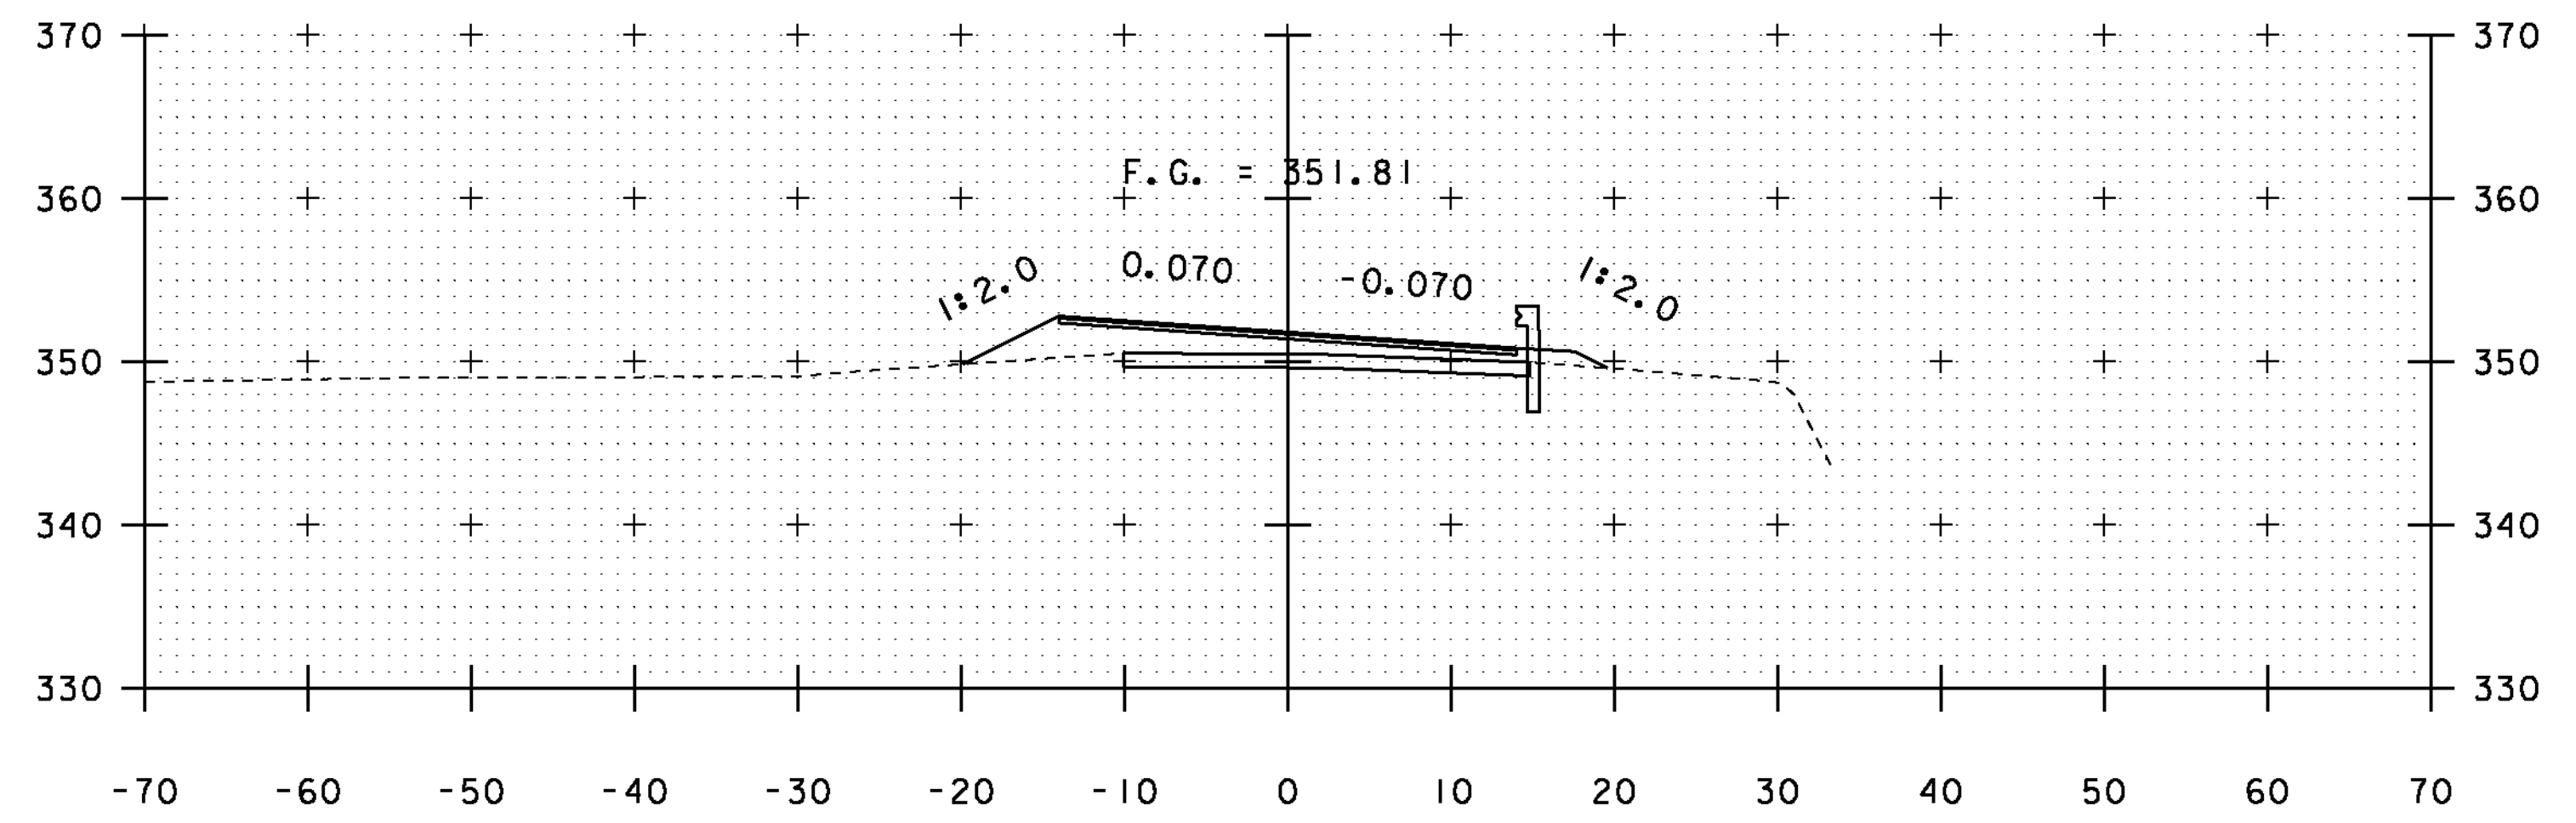

9+50

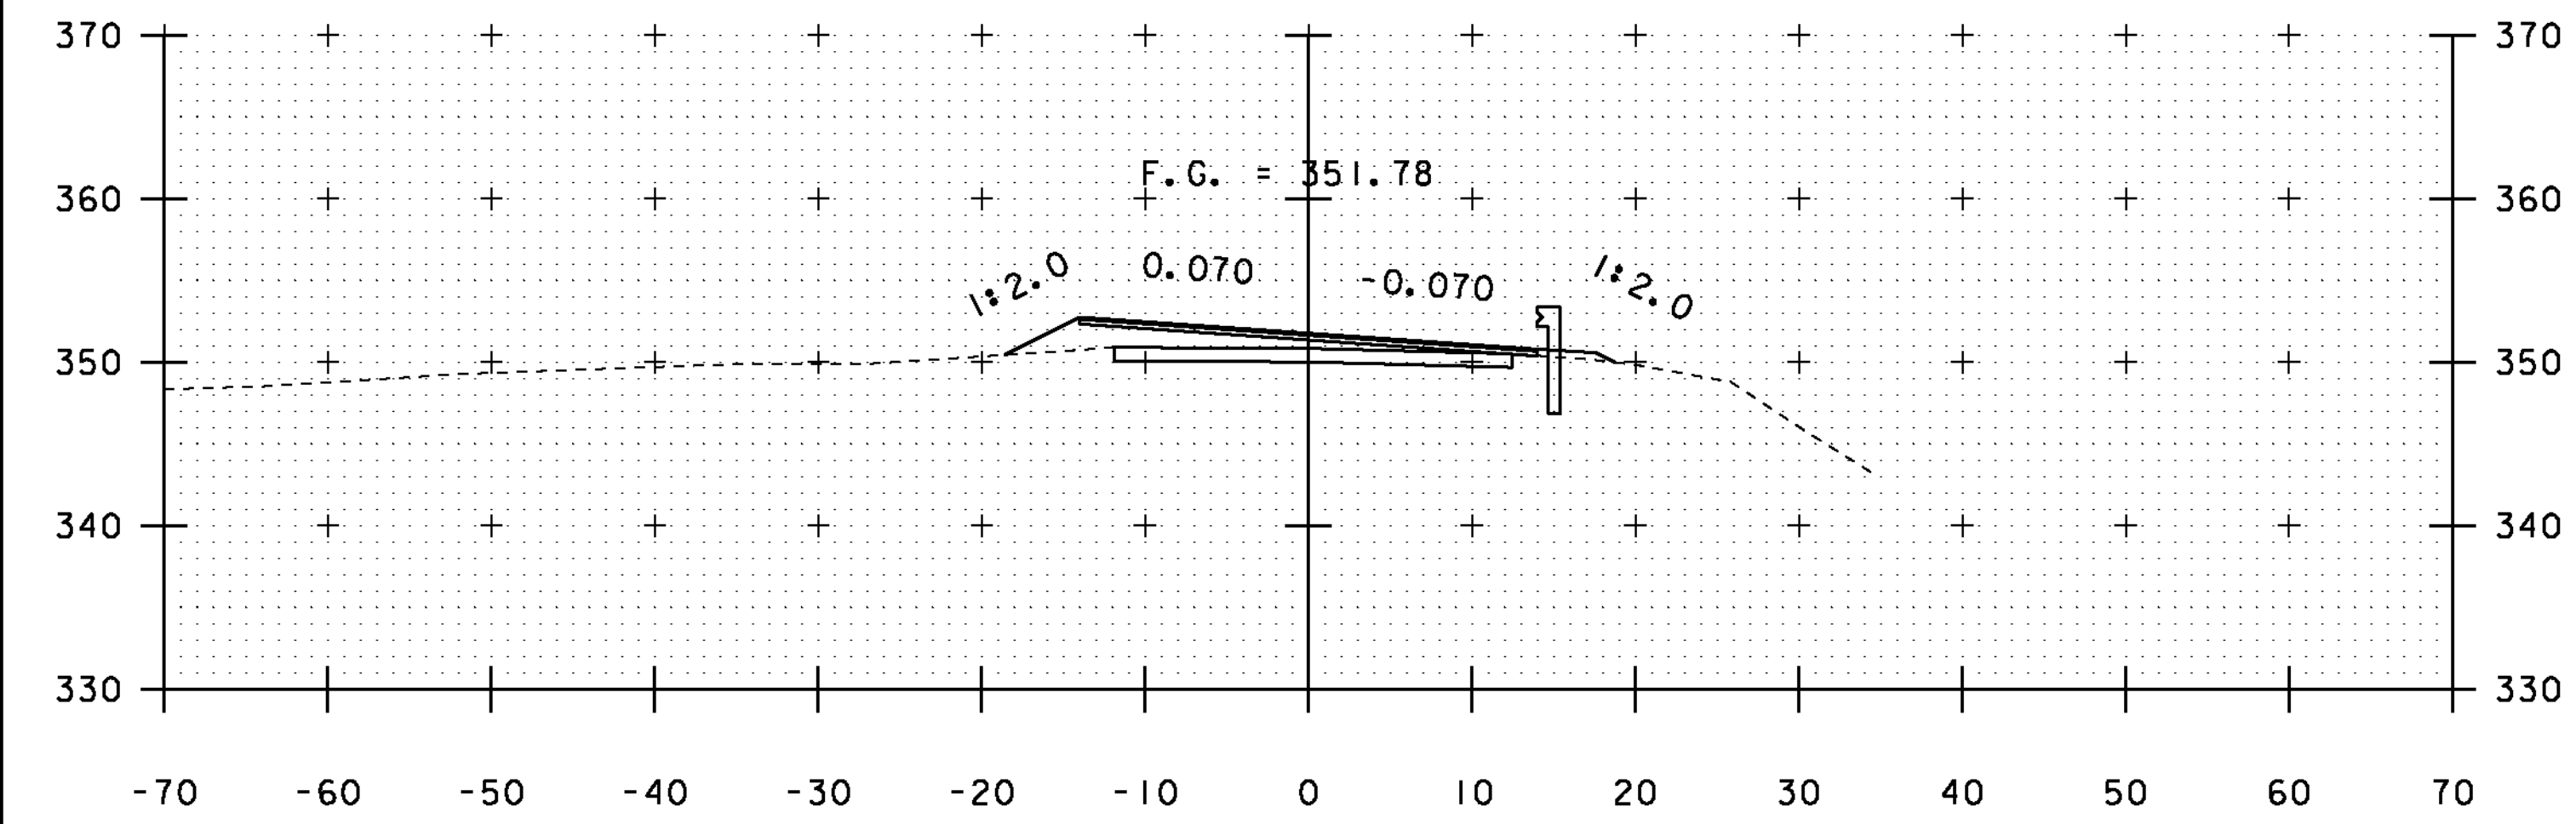

7+50

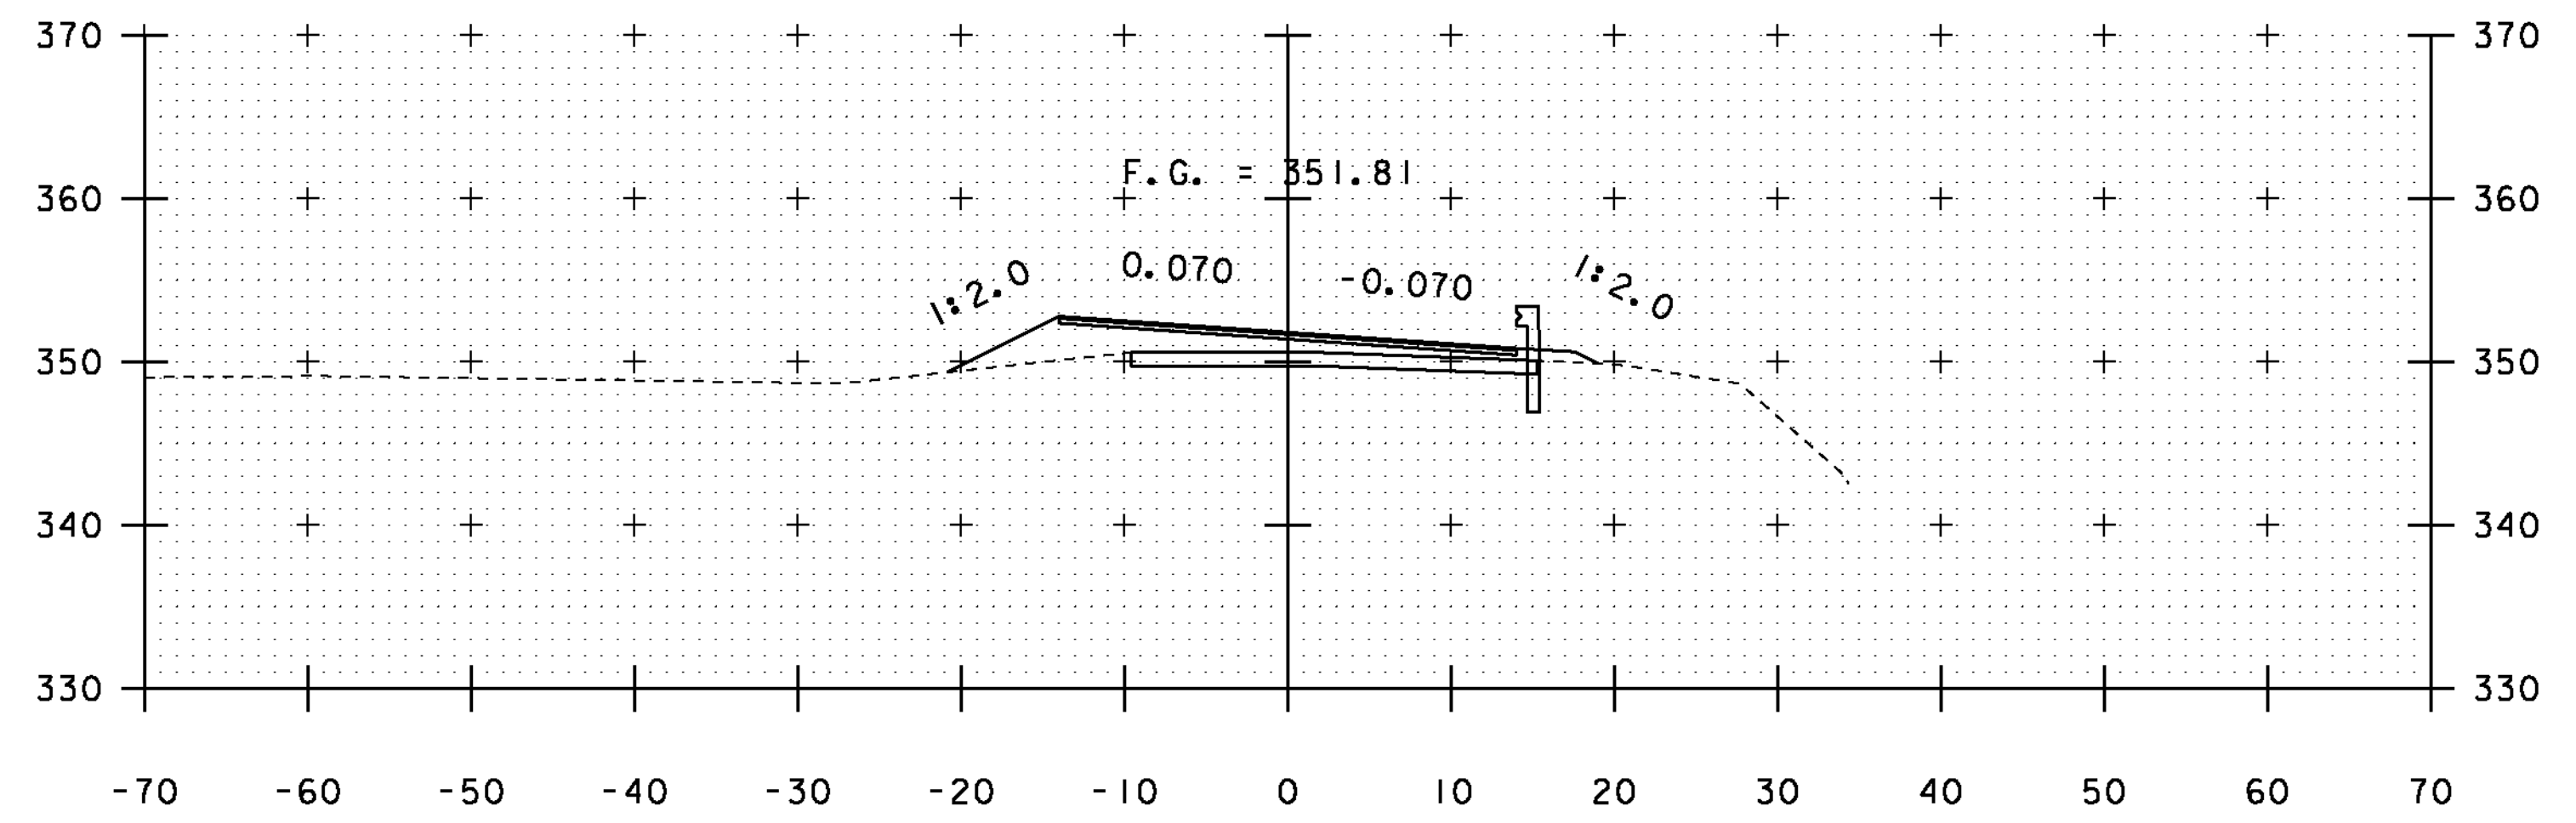

9+00



STA. 7+50 TO STA. 10+00

PROJECT NAME:	SUDBURY - BRANDON
PROJECT NUMBER:	STP 0158(3)
FILE NAME:	d10c204_xs.dgn
PROJECT LEADER:	K. UPMAL
DESIGNED BY:	B. MCADAMS
VT 73 CROSS SECTIONS IO	
PLOT DATE:	13-FEB-2013
DRAWN BY:	A. KEMPTON
CHECKED BY:	N. PAPPAS
SHEET	105 OF 137