




42+50

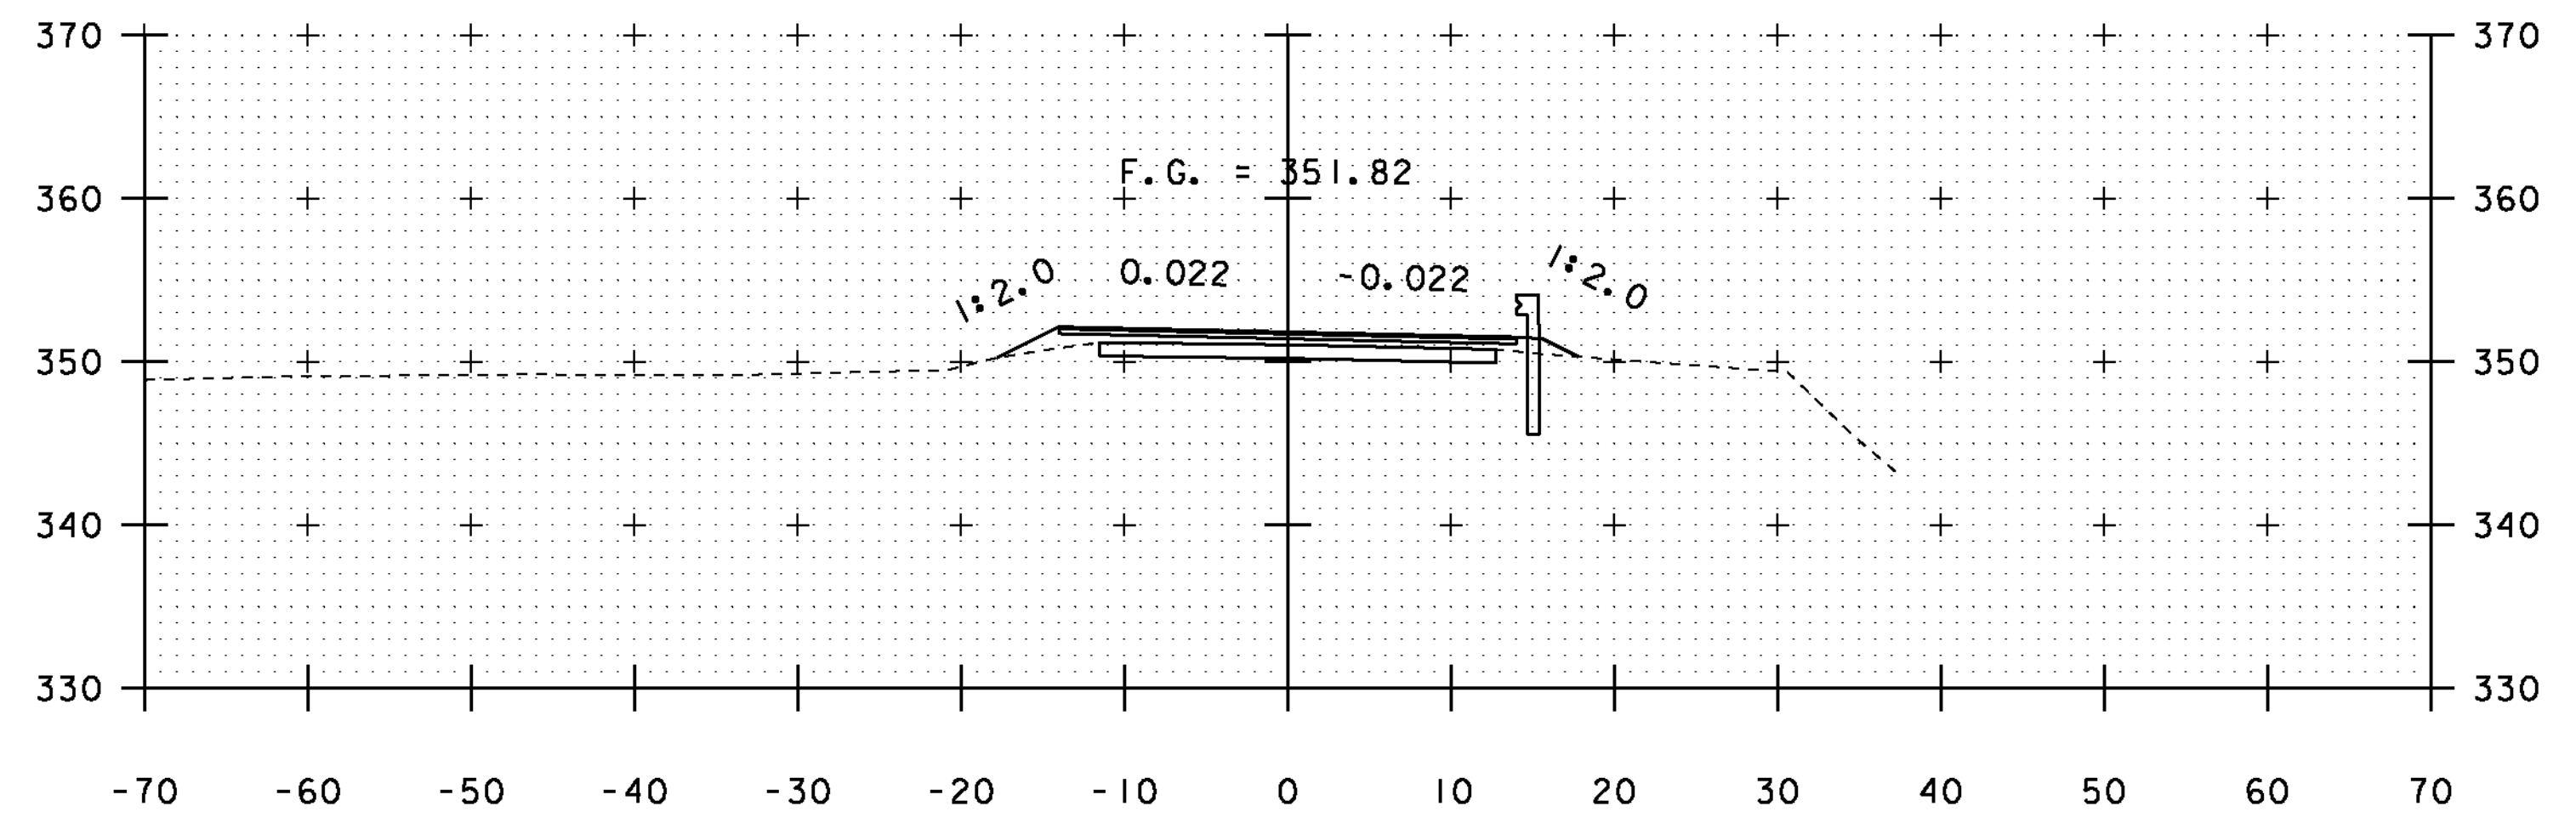


44+00

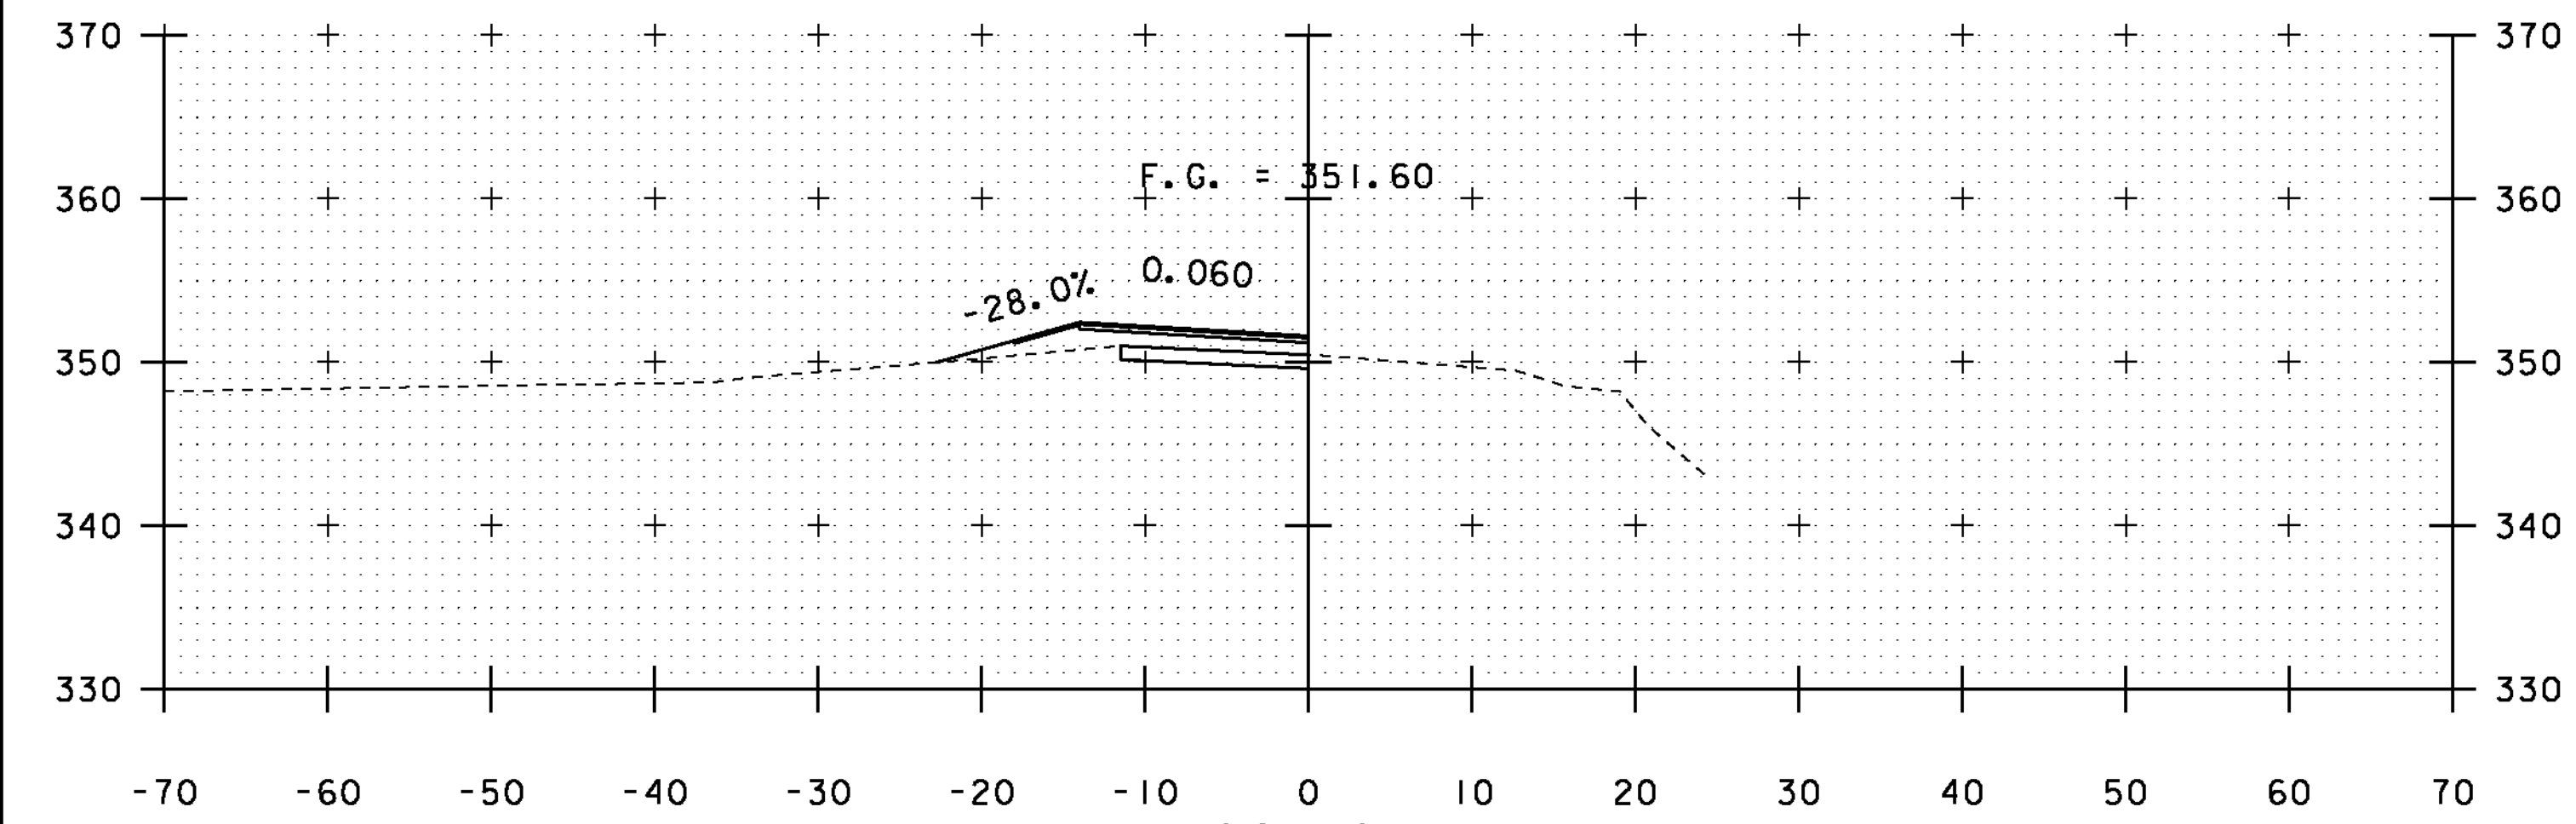


42+48
DRIVE LT

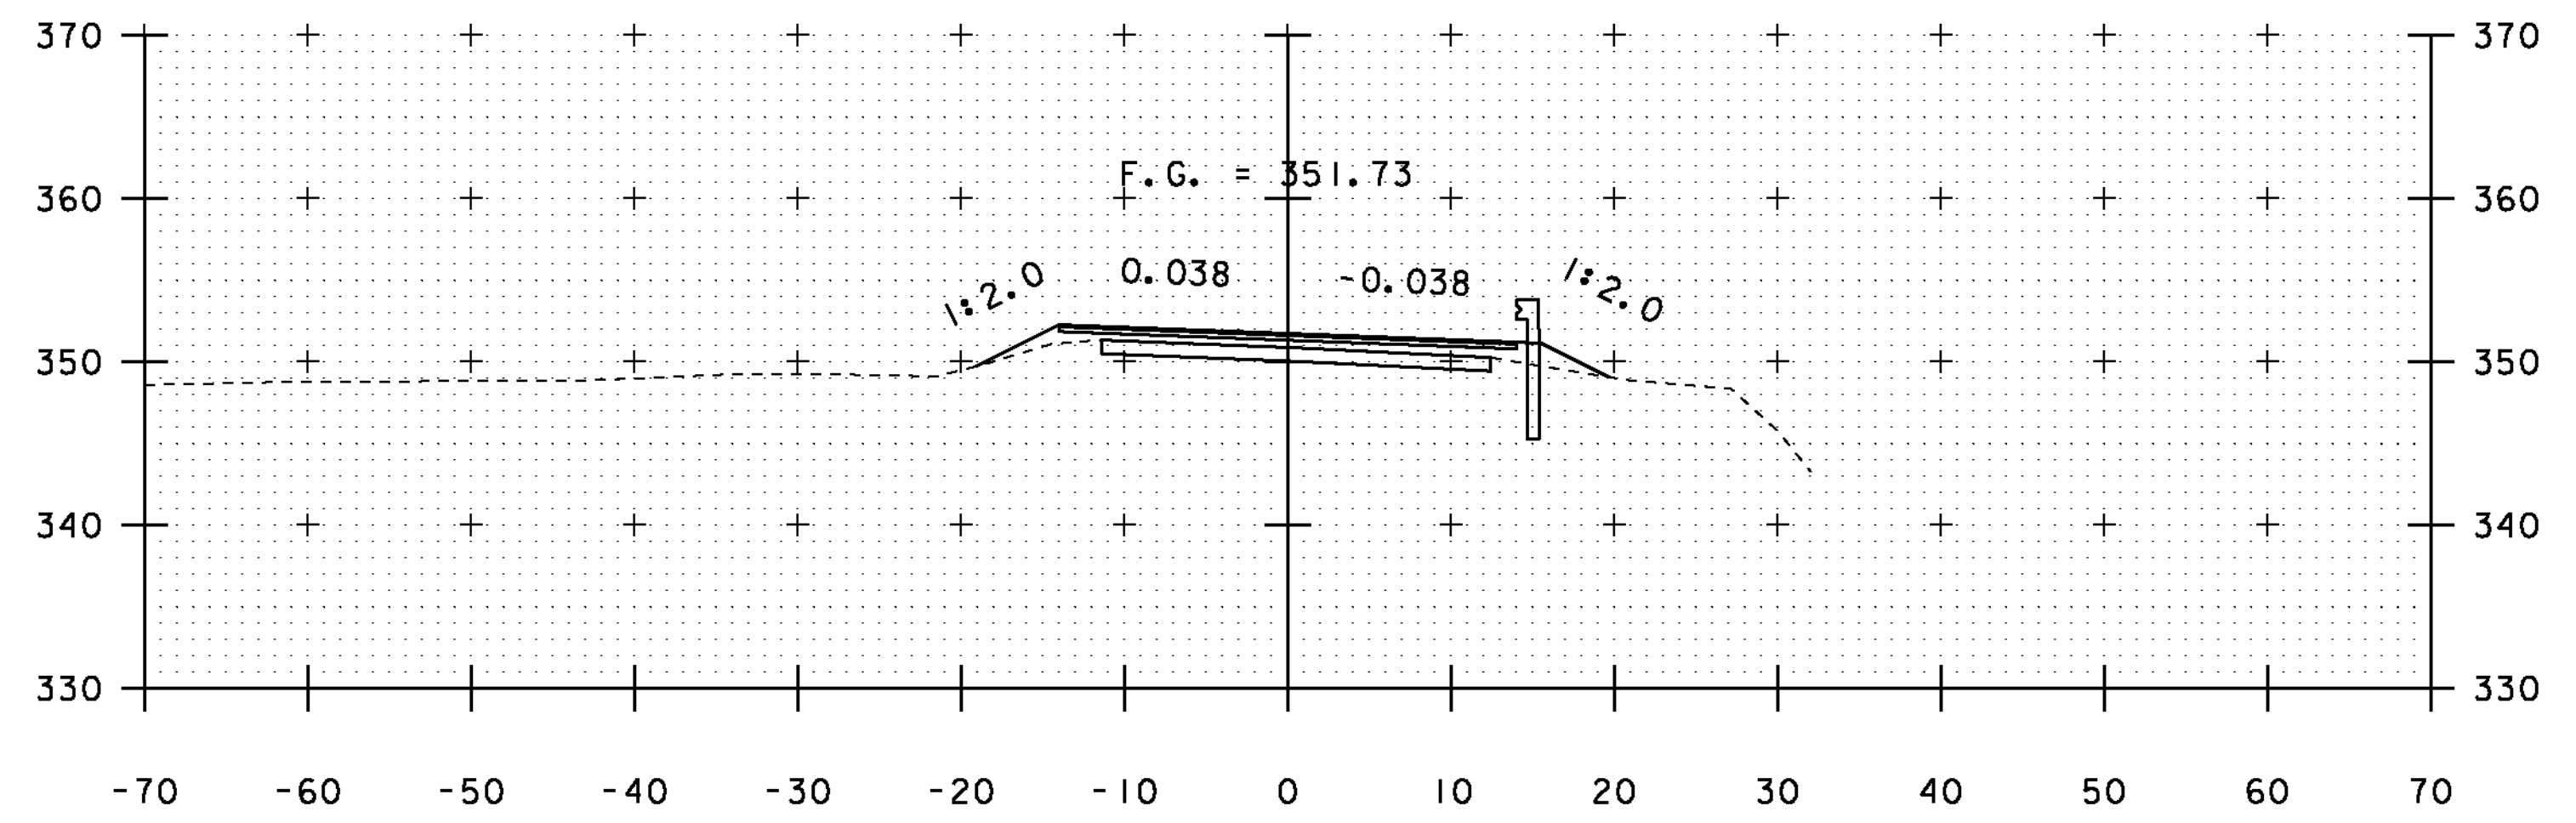

43+50

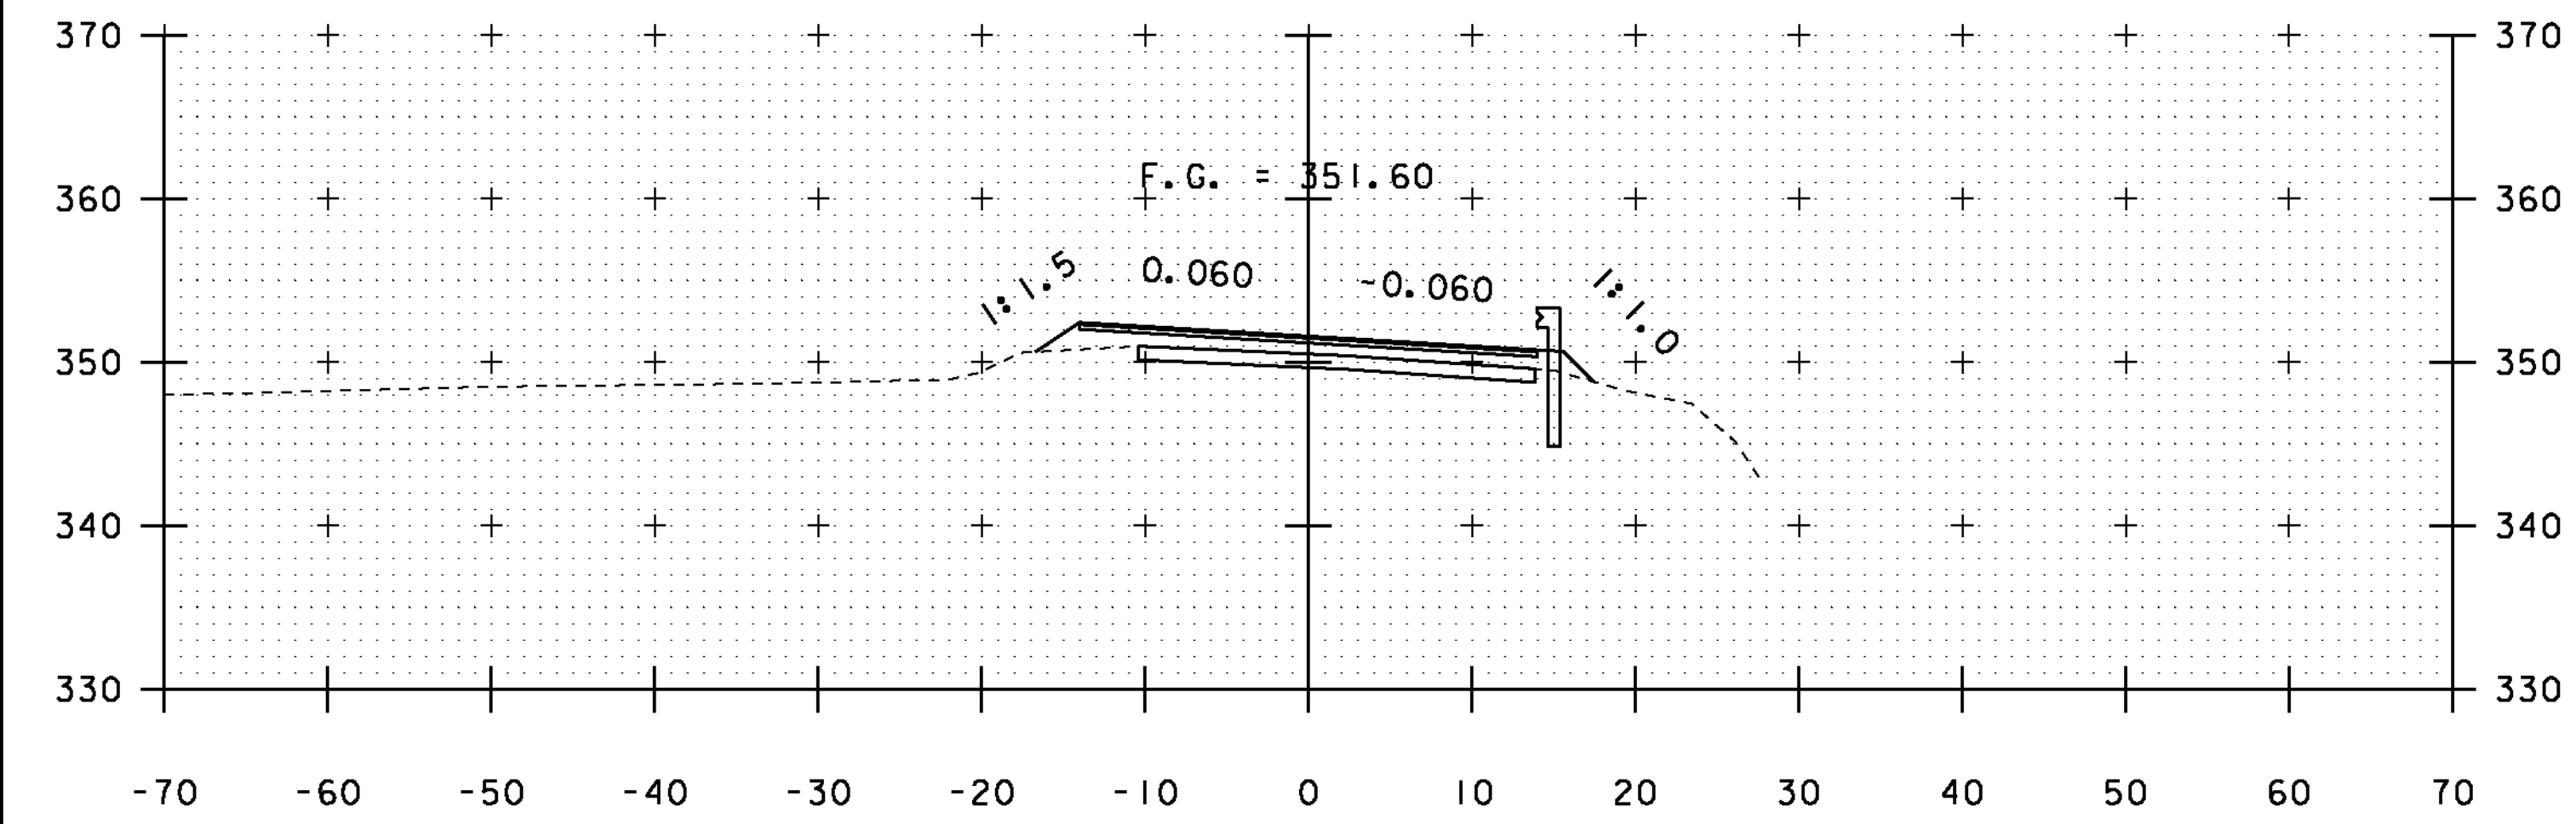

42+00

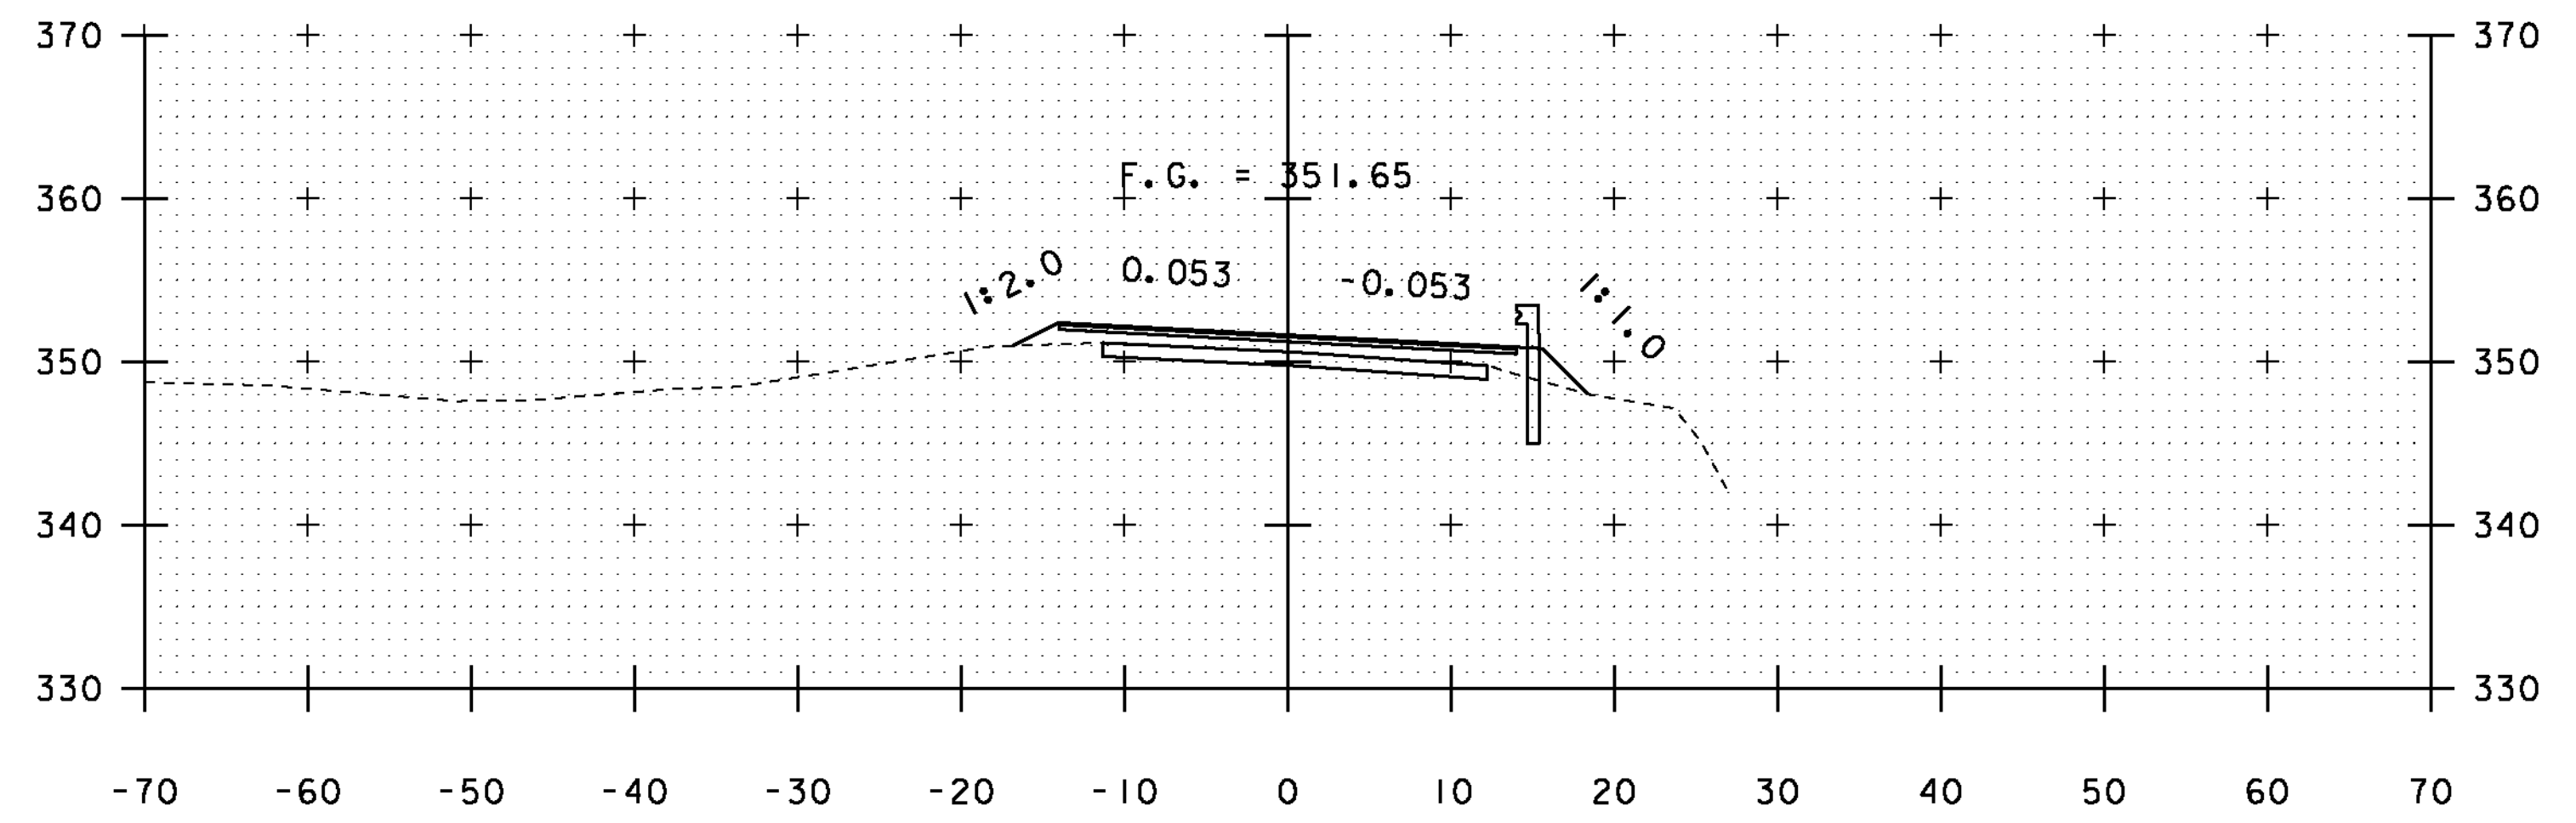

43+00



STA. 42+00 TO STA. 44+00

| | |
|----------------------|-------------------|
| PROJECT NAME: | SUDBURY - BRANDON |
| PROJECT NUMBER: | STP 0158(3) |
| FILE NAME: | d10c204_xs.dgn |
| PROJECT LEADER: | K. UPMAL |
| DESIGNED BY: | B. MCADAMS |
| VT 73 CROSS SECTIONS | 22 |
| PLOT DATE: | 13-FEB-2013 |
| DRAWN BY: | A. KEMPTON |
| CHECKED BY: | N. PAPPAS |
| SHEET | 117 OF 137 |