




45+50

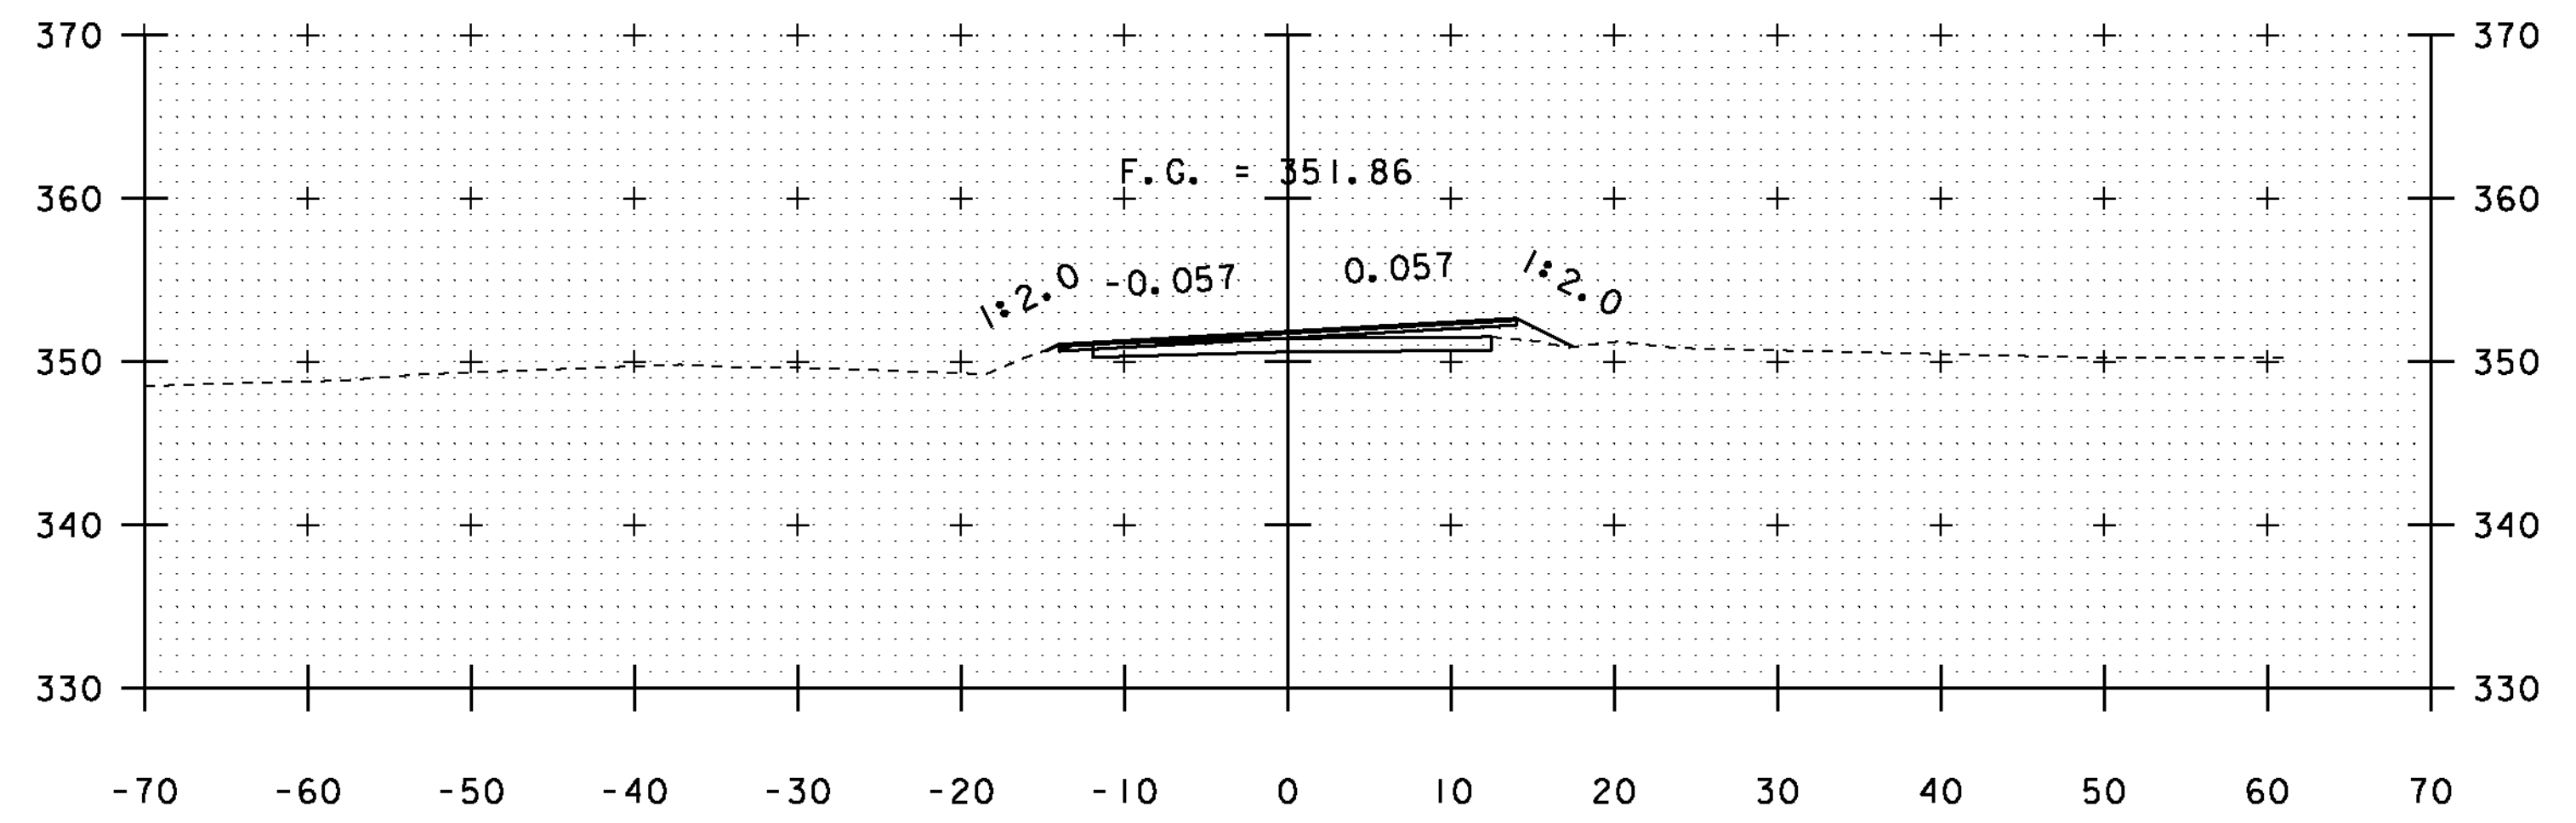


47+00

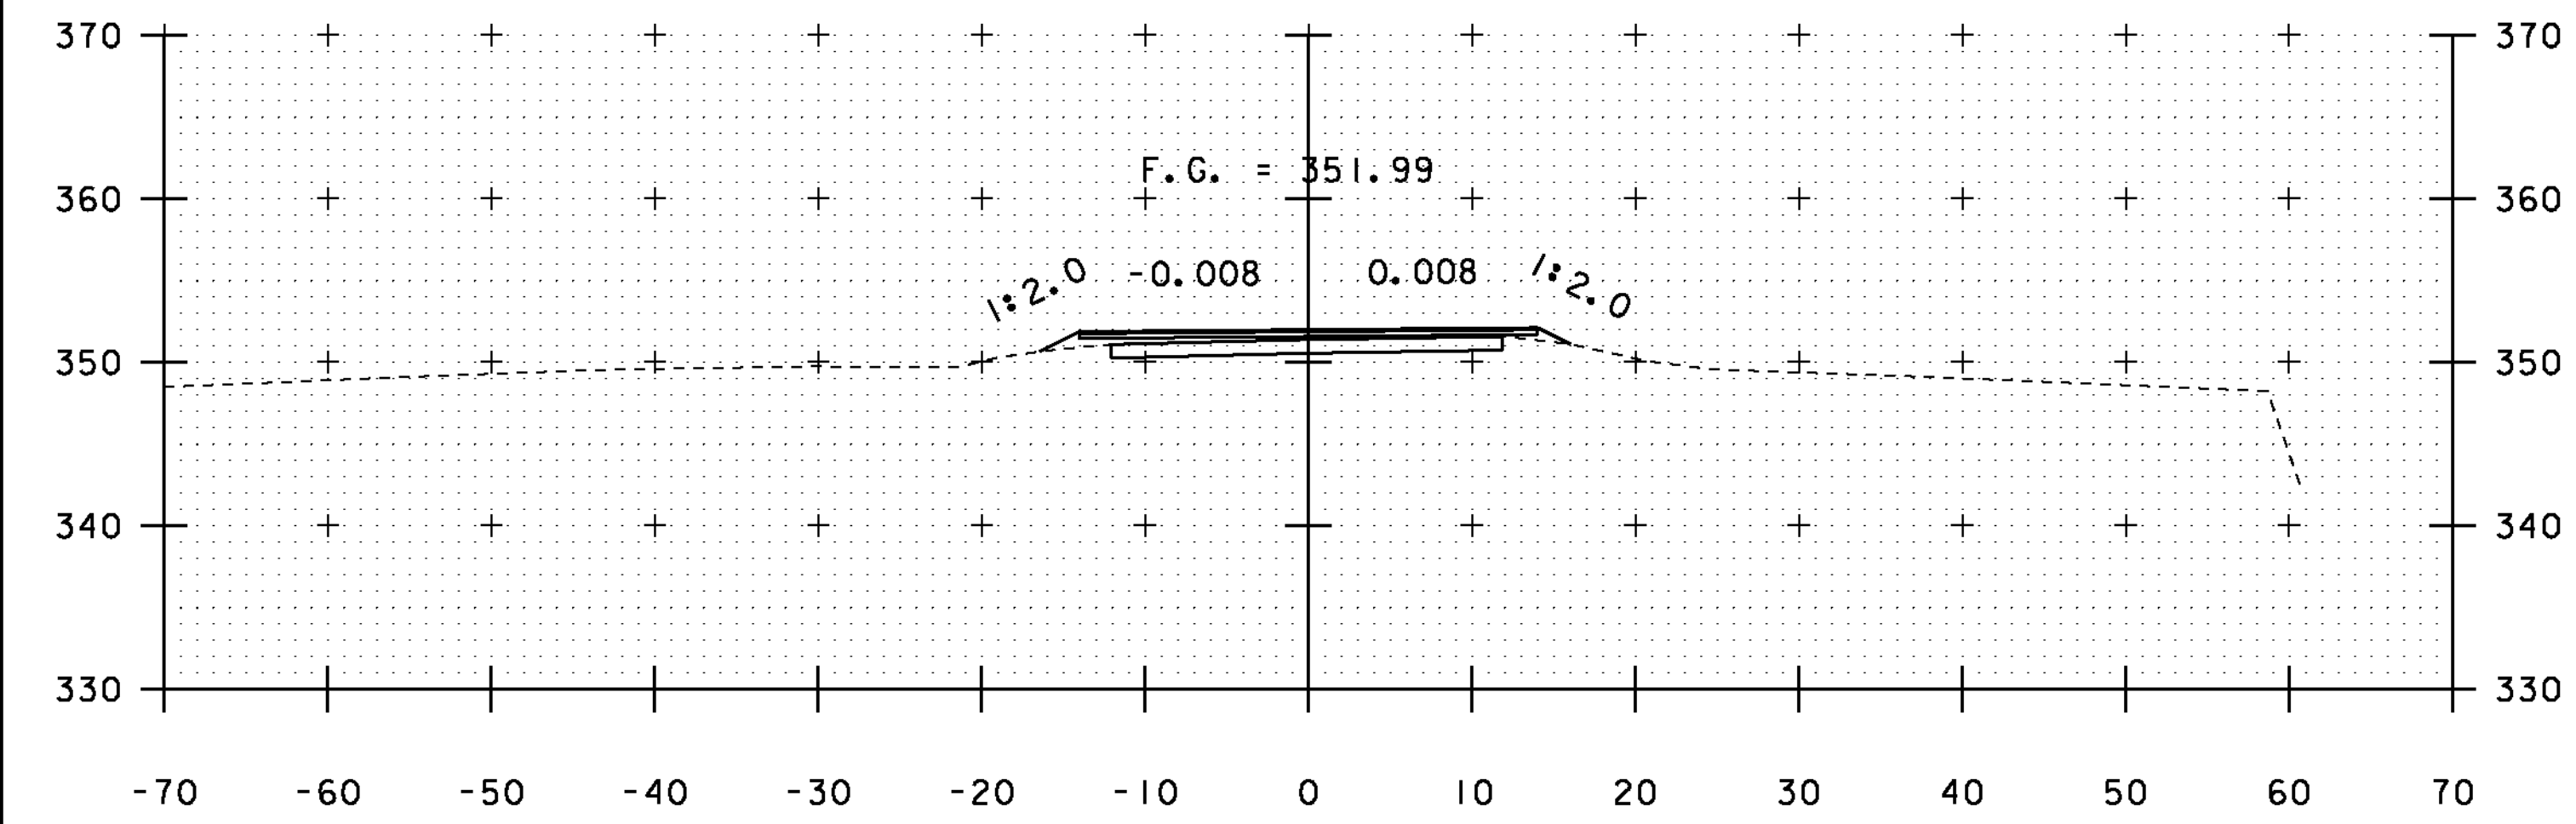


45+00

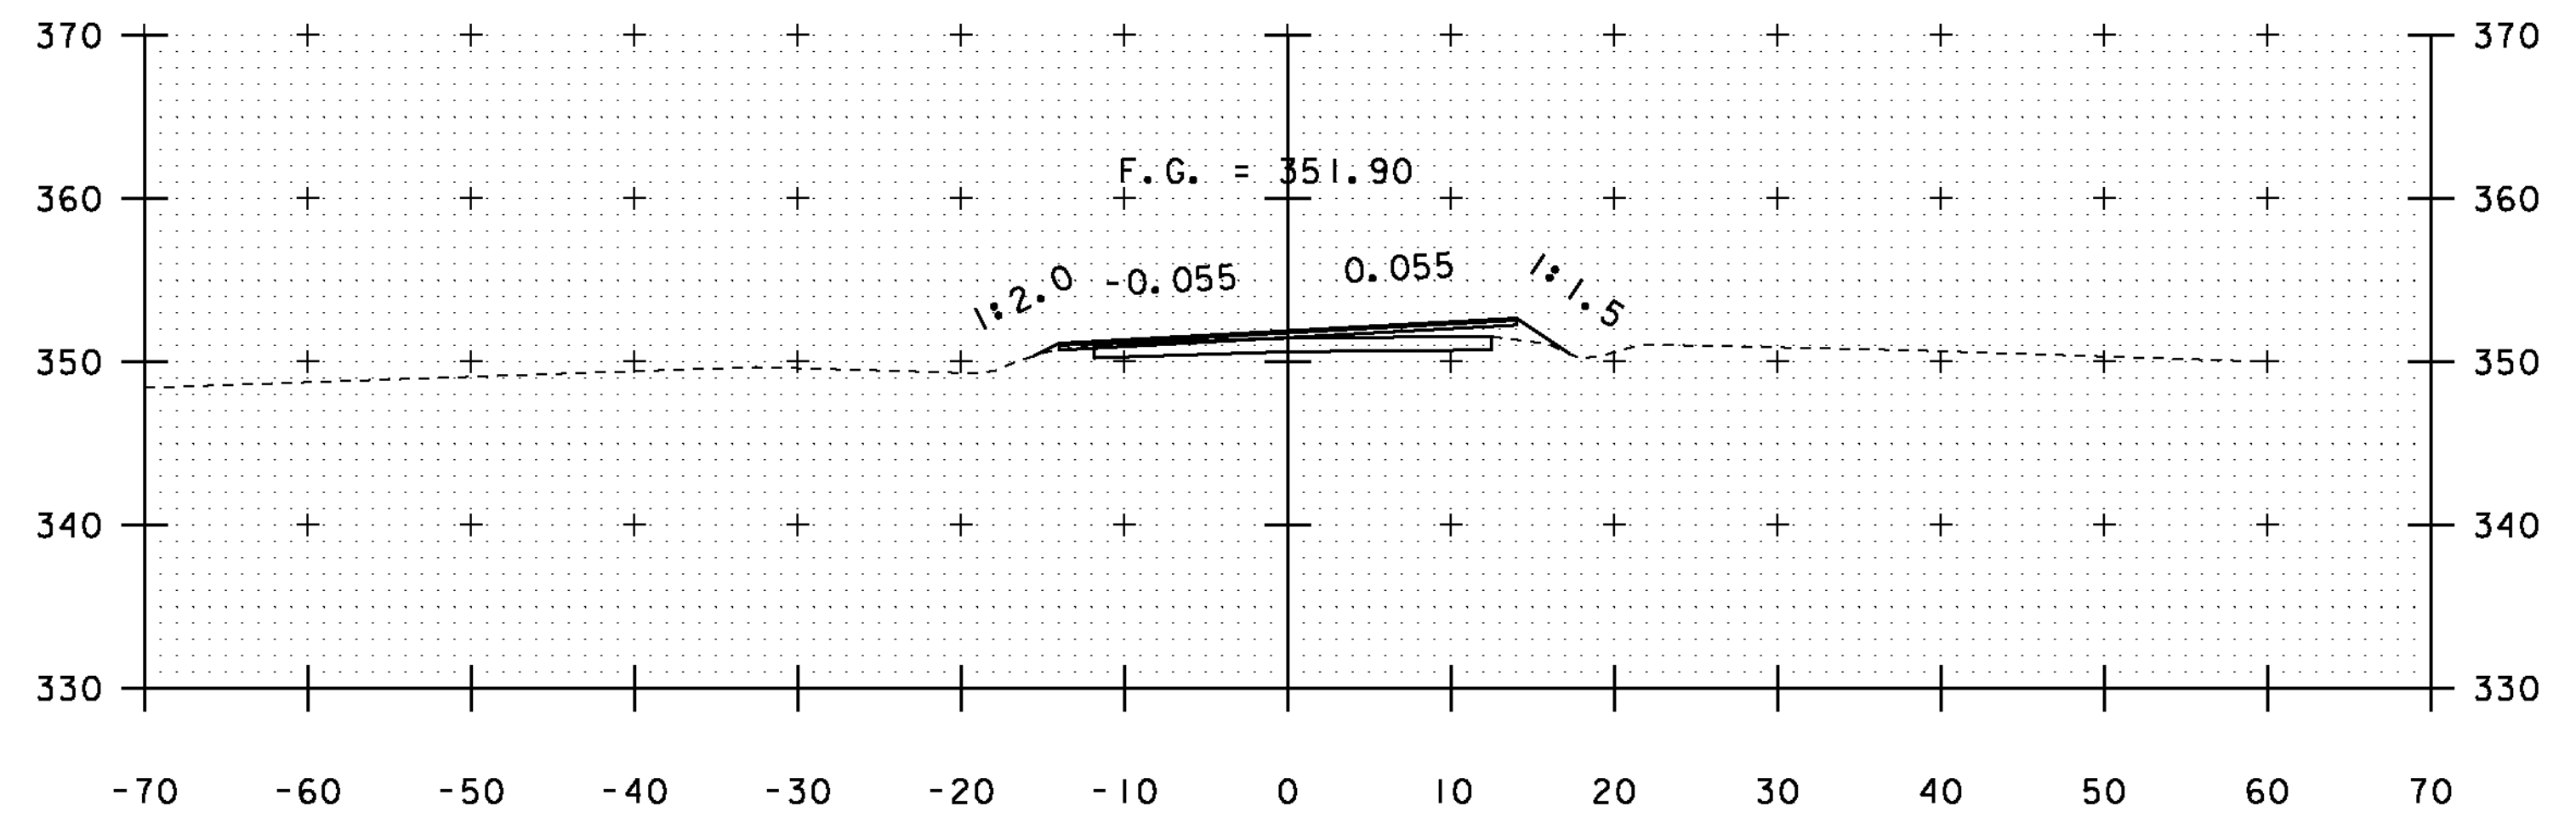


46+50

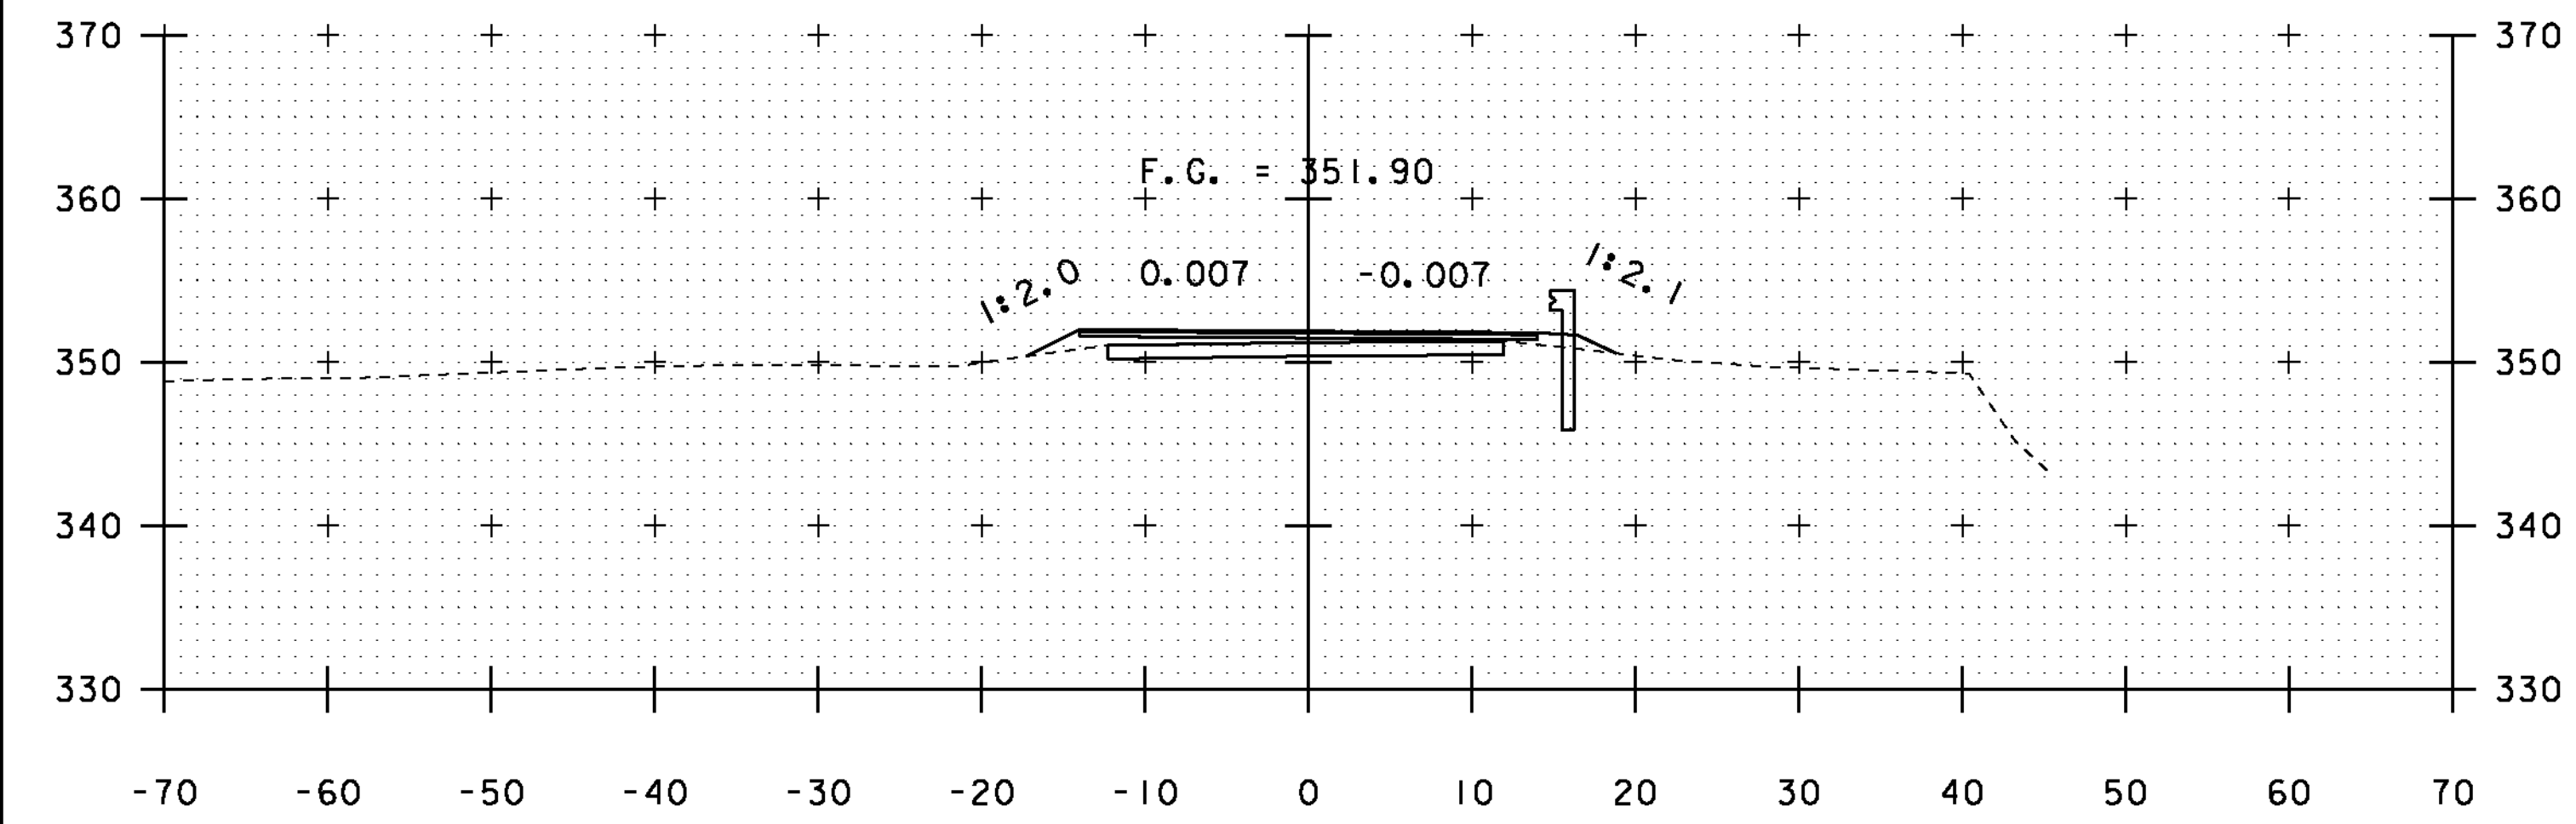

44+50

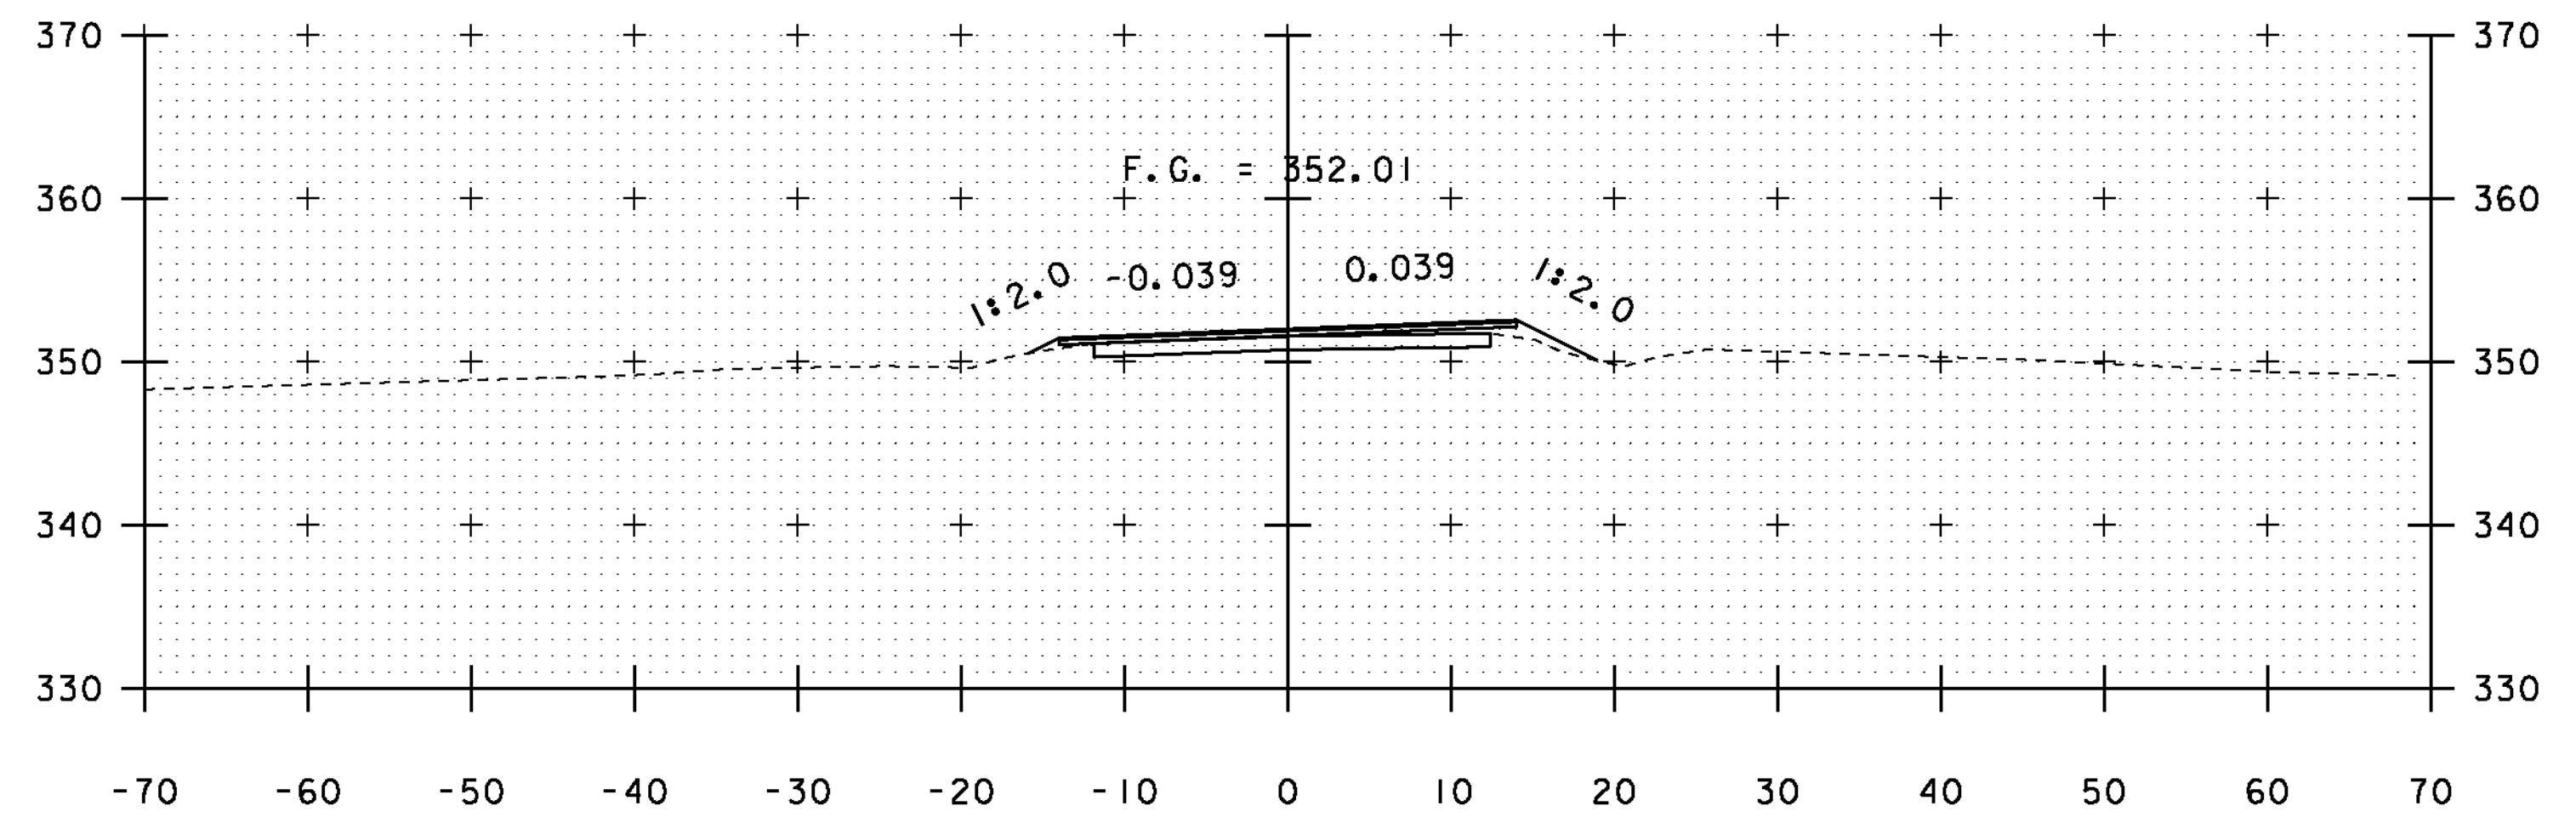

46+00

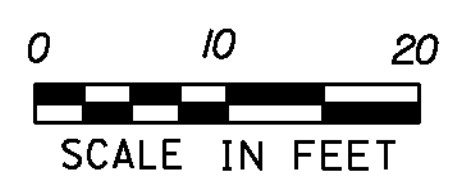

STA. 44+50 TO STA. 47+00

PROJECT NAME:	SUDBURY - BRANDON
PROJECT NUMBER:	STP 0158(3)
FILE NAME:	d10c204_xs.dgn
PROJECT LEADER:	K. UPMAL
DESIGNED BY:	B. MCADAMS
VT 73 CROSS SECTIONS	23
PLOT DATE:	13-FEB-2013
DRAWN BY:	A. KEMPTON
CHECKED BY:	N. PAPPAS
SHEET	118 OF 137