




57+00

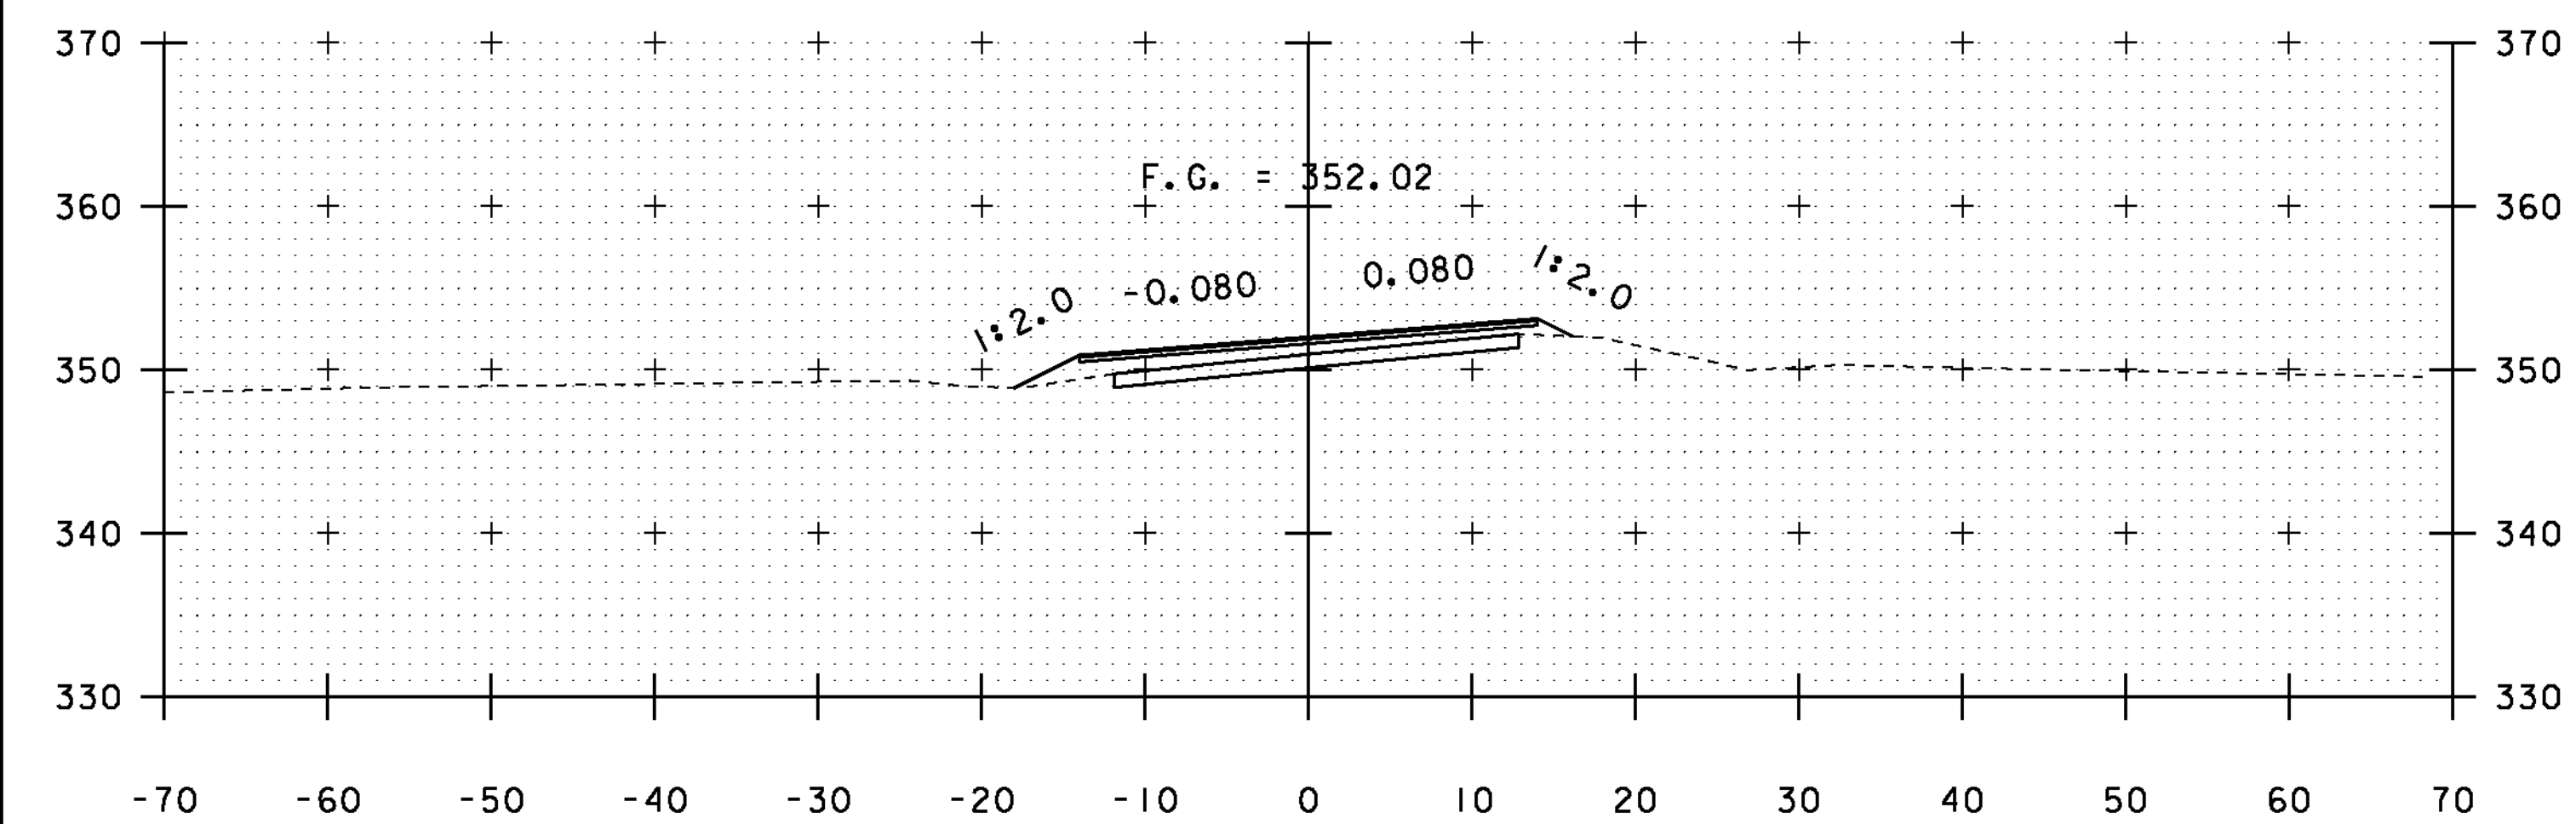


56+50

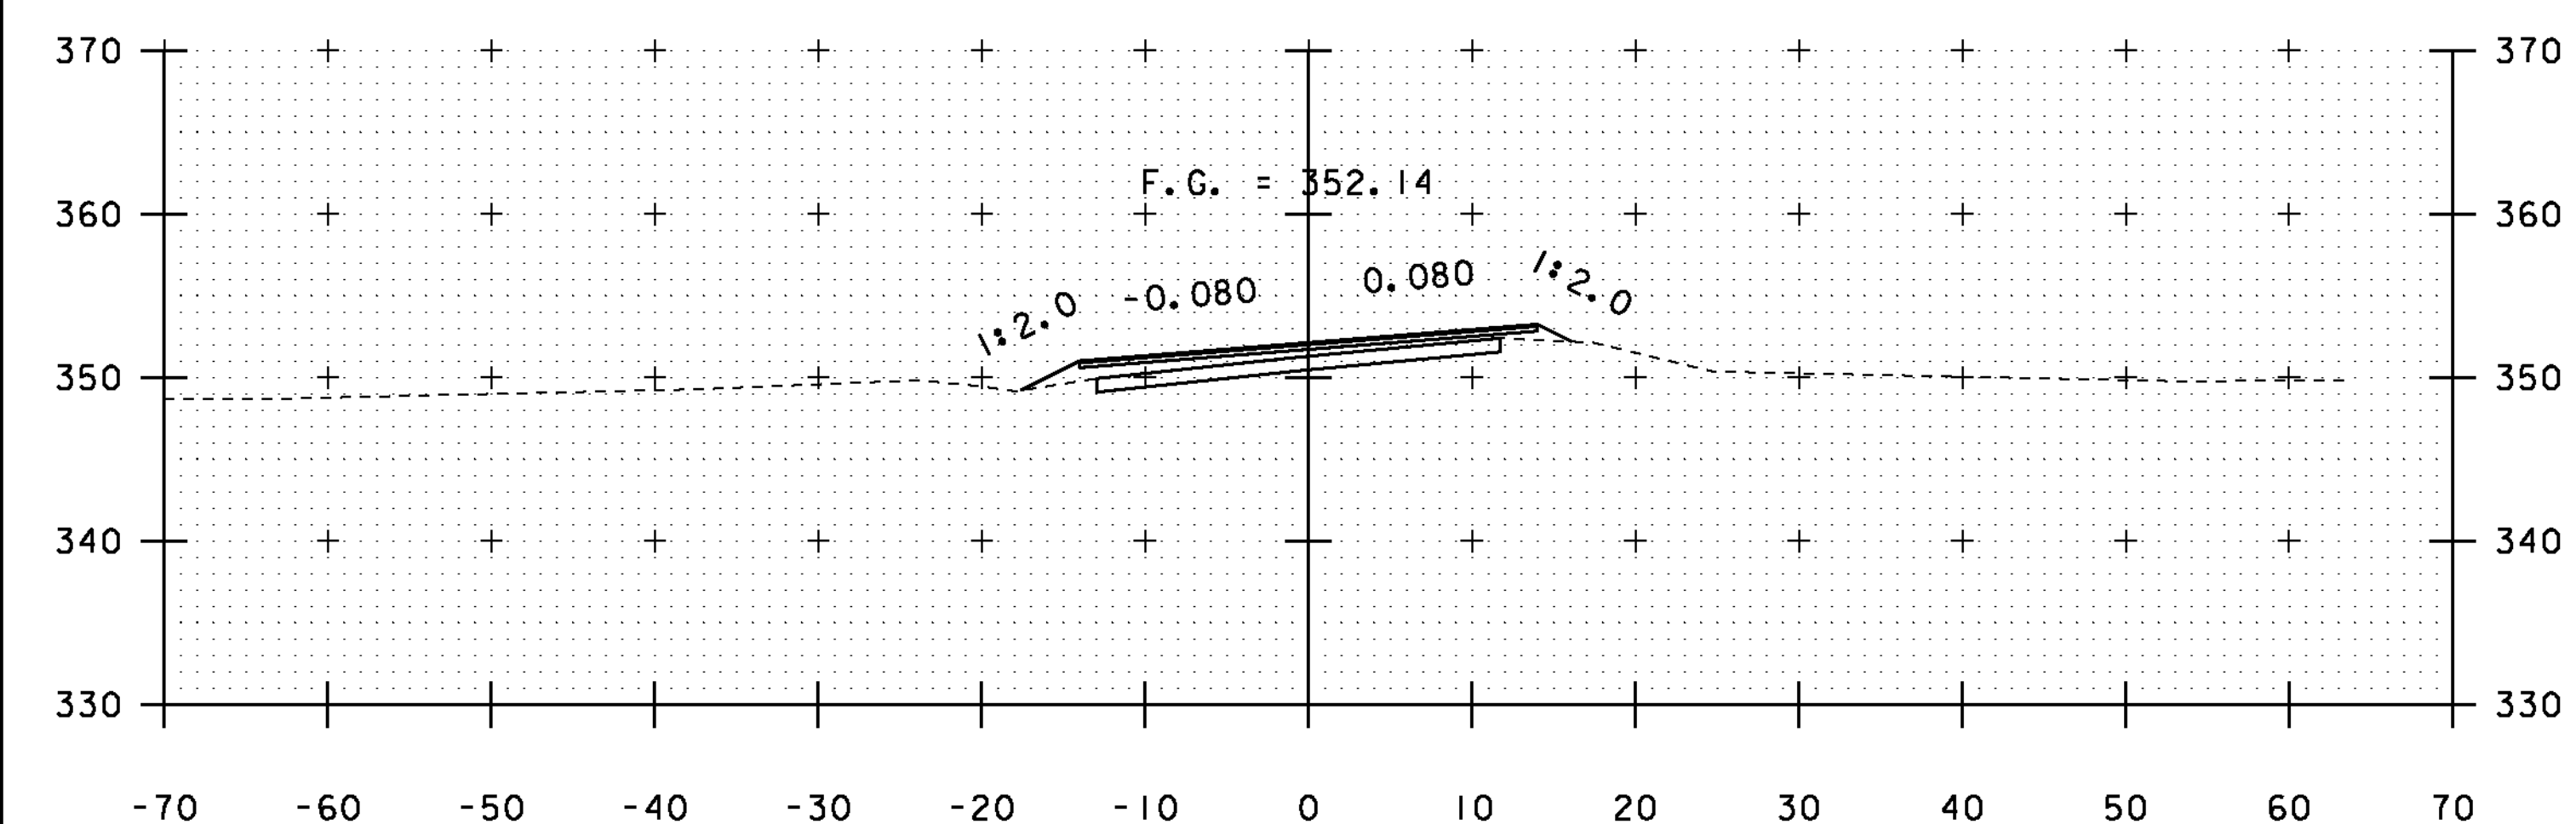


56+00

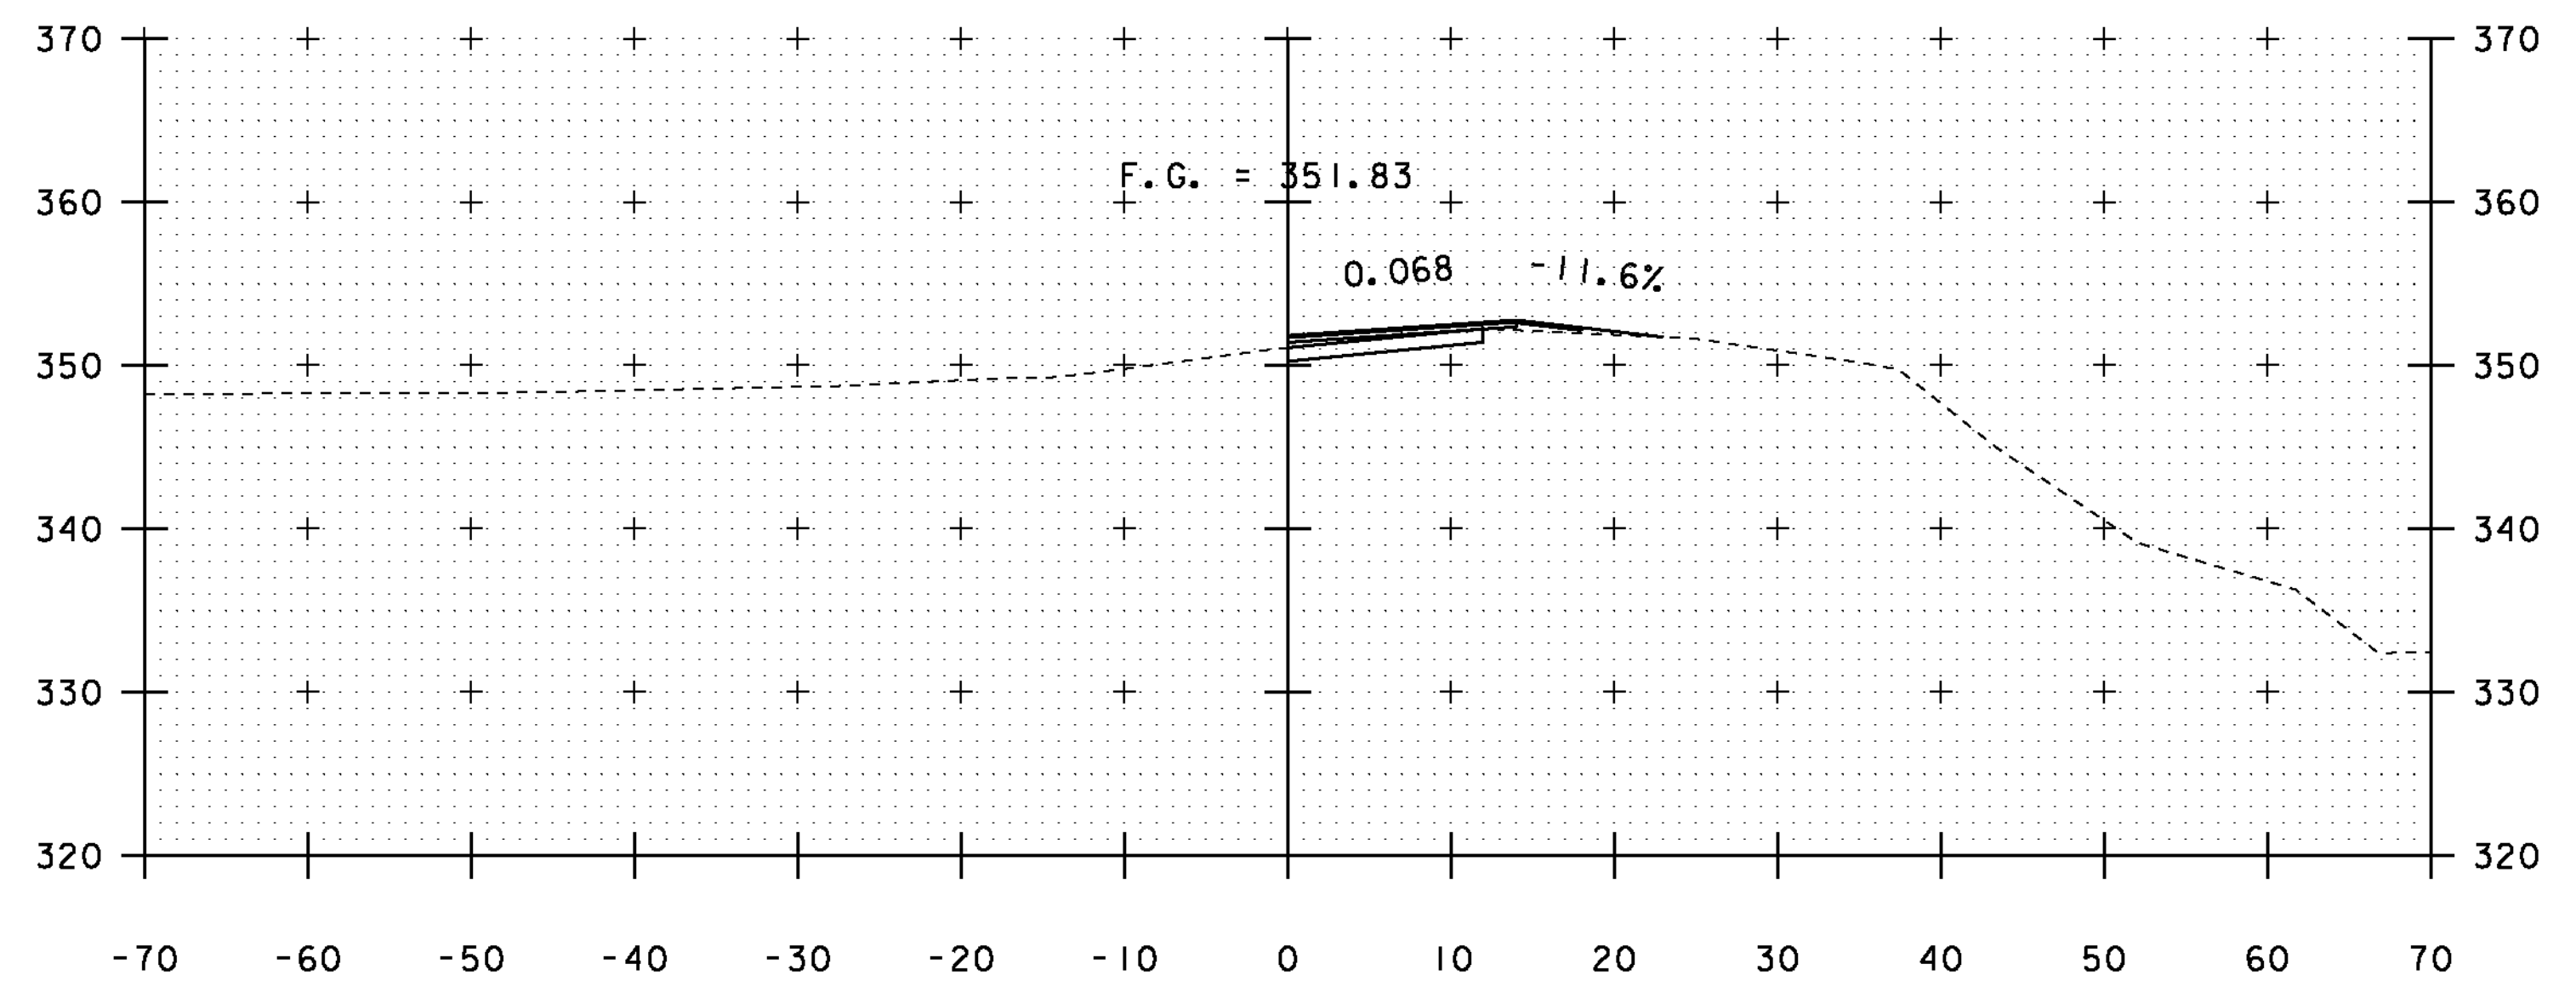

57+84
DRIVE RT

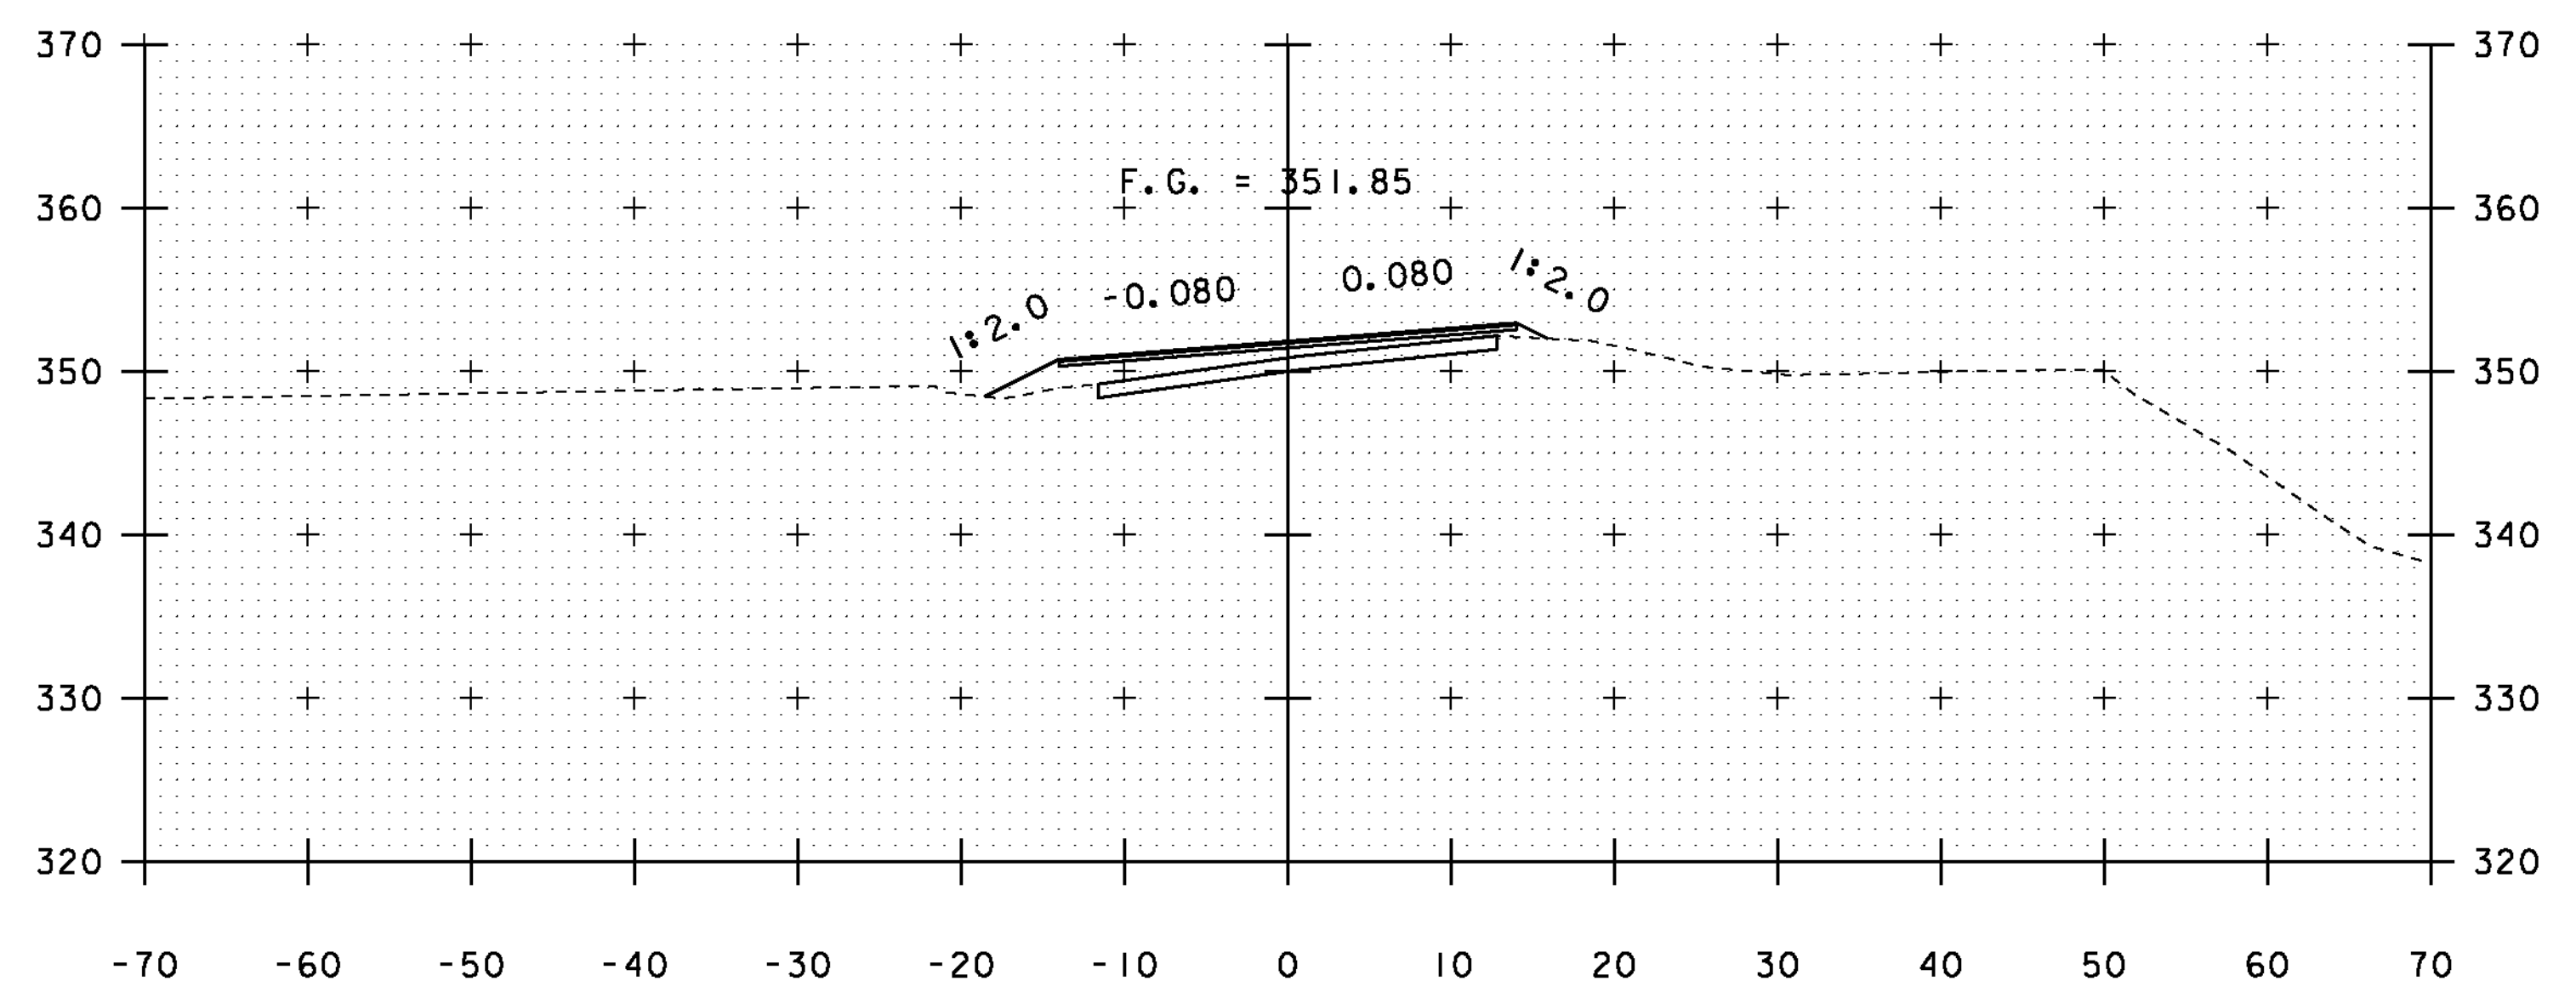

57+50

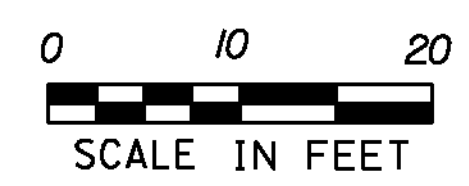

STA. 56+00 TO STA. 57+84

| | |
|-------------------------|-------------------|
| PROJECT NAME: | SUDBURY - BRANDON |
| PROJECT NUMBER: | STP 0158(3) |
| FILE NAME: | d10c204_xs.dgn |
| PROJECT LEADER: | K. UPMAL |
| DESIGNED BY: | B. MCADAMS |
| VT 73 CROSS SECTIONS 27 | |
| PLOT DATE: | 13-FEB-2013 |
| DRAWN BY: | A. KEMPTON |
| CHECKED BY: | N. PAPPAS |
| SHEET | 122 OF 137 |