




58+50

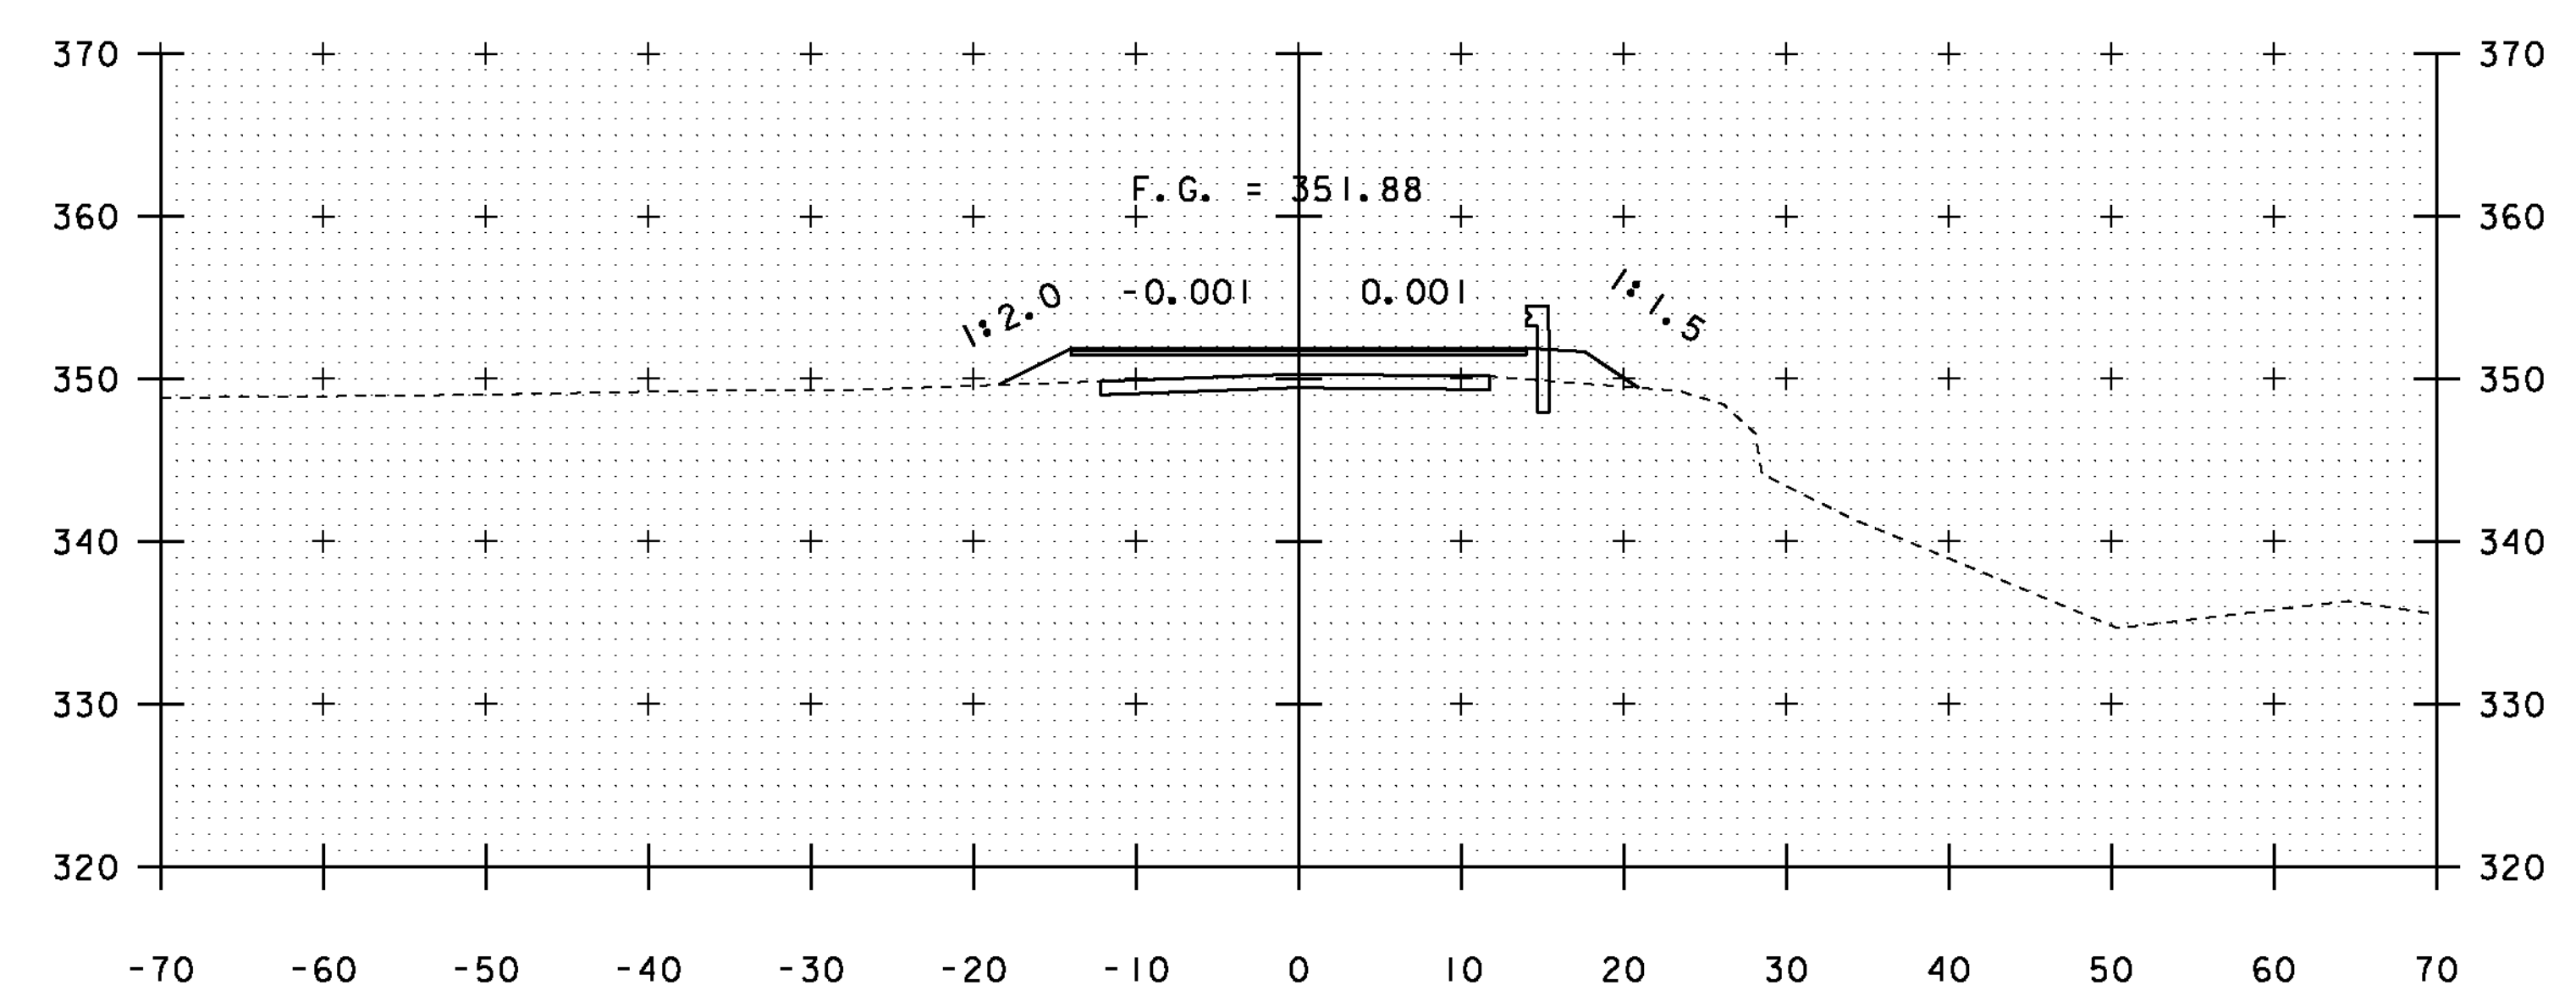


59+50

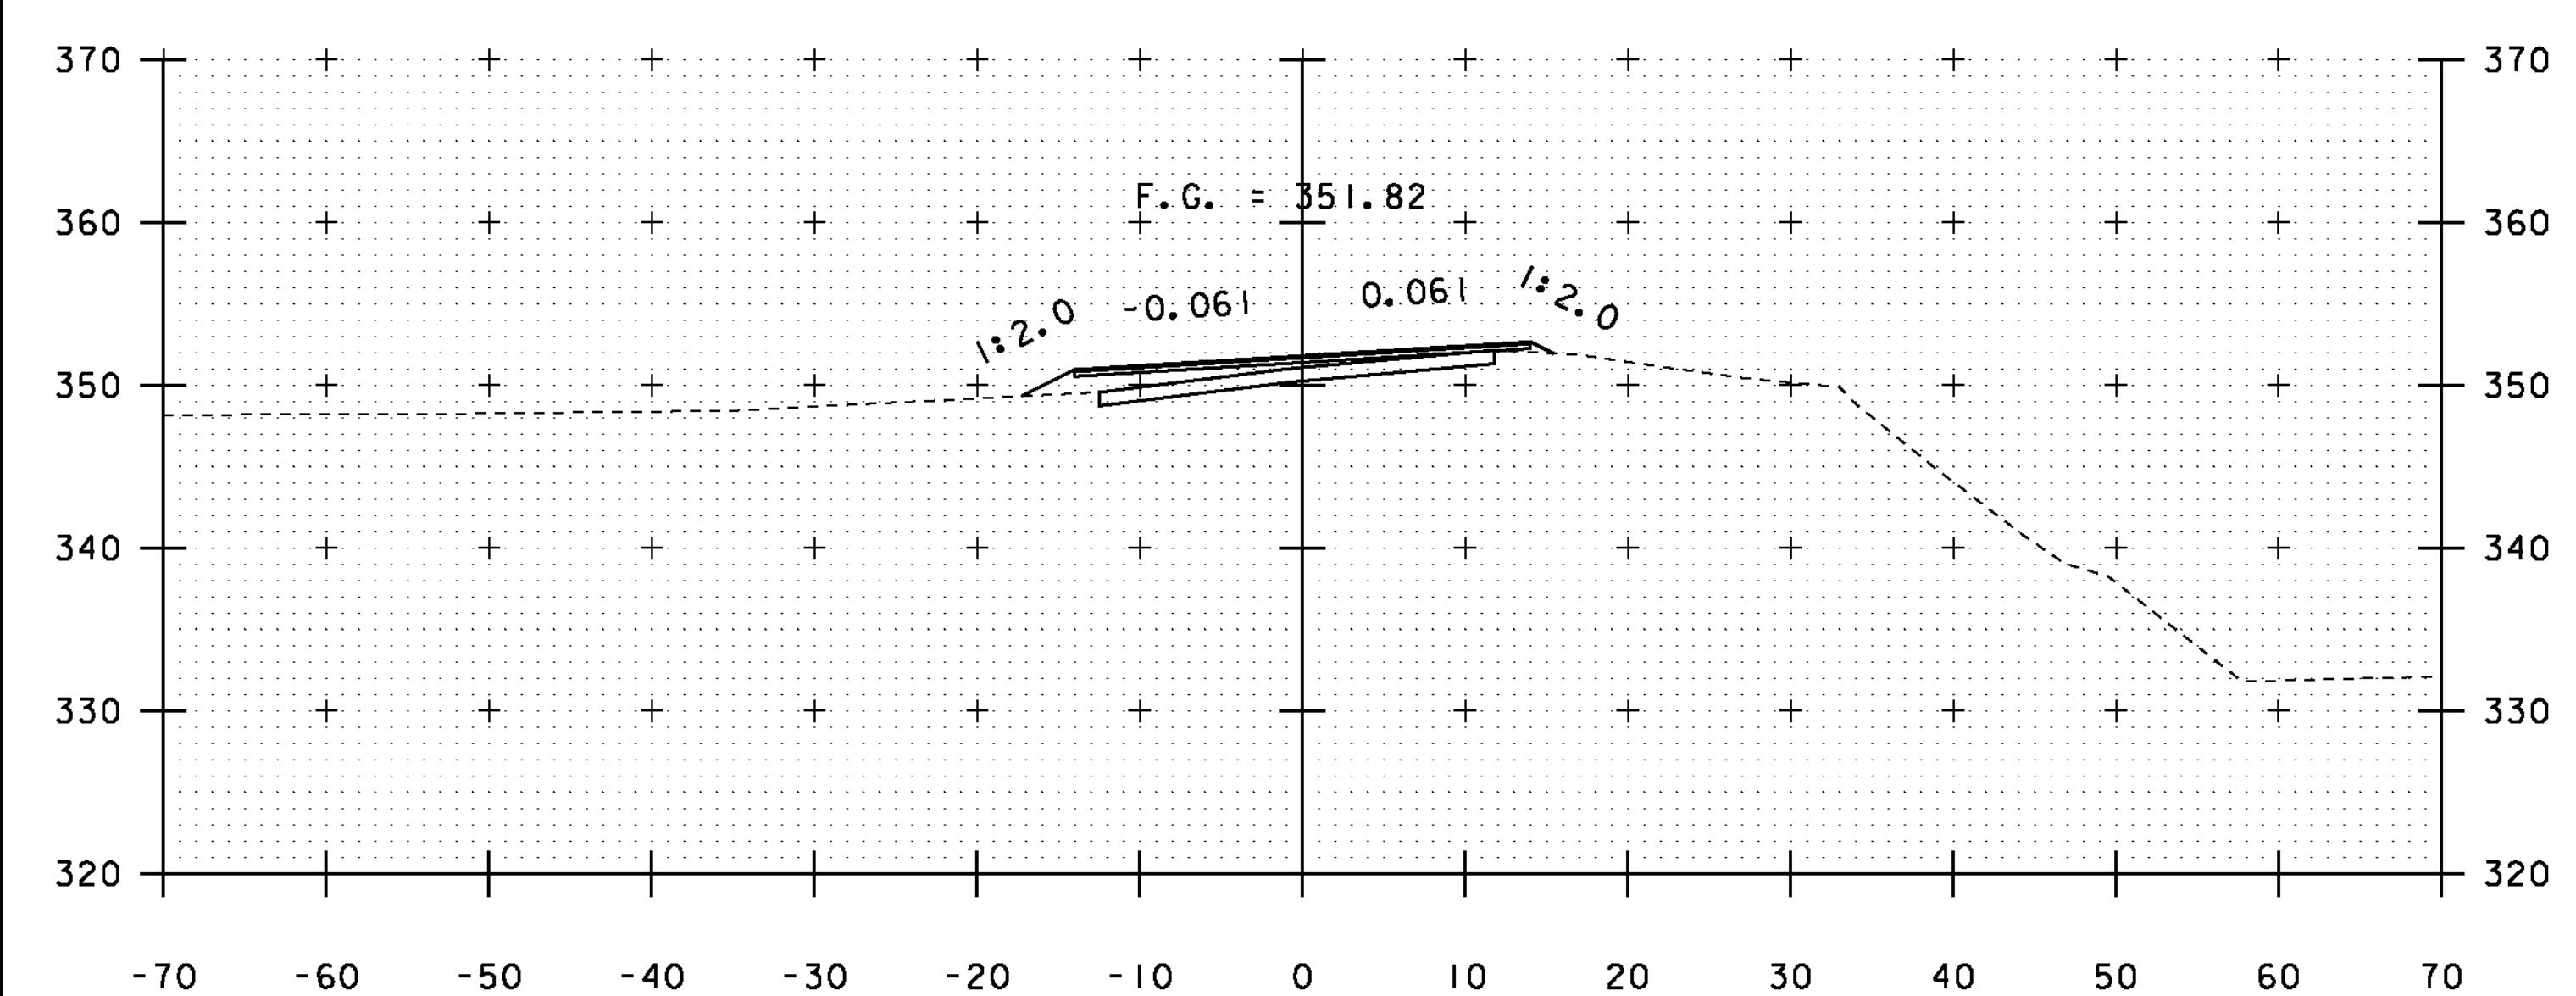

58+00

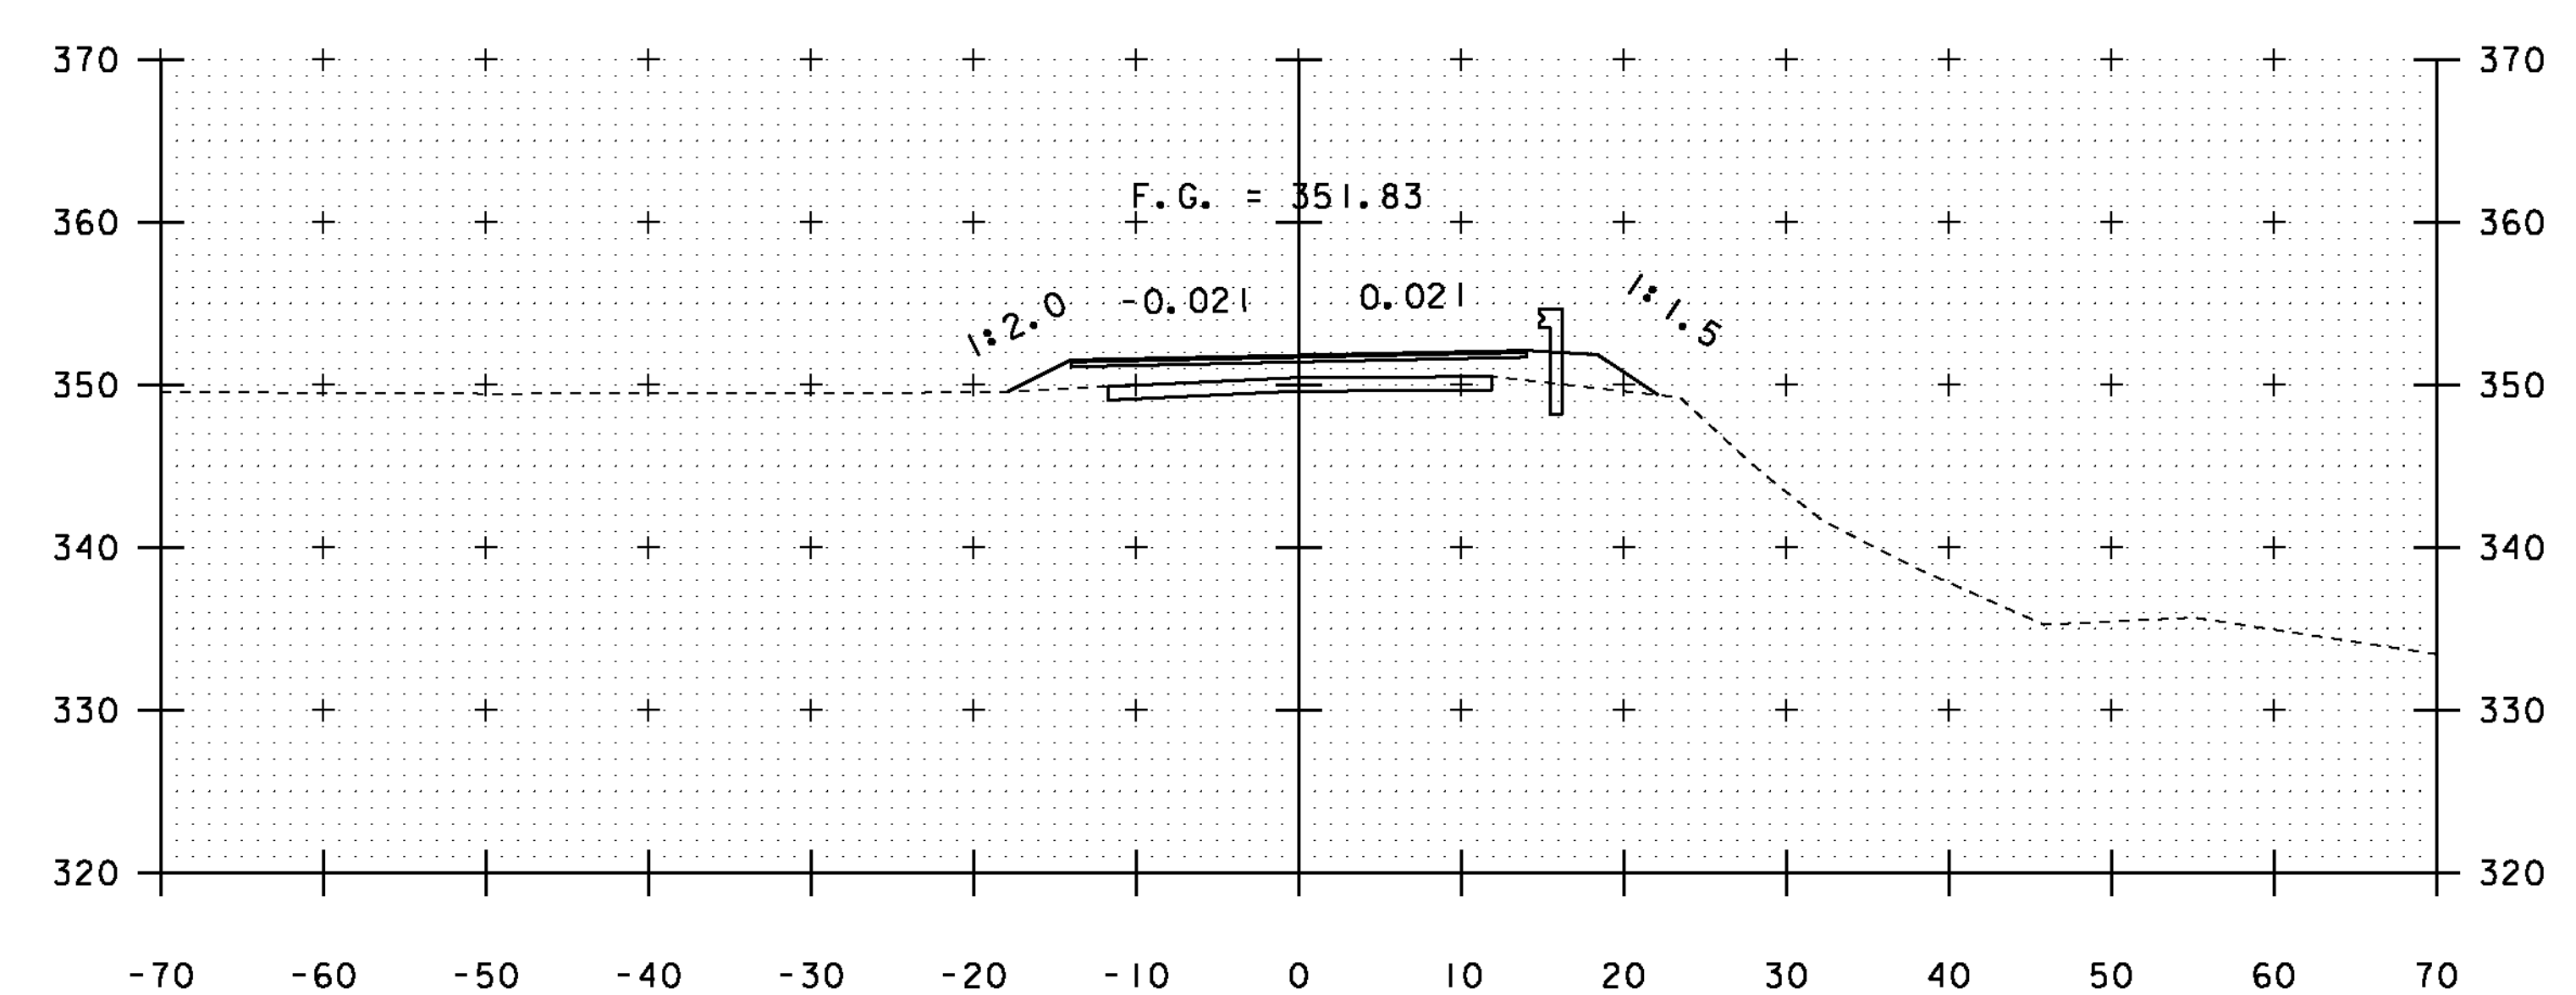

59+00

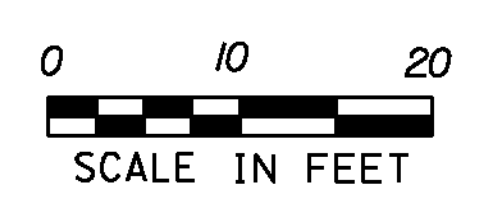

STA. 58+00 TO STA. 59+50

PROJECT NAME: SUDBURY - BRANDON	
PROJECT NUMBER: STP 0158(3)	
FILE NAME: dl0c204_xs.dgn	PLOT DATE: 13-FEB-2013
PROJECT LEADER: K. UPMAL	DRAWN BY: A. KEMPTON
DESIGNED BY: B. MCADAMS	CHECKED BY: N. PAPPAS
VT 73 CROSS SECTIONS 28	SHEET 123 OF 137