




88+00

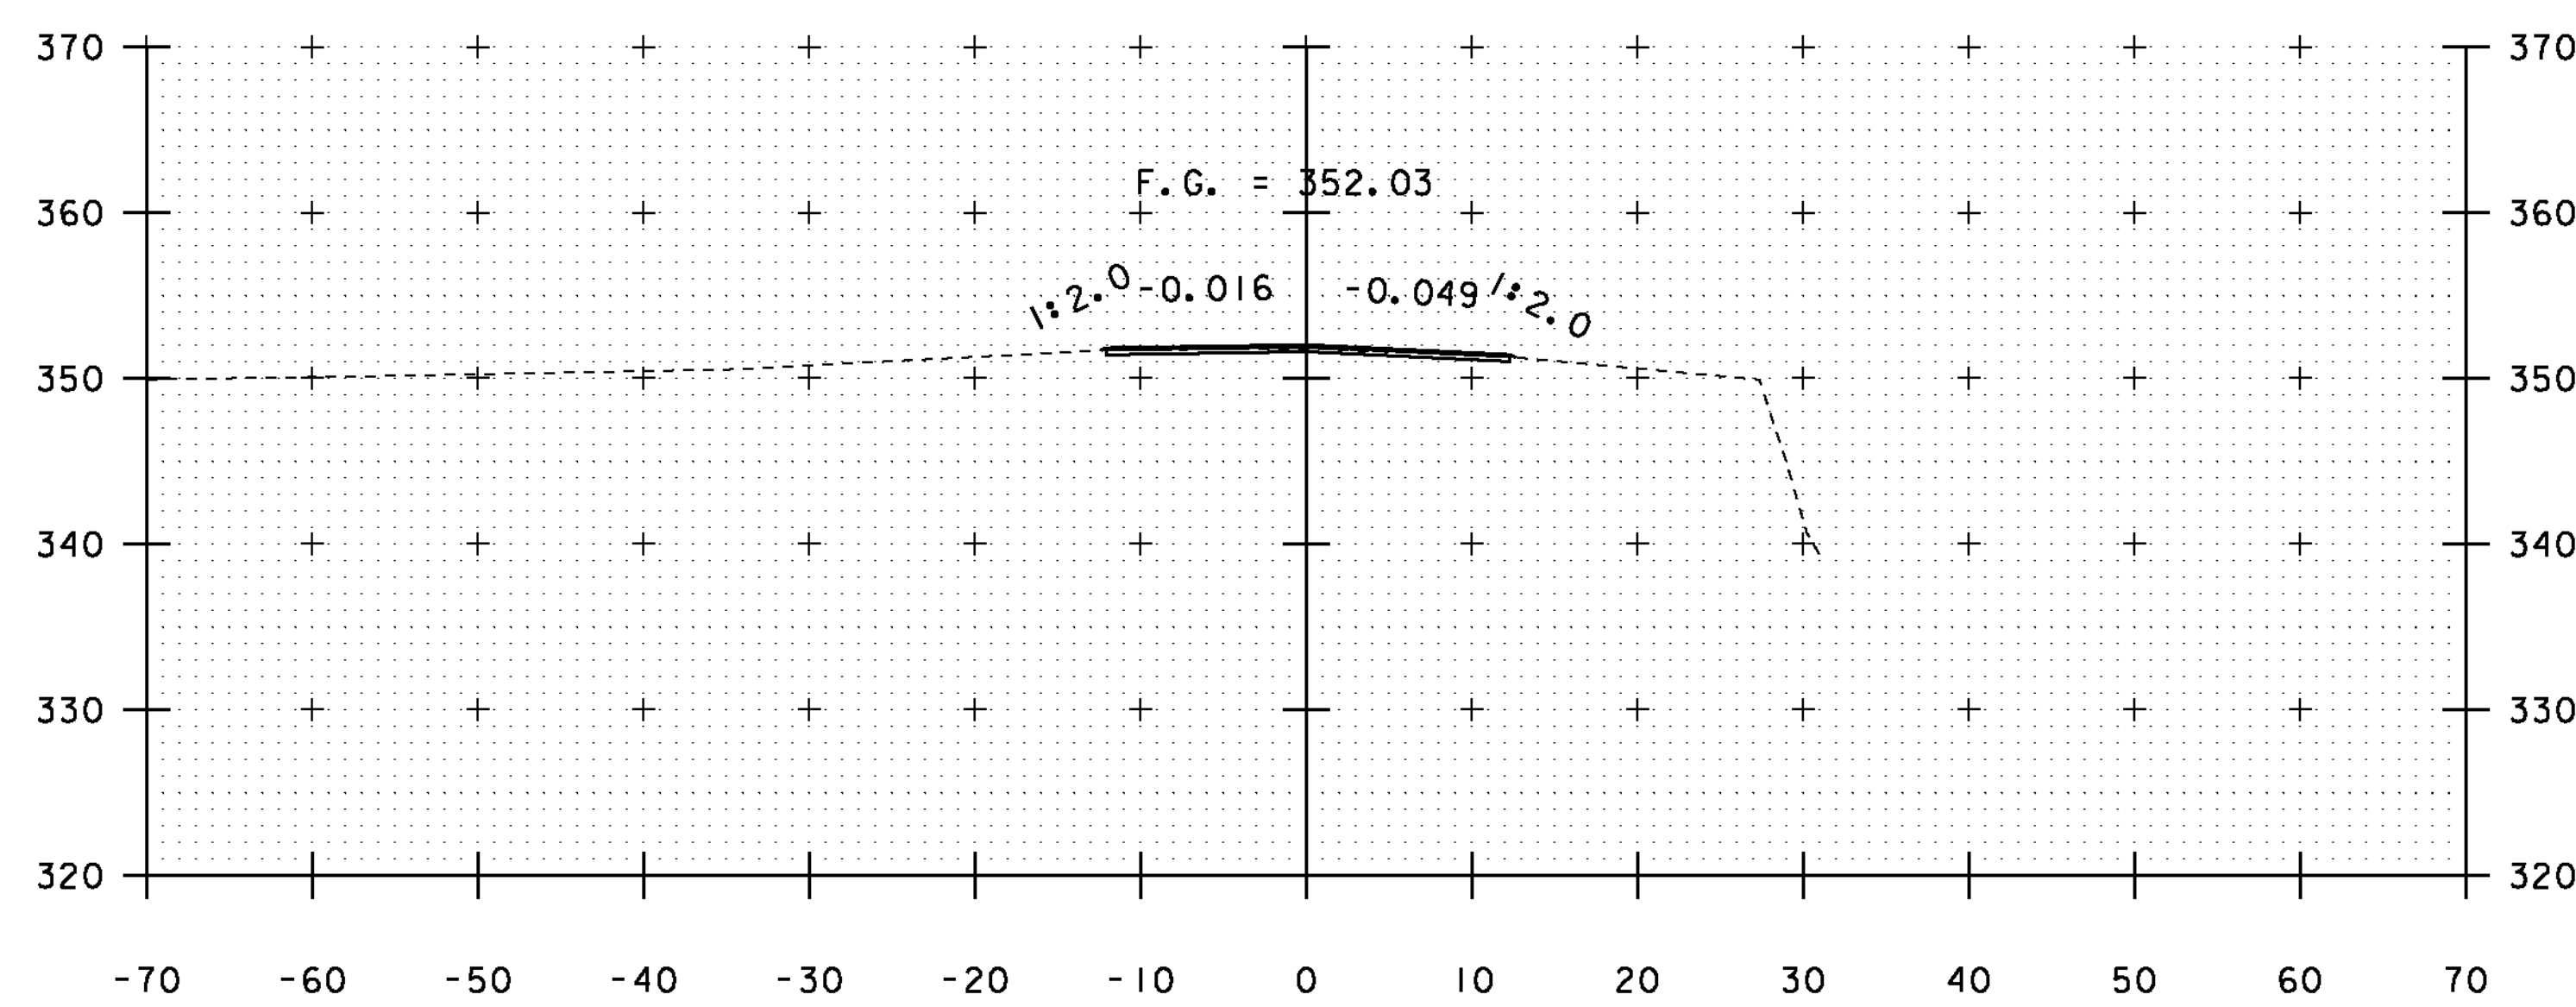


89+00

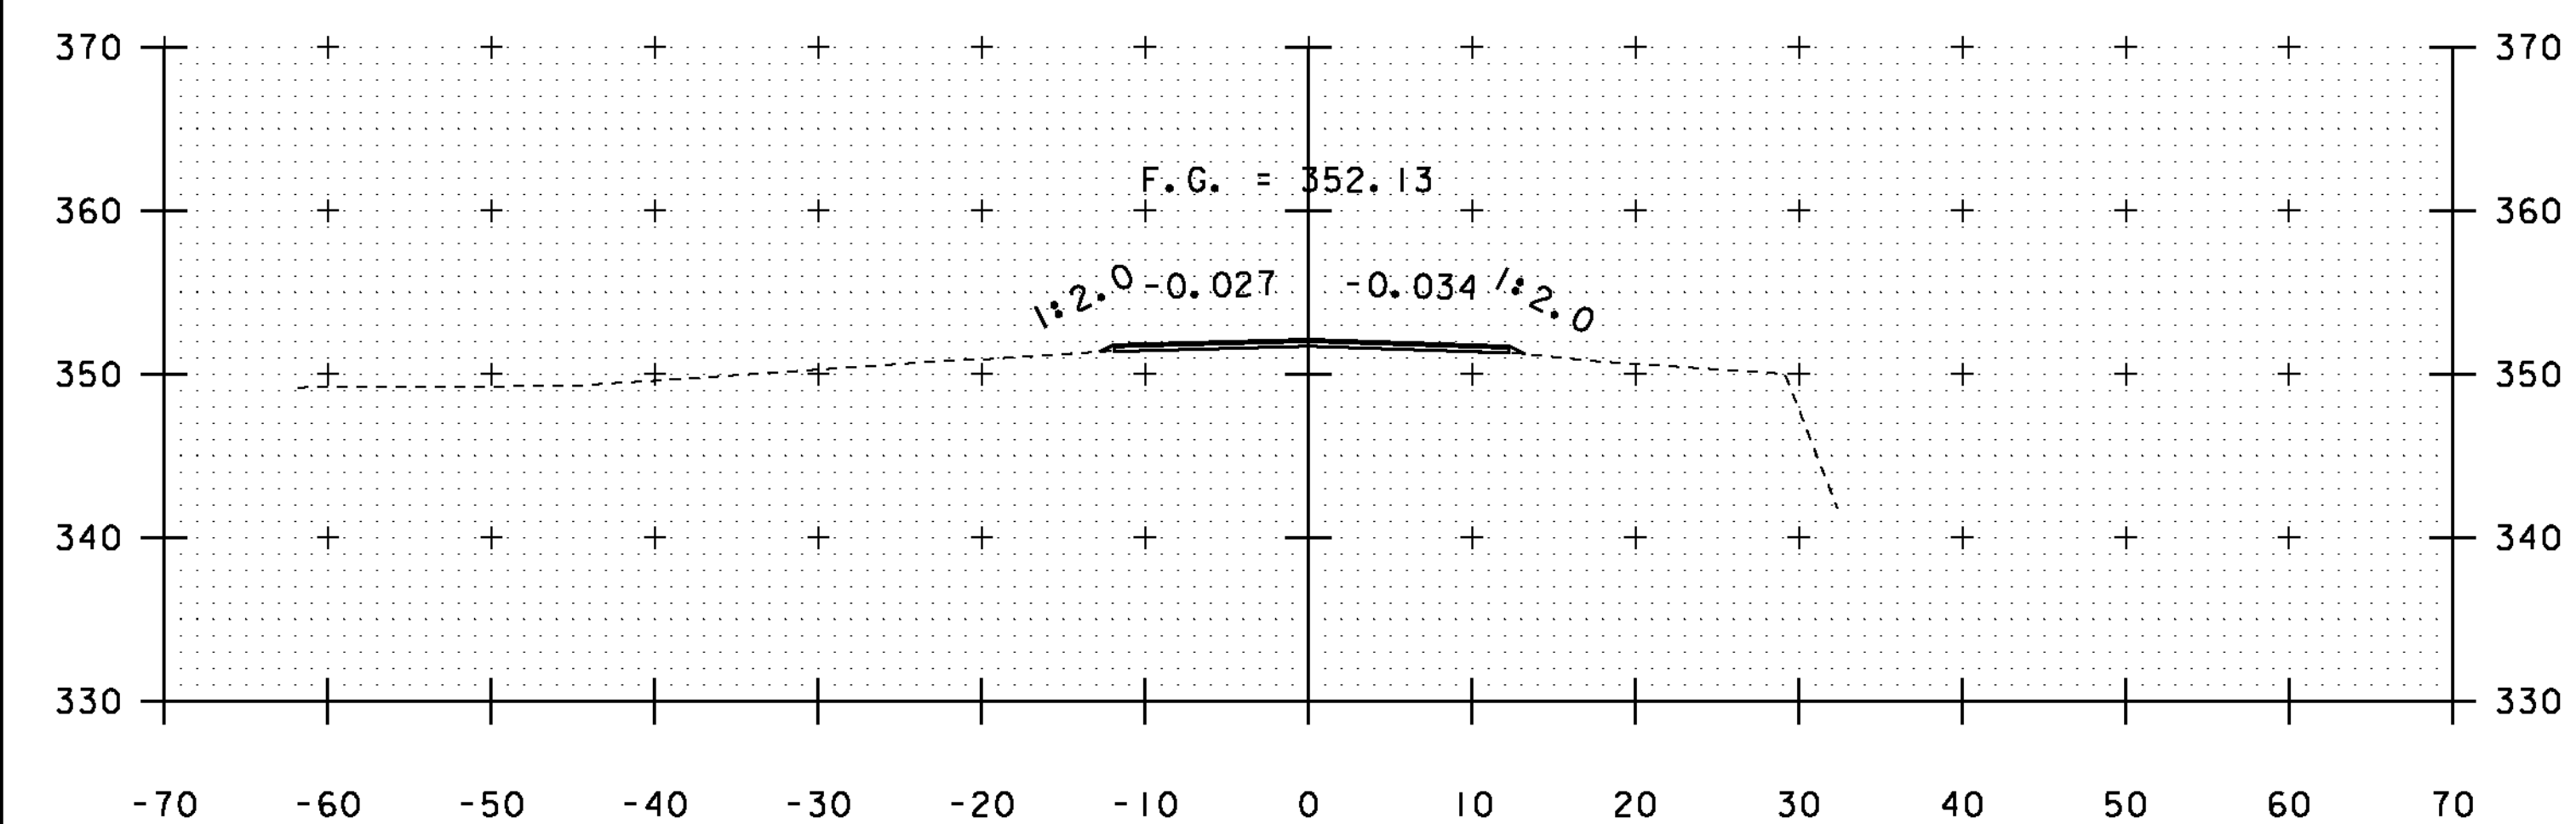

87+50

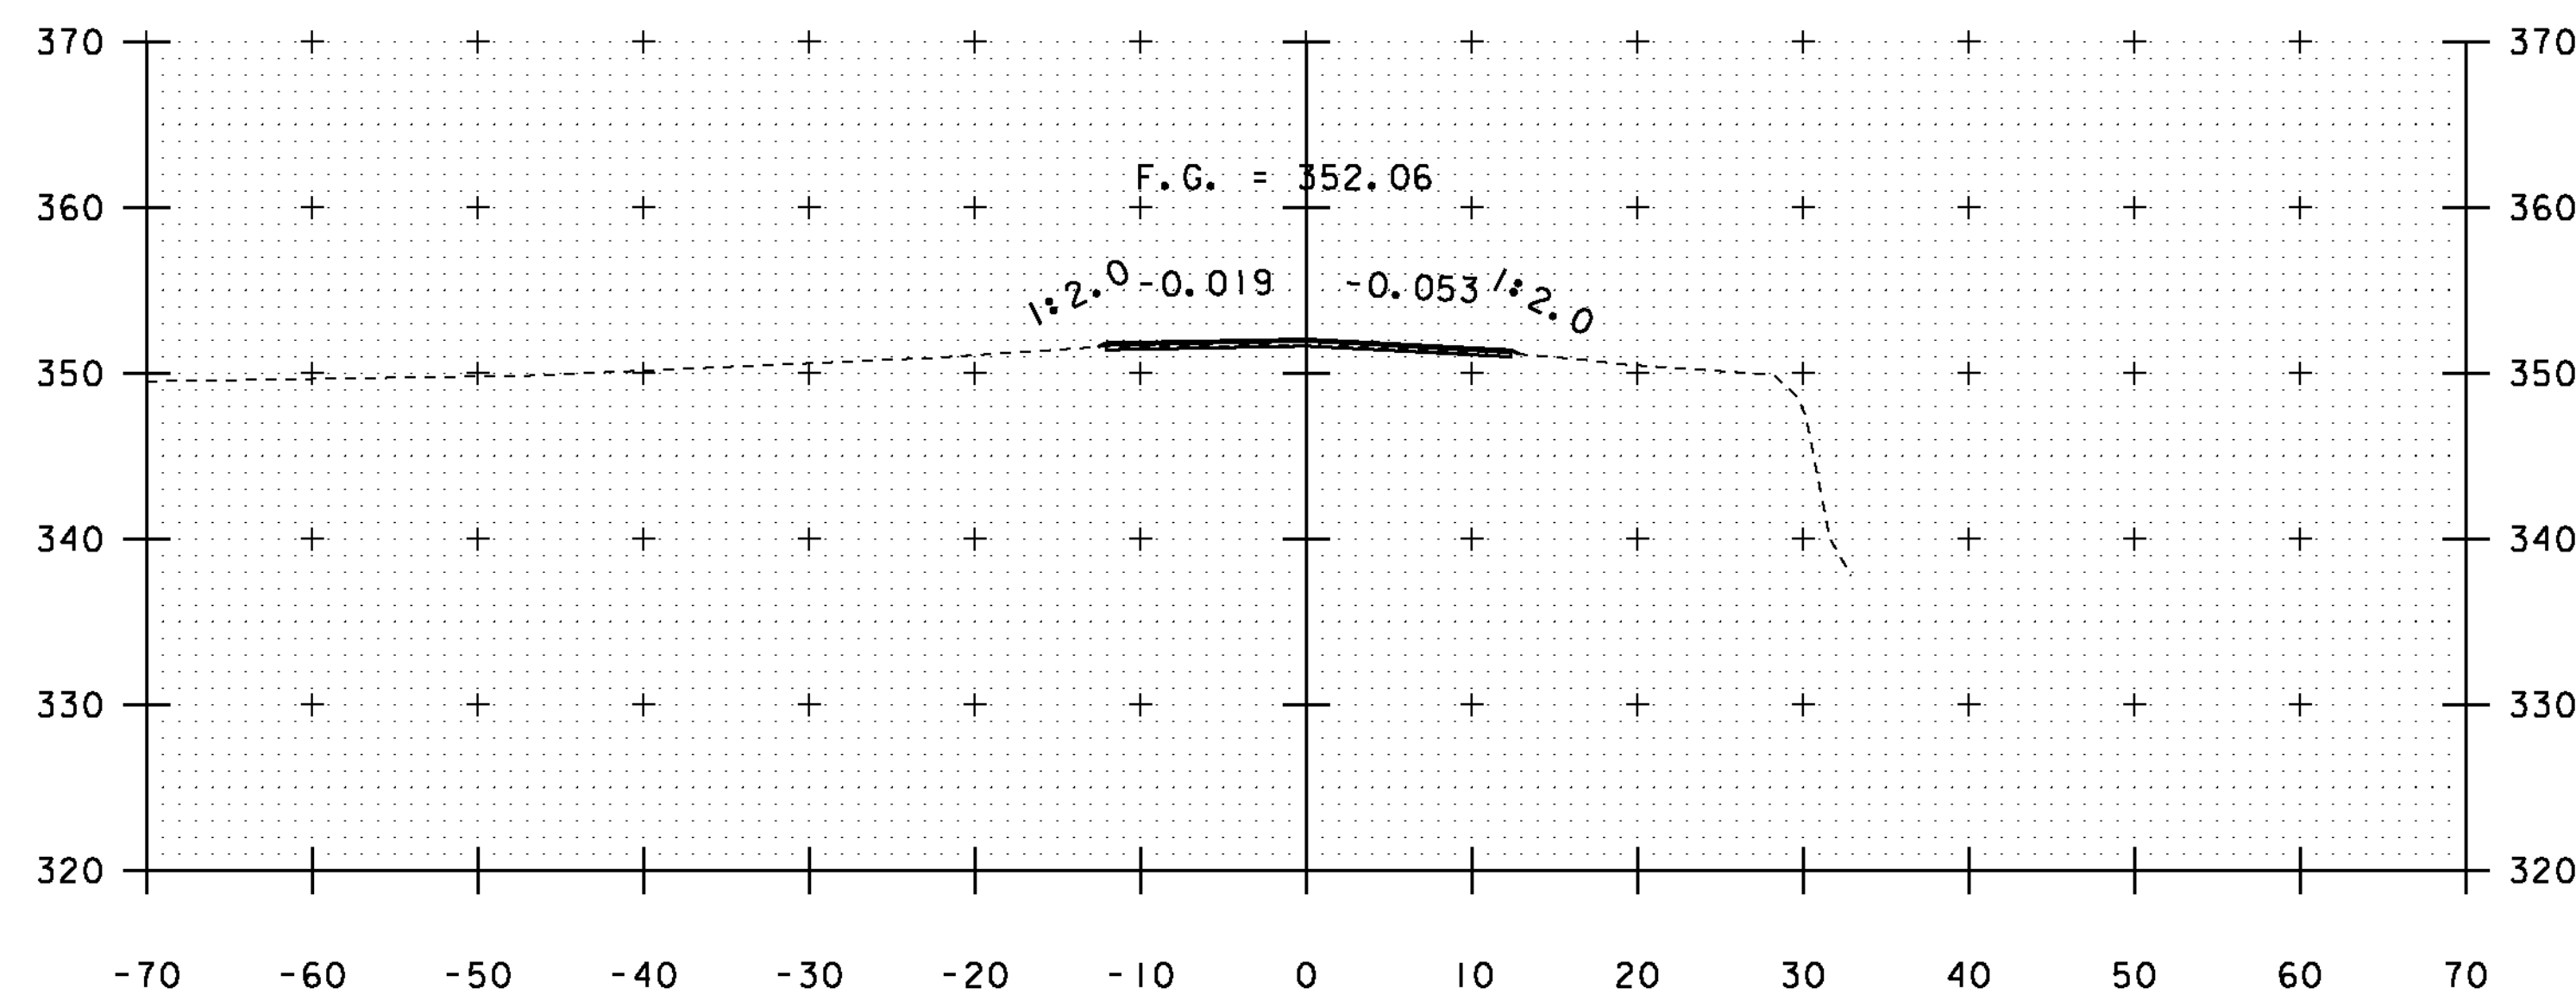

88+50

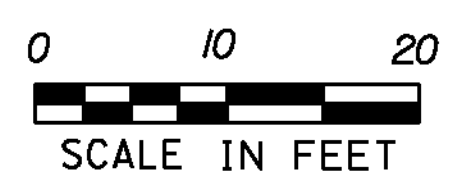

STA. 87+50 TO STA. 89+00

PROJECT NAME: SUDBURY - BRANDON	
PROJECT NUMBER: STP 0158(3)	
FILE NAME: dl0c204_xs.dgn	PLOT DATE: 13-FEB-2013
PROJECT LEADER: K. UPMAL	DRAWN BY: A. KEMPTON
DESIGNED BY: B. MCADAMS	CHECKED BY: N. PAPPAS
VT 73 CROSS SECTIONS 40	SHEET 135 OF 137