

646.402 DURABLE 4 INCH WHITE LINE, THERMOPLASTIC OR
 646.403 DURABLE 4 INCH WHITE LINE, EPOXY PAINT OR
 646.404 DURABLE 4 INCH WHITE LINE, POLYUREA
 (ALL LINES WILL INCLUDE EDGE LINE BREAKS AND
 RADIUS FOR TOWN HIGHWAYS)
 CASTLETON:
 STA 209+25.00 - STA 215+25.00 EDGE LINE LT & RT
 STA 209+25.00 - STA 210+00.00 DOTTED LANE LINE RT
 STA 210+00.00 - STA 211+50.00 SOLID LANE LINE RT

646.602 TEMPORARY 4 INCH YELLOW LINE, PAINT
 (ALL LINES WILL INCLUDE EDGE LINE BREAKS AND
 RADIUS FOR TOWN HIGHWAYS)
 CASTLETON:
 STA 209+25.00 - STA 215+25.00 EDGE LINE LT & RT
 STA 209+25.00 - STA 210+00.00 DOTTED LANE LINE RT
 STA 210+00.00 - STA 211+50.00 SOLID LANE LINE RT

646.612 TEMPORARY 4 INCH YELLOW LINE, THERMOPLASTIC OR
 646.613 DURABLE 4 INCH YELLOW LINE, EPOXY PAINT OR
 646.614 DURABLE 4 INCH YELLOW LINE, POLYUREA
 (ALL LINES WILL INCLUDE C/L BREAKS FOR
 TOWN HIGHWAYS) S=SOLID, D=DASHED
 CASTLETON:
 STA 210+00.00 - STA 211+50.00 LT & RT
 STA 209+25.00 - STA 210+00.00 DOUBLE SOLID MEDIAN LT
 STA 212+00.00 - STA 215+25.00 DOUBLE SOLID MEDIAN LT & RT

646.622 TEMPORARY 4 INCH YELLOW LINE, THERMOPLASTIC OR
 646.623 DURABLE 4 INCH YELLOW LINE, EPOXY PAINT OR
 646.624 DURABLE 4 INCH YELLOW LINE, POLYUREA
 CASTLETON:
 STA 209+25.00 - STA 210+00.00 MEDIAN HATCHING
 STA 212+00.00 - STA 215+25.00 MEDIAN HATCHING

675.50 REMOVING SIGNS
 AS SHOWN - 17
 675.60 ERECTING SALVAGED SIGNS
 AS SHOWN - 1

CASTLETON STATE HIGHWAY:
 STA 0+30.00 - STA 2+00.00 EDGE LINE LT & RT
 STA 0+30.00 - STA 1+25.00 SOLID LANE LINE LT
 STA 1+25.00 - STA 2+00.00 DOTTED LANE LINE LT

CASTLETON STATE HIGHWAY:
 STA 0+30.00 - STA 2+00.00 EDGE LINE LT & RT
 STA 0+30.00 - STA 1+25.00 SOLID LANE LINE LT
 STA 1+25.00 - STA 2+00.00 DOTTED LANE LINE LT

CASTLETON STATE HIGHWAY:
 STA 0+30.00 - STA 1+10.00 MEDIAN EDGE LINE LT & RT
 STA 1+10.00 - STA 2+00.00 DOUBLE SOLID MEDIAN LT & RT

CASTLETON STATE HIGHWAY:
 STA 1+10.00 - STA 2+00.00 MEDIAN HATCHING

646.482 DURABLE 24 INCH STOP BAR, THERMOPLASTIC OR
 646.483 DURABLE 24 INCH STOP BAR, EPOXY PAINT OR
 646.484 DURABLE 24 INCH STOP BAR, POLYUREA
 CASTLETON STATE HIGHWAY:
 STA 0+30.00 LT

646.412 DURABLE 4 INCH YELLOW LINE, THERMOPLASTIC OR
 646.413 DURABLE 4 INCH YELLOW LINE, EPOXY PAINT OR
 646.414 DURABLE 4 INCH YELLOW LINE, POLYUREA
 (ALL LINES WILL INCLUDE C/L BREAKS FOR
 TOWN HIGHWAYS) S=SOLID, D=DASHED
 CASTLETON:
 STA 210+00.00 - STA 211+50.00 LT & RT
 STA 209+25.00 - STA 210+00.00 DOUBLE SOLID MEDIAN LT
 STA 212+00.00 - STA 215+25.00 DOUBLE SOLID MEDIAN LT & RT

CASTLETON STATE HIGHWAY:
 STA 0+30.00 - STA 1+10.00 MEDIAN EDGE LINE LT & RT
 STA 1+10.00 - STA 2+00.00 DOUBLE SOLID MEDIAN LT & RT

646.81 PAINTED CURB
 CASTLETON STATE HIGHWAY:
 STA 0+27.00 - STA 1+00.00 LT/RT (146.0 LF)

646.492 DURABLE LETTER OR SYMBOL, THERMOPLASTIC OR
 646.493 DURABLE LETTER OR SYMBOL, EPOXY PAINT
 CASTLETON:
 STA 210+04.25 C/L ARROW (1EA)
 STA 210+75.00 C/L "O,N,L,Y" (4 EA)
 STA 211+45.75 C/L ARROW (1EA)
 STA 212+46.50 LT ARROW (2 EA)
 STA 213+43.50 LT ARROW (2 EA)

646.692 TEMPORARY LETTER OR SYMBOL, PAINT
 CASTLETON:
 STA 210+04.25 C/L ARROW (2 EA)
 STA 211+45.75 C/L ARROW (2 EA)
 STA 212+46.50 LT ARROW (4 EA)
 STA 213+43.50 LT ARROW (4 EA)


CASTLETON STATE HIGHWAY:
 STA 0+39.17 LT "S,T,O,P" (8 EA)
 STA 0+39.17 LT "S,T,O,P" (8 EA)
 STA 0+80.00 LT ARROW (1EA)
 STA 0+80.00 LT ARROW (1EA)
 STA 1+20.75 LT ARROW (1EA)
 STA 1+20.75 LT ARROW (1EA)

CASTLETON STATE HIGHWAY:
 STA 0+39.17 LT "S,T,O,P" (4 EA)
 STA 0+39.17 LT "S,T,O,P" (4 EA)
 STA 0+80.00 LT ARROW (1EA)
 STA 0+80.00 LT ARROW (1EA)
 STA 1+20.75 LT ARROW (1EA)
 STA 1+20.75 LT ARROW (1EA)

CASTLETON STATE HIGHWAY:
 STA 1+00.00 LT "O,N,L,Y" (4 EA)
 STA 1+00.00 LT "O,N,L,Y" (4 EA)

CASTLETON STATE HIGHWAY:
 STA 0+39.17 LT "S,T,O,P" (4 EA)
 STA 0+39.17 LT "S,T,O,P" (4 EA)
 STA 0+80.00 LT ARROW (1EA)
 STA 0+80.00 LT ARROW (1EA)
 STA 1+20.75 LT ARROW (1EA)
 STA 1+20.75 LT ARROW (1EA)

CASTLETON STATE HIGHWAY:
 STA 0+39.17 LT "S,T,O,P" (8 EA)
 STA 0+39.17 LT "S,T,O,P" (8 EA)
 STA 0+80.00 LT ARROW (2 EA)
 STA 0+80.00 LT ARROW (2 EA)
 STA 1+20.75 LT ARROW (2 EA)
 STA 1+20.75 LT ARROW (2 EA)

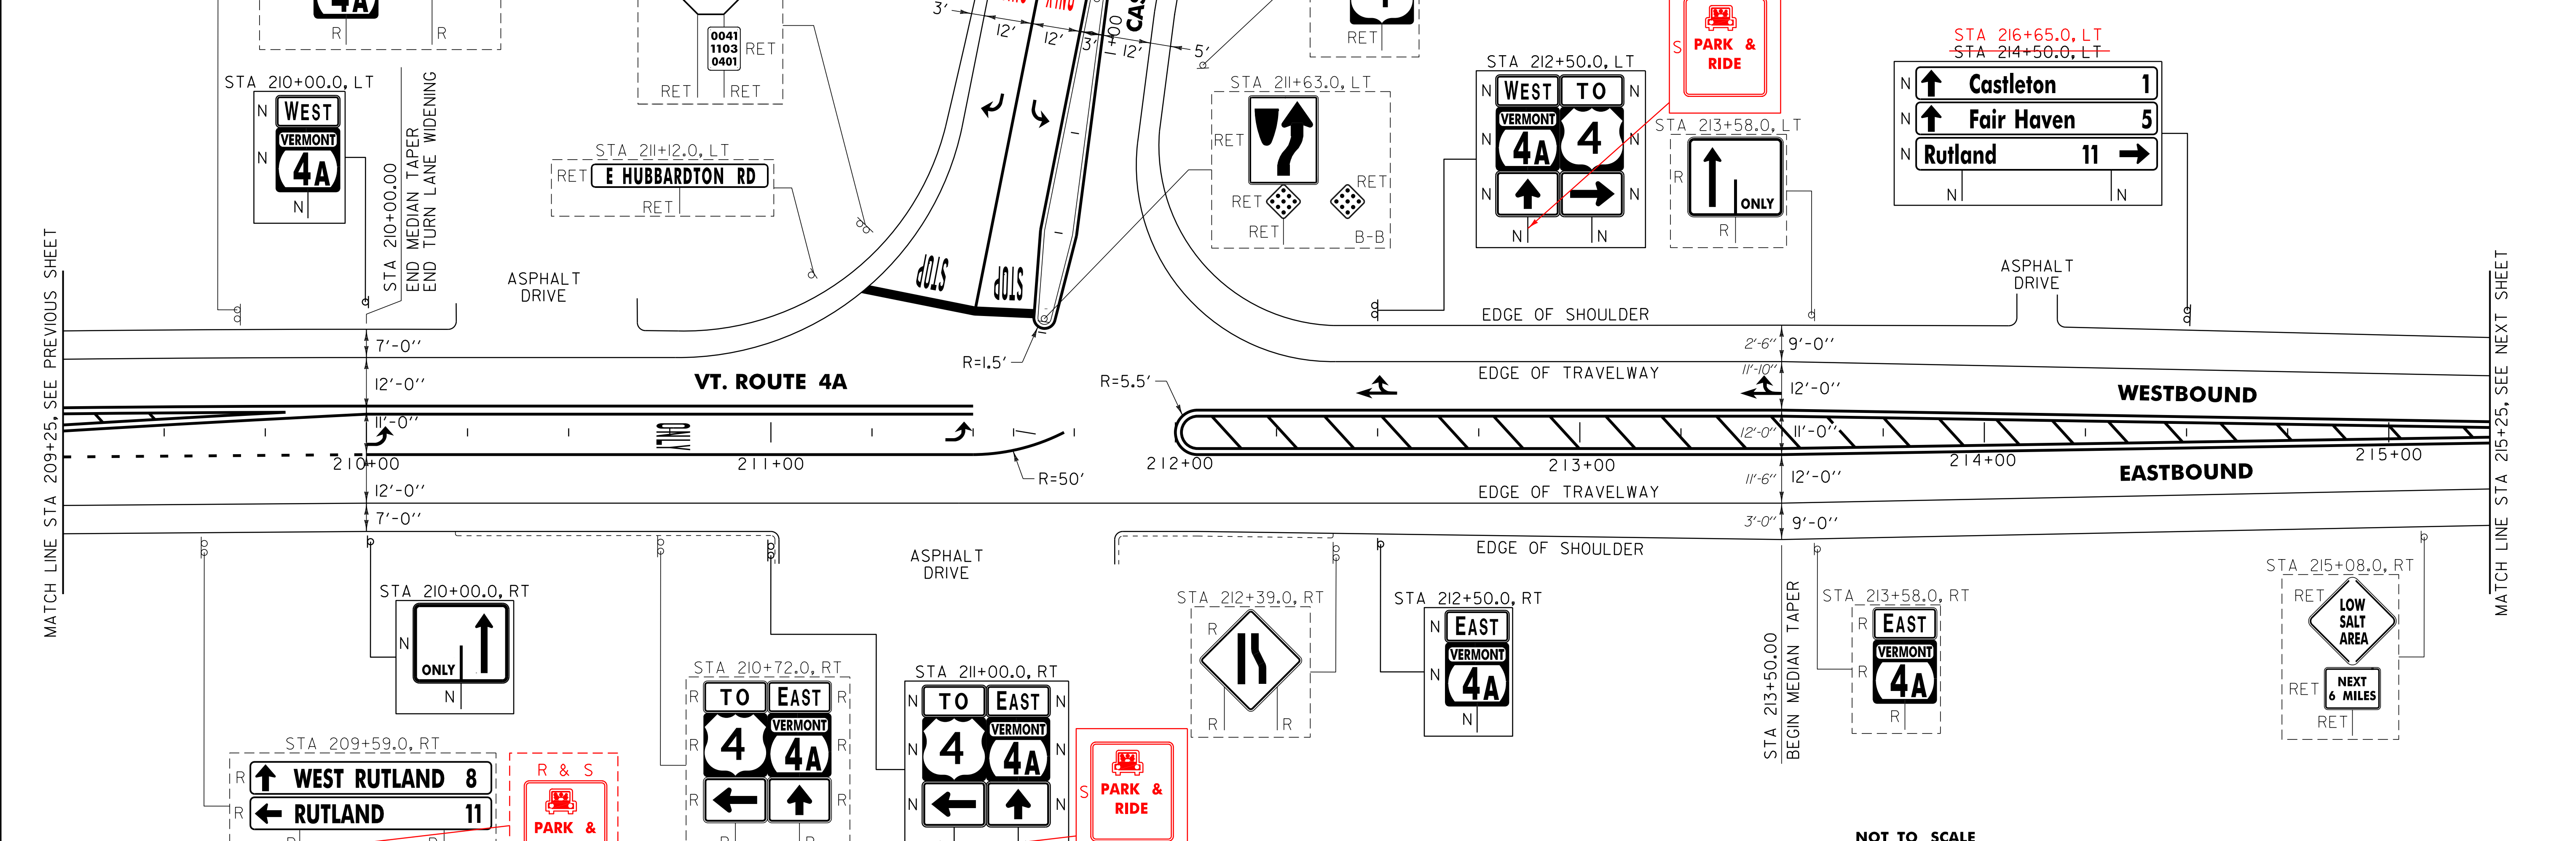

MATCH LINE STA 209+25, SEE PREVIOUS SHEET

MATCH LINE STA 215+25, SEE NEXT SHEET

SIGN LEGEND
 R = REMOVE
 S = SALVAGE
 N = NEW
 RET = RETAIN
 B-B = BACK TO BACK
 EXISTING BY: _____
 NEW = _____

PROJECT LAYOUT SHEET #2	PROJECT NAME: CASTLETON - WEST RUTLAND	PLOT DATE: 04-JUN-2013 09:14
	PROJECT NUMBER: STP 2705(1)	DRAWN BY: W.G.P.
	FILE NAME: p07cl68.dgn	CHECKED BY: D.E.G.
	DESIGNED BY: M.J.M.	SHEET 23 OF 152