



646.402 DURABLE 4 INCH WHITE LINE, THERMOPLASTIC OR  
 646.403 DURABLE 4 INCH WHITE LINE, EPOXY PAINT OR  
 646.404 DURABLE 4 INCH WHITE LINE, POLYUREA  
 (ALL LINES WILL INCLUDE EDGE LINE BREAKS AND  
 RADIUS FOR TOWN HIGHWAYS)  
 CASTLETON:  
 STA 215+25.00 - STA 226+50.00 EDGE LINE LT & RT

646.602 TEMPORARY 4 INCH WHITE LINE, PAINT  
 (ALL LINES WILL INCLUDE EDGE LINE BREAKS AND  
 RADIUS FOR TOWN HIGHWAYS)  
 CASTLETON:  
 STA 215+25.00 - STA 226+50.00 EDGE LINE LT & RT

646.412 DURABLE 4 INCH YELLOW LINE, THERMOPLASTIC OR  
 646.413 DURABLE 4 INCH YELLOW LINE, EPOXY PAINT OR  
 646.414 DURABLE 4 INCH YELLOW LINE, POLYUREA  
 (ALL LINES WILL INCLUDE C/L BREAKS FOR  
 TOWN HIGHWAYS) S=SOLID, D=DASHED  
 CASTLETON:  
 STA 216+25.00 - STA 226+50.00 LT @ RT  
 STA 215+25.00 - STA 216+25.00 DOUBLE SOLID MEDIAN LT & RT

646.612 TEMPORARY 4 INCH YELLOW LINE, PAINT  
 (ALL LINES WILL INCLUDE C/L BREAKS FOR  
 TOWN HIGHWAYS) S=SOLID, D=DASHED  
 CASTLETON:  
 STA 216+25.00 - STA 226+50.00 LT @ RT  
 STA 215+25.00 - STA 216+25.00 DOUBLE SOLID MEDIAN LT & RT

675.50 REMOVING SIGNS  
 AS SHOWN - 17  
 675.60 ERECTING SALVAGED SIGNS  
 AS SHOWN - 1  
 TH-8  
 CRAMPTON RD  
 MM 4.182 = STA 220+80.96  
 (ASPHALT)

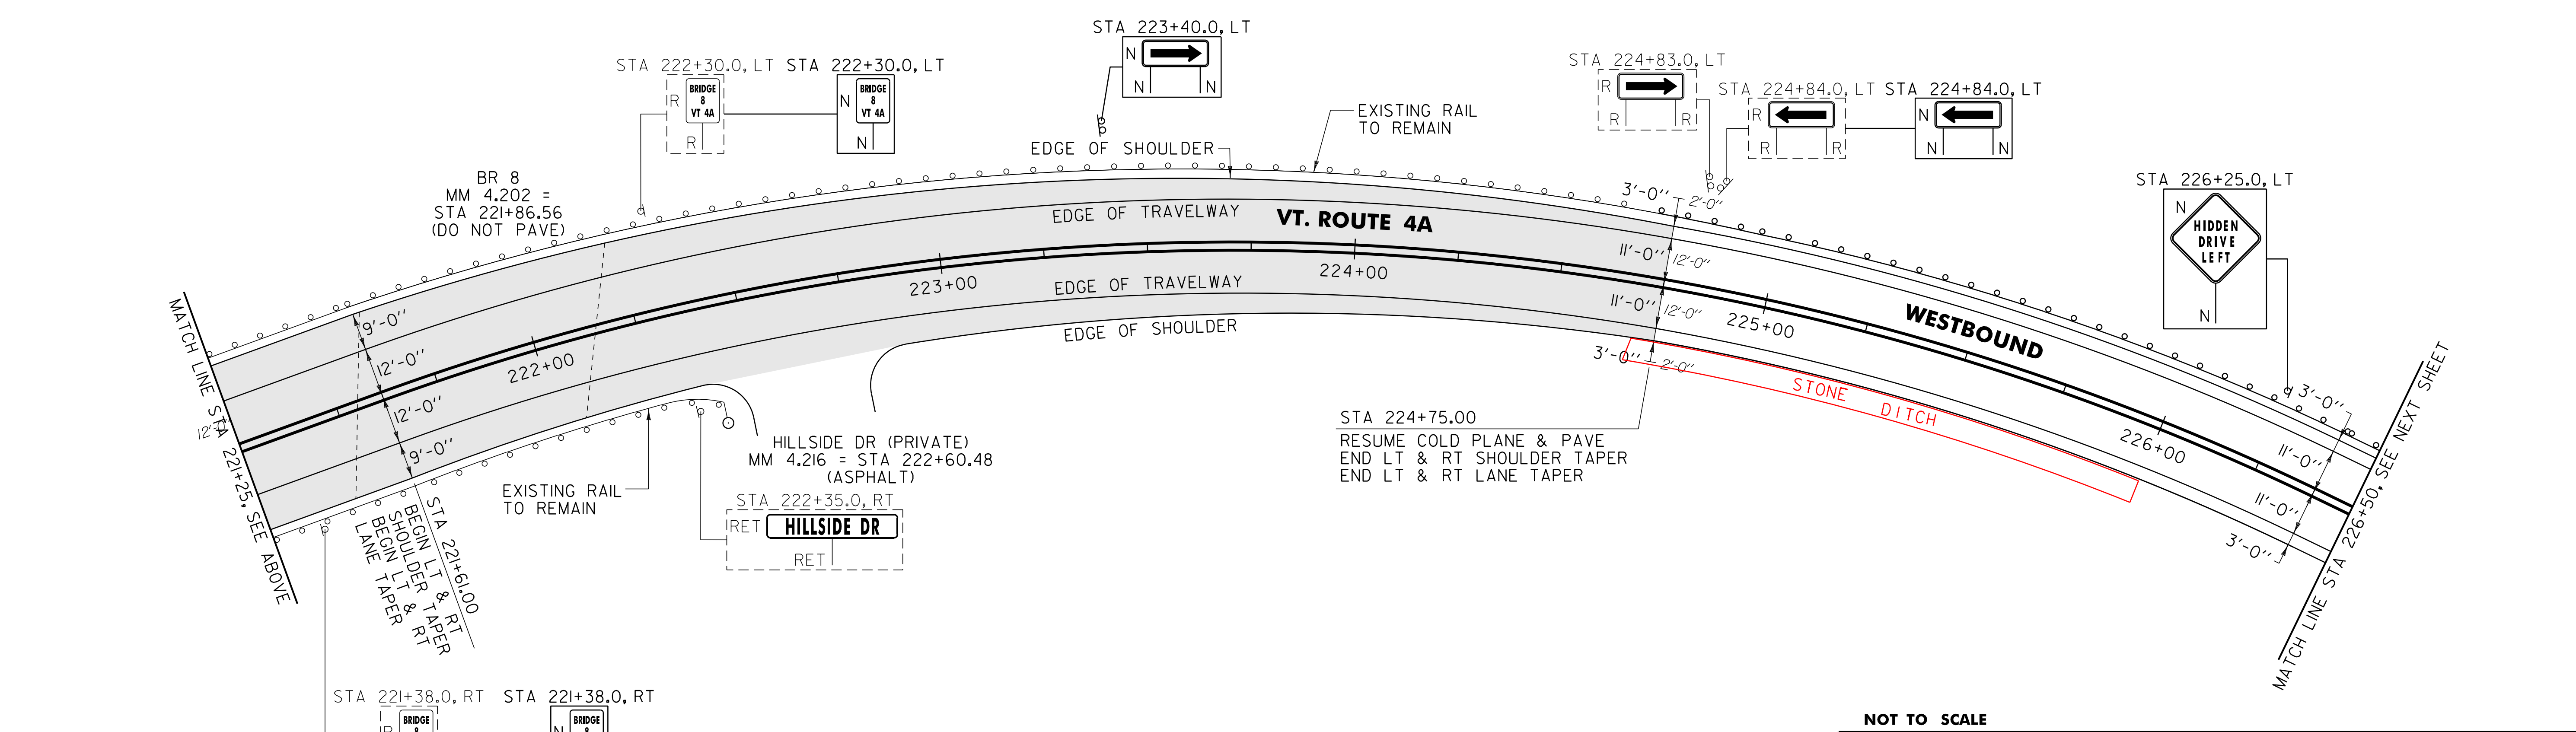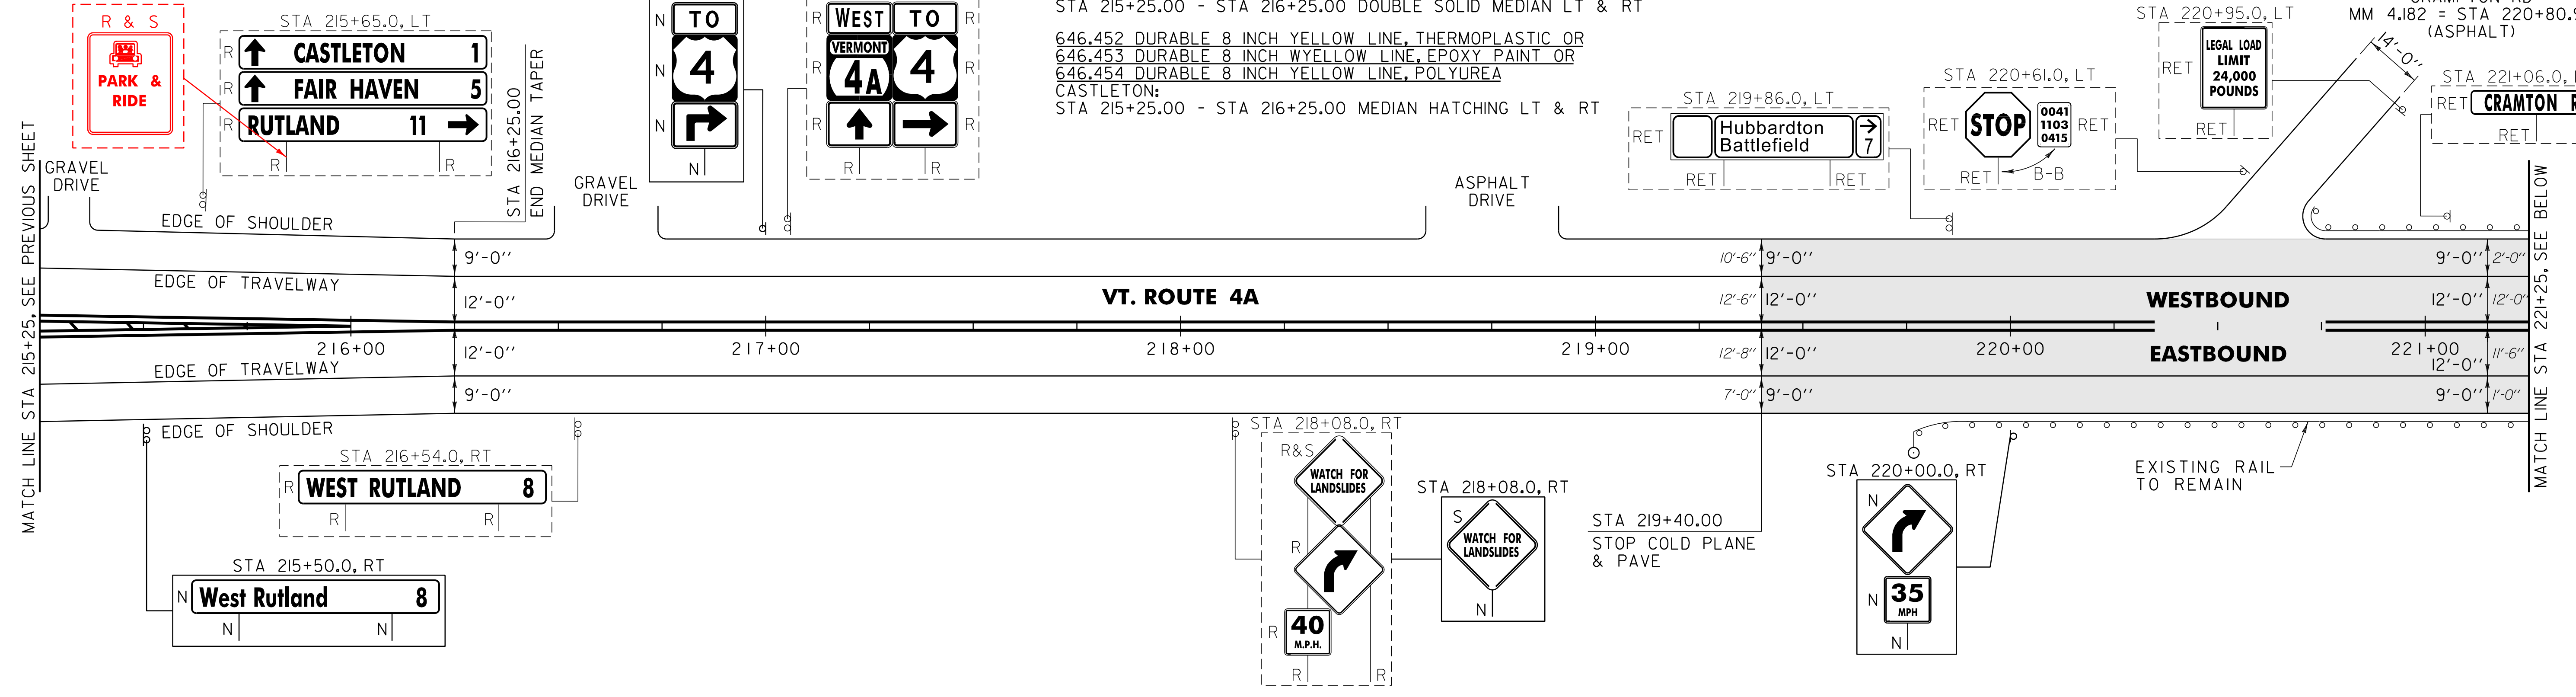

NO PAVING WORK  
 TO BE PERFORMED  
 IN THIS AREA

621.205 STEEL BEAM GUARDRAIL, GALVANIZED W/8 FEET POSTS  
 CASTLETON:  
 STA 224+72.0 - STA 226+50.0 LT (178.0 LF)  
 621.80 REMOVAL AND DISPOSAL OF GUARDRAIL  
 CASTLETON:  
 STA 224+72.0 - STA 226+50.0 LT (178.0 LF)

**SIGN LEGEND**  
 R = REMOVE  
 S = SALVAGE  
 N = NEW  
 RET = RETAIN  
 B-B = BACK TO BACK  
 EXISTING = - - - - -  
 NEW = \_\_\_\_\_

**NOT TO SCALE**

<b>PROJECT LAYOUT SHEET #3</b>	PROJECT NAME: CASTLETON - WEST RUTLAND	PLOT DATE: 04-JUN-2013 09:14
	PROJECT NUMBER: STP 2705(1)	DRAWN BY: W.G.P.
	FILE NAME: p07cl68.dgn	CHECKED BY: D.E.G.
	DESIGNED BY: M.J.M.	SHEET 24 OF 152