


646.402 DURABLE 4 INCH WHITE LINE, THERMOPLASTIC OR
 646.403 DURABLE 4 INCH WHITE LINE, EPOXY PAINT OR
 646.404 DURABLE 4 INCH WHITE LINE, POLYUREA
 (ALL LINES WILL INCLUDE EDGE LINE BREAKS AND RADIUS FOR TOWN HIGHWAYS)
 CASTLETON:
 STA 250+50.00 - STA 262+50.00 EDGE LINE LT & RT
 646.412 DURABLE 4 INCH YELLOW LINE, THERMOPLASTIC OR
 646.413 DURABLE 4 INCH YELLOW LINE, EPOXY PAINT OR
 646.414 DURABLE 4 INCH YELLOW LINE, POLYUREA
 (ALL LINES WILL INCLUDE C/L BREAKS FOR TOWN HIGHWAYS) S=SOLID, D=DASHED
 CASTLETON:
 STA 250+50.00 - STA 253+44.00 LT @ RT
 STA 253+44.00 - STA 262+50.00 D - S

646.602 TEMPORARY 4 INCH WHITE LINE, PAINT
 (ALL LINES WILL INCLUDE EDGE LINE BREAKS AND RADIUS FOR TOWN HIGHWAYS)
 CASTLETON:
 STA 250+50.00 - STA 262+50.00 EDGE LINE LT & RT
 646.612 TEMPORARY 4 INCH YELLOW LINE, PAINT
 (ALL LINES WILL INCLUDE C/L BREAKS FOR TOWN HIGHWAYS) S=SOLID, D=DASHED
 CASTLETON:
 STA 250+50.00 - STA 253+44.00 LT @ RT
 STA 253+44.00 - STA 262+50.00 D - S


MATCH LINE STA 250+50.00, SEE PREVIOUS SHEET

MATCH LINE STA 256+50.00, SEE BELOW

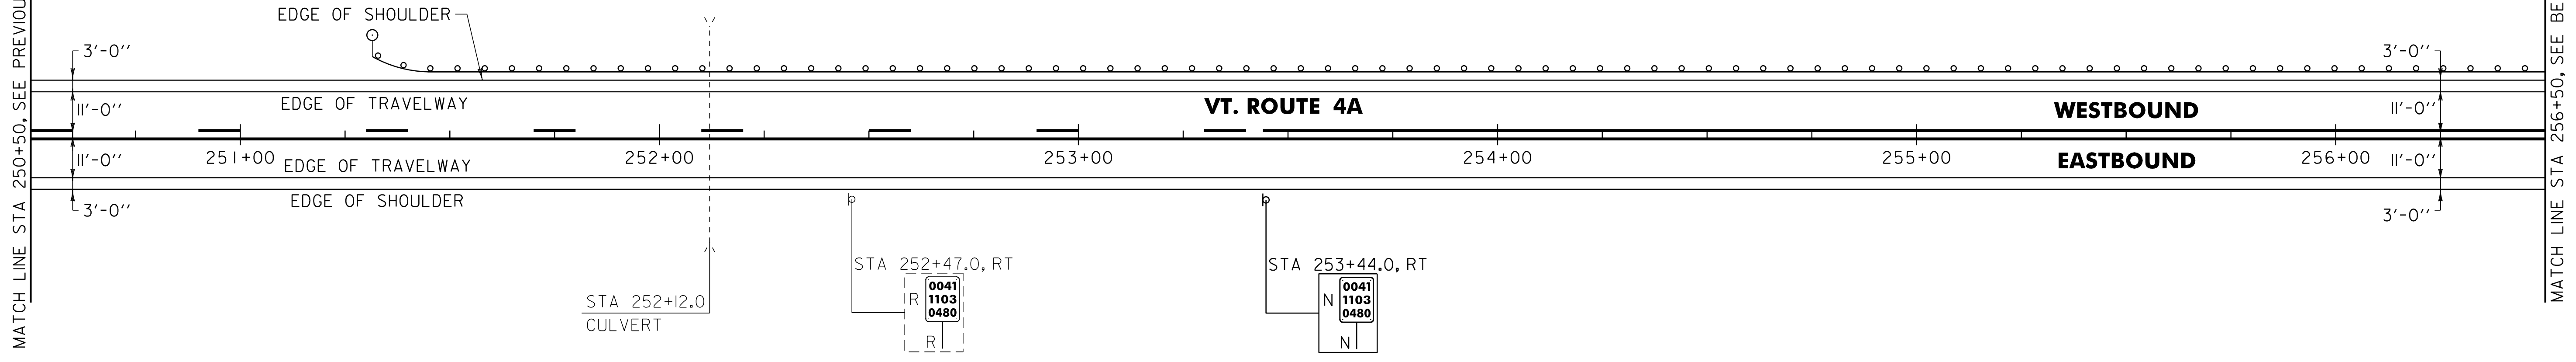

MATCH LINE STA 256+50.00, SEE ABOVE

MATCH LINE STA 262+50.00, SEE NEXT SHEET

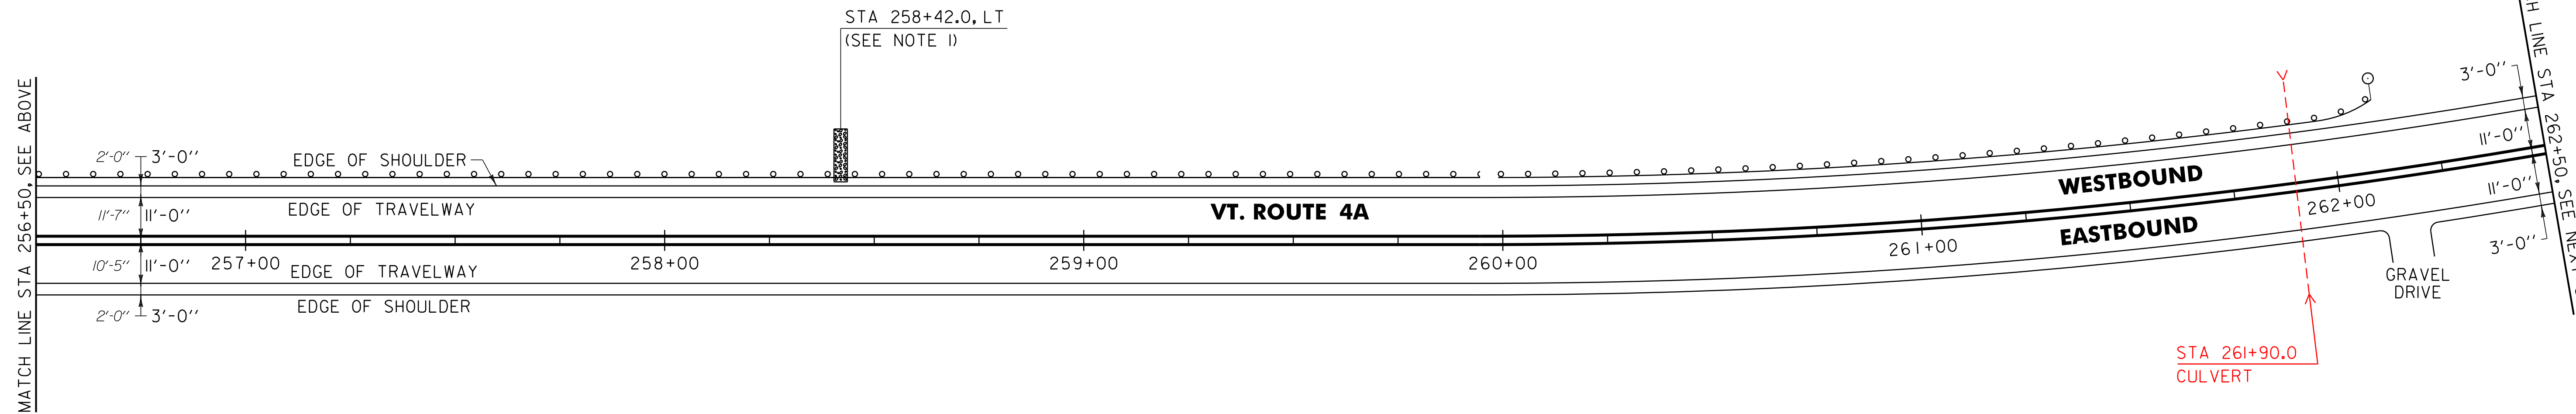

613.10 STONE FILL, TYPE I
 CASTLETON:
 STA 258+42.0 LT (2.0 CY)

621.205 STEEL BEAM GUARDRAIL, GALVANIZED W/8 FEET POSTS
 CASTLETON:
 STA 251+31.5 - STA 262+10.5 LT (1079.0 LF)

621.60 ANCHOR FOR STEEL BEAM RAIL
 CASTLETON:
 STA 251+38.0 LT
 STA 262+04.0 LT

621.80 REMOVAL AND DISPOSAL OF GUARDRAIL
 CASTLETON:
 STA 251+37.0 - STA 262+05.0, LT (1068.0 LF)

676.10 DELINEATOR WITH STEEL POST
 CASTLETON:
 STA 251+31.5 LT
 STA 262+10.5 LT

NOTE:
 1. AN ESTIMATED QUANTITY OF ITEM 613.10 STONE FILL, TYPE I HAS BEEN INCLUDED FOR THE REPAIR OF THE EXISTING SLOPE BY THE CONTRACTOR AS DIRECTED BY THE RESIDENT ENGINEER.

SIGN LEGEND
 R = REMOVE
 S = SALVAGE
 N = NEW
 RET = RETAIN
 B-B = BACK TO BACK
 EXISTING = - - - - -
 NEW = _____

PROJECT LAYOUT SHEET #6	NOT TO SCALE	
	PROJECT NAME: CASTLETON - WEST RUTLAND	PROJECT NUMBER: STP 2705(1)
	FILE NAME: p07cl68.dgn	PLOT DATE: 04-JUN-2013 09:14
	PROJECT LEADER: D.E.G. DESIGNED BY: M.J.M. IPARM FILE: p07cl68106.i	DRAWN BY: W.G.P. CHECKED BY: D.E.G. SHEET 27 OF 152