


646.402 DURABLE 4 INCH WHITE LINE, THERMOPLASTIC OR
 646.403 DURABLE 4 INCH WHITE LINE, EPOXY PAINT OR
 646.404 DURABLE 4 INCH WHITE LINE, POLYUREA
 (ALL LINES WILL INCLUDE EDGE LINE BREAKS AND
 RADIUS FOR TOWN HIGHWAYS)
 CASTLETON:
 STA 361+50.00 - STA 366+22.08 EDGE LINE LT & RT
 IRA:
 STA 0+00.00 - STA 7+25.00 EDGE LINE LT & RT

646.602 TEMPORARY 4 INCH WHITE LINE, PAINT
 (ALL LINES WILL INCLUDE EDGE LINE BREAKS AND
 RADIUS FOR TOWN HIGHWAYS)
 CASTLETON:
 STA 361+50.00 - STA 366+22.08 EDGE LINE LT & RT
 IRA:
 STA 0+00.00 - STA 7+25.00 EDGE LINE LT & RT

646.412 DURABLE 4 INCH YELLOW LINE, THERMOPLASTIC OR
 646.413 DURABLE 4 INCH YELLOW LINE, EPOXY PAINT OR
 646.414 DURABLE 4 INCH YELLOW LINE, POLYUREA
 (ALL LINES WILL INCLUDE C/L BREAKS FOR
 TOWN HIGHWAYS) S=SOLID, D=DASHED
 CASTLETON:
 STA 361+50.00 - STA 366+22.08
 LT C RT
 S - S
 IRA:
 STA 0+00.00 - STA 7+25.00
 S - S

646.612 TEMPORARY 4 INCH YELLOW LINE, PAINT
 (ALL LINES WILL INCLUDE C/L BREAKS FOR
 TOWN HIGHWAYS) S=SOLID, D=DASHED
 CASTLETON:
 STA 361+50.00 - STA 366+22.08
 LT C RT
 S - S
 IRA:
 STA 0+00.00 - STA 7+25.00
 S - S

675.50 REMOVING SIGN
 AS SHOWN - 6

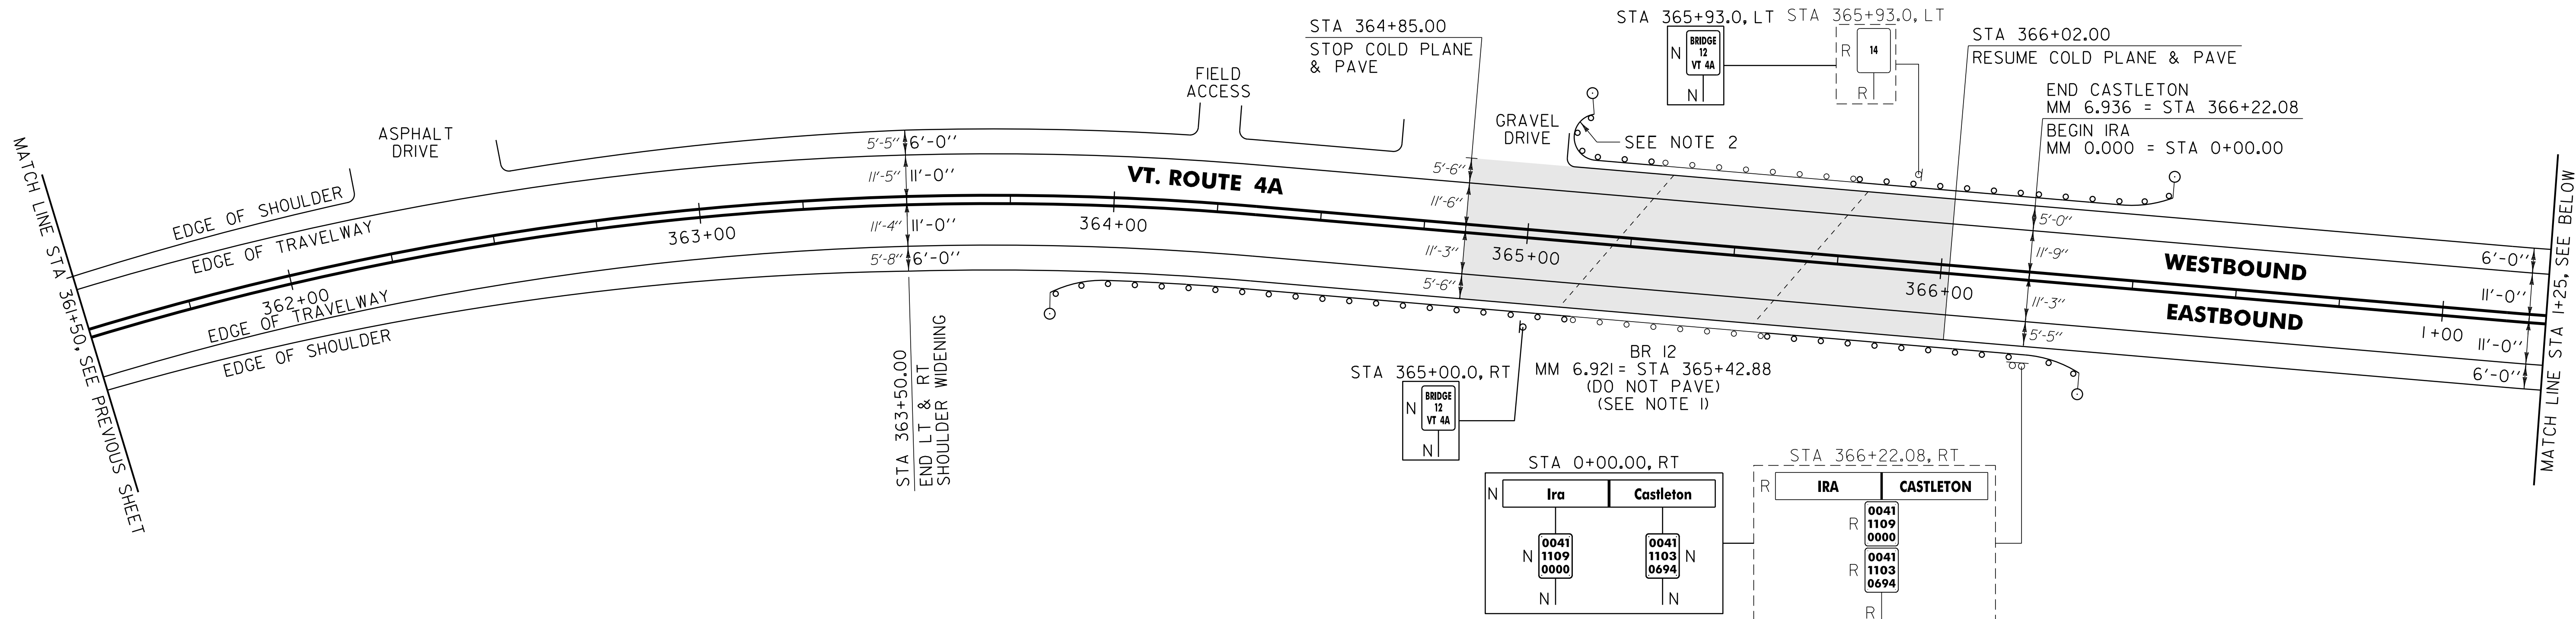

621.20 STEEL BEAM GUARDRAIL, GALVANIZED
 CASTLETON:
 STA 363+85.0 - STA 364+62.0 RT (77.0 LF)
 STA 365+18.5 - STA 365+18.5 LT (16.0 LF)
 STA 366+09.0 - STA 366+22.08 RT (13.08 LF)

621.70 GUARDRAIL APPROACH SECTION, GALVANIZED TYPE I
 CASTLETON:
 STA 364+62.0 - STA 365+12.0 RT
 STA 365+59.0 - STA 366+09.0 RT
 STA 365+78.0 - STA 366+22.08 LT

621.80 REMOVAL AND DISPOSAL OF GUARDRAIL
 CASTLETON:
 STA 363+92.0 - STA 365+12.0 RT (120.0 LF)
 STA 365+18.5 - STA 365+31.0 LT (41.0 LF)
 STA 365+59.0 - STA 366+22.08 RT (63.08 LF)
 STA 365+78.0 - STA 366+22.08 LT (44.08 LF)

IRA:
 STA 0+00.0 - STA 0+13.92 RT (13.92 LF)
 STA 0+05.92 - STA 0+32.92 LT (27.0 LF)

IRA:
 STA 0+00.0 - STA 0+05.92 LT

IRA:
 STA 0+00.0 - STA 0+03.92 RT (3.92 LF)
 STA 0+00.0 - STA 0+23.92 LT (23.92 LF)


621.60 ANCHOR FOR STEEL BEAM RAIL
 CASTLETON:
 STA 363+91.5 RT
 STA 365+18.5 LT

621.71 GUARDRAIL APPROACH SECTION, GALVANIZED TYPE II
 CASTLETON:
 STA 365+18.5 - STA 365+31.0 LT

676.10 DELINEATOR WITH STEEL POST
 CASTLETON:
 STA 363+85.0 RT
 STA 365+18.5 LT

IRA:
 STA 0+07.42 RT
 STA 0+26.42 LT

IRA:
 STA 0+13.92 RT
 STA 0+39.92 LT

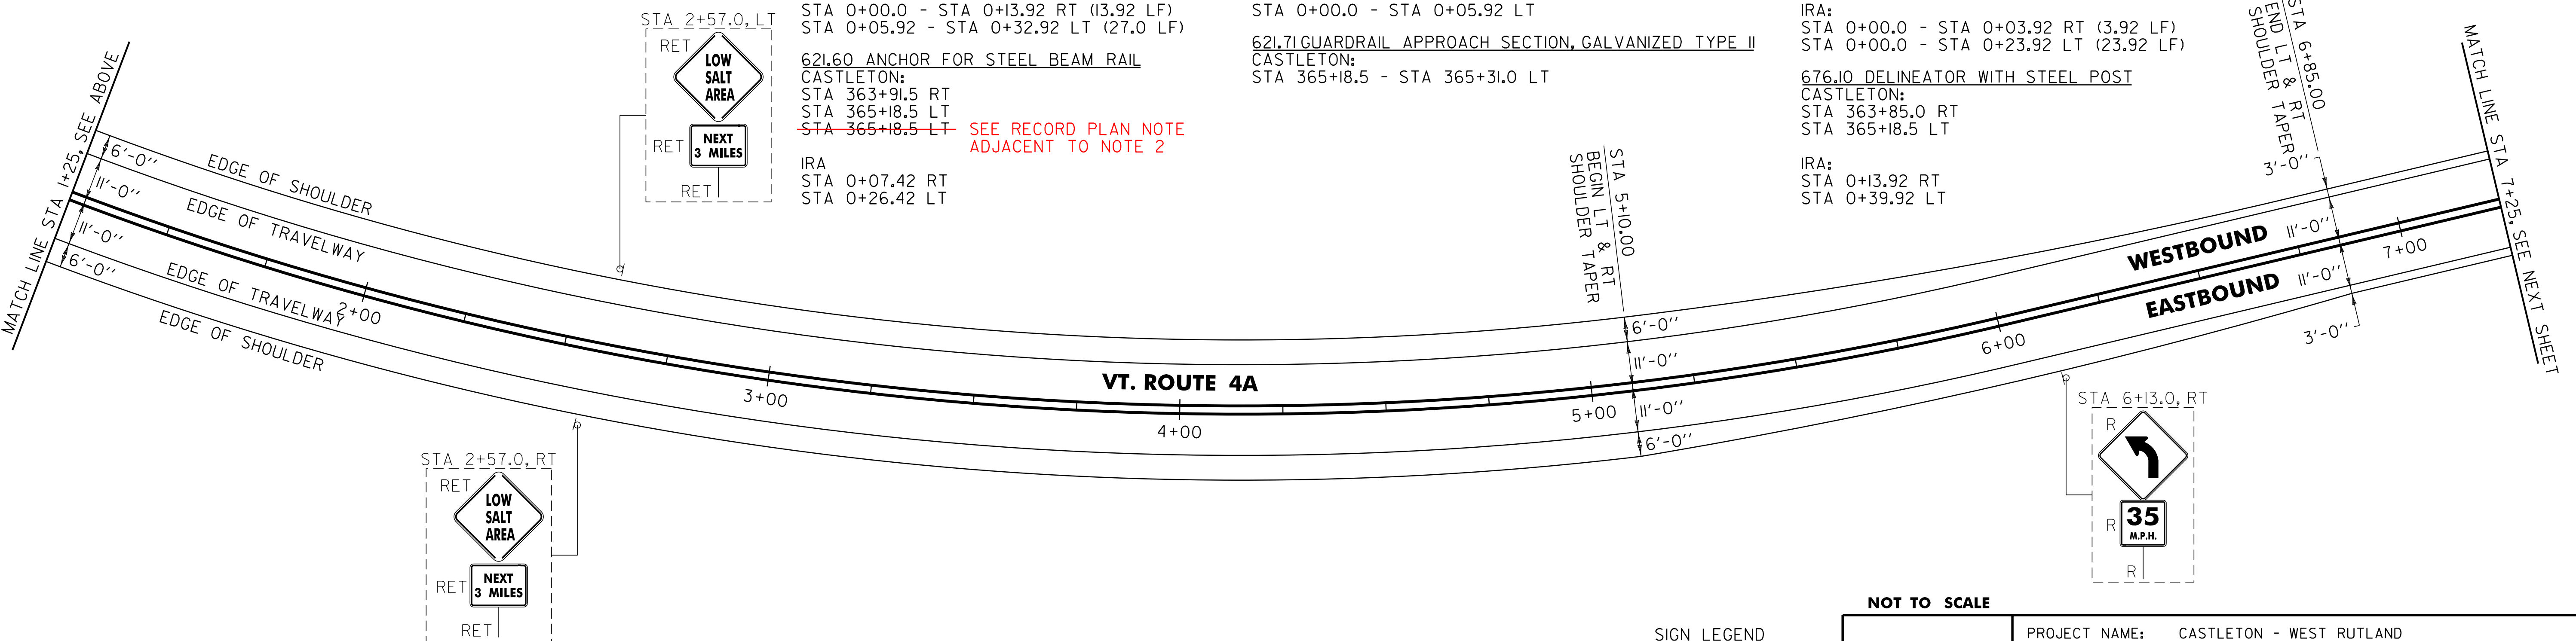

NOTES:
 1. SEE SHEET 84 FOR BR 12 DETAILS.

2. THE CONTRACTOR SHALL INSTALL A NEW 16' ONLY ONE ANCHOR INSTALLED DUE TO INSUFFICIENT ROOM TO INSTALL TWO ANCHORS PER RE AS DIRECTED BY THE RESIDENT ENGINEER.

NO PAVING WORK TO BE PERFORMED IN THIS AREA

SIGN LEGEND
 R = REMOVE
 S = SALVAGE
 N = NEW
 RET = RETAIN
 B-B = BACK TO BACK
 EXISTING = - - - - -
 NEW = _____

NOT TO SCALE

PROJECT LAYOUT SHEET #16	PROJECT NAME: CASTLETON - WEST RUTLAND	PLOT DATE: 04-JUN-2013 09:14
	PROJECT NUMBER: STP 2705(i)	DRAWN BY: W.G.P.
	FILE NAME: p07cl68.dgn	CHECKED BY: D.E.G.
	PROJECT LEADER: D.E.G.	SHEET 37 OF 152