

646.402 DURABLE 4 INCH WHITE LINE, THERMOPLASTIC OR
 646.403 DURABLE 4 INCH WHITE LINE, EPOXY PAINT OR
 646.404 DURABLE 4 INCH WHITE LINE, POLYUREA
 (ALL LINES WILL INCLUDE EDGE LINE BREAKS AND
 RADIUS FOR TOWN HIGHWAYS)
 IRA:
 STA 19+25.00 - STA 31+25.00 EDGE LINE LT & RT



646.602 TEMPORARY 4 INCH WHITE LINE, PAINT
 (ALL LINES WILL INCLUDE EDGE LINE BREAKS AND
 RADIUS FOR TOWN HIGHWAYS)
 IRA:
 STA 19+25.00 - STA 31+25.00 EDGE LINE LT & RT

646.412 DURABLE 4 INCH YELLOW LINE, THERMOPLASTIC OR
 646.413 DURABLE 4 INCH YELLOW LINE, EPOXY PAINT OR
 646.414 DURABLE 4 INCH YELLOW LINE, POLYUREA
 (ALL LINES WILL INCLUDE C/L BREAKS FOR
 TOWN HIGHWAYS) S=SOLID, D=DASHED
 IRA:
 STA 19+25.00 - STA 31+25.00

LT C RT
 S - S

646.612 TEMPORARY 4 INCH YELLOW LINE, PAINT
 (ALL LINES WILL INCLUDE C/L BREAKS FOR
 TOWN HIGHWAYS) S=SOLID, D=DASHED
 IRA:
 STA 19+25.00 - STA 31+25.00

LT C RT
 S - S

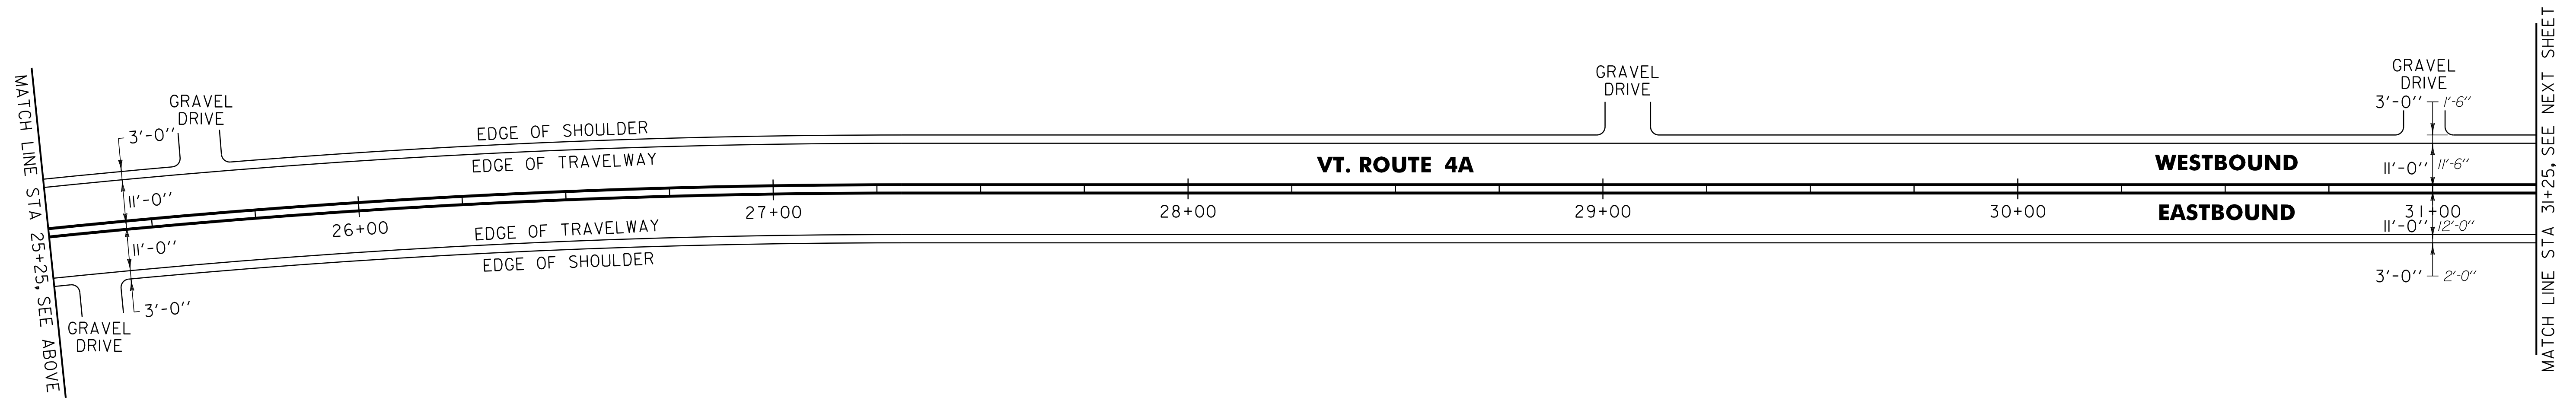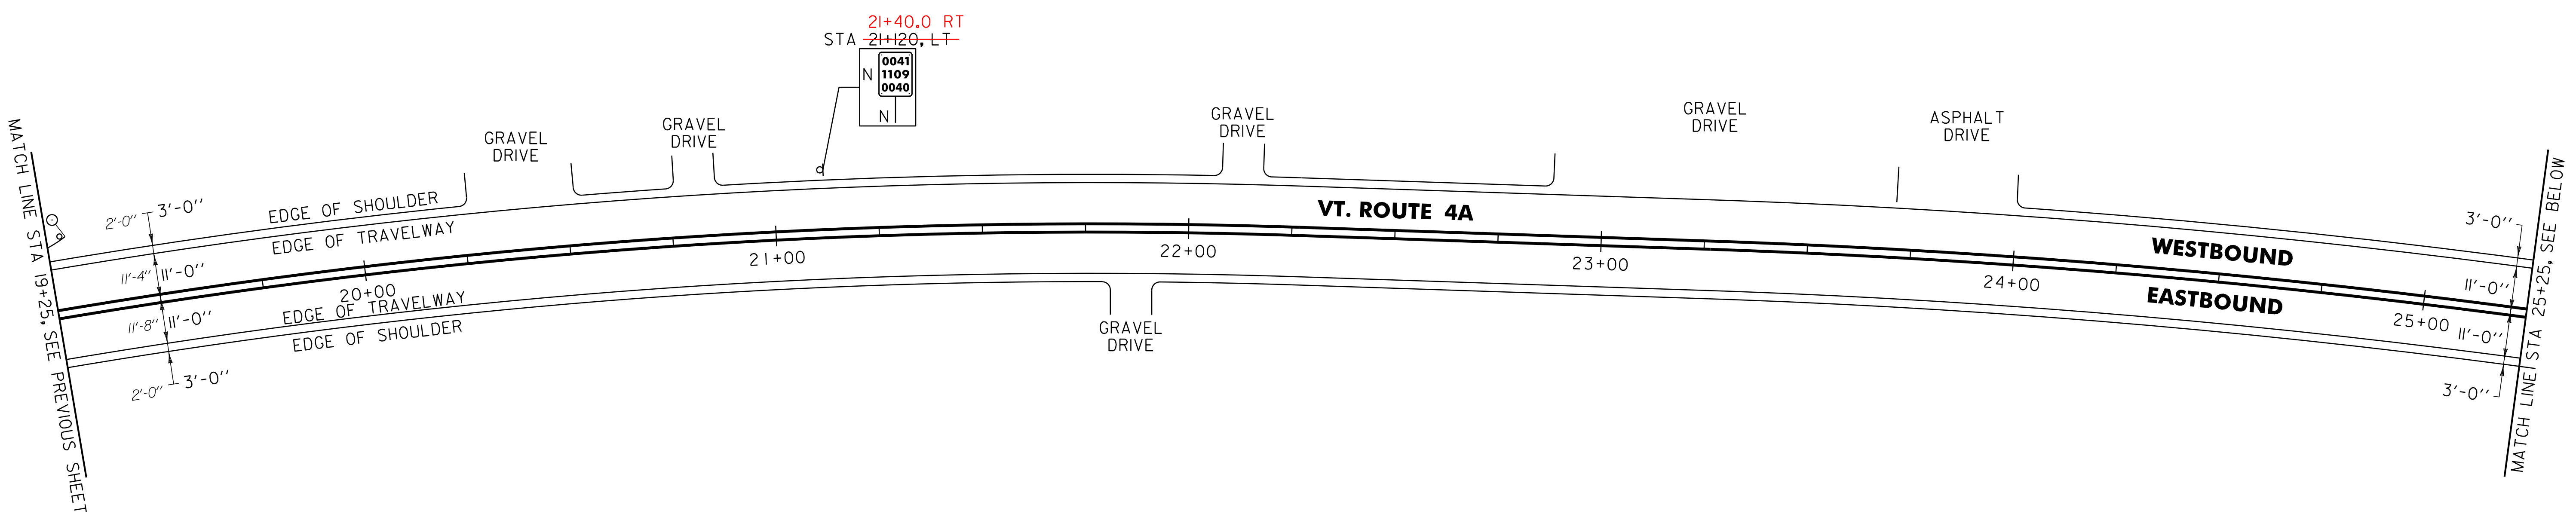

621.20 STEEL BEAM GUARDRAIL, GALVANIZED
 IRA:
 STA 19+25.0 - STA 19+32.9 LT (7.9 LF)
 621.60 ANCHOR FOR STEEL BEAM RAIL
 CASTLETON:
 STA 19+26.4 LT
 676.10 DELINEATOR WITH STEEL POST
 IRA:
 STA 19+32.9 LT

SIGN LEGEND
 R = REMOVE
 S = SALVAGE
 N = NEW
 RET = RETAIN
 B-B = BACK TO BACK
 EXISTING = - - - - -
 NEW = _____

| | | |
|---------------------------------|---|---|
| PROJECT LAYOUT SHEET #18 | NOT TO SCALE | |
| | PROJECT NAME: CASTLETON - WEST RUTLAND | PROJECT NUMBER: STP 2705(i) |
| | FILE NAME: p07cl68.dgn | PLOT DATE: 04-JUN-2013 09:14 |
| | PROJECT LEADER: D.E.G. DESIGNED BY: M.J.M. IPARM FILE: p07cl68i18.i | DRAWN BY: W.G.P. CHECKED BY: D.E.G. SHEET 39 OF 152 |