

646.402 DURABLE 4 INCH WHITE LINE, THERMOPLASTIC OR
 646.403 DURABLE 4 INCH WHITE LINE, EPOXY PAINT OR
 646.404 DURABLE 4 INCH WHITE LINE, POLYUREA
 (ALL LINES WILL INCLUDE EDGE LINE BREAKS AND
 RADIUS FOR TOWN HIGHWAYS)

IRA:
 STA 61+25.00 - STA 68+69.28 EDGE LINE LT & RT

WEST RUTLAND:
 STA 0+00.00 - STA 4+25.00 EDGE LINE LT & RT
 STA 61+50.0, LT

646.412 DURABLE 4 INCH YELLOW LINE, THERMOPLASTIC OR
 646.413 DURABLE 4 INCH YELLOW LINE, EPOXY PAINT OR
 646.414 DURABLE 4 INCH YELLOW LINE, POLYUREA
 (ALL LINES WILL INCLUDE C/L BREAKS FOR
 TOWN HIGHWAYS) S=SOLID, D=DASHED

IRA:
 STA 61+25.00 - STA 67+05.00 LT C RT
 S - S
 STA 67+05.00 - STA 68+69.28 S - D

WEST RUTLAND:
 STA 0+00.00 - STA 4+25.00 S - D

646.602 TEMPORARY 4 INCH WHITE LINE, PAINT
 (ALL LINES WILL INCLUDE EDGE LINE BREAKS AND
 RADIUS FOR TOWN HIGHWAYS)

IRA:
 STA 61+25.00 - STA 68+69.28 EDGE LINE LT & RT

WEST RUTLAND:
 STA 0+00.00 - STA 4+25.00 EDGE LINE LT & RT



675.50 REMOVING SIGNS
 AS SHOWN - I2

IRA:
 STA 61+25.00 - STA 67+05.00 LT C RT
 S - S
 STA 67+05.00 - STA 68+69.28 S - D

WEST RUTLAND:
 STA 0+00.00 - STA 4+25.00 S - D

MATCH LINE STA 61+25, SEE PREVIOUS SHEET

MATCH LINE STA 67+25, SEE BELOW

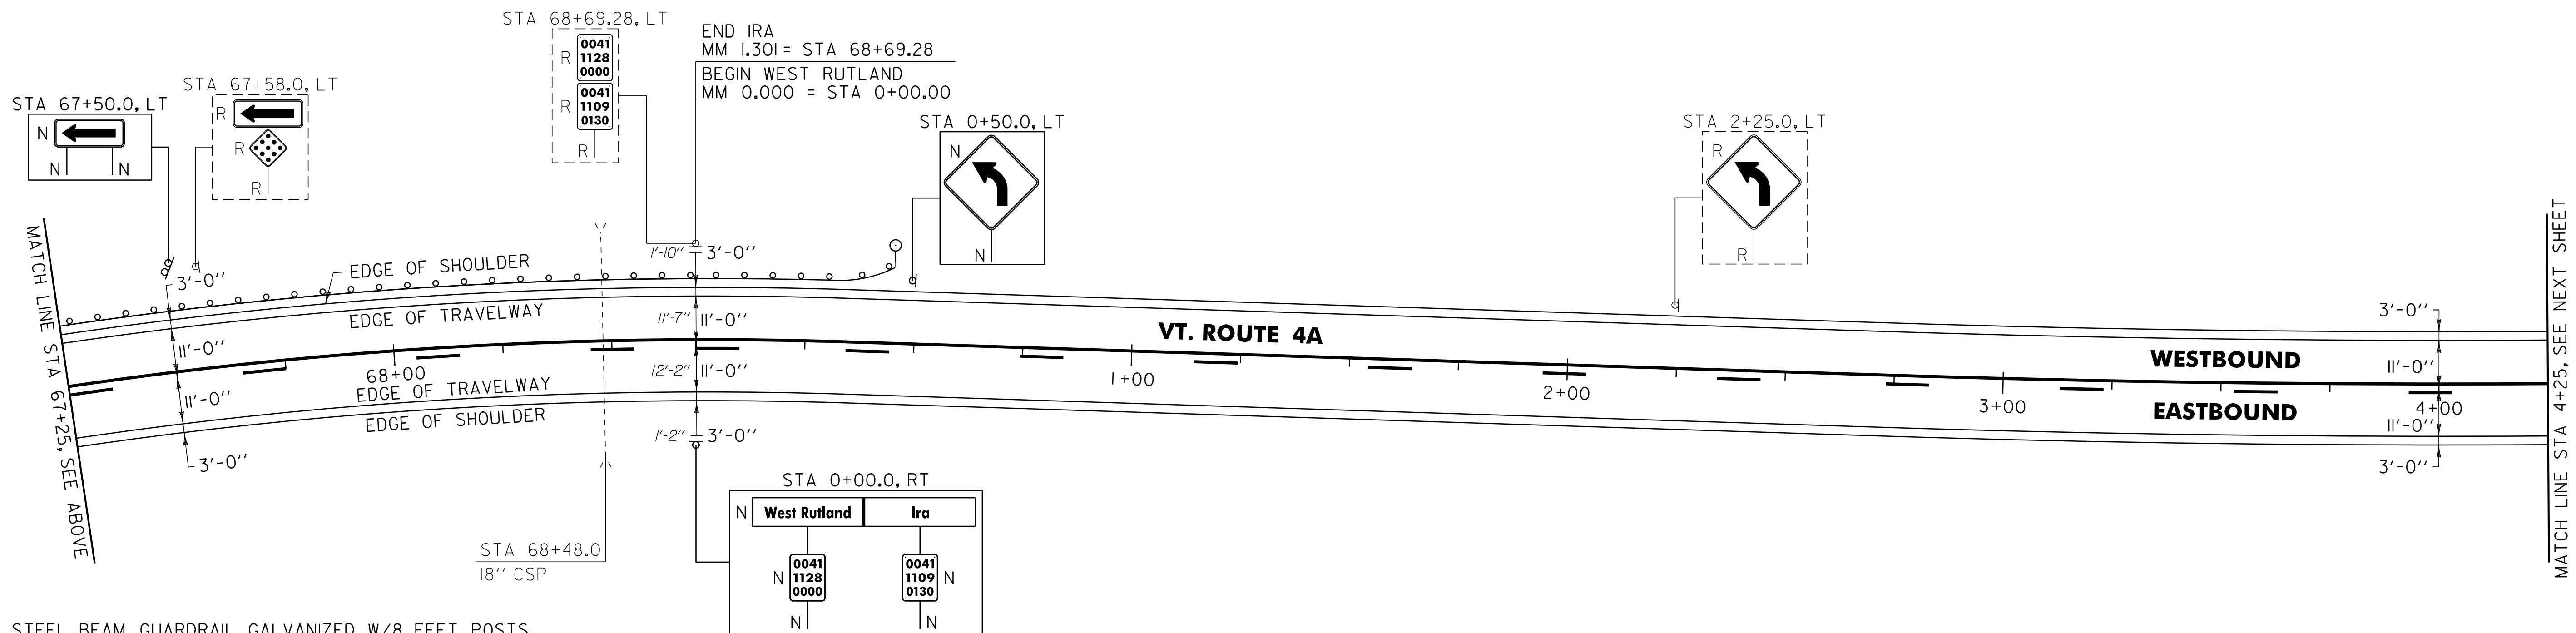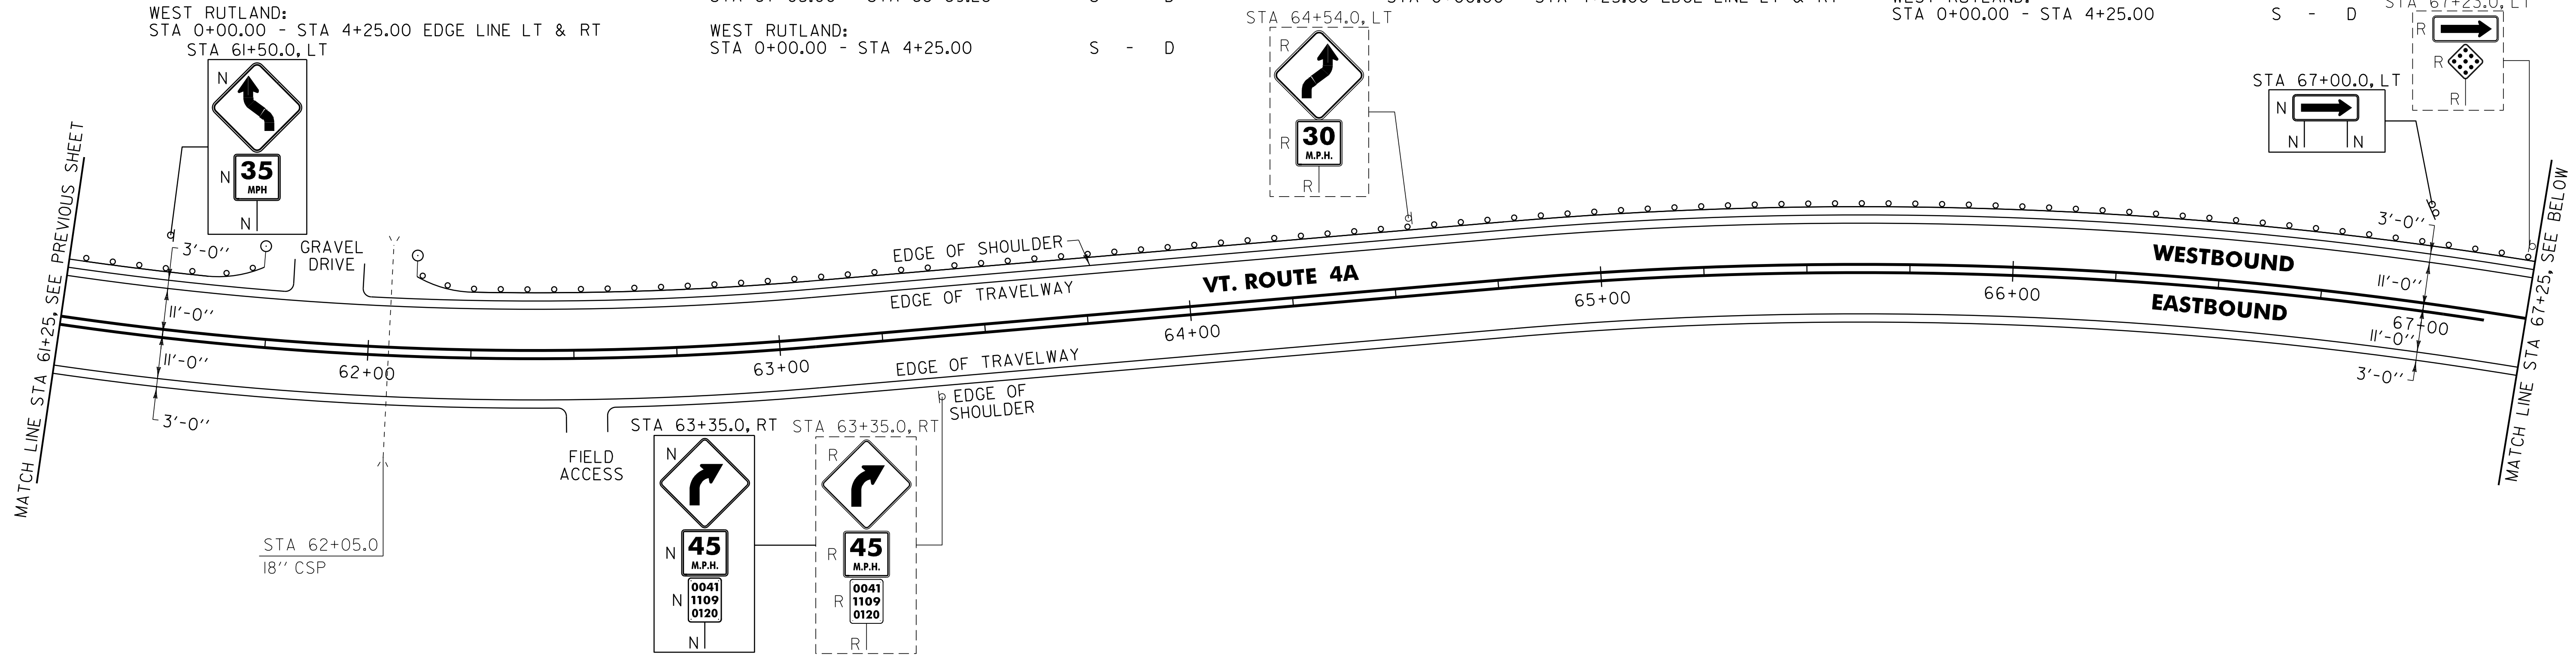

MATCH LINE STA 67+25, SEE ABOVE

MATCH LINE STA 4+25, SEE NEXT SHEET

621.205 STEEL BEAM GUARDRAIL, GALVANIZED W/8 FEET POSTS
 IRA:
 STA 61+25.0 - STA 61+84.8 LT (59.8 LF)
 STA 62+11.0 - STA 68+69.28 LT (658.28 LF)

WEST RUTLAND:
 STA 0+00.0 - 0+45.72 LT (45.72 LF)

621.60 ANCHOR FOR STEEL BEAM RAIL
 IRA:
 STA 61+78.3 LT
 STA 62+17.5 LT

WEST RUTLAND:
 STA 0+39.22 LT

621.80 REMOVAL AND DISPOSAL OF GUARDRAIL
 IRA:
 STA 61+25.0 - STA 61+79.0 LT (54.0 LF)
 STA 62+11.0 - STA 68+69.28 LT (658.28 LF)

WEST RUTLAND:
 STA 0+00.0 - STA 0+34.72 LT (34.72 LF)

676.10 DELINEATOR WITH STEEL POST
 IRA:
 STA 61+84.8 LT
 STA 62+11.0 LT

WEST RUTLAND:
 STA 0+45.72 LT

SIGN LEGEND
 R = REMOVE
 S = SALVAGE
 N = NEW
 RET = RETAIN
 B-B = BACK TO BACK
 EXISTING = - - - - -
 NEW = _____

NOT TO SCALE

PROJECT LAYOUT SHEET #22	PROJECT NAME: CASTLETON - WEST RUTLAND	PLOT DATE: 04-JUN-2013 09:14
	PROJECT NUMBER: STP 2705(i)	DRAWN BY: W.G.P.
	FILE NAME: p07cl68.dgn	CHECKED BY: D.E.G.
	PROJECT LEADER: D.E.G.	SHEET 43 OF 152