


646.402 DURABLE 4 INCH WHITE LINE, THERMOPLASTIC OR  
 646.403 DURABLE 4 INCH WHITE LINE, EPOXY PAINT OR  
 646.404 DURABLE 4 INCH WHITE LINE, POLYUREA  
 (ALL LINES WILL INCLUDE EDGE LINE BREAKS AND  
 RADIUS FOR TOWN HIGHWAYS)  
 WEST RUTLAND:  
 STA 52+25.00 - STA 63+25.00 EDGE LINE LT & RT  
 646.412 DURABLE 4 INCH YELLOW LINE, THERMOPLASTIC OR  
 646.413 DURABLE 4 INCH YELLOW LINE, EPOXY PAINT OR  
 646.414 DURABLE 4 INCH YELLOW LINE, POLYUREA  
 (ALL LINES WILL INCLUDE C/L BREAKS FOR  
 TOWN HIGHWAYS) S=SOLID, D=DASHED  
 WEST RUTLAND:  
 STA 52+25.00 - STA 63+25.00 LT ☉ RT  
 S - S

646.602 TEMPORARY 4 INCH WHITE LINE, PAINT  
 (ALL LINES WILL INCLUDE EDGE LINE BREAKS AND  
 RADIUS FOR TOWN HIGHWAYS)  
 WEST RUTLAND:  
 STA 52+25.00 - STA 63+25.00 EDGE LINE LT & RT  
 646.612 TEMPORARY 4 INCH YELLOW LINE, PAINT  
 (ALL LINES WILL INCLUDE C/L BREAKS FOR  
 TOWN HIGHWAYS) S=SOLID, D=DASHED  
 WEST RUTLAND:  
 STA 52+25.00 - STA 63+25.00 LT ☉ RT  
 S - S

675.50 REMOVING SIGNS  
 AS SHOWN - 3


MATCH LINE STA 52+25, SEE PREVIOUS SHEET

MATCH LINE STA 58+25, SEE BELOW

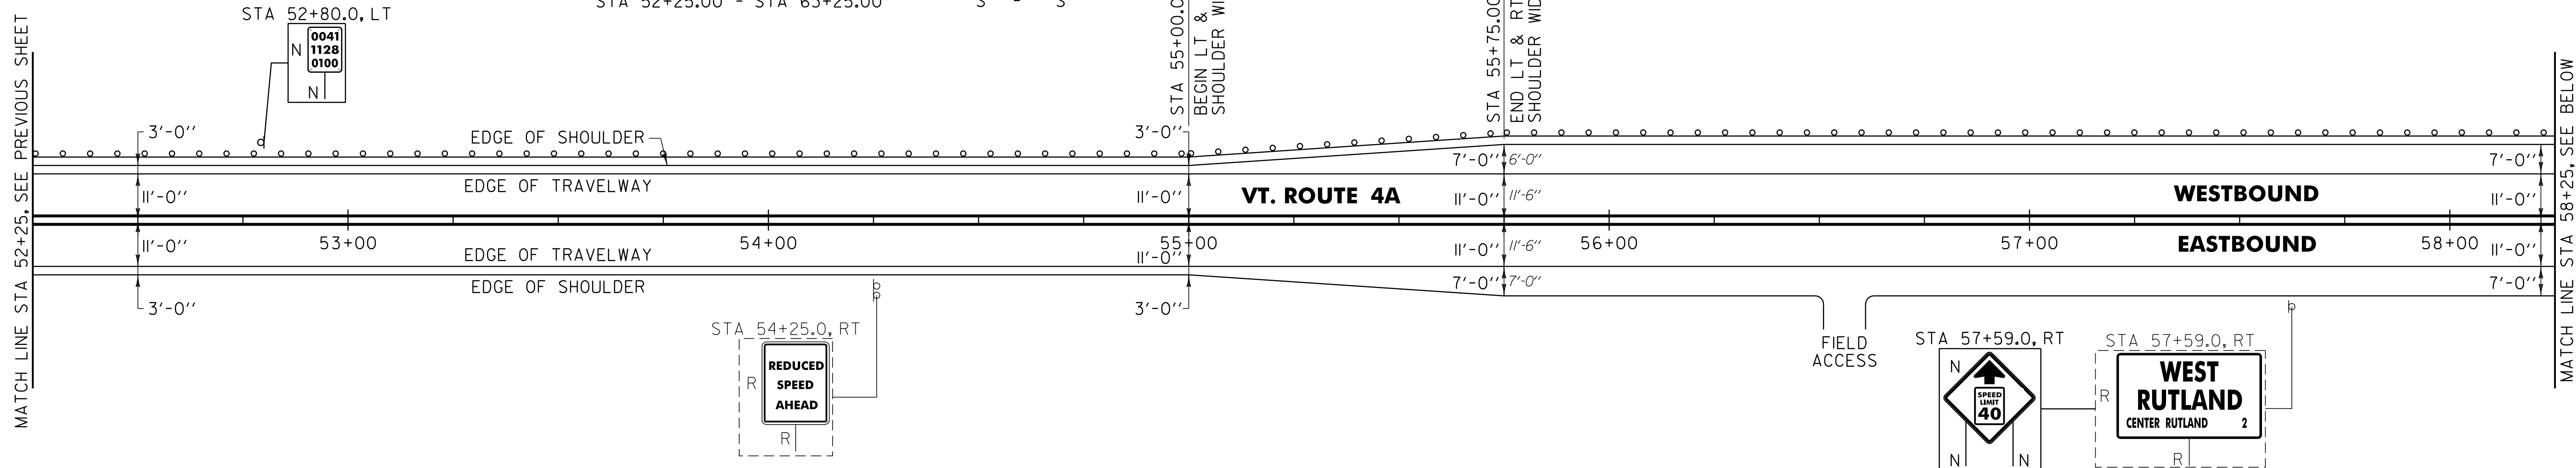

MATCH LINE STA 58+25, SEE ABOVE

MATCH LINE STA 63+25, SEE NEXT SHEET

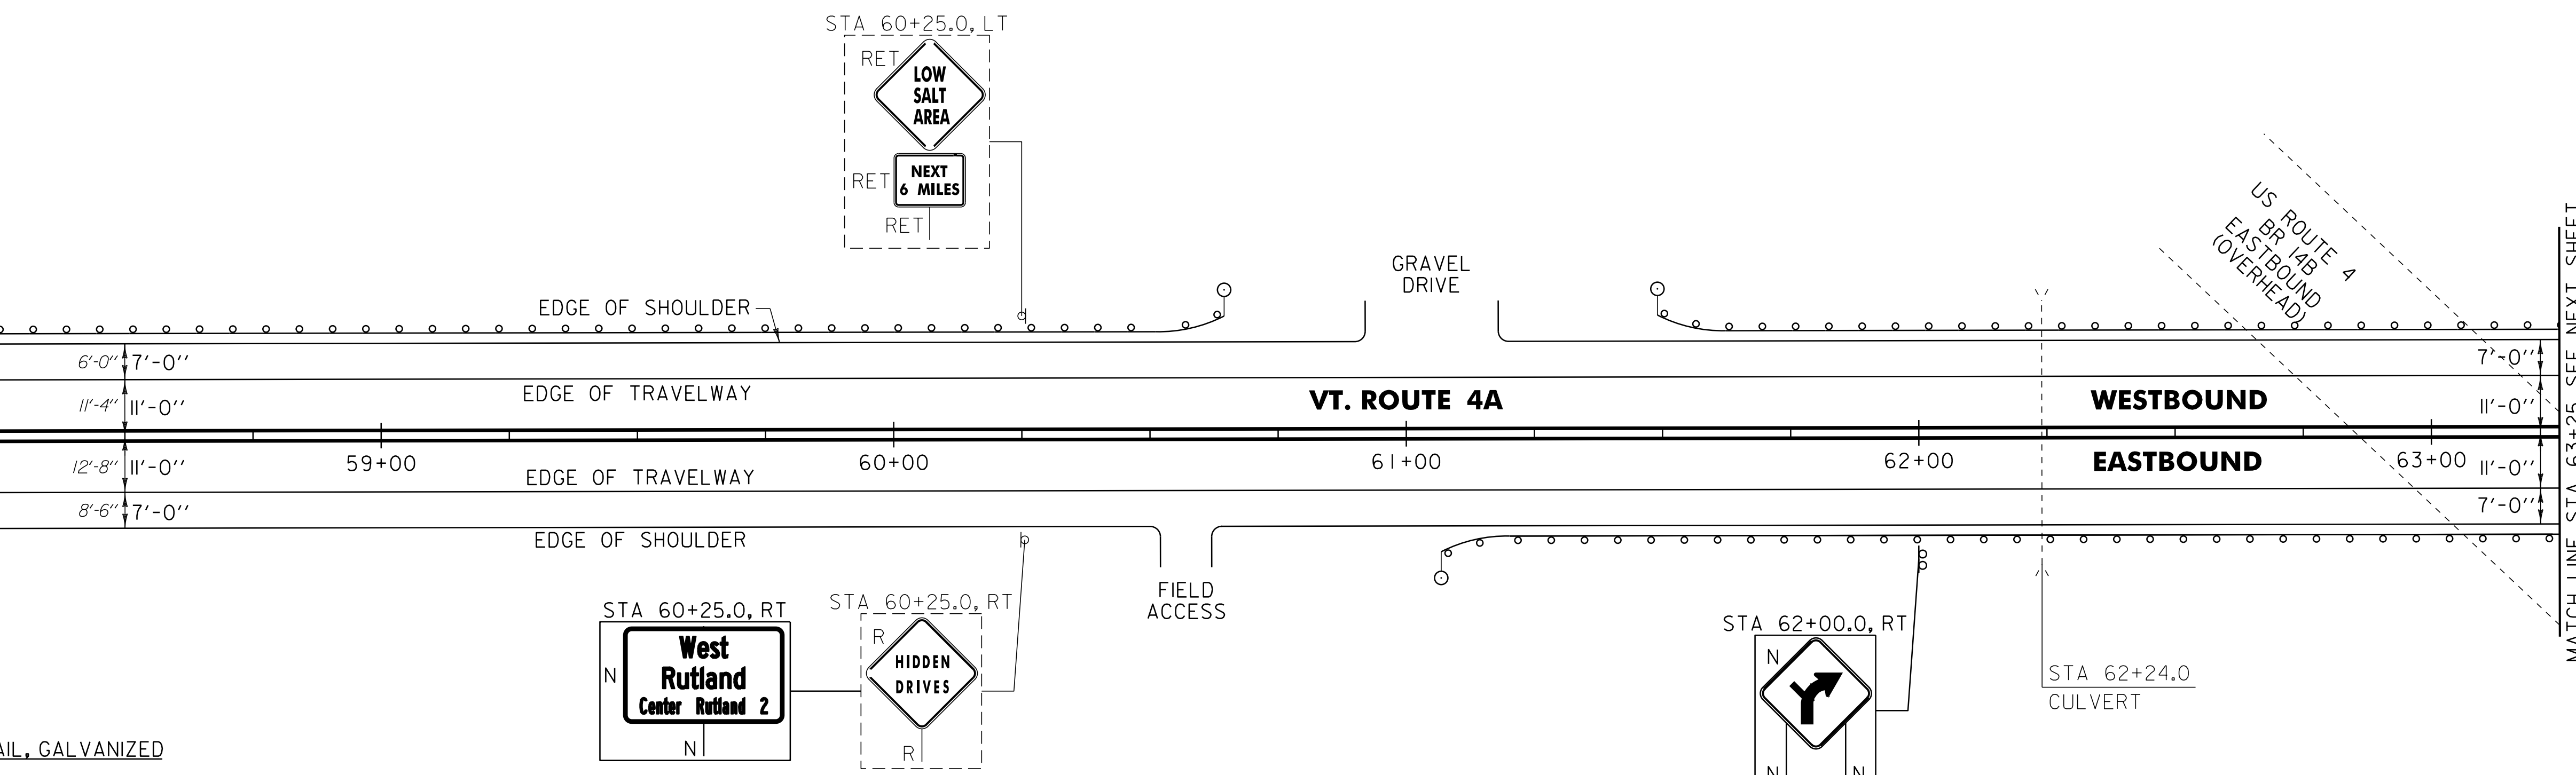

621.20 STEEL BEAM GUARDRAIL, GALVANIZED  
 WEST RUTLAND:  
 STA 61+06.8 - STA 63+25.0 RT (218.2 LF)  
 STA 61+49.0 - STA 63+25.0 LT (176.0 LF)

621.205 STEEL BEAM GUARDRAIL W/8 FEET POSTS  
 CASTLETON:  
 STA 52+25.0 - STA 60+64.5 LT (839.5 LF)

621.60 ANCHOR FOR STEEL BEAM RAIL  
 WEST RUTLAND:  
 STA 60+58.0 LT  
 STA 61+13.3 RT  
 STA 61+55.5 LT

621.80 REMOVAL AND DISPOSAL OF GUARDRAIL  
 WEST RUTLAND:  
 STA 52+25.0 - STA 60+57.0 LT (832.0 LF)  
 STA 61+05.0 - STA 63+25.0 RT (220.0 LF)  
 STA 61+51.0 - STA 63+25.0 LT (174.0 LF)

676.10 DELINEATOR WITH STEEL POST  
 WEST RUTLAND:  
 STA 60+64.5 LT  
 STA 61+06.8 RT  
 STA 61+49.0 LT

**SIGN LEGEND**  
 R = REMOVE  
 S = SALVAGE  
 N = NEW  
 RET = RETAIN  
 B-B = BACK TO BACK  
 EXISTING = - - - - -  
 NEW = \_\_\_\_\_

NOT TO SCALE

<b>PROJECT LAYOUT SHEET #27</b>	PROJECT NAME: CASTLETON - WEST RUTLAND	PLOT DATE: 04-JUN-2013 09:14
	PROJECT NUMBER: STP 2705(i)	DRAWN BY: W.G.P.
	FILE NAME: p07cl68.dgn	CHECKED BY: D.E.G.
	PROJECT LEADER: D.E.G.	SHEET 48 OF 152