

646.402 DURABLE 4 INCH WHITE LINE, THERMOPLASTIC OR
 646.403 DURABLE 4 INCH WHITE LINE, EPOXY PAINT OR
 646.404 DURABLE 4 INCH WHITE LINE, POLYUREA
 (ALL LINES WILL INCLUDE EDGE LINE BREAKS AND
 RADIUS FOR TOWN HIGHWAYS)
 WEST RUTLAND:
 STA 69+25.00 - STA 81+25.00 EDGE LINE LT & RT

646.412 DURABLE 4 INCH YELLOW LINE, THERMOPLASTIC OR
 646.413 DURABLE 4 INCH YELLOW LINE, EPOXY PAINT OR
 646.414 DURABLE 4 INCH YELLOW LINE, POLYUREA
 (ALL LINES WILL INCLUDE C/L BREAKS FOR
 TOWN HIGHWAYS) S=SOLID, D=DASHED
 WEST RUTLAND:
 STA 69+25.00 - STA 81+25.00


646.602 TEMPORARY 4 INCH WHITE LINE, PAINT
 (ALL LINES WILL INCLUDE EDGE LINE BREAKS AND
 RADIUS FOR TOWN HIGHWAYS)
 WEST RUTLAND:
 STA 69+25.00 - STA 81+25.00 EDGE LINE LT & RT

646.612 TEMPORARY 4 INCH YELLOW LINE, PAINT
 (ALL LINES WILL INCLUDE C/L BREAKS FOR
 TOWN HIGHWAYS) S=SOLID, D=DASHED
 WEST RUTLAND:
 STA 69+25.00 - STA 81+25.00

675.50 REMOVING SIGNS
 AS SHOWN - 4


MATCH LINE STA 69+25, SEE PREVIOUS SHEET

MATCH LINE STA 75+25, SEE BELOW

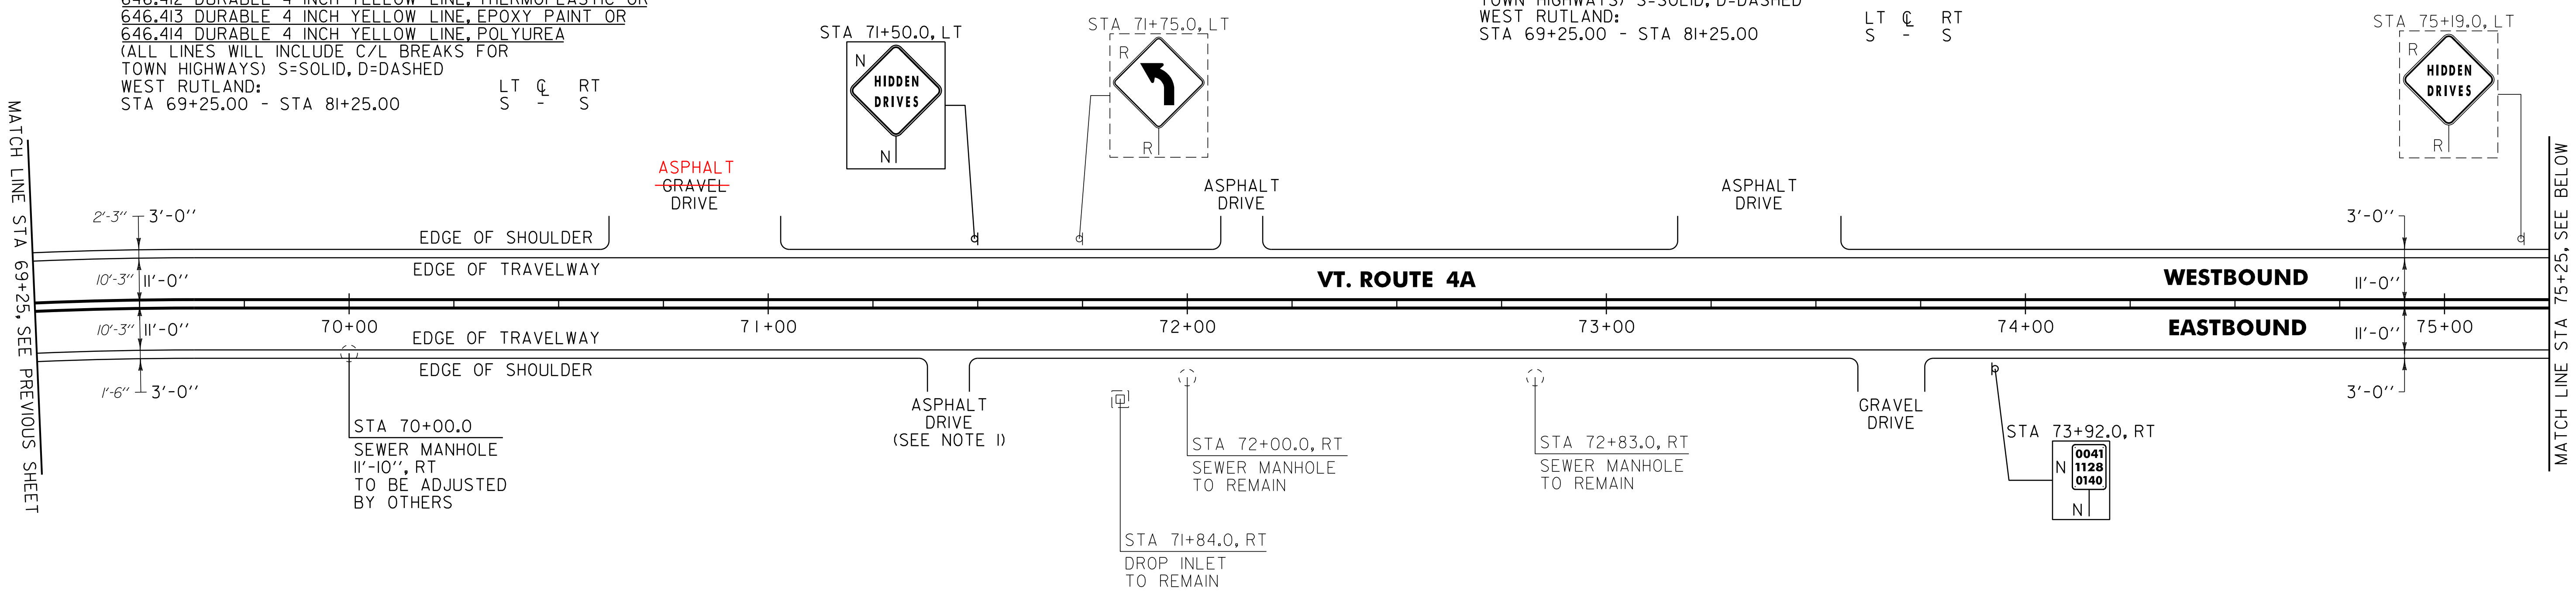

MATCH LINE STA 75+25, SEE ABOVE

MATCH LINE STA 81+25, SEE NEXT SHEET

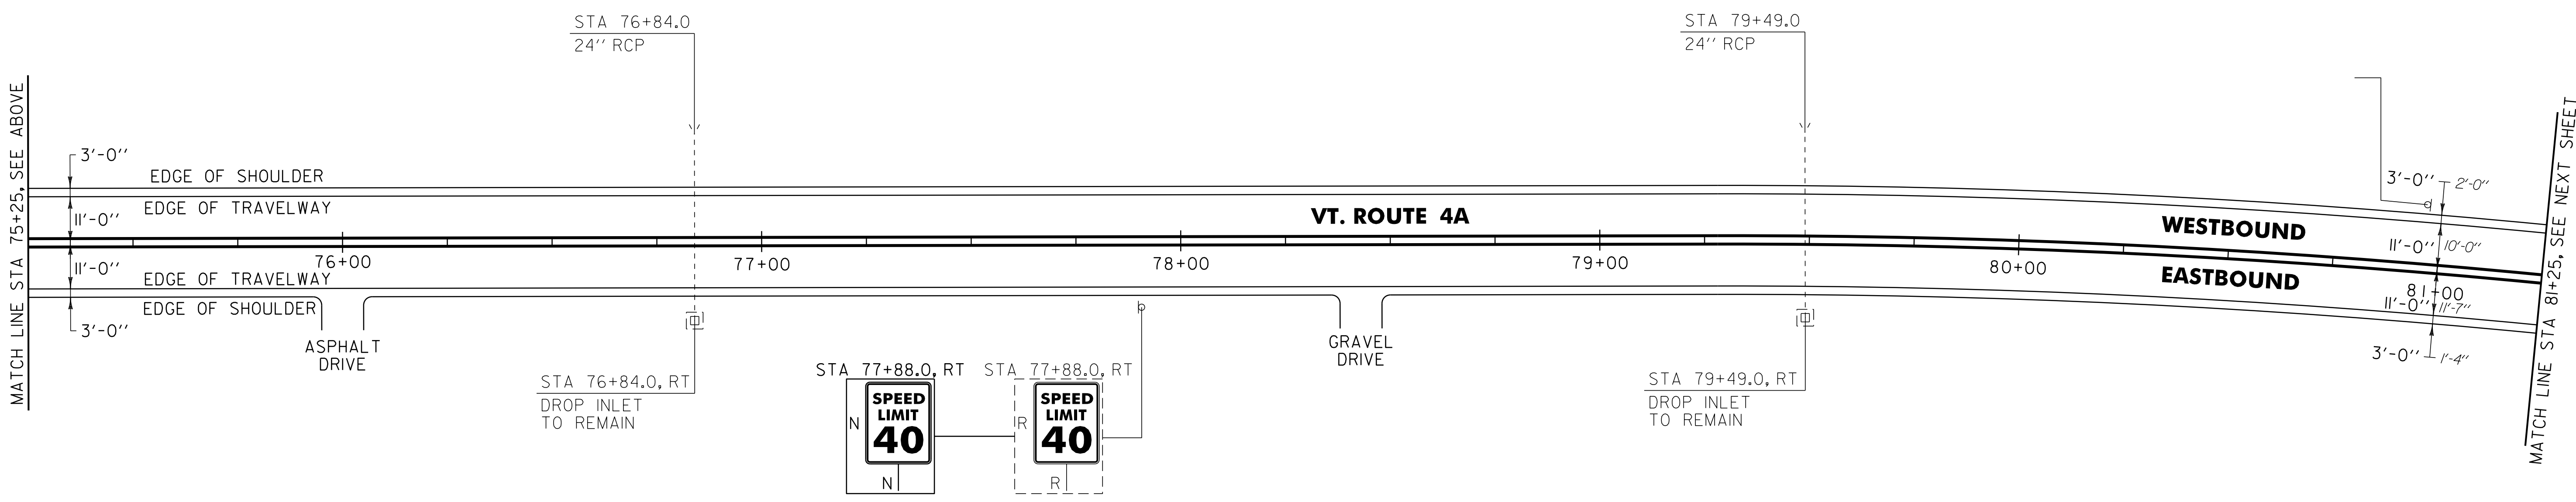

NOTE:
 1. THE CONTRACTOR SHALL PAVE THE EXISTING DRIVEWAY SO THAT DRAINAGE IS REDIRECTED TO THE EXISTING DI LOCATED AT STA 71+84.0 RT AS DIRECTED BY THE RESIDENT ENGINEER. PAYMENT WILL BE INCIDENTAL TO ITEM 490.30 SUPERPAVE BITUMINOUS CONCRETE PAVEMENT.

SIGN LEGEND
 R = REMOVE
 S = SALVAGE
 N = NEW
 RET = RETAIN
 B-B = BACK TO BACK
 EXISTING = - - - - -
 NEW = _____

NOT TO SCALE

PROJECT LAYOUT SHEET #29	PROJECT NAME: CASTLETON - WEST RUTLAND	PLOT DATE: 04-JUN-2013 09:14
	PROJECT NUMBER: STP 2705(i)	DRAWN BY: W.G.P.
	FILE NAME: p07cl68.dgn	CHECKED BY: D.E.G.
	DESIGNED BY: M.J.M.	SHEET 50 OF 152
	IPARM FILE: p07cl68i29.i	