

646.402 DURABLE 4 INCH WHITE LINE, THERMOPLASTIC OR  
646.403 DURABLE 4 INCH WHITE LINE, EPOXY PAINT OR  
646.404 DURABLE 4 INCH WHITE LINE, POLYUREA  
(ALL LINES WILL INCLUDE EDGE LINE BREAKS AND  
RADIUS FOR TOWN HIGHWAYS)  
WEST RUTLAND:  
STA 81+25.00 - STA 93+25.00 EDGE LINE LT & RT

646.412 DURABLE 4 INCH YELLOW LINE, THERMOPLASTIC OR  
646.413 DURABLE 4 INCH YELLOW LINE, EPOXY PAINT OR  
646.414 DURABLE 4 INCH YELLOW LINE, POLYUREA  
(ALL LINES WILL INCLUDE C/L BREAKS FOR  
TOWN HIGHWAYS) S=SOLID, D=DASHED  
WEST RUTLAND:  
STA 81+25.00 - STA 93+25.00



646.602 TEMPORARY 4 INCH WHITE LINE, PAINT  
(ALL LINES WILL INCLUDE EDGE LINE BREAKS AND  
RADIUS FOR TOWN HIGHWAYS)  
WEST RUTLAND:  
STA 81+25.00 - STA 93+25.00 EDGE LINE LT & RT

646.612 TEMPORARY 4 INCH YELLOW LINE, PAINT  
(ALL LINES WILL INCLUDE C/L BREAKS FOR  
TOWN HIGHWAYS) S=SOLID, D=DASHED  
WEST RUTLAND:  
STA 81+25.00 - STA 93+25.00

LT C RT  
S - S

STA 84+48.0, LT-RT

0041  
1128  
0160  
N  
N

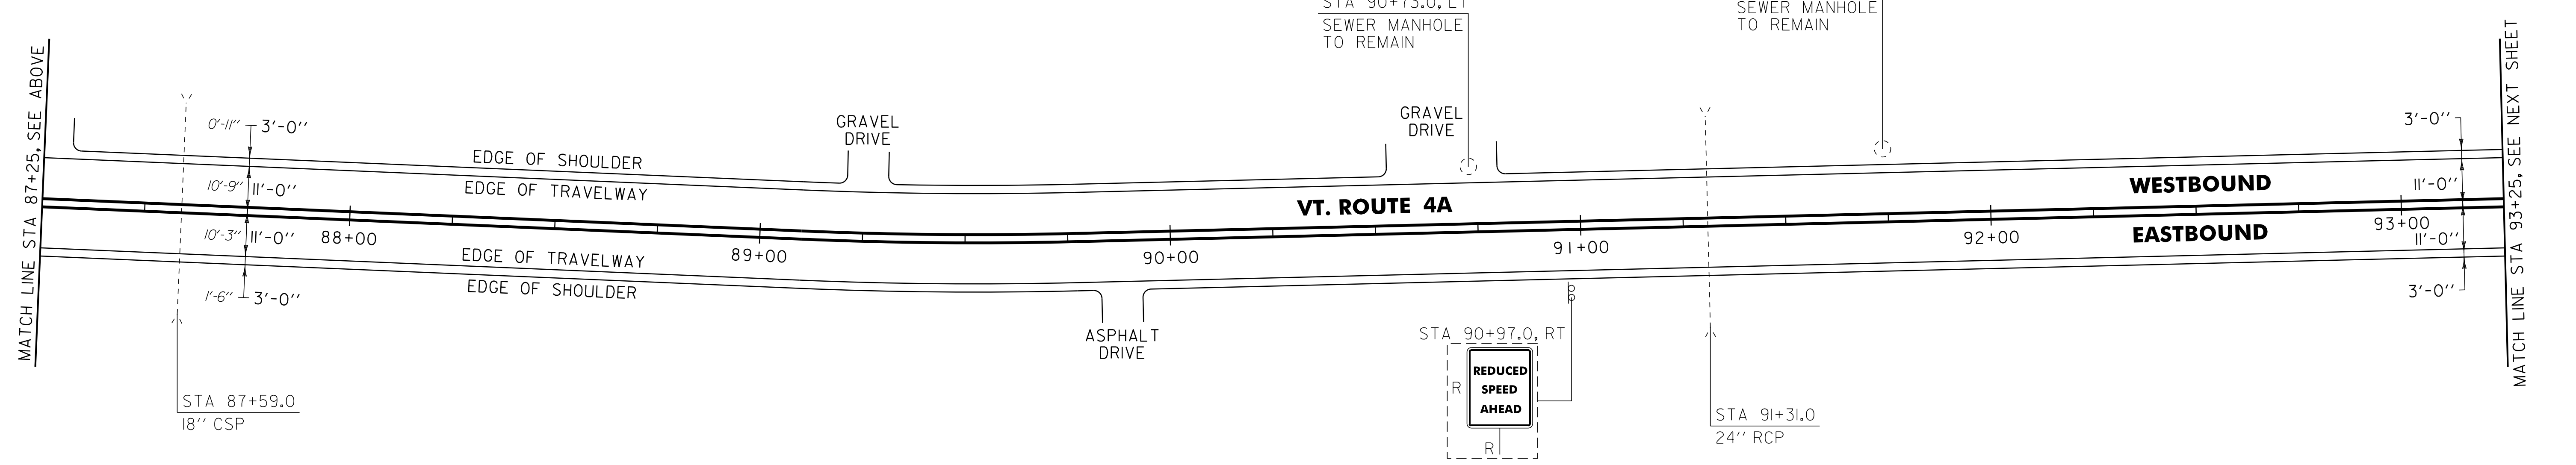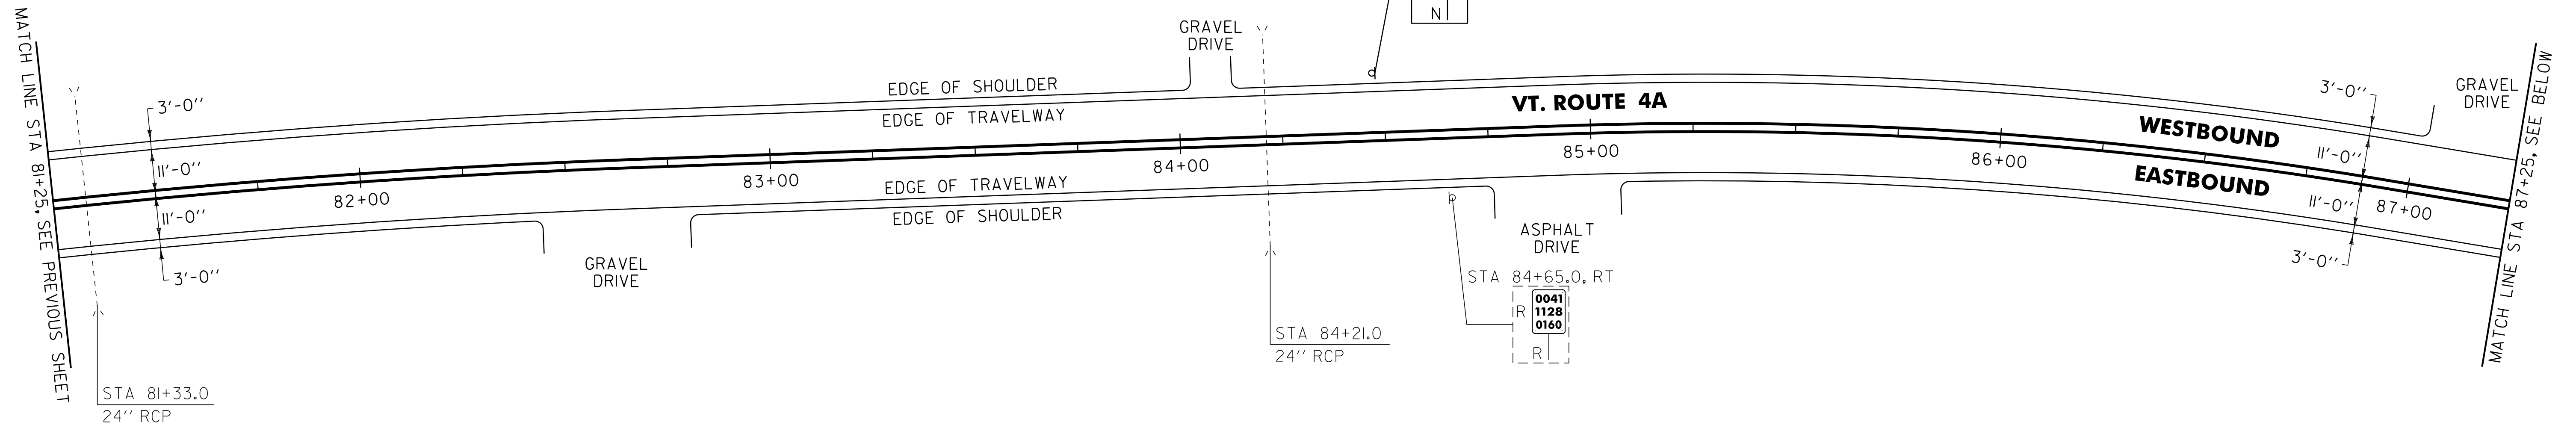

**SIGN LEGEND**  
R = REMOVE  
S = SALVAGE  
N = NEW  
RET = RETAIN  
B-B = BACK TO BACK  
EXISTING = - - - - -  
NEW = \_\_\_\_\_

**NOT TO SCALE**

<b>PROJECT LAYOUT SHEET #30</b>	PROJECT NAME: CASTLETON - WEST RUTLAND	PLOT DATE: 04-JUN-2013 09:14
	PROJECT NUMBER: STP 2705(1)	DRAWN BY: W.G.P.
	FILE NAME: p07cl68.dgn	CHECKED BY: D.E.G.
	DESIGNED BY: M.J.M.	SHEET 51 OF 152
	IPARM FILE: p07cl68130.i	