

646.402 DURABLE 4 INCH WHITE LINE, THERMOPLASTIC OR
 646.403 DURABLE 4 INCH WHITE LINE, EPOXY PAINT OR
 646.404 DURABLE 4 INCH WHITE LINE, POLYUREA
 (ALL LINES WILL INCLUDE EDGE LINE BREAKS AND
 RADIUS FOR TOWN HIGHWAYS)
 CASTLETON STATE HIGHWAY:
 STA 13+50.00 - STA 19+50.00 EDGE LINE LT & RT

646.412 DURABLE 4 INCH YELLOW LINE, THERMOPLASTIC OR
 646.413 DURABLE 4 INCH YELLOW LINE, EPOXY PAINT OR
 646.414 DURABLE 4 INCH YELLOW LINE, POLYUREA
 (ALL LINES WILL INCLUDE C/L BREAKS FOR
 TOWN HIGHWAYS) S=SOLID, D=DASHED
 CASTLETON STATE HIGHWAY:
 STA 13+50.00 - STA 19+50.00

646.422 DURABLE 6 INCH WHITE LINE, THERMOPLASTIC OR
 646.423 DURABLE 6 INCH WHITE LINE, EPOXY PAINT OR
 646.424 DURABLE 6 INCH WHITE LINE, POLYUREA
 (ALL LINES WILL INCLUDE EDGE LINE BREAKS AND
 RADIUS FOR TOWN HIGHWAYS)
 CASTLETON STATE HIGHWAY:
 STA 18+42.79 RT, RAMP B EDGE LINE
 STA 18+77.37 RT, RAMP C EDGE LINE

646.432 DURABLE 6 INCH YELLOW LINE, THERMOPLASTIC OR
 646.433 DURABLE 6 INCH YELLOW LINE, EPOXY PAINT OR
 646.434 DURABLE 6 INCH YELLOW LINE, POLYUREA
 (ALL LINES WILL INCLUDE C/L BREAKS FOR
 TOWN HIGHWAYS) S=SOLID, D=DASHED
 CASTLETON STATE HIGHWAY:
 STA 18+42.79 RAMP B, MEDIAN EDGE LINE RT
 STA 18+77.37 RAMP C, MEDIAN EDGE LINE RT

646.492 DURABLE LETTER OR SYMBOL, THERMOPLASTIC OR
 646.493 DURABLE LETTER OR SYMBOL, EPOXY PAINT
 CASTLETON STATE HIGHWAY:
 STA 18+77.77 RT RAMP C, "S,T,O,P" (4 EA)

646.602 TEMPORARY 4 INCH WHITE LINE, PAINT
 (ALL LINES WILL INCLUDE EDGE LINE BREAKS AND
 RADIUS FOR TOWN HIGHWAYS)
 CASTLETON STATE HIGHWAY:
 STA 13+50.00 - STA 19+50.00 EDGE LINE LT & RT

646.612 TEMPORARY 4 INCH YELLOW LINE, PAINT
 (ALL LINES WILL INCLUDE C/L BREAKS FOR
 TOWN HIGHWAYS) S=SOLID, D=DASHED
 CASTLETON STATE HIGHWAY:
 STA 13+50.00 - STA 19+50.00


646.682 TEMPORARY 24 INCH STOP BAR, PAINT
 CASTLETON STATE HIGHWAY:
 STA 18+69.12 RT RAMP C

646.492 TEMPORARY LETTER OR SYMBOL, PAINT
 CASTLETON STATE HIGHWAY:
 STA 18+77.77 RT RAMP C, "S,T,O,P" (8 EA)

646.81 PAINTED CURB
 CASTLETON STATE HIGHWAY:
 STA 18+42.79 RAMP B, RT (60.0 LF)
 STA 18+77.37 RAMP C, RT (60.0 LF)

675.50 REMOVING SIGNS
 AS SHOWN - 4

675.60 ERECTING SALVAGED SIGNS
 AS SHOWN - 1

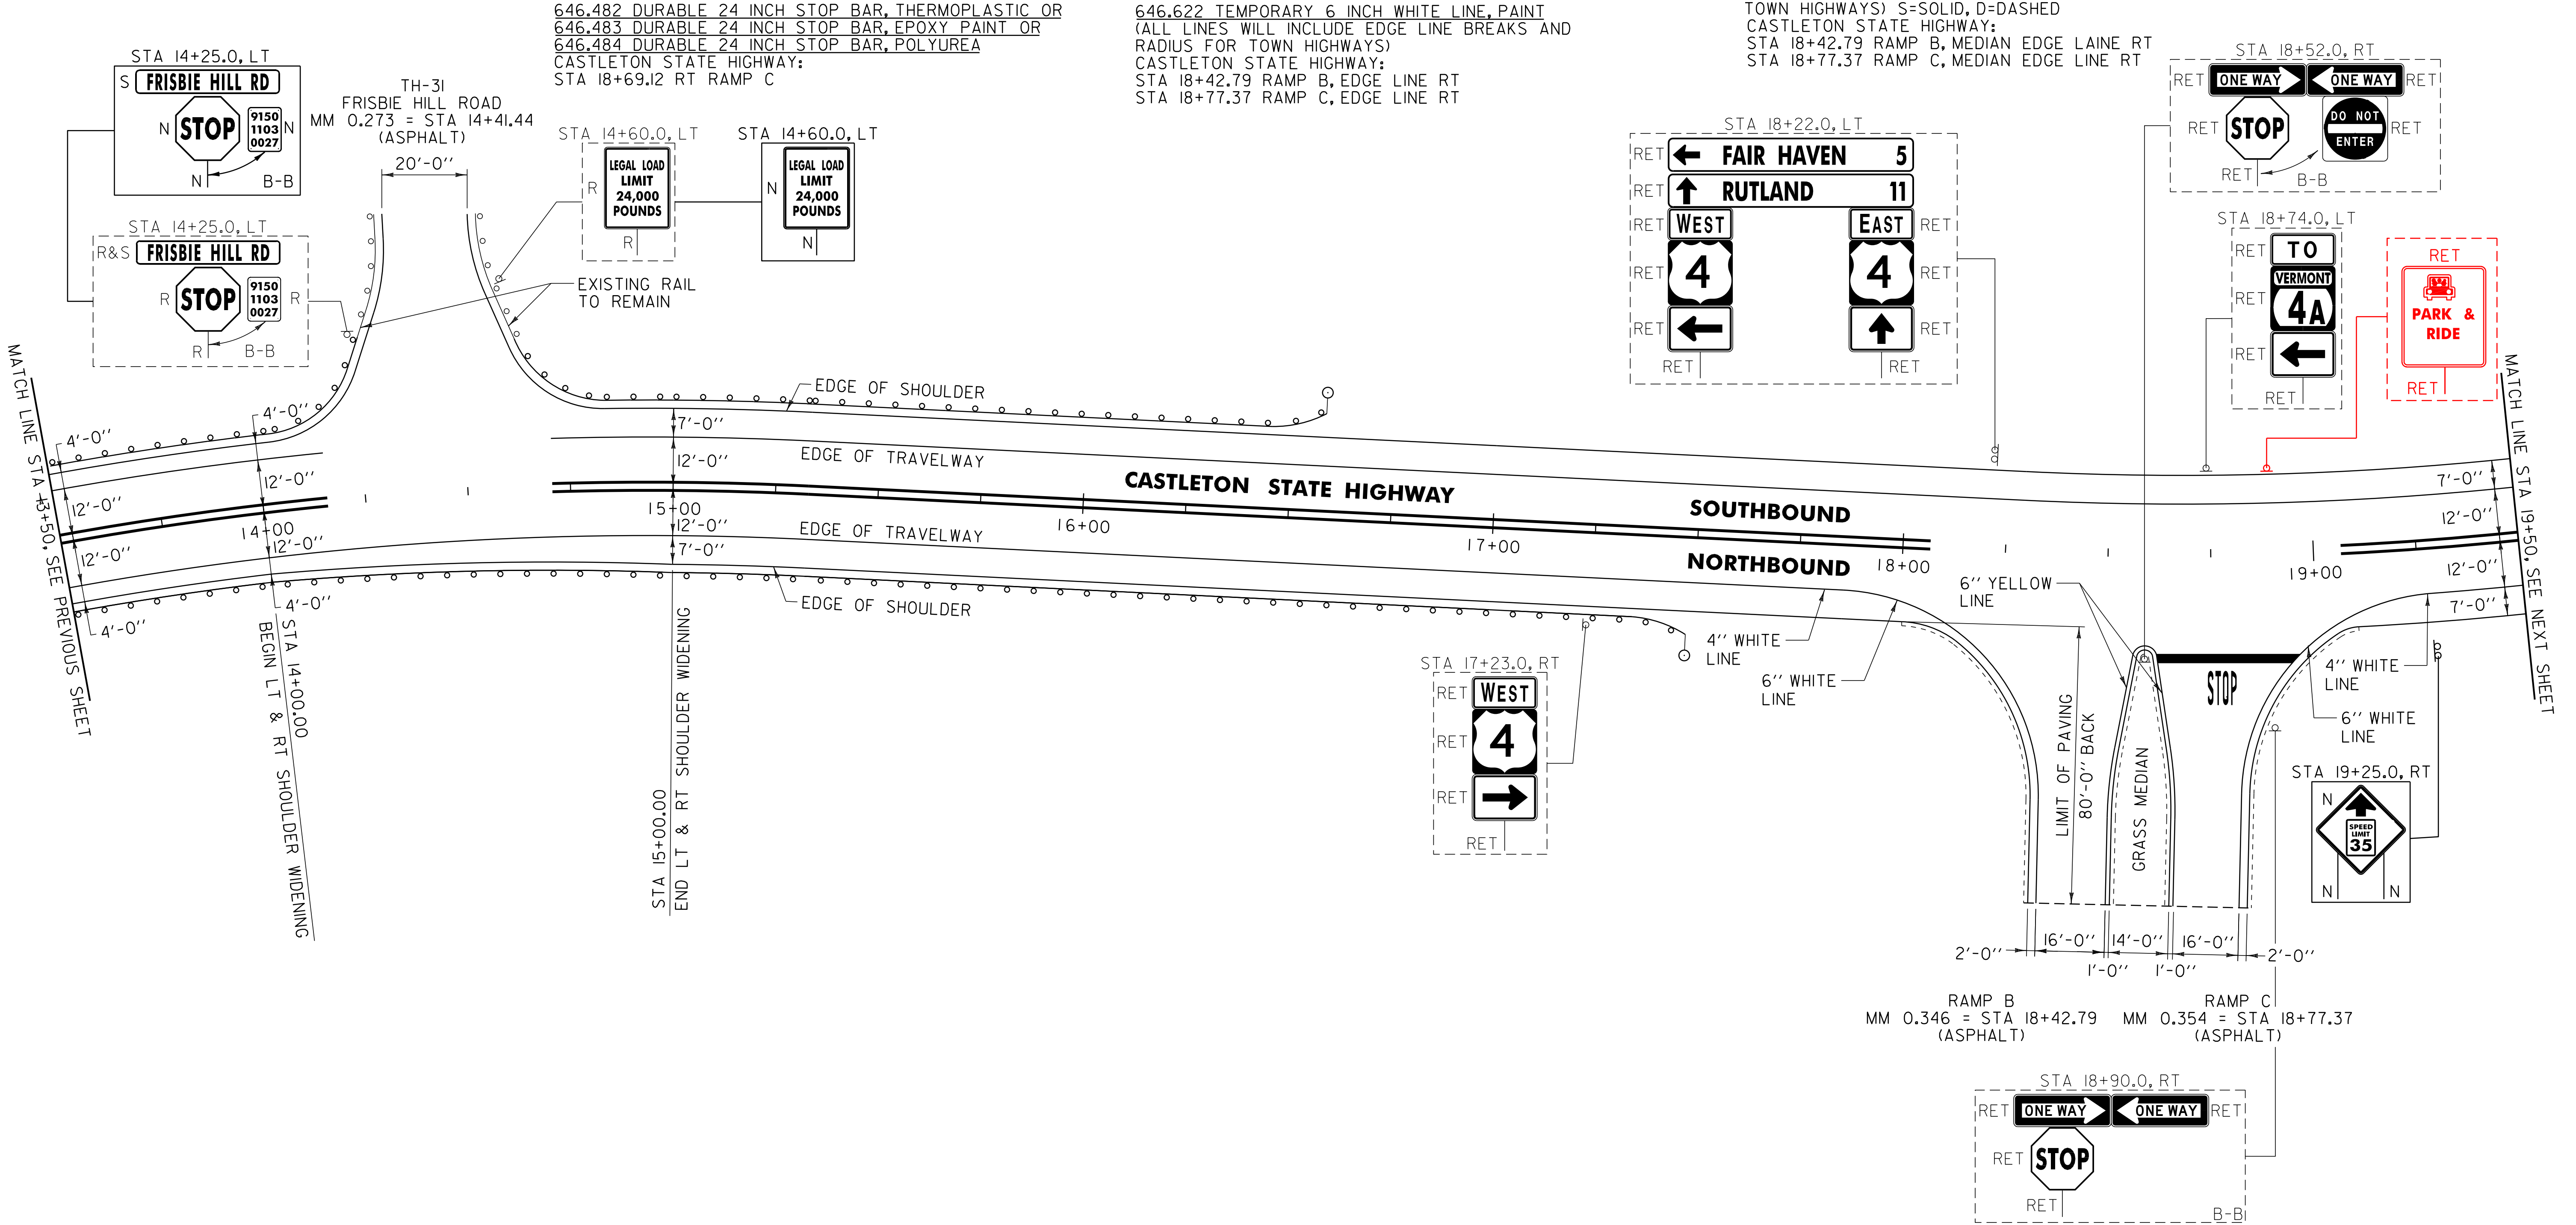

621.20 STEEL BEAM GUARDRAIL, GALVANIZED
 CASTLETON STATE HIGHWAY:
 STA 13+50.0 - STA 14+17.0 LT (104.5 LF)
 STA 13+50.0 - STA 17+52.5 RT (402.5 LF)
 STA 14+70.0 - STA 16+59.5 LT (227.0 LF)

621.80 REMOVAL AND DISPOSAL OF GUARDRAIL
 CASTLETON STATE HIGHWAY:
 STA 13+50.0 - STA 14+17.0 LT (104.5 LF)
 STA 13+50.0 - STA 17+43.0 RT (393.0 LF)
 STA 14+70.0 - STA 16+58.0 LT (225.5 LF)

621.60 ANCHOR FOR STEEL BEAM RAIL
 CASTLETON STATE HIGHWAY:
 STA 16+53.0 LT
 STA 17+46.0 RT

676.10 DELINEATOR WITH STEEL POST
 CASTLETON STATE HIGHWAY:
 STA 16+59.5 LT
 STA 17+52.5 RT

NOTE:
 1. PAVING LIMIT ON ALL TOWN HIGHWAYS SHALL BE MEASURED 25 FT BACK FROM CASTLETON STATE HIGHWAY EDGE OF SHOULDER UNLESS DENOTED OTHERWISE ON THE PLANS OR AS DIRECTED BY THE RESIDENT ENGINEER.

SIGN LEGEND
 R = REMOVE
 S = SALVAGE
 N = NEW
 RET = RETAIN
 B-B = BACK TO BACK
 EXISTING = - - - - -
 NEW = _____

NOT TO SCALE

PROJECT LAYOUT SHEET #34	PROJECT NAME: CASTLETON - WEST RUTLAND	FILE NAME: p07cl68.dgn	PLOT DATE: 04-JUN-2013 09:14
	PROJECT NUMBER: STP 2705(1)	PROJECT LEADER: D.E.G.	DRAWN BY: W.G.P.
		DESIGNED BY: M.J.M.	CHECKED BY: D.E.G.
	IPARM FILE: p07cl68134.i		SHEET 55 OF 152