

646.402 DURABLE 4 INCH WHITE LINE, THERMOPLASTIC OR
 646.403 DURABLE 4 INCH WHITE LINE, EPOXY PAINT OR
 646.404 DURABLE 4 INCH WHITE LINE, POLYUREA
 (ALL LINES WILL INCLUDE EDGE LINE BREAKS AND
 RADIUS FOR TOWN HIGHWAYS)
 CASTLETON:
 STA 153+25.00 - STA 159+25.00 EDGE LINE LT & RT


646.412 DURABLE 4 INCH YELLOW LINE, THERMOPLASTIC OR
 646.413 DURABLE 4 INCH YELLOW LINE, EPOXY PAINT OR
 646.414 DURABLE 4 INCH YELLOW LINE, POLYUREA
 (ALL LINES WILL INCLUDE C/L BREAKS FOR
 TOWN HIGHWAYS) S=SOLID, D=DASHED
 CASTLETON:
 STA 153+25.00 - STA 159+25.00 LT S RT S

646.602 TEMPORARY 4 INCH WHITE LINE, PAINT
 (ALL LINES WILL INCLUDE EDGE LINE BREAKS AND
 RADIUS FOR TOWN HIGHWAYS)
 CASTLETON:
 STA 153+25.00 - STA 159+25.00 EDGE LINE LT & RT

646.612 TEMPORARY 4 INCH YELLOW LINE, PAINT
 (ALL LINES WILL INCLUDE C/L BREAKS FOR
 TOWN HIGHWAYS) S=SOLID, D=DASHED
 CASTLETON:
 STA 153+25.00 - STA 159+25.00 LT S RT S

646.442 DURABLE 8 INCH WHITE LINE, THERMOPLASTIC OR
 646.443 DURABLE 8 INCH WHITE LINE, EPOXY PAINT OR
 646.444 DURABLE 8 INCH WHITE LINE, POLYUREA
 CASTLETON:
 STA 156+11.0 - STA 156+23.0 FIRE HYDRANT NO PARKING ZONE LT

675.50 REMOVING SIGNS
 AS SHOWN - + 0
 SIGN NOT THERE

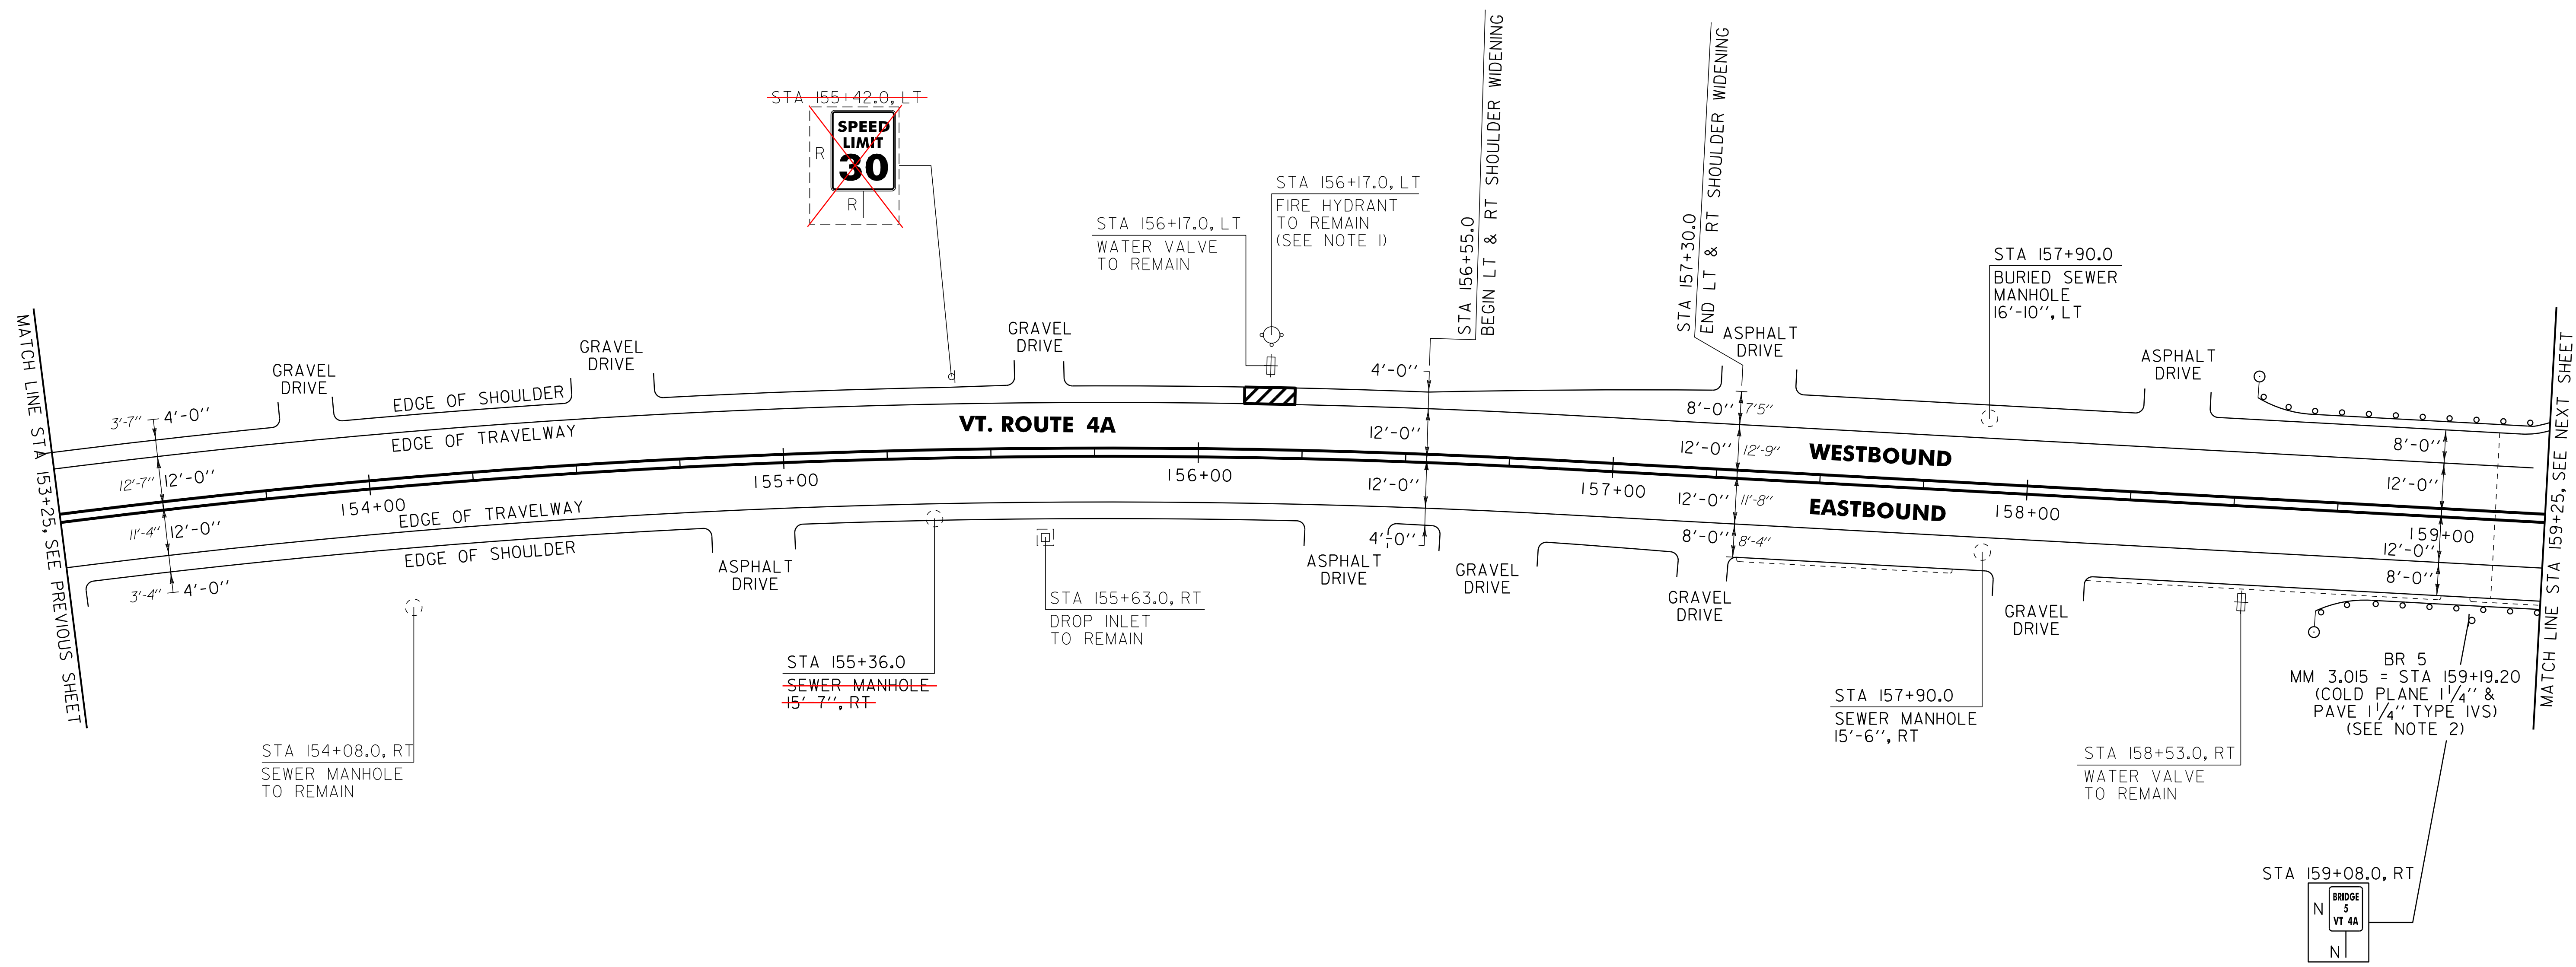

525.10 REMOVAL OF EXISTING RAILING
 CASTLETON:
 STA 159+07.5 - STA 159+25.0 LT (17.5 LF)
 STA 159+07.5 - STA 159+25.0 RT (17.5 LF)

525.50 BRIDGE RAILING REPAIR, TYPE I
 CASTLETON:
 STA 159+07.5 - STA 159+25.0 LT (17.5 LF)
 STA 159+07.5 - STA 159+25.0 RT (17.5 LF)

604.42 CHANGING ELEVATION OF SEWER MANHOLES
 CASTLETON:
 STA 155+36.0 RT
 STA 157+90.0 RT
 STA 157+90.0 LT

621.20 STEEL BEAM GUARDRAIL, GALVANIZED
 CASTLETON:
 STA 158+55.5 - STA 158+82.5 LT (27.0 LF)
 STA 158+68.0 - STA 158+82.5 RT (14.5 LF)

621.21 HD STEEL BEAM GUARDRAIL, GALVANIZED
 CASTLETON:
 STA 158+82.5 - STA 159+07.5 LT (32.5 LF)
 STA 158+82.5 - STA 159+07.5 RT (32.5 LF)

621.60 ANCHOR FOR STEEL BEAM RAIL
 CASTLETON:
 STA 158+62.0 LT
 STA 158+74.5 RT

621.80 REMOVAL AND DISPOSAL OF GUARDRAIL
 CASTLETON:
 STA 158+57.0 - STA 159+07.5 LT (50.5 LF)
 STA 158+71.0 - STA 159+07.5 RT (36.5 LF)

676.10 DELINEATOR WITH STEEL POST
 CASTLETON:
 STA 158+55.5 LT
 STA 158+68.0 RT

NOTES:
 1. SEE SHEET 8 FOR FIRE HYDRANT PAVEMENT MARKING DETAIL.
 2. SEE SHEET 118 FOR BR 5 DETAIL.

SIGN LEGEND
 R = REMOVE
 S = SALVAGE
 N = NEW
 RET = RETAIN
 B-B = BACK TO BACK
 EXISTING = - - - - -
 NEW = _____

PROJECT LAYOUT SHEET #2	NOT TO SCALE	
	PROJECT NAME: CASTLETON	PLOT DATE: 04-JUN-2013 09:14
	PROJECT NUMBER: STP 2908(1)	DRAWN BY: W.G.P.
	FILE NAME: p10c210.dgn PROJECT LEADER: D.E.G. DESIGNED BY: M.J.M. IPARM FILE: p10c210102.i	CHECKED BY: D.E.G. SHEET 99 OF 152