

646.402 DURABLE 4 INCH WHITE LINE, THERMOPLASTIC OR
 646.403 DURABLE 4 INCH WHITE LINE, EPOXY PAINT OR
 646.404 DURABLE 4 INCH WHITE LINE, POLYUREA
 (ALL LINES WILL INCLUDE EDGE LINE BREAKS AND
 RADIUS FOR TOWN HIGHWAYS)
 CASTLETON:
 STA 159+25.00 - STA 165+25.00 EDGE LINE LT & RT


646.412 DURABLE 4 INCH YELLOW LINE, THERMOPLASTIC OR
 646.413 DURABLE 4 INCH YELLOW LINE, EPOXY PAINT OR
 646.414 DURABLE 4 INCH YELLOW LINE, POLYUREA
 (ALL LINES WILL INCLUDE C/L BREAKS FOR
 TOWN HIGHWAYS) S=SOLID, D=DASHED
 CASTLETON:
 STA 159+25.00 - STA 165+25.00 LT S RT S

646.602 TEMPORARY 4 INCH WHITE LINE, PAINT
 (ALL LINES WILL INCLUDE EDGE LINE BREAKS AND
 RADIUS FOR TOWN HIGHWAYS)
 CASTLETON:
 STA 159+25.00 - STA 165+25.00 LT S RT S

646.612 TEMPORARY 4 INCH YELLOW LINE, PAINT
 (ALL LINES WILL INCLUDE C/L BREAKS FOR
 TOWN HIGHWAYS) S=SOLID, D=DASHED
 CASTLETON:
 STA 159+25.00 - STA 165+25.00 LT S RT S

646.442 DURABLE 8 INCH WHITE LINE, THERMOPLASTIC OR
 646.443 DURABLE 8 INCH WHITE LINE, EPOXY PAINT OR
 646.444 DURABLE 8 INCH WHITE LINE, POLYUREA
 CASTLETON:
 STA 161+00.0 - STA 161+12.0 FIRE HYDRANT NO PARKING ZONE LT

675.50 REMOVING SIGNS
 AS SHOWN - 57

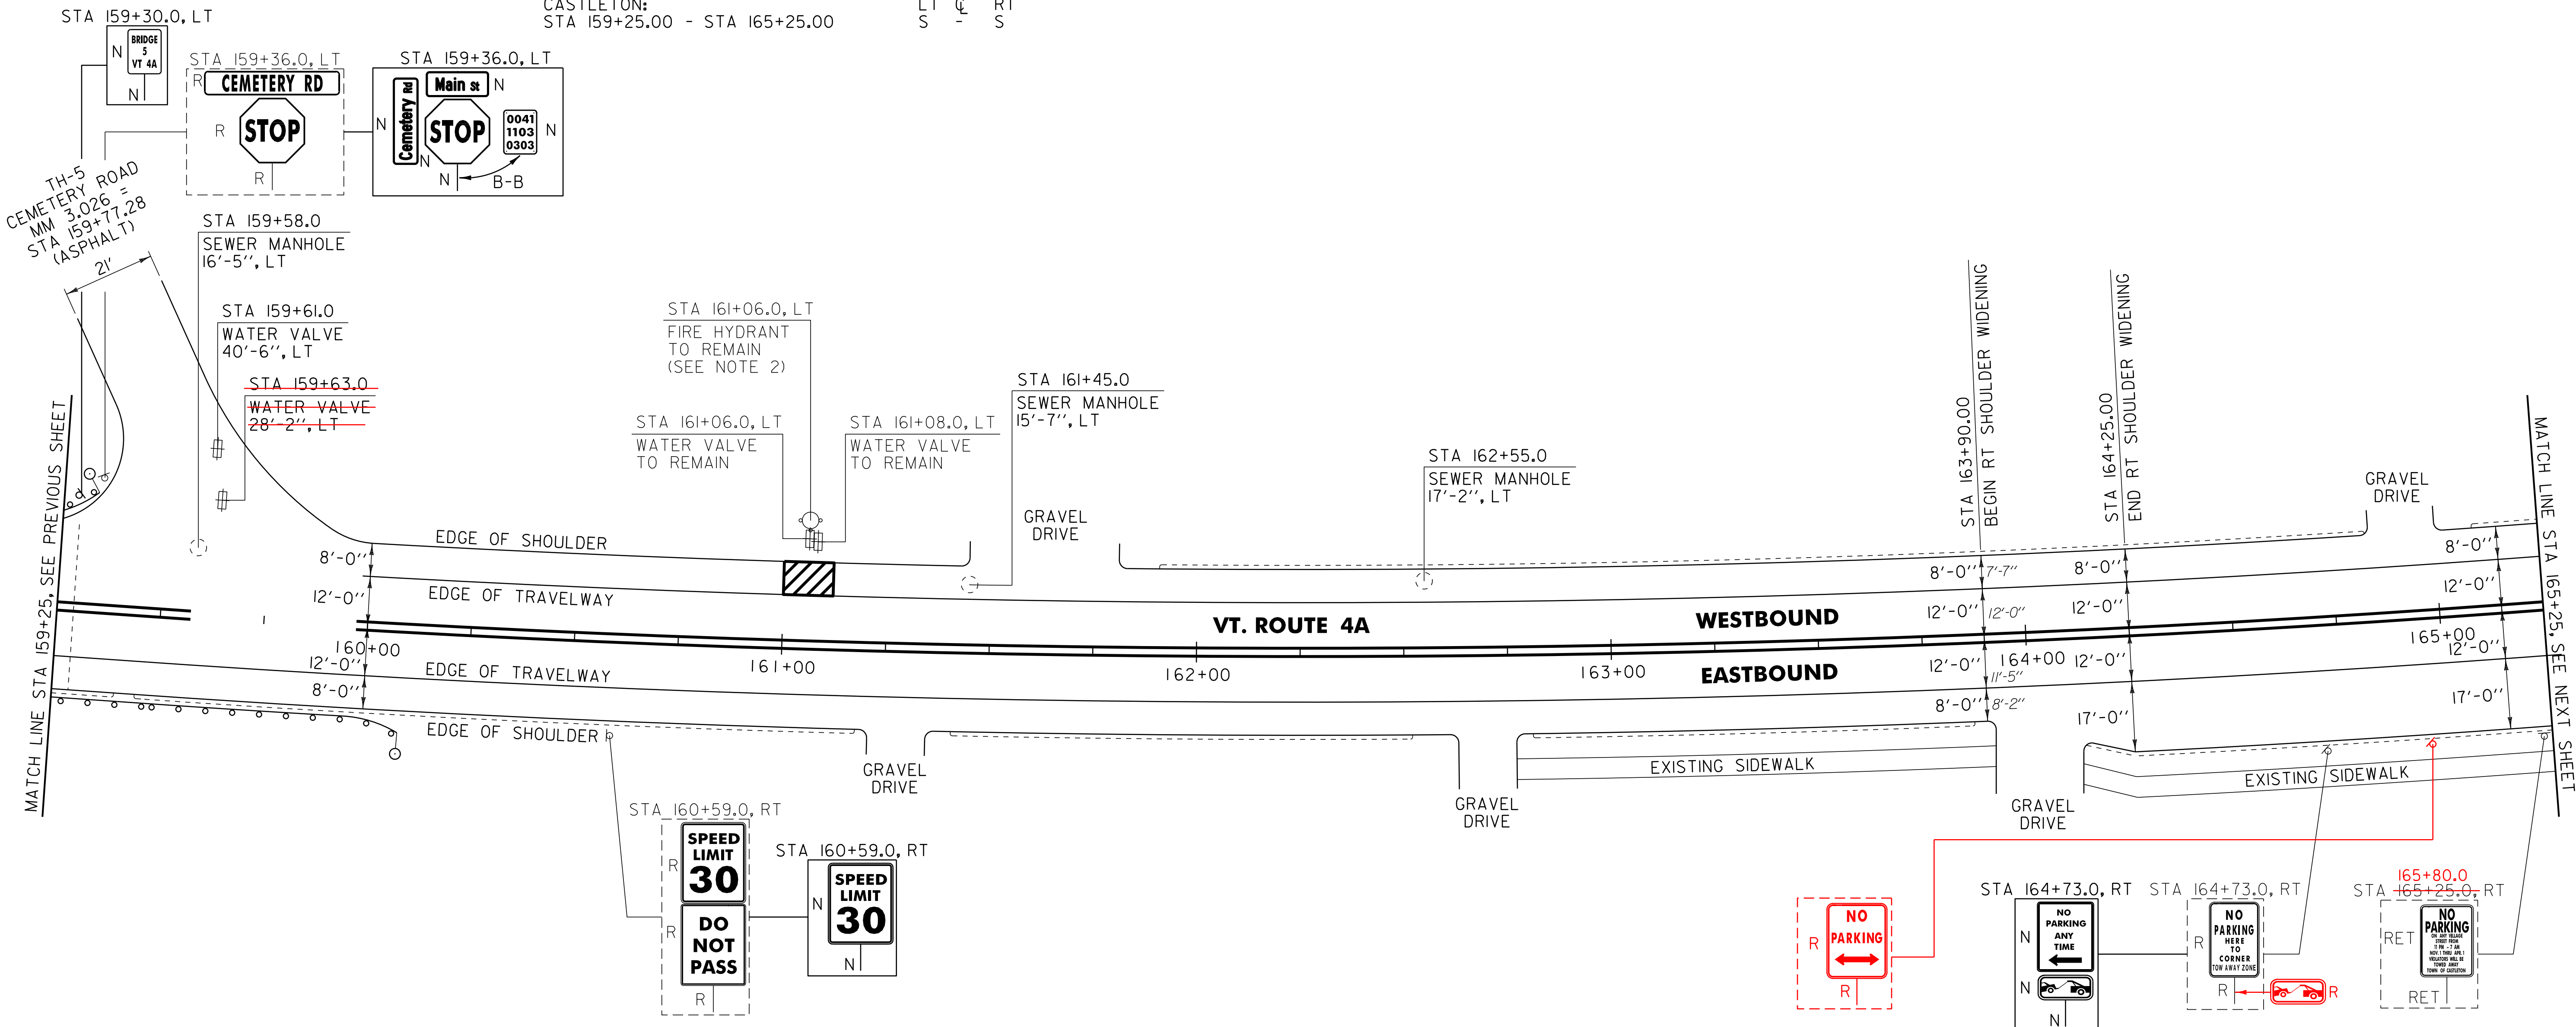

525.10 REMOVAL OF EXISTING RAILING
 CASTLETON:
 STA 159+25.0 - STA 159+32.5 LT (7.5 LF)
 STA 159+25.0 - STA 159+32.5 RT (7.5 LF)

525.50 BRIDGE RAILING REPAIR, TYPE I
 CASTLETON:
 STA 159+25.0 - STA 159+32.5 LT (7.5 LF)
 STA 159+25.0 - STA 159+32.5 RT (7.5 LF)

604.42 CHANGING ELEVATION OF SEWER MANHOLES
 CASTLETON:
 STA 159+58.0 LT
 STA 161+45.0 LT
 STA 162+55.0 LT

621.20 STEEL BEAM GUARDRAIL, GALVANIZED
 CASTLETON:
 STA 159+32.5 - STA 159+47.0 LT (14.5 LF)
 STA 159+57.5 - STA 160+09.5 RT (52.0 LF)

621.21HD STEEL BEAM GUARDRAIL, GALVANIZED
 CASTLETON:
 STA 159+32.5 - STA 159+57.5 RT (32.5 LF)

621.60 ANCHOR FOR STEEL BEAM RAIL
 CASTLETON:
 STA 159+40.5 LT
 STA 160+03.0 RT

621.80 REMOVAL AND DISPOSAL OF GUARDRAIL
 CASTLETON:
 STA 159+32.5 - STA 159+35.0 LT (2.5 LF)
 STA 159+32.5 - STA 160+10.0 RT (77.5 LF)

629.20 ADJUST ELEVATION OF VALVE BOX
 CASTLETON:
 STA 159+61.0 LT
 STA 159+63.0 LT

676.10 DELINEATOR WITH STEEL POST
 CASTLETON:
 STA 159+47.0 LT
 STA 160+09.5 RT

NOTES:
 1. PAVING LIMIT ON ALL TOWN HIGHWAYS SHALL BE MEASURED 25 FT BACK FROM VT. ROUTE 4A EDGE OF SHOULDER UNLESS DENOTED OTHERWISE ON THE PLANS OR AS DIRECTED BY THE RESIDENT ENGINEER.
 2. SEE SHEET 8 FOR FIRE HYDRANT PAVEMENT MARKING DETAIL.

SIGN LEGEND
 R = REMOVE
 S = SALVAGE
 N = NEW
 RET = RETAIN
 B-B = BACK TO BACK
 EXISTING = _____
 NEW = _____

PROJECT LAYOUT SHEET #3	NOT TO SCALE	
	PROJECT NAME: CASTLETON	PROJECT NUMBER: STP 2908(1)
	FILE NAME: p10c210.dgn	PLOT DATE: 04-JUN-2013 09:14
	PROJECT LEADER: D.E.G. DESIGNED BY: M.J.M. IPARM FILE: p10c210I03.i	DRAWN BY: W.G.P. CHECKED BY: D.E.G. SHEET 100 OF 152