

646.402 DURABLE 4 INCH WHITE LINE, THERMOPLASTIC OR  
 646.403 DURABLE 4 INCH WHITE LINE, EPOXY PAINT OR  
 646.404 DURABLE 4 INCH WHITE LINE, POLYUREA  
 (ALL LINES WILL INCLUDE EDGE LINE BREAKS AND  
 RADIUS FOR TOWN HIGHWAYS)  
 CASTLETON:  
 STA 80+78.40 - STA 86+50.00 EDGE LINE LT & RT  
 STA 80+78.40 - STA 81+40.00 SOLID LANE LINE LT  
 STA 81+40.00 - STA 83+20.00 DOTTED LANE LINE LT

646.412 DURABLE 4 INCH YELLOW LINE, THERMOPLASTIC OR  
 646.413 DURABLE 4 INCH YELLOW LINE, EPOXY PAINT OR  
 646.414 DURABLE 4 INCH YELLOW LINE, POLYUREA  
 (ALL LINES WILL INCLUDE C/L BREAKS FOR  
 TOWN HIGHWAYS) S=SOLID, D=DASHED  
 CASTLETON:  
 STA 80+78.40 - STA 86+50.00

646.602 TEMPORARY 4 INCH WHITE LINE, PAINT  
 (ALL LINES WILL INCLUDE EDGE LINE BREAKS AND  
 RADIUS FOR TOWN HIGHWAYS)  
 CASTLETON:  
 STA 80+78.40 - STA 86+50.00 EDGE LINE LT & RT  
 STA 80+78.40 - STA 81+40.00 SOLID LANE LINE LT  
 STA 81+40.00 - STA 83+20.00 DOTTED LANE LINE LT

646.612 TEMPORARY 4 INCH YELLOW LINE, PAINT  
 (ALL LINES WILL INCLUDE C/L BREAKS FOR  
 TOWN HIGHWAYS) S=SOLID, D=DASHED  
 CASTLETON:  
 STA 80+78.40 - STA 86+50.00


646.442 DURABLE 8 INCH WHITE LINE, THERMOPLASTIC OR  
 646.443 DURABLE 8 INCH WHITE LINE, EPOXY PAINT OR  
 646.444 DURABLE 8 INCH WHITE LINE, POLYUREA  
 CASTLETON:  
 STA 84+57.0 - STA 84+69.0 FIRE HYDRANT NO PARKING ZONE RT

646.492 DURABLE LETTER OR SYMBOL, THERMOPLASTIC OR  
 646.493 DURABLE LETTER OR SYMBOL, EPOXY PAINT  
 CASTLETON:  
 STA 81+33.50 LT ARROWS (2 EA)  
 STA 81+35.75 LT ARROW (1EA)  
 STA 80+80.0 LT ARROWS (3 EA)

646.692 TEMPORARY LETTER OR SYMBOL, PAINT  
 CASTLETON:  
 STA 81+33.50 LT ARROWS (4 EA)  
 STA 81+35.75 LT ARROW (2 EA)

646.482 DURABLE 24 IN STOP BAR, THERMOPLASTIC  
 CASTLETON:  
 STA 80+70 LT, VT 30 @ VT 4A INTERSECTION

675.50 REMOVING SIGNS  
 AS SHOWN - + 0

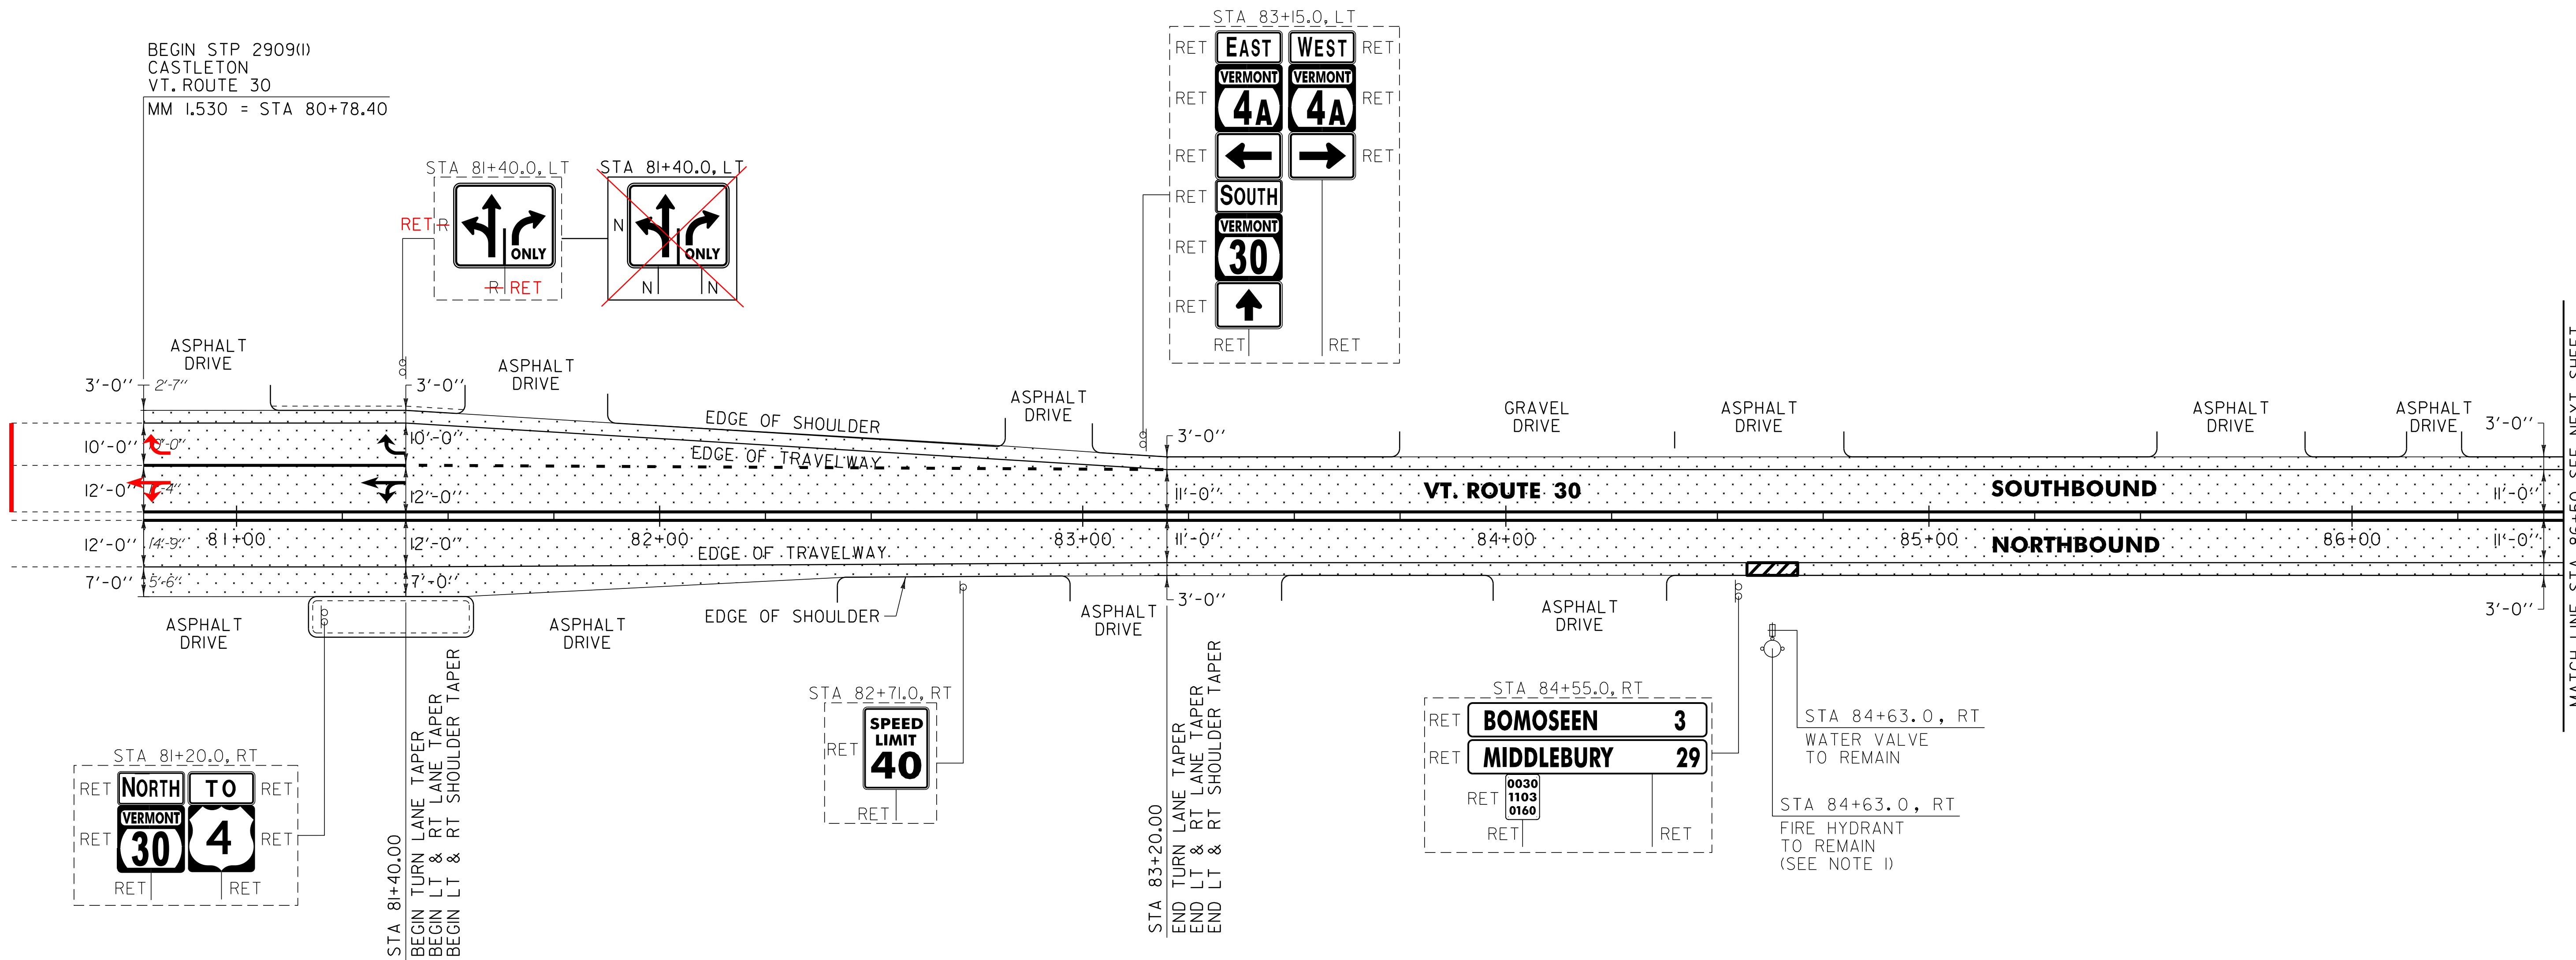

NOTE:  
 I. SEE SHEET 8 FOR FIRE HYDRANT PAVEMENT MARKING DETAIL.



SIGN LEGEND  
 R = REMOVE  
 S = SALVAGE  
 N = NEW  
 RET = RETAIN  
 B-B = BACK TO BACK  
 EXISTING = - - - - -  
 NEW = \_\_\_\_\_

NOT TO SCALE

<b>PROJECT LAYOUT SHEET #1</b>	PROJECT NAME: CASTLETON	PLOT DATE: 04-JUN-2013 09:11
	PROJECT NUMBER: STP 2909(1)	DRAWN BY: W.G.P.
	FILE NAME: p10c212.dgn	CHECKED BY: D.E.G.
	DESIGNED BY: M.J.M.	SHEET 129 OF 152