

646.402 DURABLE 4 INCH WHITE LINE, THERMOPLASTIC OR  
 646.403 DURABLE 4 INCH WHITE LINE, EPOXY PAINT OR  
 646.404 DURABLE 4 INCH WHITE LINE, POLYUREA  
 (ALL LINES WILL INCLUDE EDGE LINE BREAKS AND  
 RADIUS FOR TOWN HIGHWAYS)  
 CASTLETON:  
 STA 86+50.00 - STA 92+50.00 EDGE LINE LT & RT

646.412 DURABLE 4 INCH YELLOW LINE, THERMOPLASTIC OR  
 646.413 DURABLE 4 INCH YELLOW LINE, EPOXY PAINT OR  
 646.414 DURABLE 4 INCH YELLOW LINE, POLYUREA  
 (ALL LINES WILL INCLUDE C/L BREAKS FOR  
 TOWN HIGHWAYS) S=SOLID, D=DASHED  
 CASTLETON:  
 STA 86+50.00 - STA 92+50.00 LT S RT S  
 STA 88+07.04 DOUBLE SOLID LT, TH-71

646.602 TEMPORARY 4 INCH WHITE LINE, PAINT  
 (ALL LINES WILL INCLUDE EDGE LINE BREAKS AND  
 RADIUS FOR TOWN HIGHWAYS)  
 CASTLETON:  
 STA 86+50.00 - STA 92+50.00 LT S RT S  
 STA 88+07.04 DOUBLE SOLID LT, TH-71


646.612 TEMPORARY 4 INCH YELLOW LINE, PAINT  
 (ALL LINES WILL INCLUDE C/L BREAKS FOR  
 TOWN HIGHWAYS) S=SOLID, D=DASHED  
 CASTLETON:  
 STA 86+50.00 - STA 92+50.00 LT S RT S  
 STA 88+07.04 DOUBLE SOLID LT, TH-71

646.492 DURABLE LETTER OR SYMBOL, THERMOPLASTIC OR  
 646.493 DURABLE LETTER OR SYMBOL, EPOXY PAINT  
 CASTLETON:  
 STA 88+07.04 LT, TH-71 "S,T,O,P" (4 EA)

646.482 DURABLE 24 INCH STOP BAR, THERMOPLASTIC OR  
 646.483 DURABLE 24 INCH STOP BAR, EPOXY PAINT OR  
 646.484 DURABLE 24 INCH STOP BAR, POLYUREA  
 CASTLETON:  
 STA 88+07.04 LT, TH-71

646.692 TEMPORARY LETTER OR SYMBOL, PAINT  
 CASTLETON:  
 STA 88+07.04 LT, TH-71, "S,T,O,P" (8 EA)

646.682 TEMPORARY 24 INCH STOP BAR, PAINT  
 CASTLETON:  
 STA 88+07.04 LT, TH-71

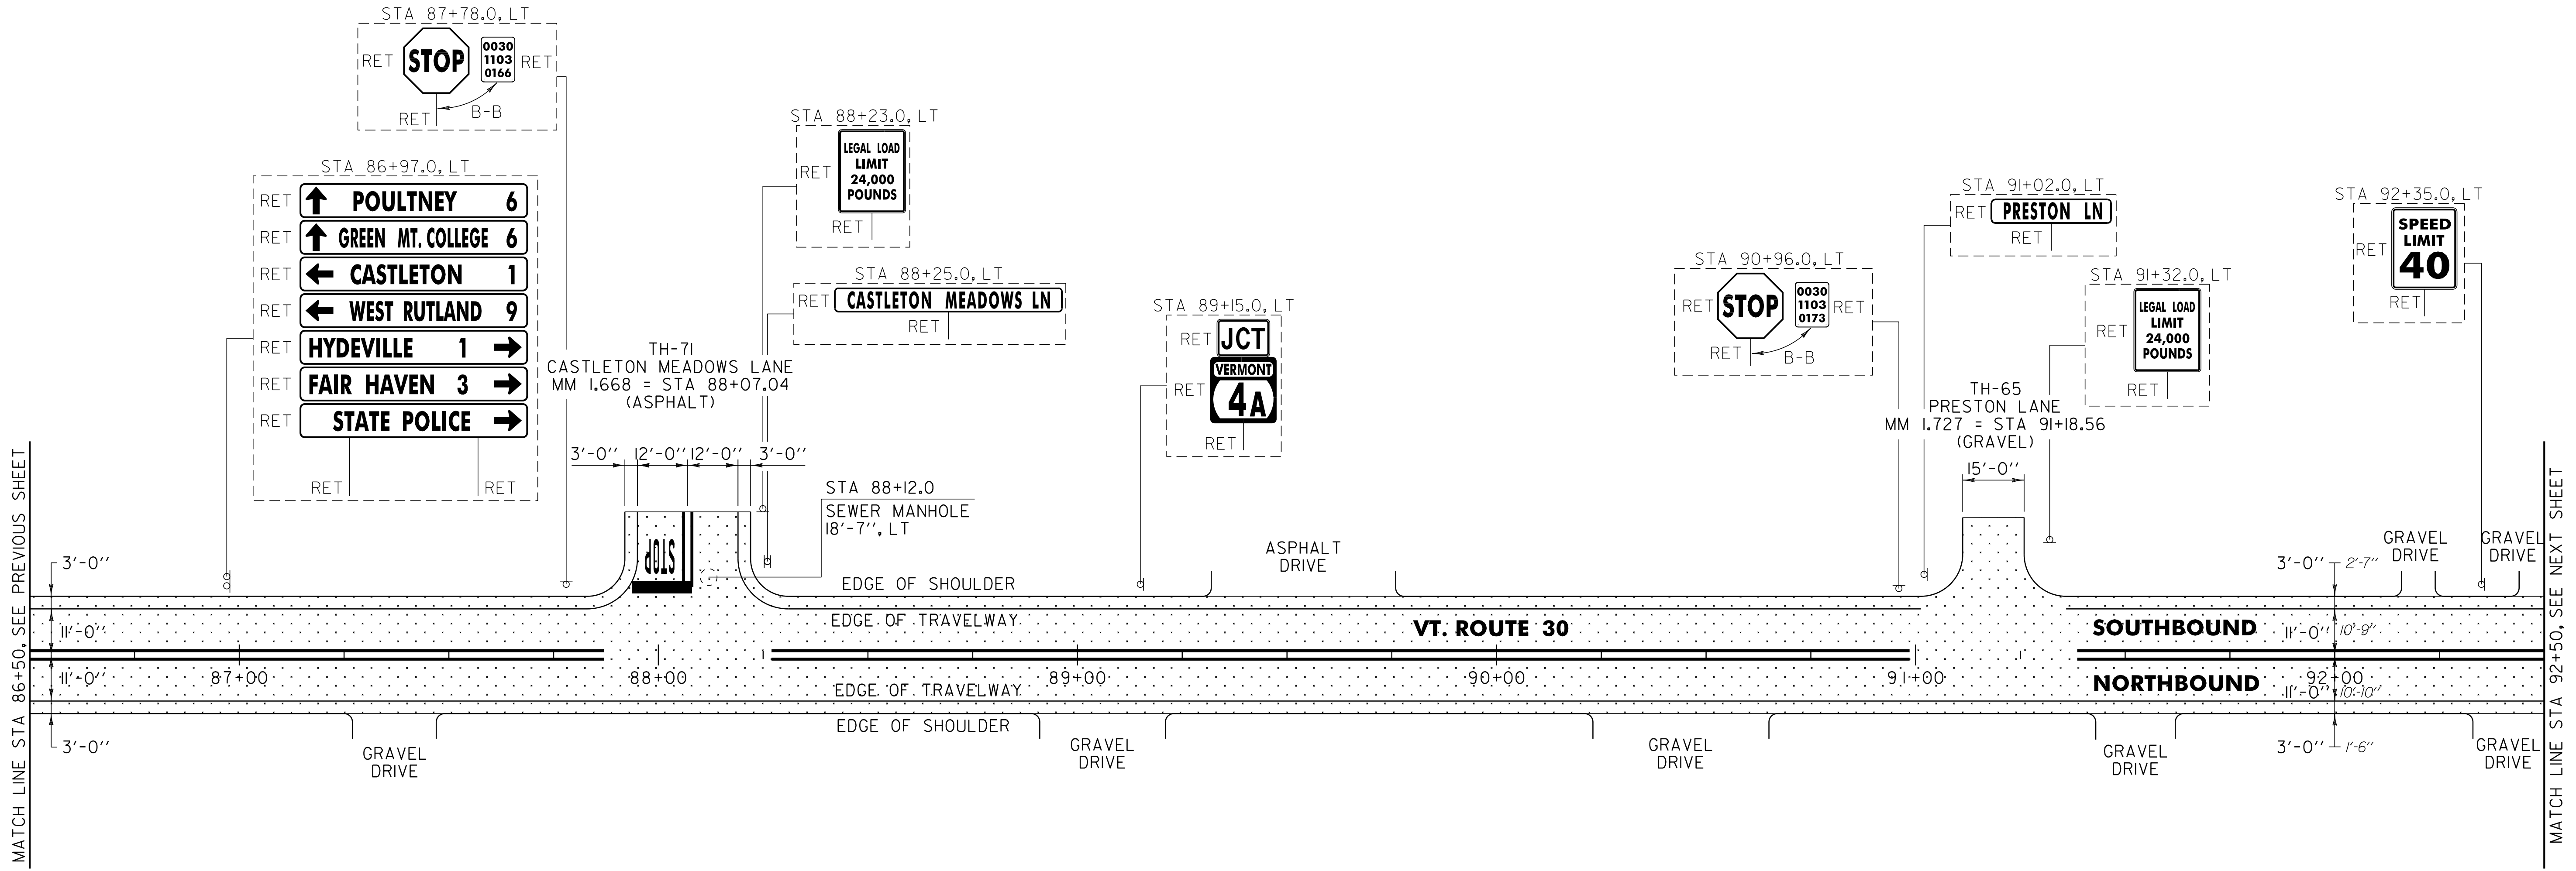

MATCH LINE STA 86+50. SEE PREVIOUS SHEET

MATCH LINE STA 92+50. SEE NEXT SHEET

NOTE:  
 1. PAVING LIMIT ON ALL TOWN HIGHWAYS SHALL BE MEASURED 25 FT BACK FROM VT. ROUTE 30 EDGE OF SHOULDER UNLESS DENOTED OTHERWISE ON THE PLANS OR AS DIRECTED BY THE RESIDENT ENGINEER.

604.42 CHANGING ELEVATION OF SEWER MANHOLES  
 STA 88+12.0 LT



**SIGN LEGEND**  
 R = REMOVE  
 S = SALVAGE  
 N = NEW  
 RET = RETAIN  
 B-B = BACK TO BACK  
 EXISTING = - - - - -  
 NEW = \_\_\_\_\_

<b>NOT TO SCALE</b>	
<b>PROJECT LAYOUT SHEET #2</b>	PROJECT NAME: CASTLETON
	PROJECT NUMBER: STP 2909(1)
	FILE NAME: p10c212.dgn
	PROJECT LEADER: D.E.G.
DESIGNED BY: M.J.M.	PLOT DATE: 04-JUN-2013 09:11
IPARM FILE: p10c212102.i	DRAWN BY: W.G.P.
	CHECKED BY: D.E.G.
	SHEET 130 OF 152