


646.402 DURABLE 4 INCH WHITE LINE, THERMOPLASTIC OR
 646.403 DURABLE 4 INCH WHITE LINE, EPOXY PAINT OR
 646.404 DURABLE 4 INCH WHITE LINE, POLYUREA
 (ALL LINES WILL INCLUDE EDGE LINE BREAKS AND
 RADIUS FOR TOWN HIGHWAYS)
 CASTLETON:
 STA 98+50.00 - STA 102+50.00 EDGE LINE LT & RT

646.412 DURABLE 4 INCH YELLOW LINE, THERMOPLASTIC OR
 646.413 DURABLE 4 INCH YELLOW LINE, EPOXY PAINT OR
 646.414 DURABLE 4 INCH YELLOW LINE, POLYUREA
 (ALL LINES WILL INCLUDE C/L BREAKS FOR
 TOWN HIGHWAYS) S=SOLID, D=DASHED
 CASTLETON:
 STA 98+50.00 - STA 100+50.00 S - S LT C RT
 STA 100+50.00 - STA 102+00.00 DOUBLE SOLID MEDIAN LT
 STA 100+50.00 - STA 102+50.00 DOUBLE SOLID MEDIAN RT
 STA 102+00.00 - STA 102+50.00 MEDIAN EDGE LINE LT

646.602 TEMPORARY 4 INCH WHITE LINE, PAINT
 (ALL LINES WILL INCLUDE EDGE LINE BREAKS AND
 RADIUS FOR TOWN HIGHWAYS)
 CASTLETON:
 STA 98+50.00 - STA 102+50.00 EDGE LINE LT & RT

646.612 TEMPORARY 4 INCH YELLOW LINE, PAINT
 (ALL LINES WILL INCLUDE C/L BREAKS FOR
 TOWN HIGHWAYS) S=SOLID, D=DASHED
 CASTLETON:
 STA 98+50.00 - STA 100+50.00 S - S LT C RT
 STA 100+50.00 - STA 102+00.00 DOUBLE SOLID MEDIAN LT
 STA 100+50.00 - STA 102+50.00 DOUBLE SOLID MEDIAN RT
 STA 102+00.00 - STA 102+50.00 MEDIAN EDGE LINE LT

646.442 DURABLE 8 INCH WHITE LINE, THERMOPLASTIC OR
 646.443 DURABLE 8 INCH WHITE LINE, EPOXY PAINT OR
 646.444 DURABLE 8 INCH WHITE LINE, POLYUREA
 CASTLETON:
 STA 99+44.0 - STA 99+56.0 FIRE HYDRANT NO PARKING ZONE RT
 646.452 DURABLE 8 INCH YELLOW LINE, THERMOPLASTIC OR
 646.453 DURABLE 8 INCH YELLOW LINE, EPOXY PAINT OR
 646.454 DURABLE 8 INCH YELLOW LINE, POLYUREA
 CASTLETON:
 STA 100+50.00 - STA 102+00.00 MEDIAN HATCHING LT & RT
 646.81 PAINTED CURB
 CASTLETON:
 STA 102+00.0 - STA 102+30.0 LT (30.0 LF)
 STA 102+00.0 - STA 102+50.0 RT (50.0 LF)

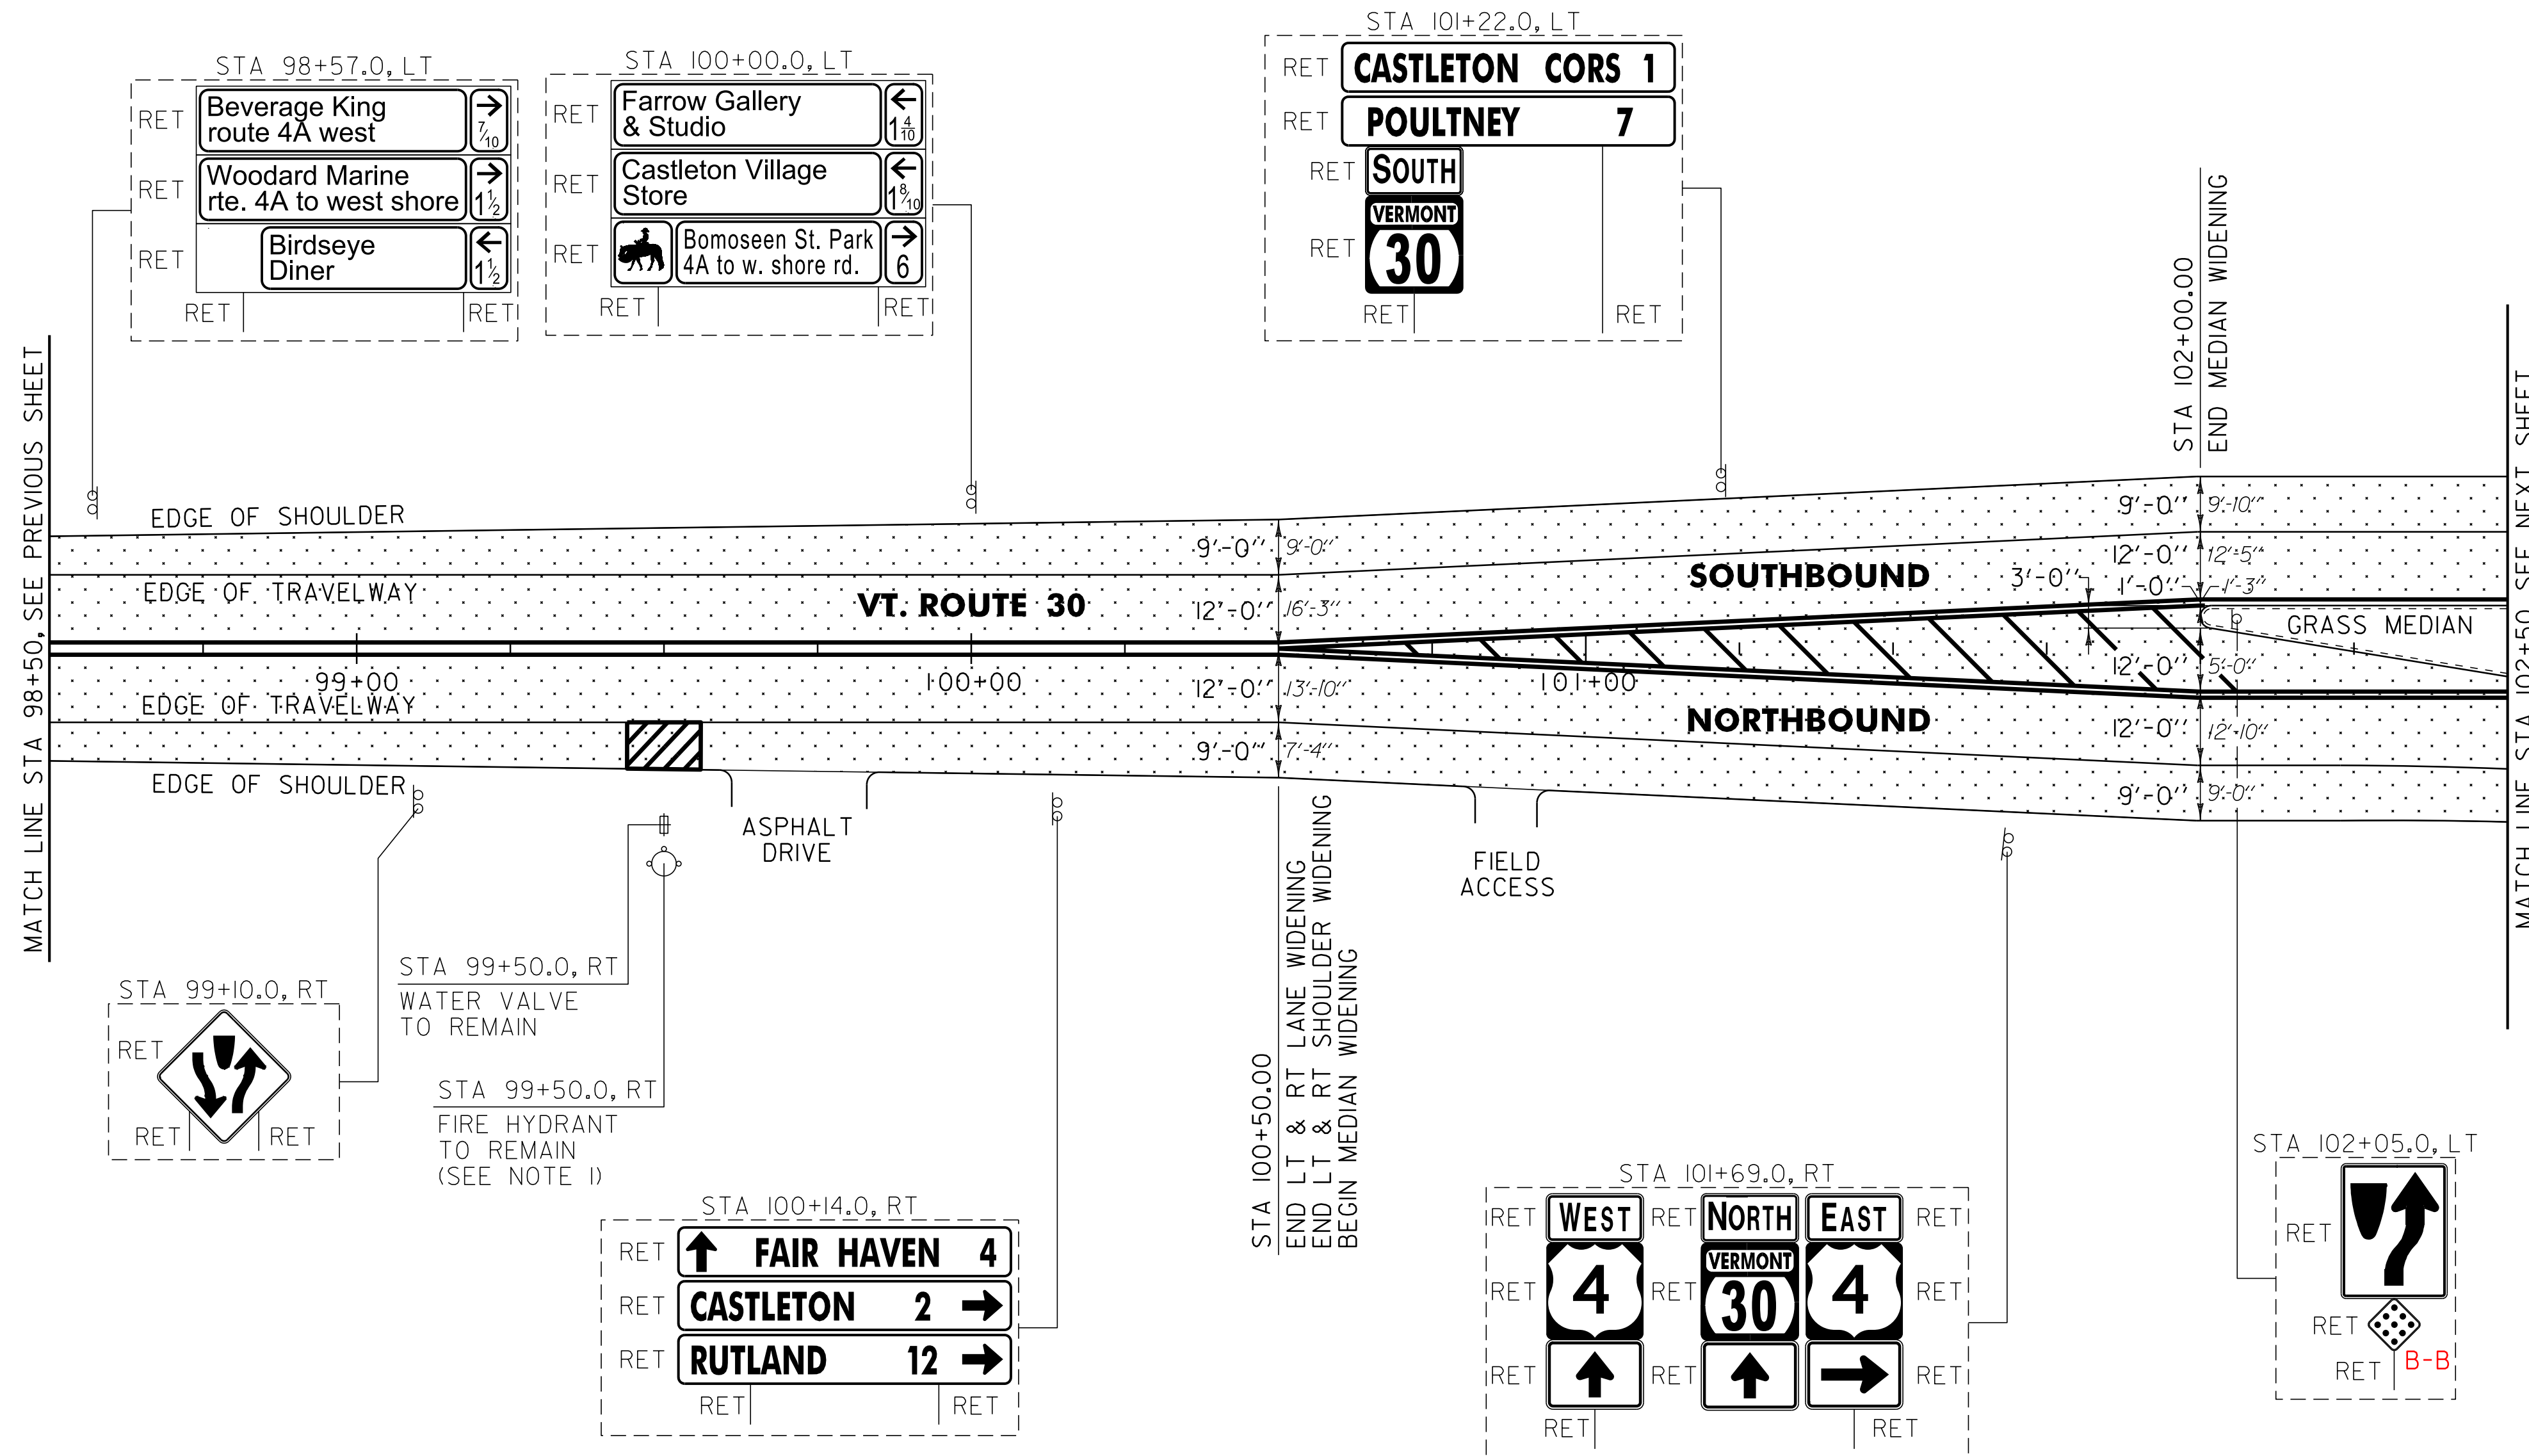

NOTE:
 1. SEE SHEET 8 FOR FIRE HYDRANT
 PAVEMENT MARKING DETAIL.

..... AREA TO BE
 COLD PLANNED

SIGN LEGEND
 R = REMOVE
 S = SALVAGE
 N = NEW
 RET = RETAIN
 B-B = BACK TO BACK
 EXISTING = - - - - -
 NEW = _____

PROJECT LAYOUT SHEET #4	NOT TO SCALE	
	PROJECT NAME: CASTLETON	PLOT DATE: 04-JUN-2013 09:1
	PROJECT NUMBER: STP 2909(1)	DRAWN BY: W.G.P.
	FILE NAME: p10c212.dgn PROJECT LEADER: D.E.G. DESIGNED BY: M.J.M. IPARM FILE: p10c212104.i	CHECKED BY: D.E.G. SHEET 132 OF 152