

646.402 DURABLE 4 INCH WHITE LINE, THERMOPLASTIC OR
 646.403 DURABLE 4 INCH WHITE LINE, EXPOXY PAINT OR
 646.404 DURABLE 4 INCH WHITE LINE, POLYUREA
 (ALL LINES WILL INCLUDE EDGE LINE BREAKS AND
 RADIUS FOR TOWN HIGHWAYS)
 CASTLETON:
 STA I02+50.00 - STA I07+50.00 EDGE LINE LT & RT
 STA I05+90.00 - STA I07+50.00 SOLID LANE LINE LT

646.412 DURABLE 4 INCH YELLOW LINE, THERMOPLASTIC OR
 646.413 DURABLE 4 INCH YELLOW LINE, EXPOXY PAINT OR
 646.414 DURABLE 4 INCH YELLOW LINE, POLYUREA
 (ALL LINES WILL INCLUDE C/L BREAKS FOR
 TOWN HIGHWAYS) S=SOLID, D=DASHED
 CASTLETON:
 STA I02+50.00 - STA I02+65.00 DOUBLE SOLID MEDIAN RT
 STA I02+50.00 - STA I05+15.00 MEDIAN EDGE LINE LT
 STA I02+65.00 - STA I05+15.00 MEDIAN EDGE LINE RT
 STA I06+20.00 - STA I07+50.00 MEDIAN EDGE LINE LT & RT

646.422 DURABLE 6 INCH WHITE LINE, THERMOPLASTIC OR
 646.423 DURABLE 6 INCH WHITE LINE, EXPOXY PAINT OR
 646.424 DURABLE 6 INCH WHITE LINE, POLYUREA
 (ALL LINES WILL INCLUDE EDGE LINE BREAKS AND
 RADIUS FOR TOWN HIGHWAYS)
 CASTLETON:
 STA I04+12.16 RAMP P EDGE LINE RT
 STA I04+12.16 RAMP P MEDIAN EDGE LINE RT
 STA I05+23.04 RAMP N EDGE LINE LT

646.432 DURABLE 6 INCH YELLOW LINE, THERMOPLASTIC OR
 646.433 DURABLE 6 INCH YELLOW LINE, EXPOXY PAINT OR
 646.434 DURABLE 6 INCH YELLOW LINE, POLYUREA
 (ALL LINES WILL INCLUDE C/L BREAKS FOR
 TOWN HIGHWAYS) S=SOLID, D=DASHED
 CASTLETON:
 STA I04+12.16 RAMP P MEDIAN EDGE LINE RT
 STA I04+12.16 RAMP P EDGE LINE RT
 STA I05+23.04 RAMP N EDGE LINE LT

646.602 TEMPORARY 4 INCH WHITE LINE, PAINT
 (ALL LINES WILL INCLUDE EDGE LINE BREAKS AND
 RADIUS FOR TOWN HIGHWAYS)
 CASTLETON:
 STA I02+50.00 - STA I07+50.00 EDGE LINE LT & RT
 STA I04+12.16 RAMP P EDGE LINE RT
 STA I04+12.16 RAMP P MEDIAN EDGE LINE RT
 STA I05+23.04 RAMP N EDGE LINE LT
 STA I05+90.00 - STA I07+50.00 SOLID LANE LINE LT

646.612 TEMPORARY 4 INCH YELLOW LINE, PAINT
 (ALL LINES WILL INCLUDE C/L BREAKS FOR
 TOWN HIGHWAYS) S=SOLID, D=DASHED
 CASTLETON:
 STA I02+50.00 - STA I02+65.00 DOUBLE SOLID MEDIAN RT
 STA I02+50.00 - STA I05+15.00 MEDIAN EDGE LINE LT
 STA I02+65.00 - STA I05+15.00 MEDIAN EDGE LINE RT
 STA I04+12.16 RAMP P MEDIAN EDGE LINE RT
 STA I04+12.16 RAMP P EDGE LINE RT
 STA I05+23.04 RAMP N EDGE LINE LT
 STA I06+20.00 - STA I07+50.00 MEDIAN EDGE LINE LT & RT

646.622 TEMPORARY 6 INCH WHITE LINE, PAINT
 (ALL LINES WILL INCLUDE EDGE LINE BREAKS AND
 RADIUS FOR TOWN HIGHWAYS)
 CASTLETON:
 STA I04+12.16 RAMP P EDGE LINE RT
 STA I04+12.16 RAMP P MEDIAN EDGE LINE RT
 STA I05+23.04 RAMP N EDGE LINE LT

646.632 TEMPORARY 6 INCH YELLOW LINE, PAINT
 (ALL LINES WILL INCLUDE C/L BREAKS FOR
 TOWN HIGHWAYS) S=SOLID, D=DASHED
 CASTLETON:
 STA I04+12.16 RAMP P MEDIAN EDGE LINE RT
 STA I04+12.16 RAMP P EDGE LINE RT
 STA I05+23.04 RAMP N EDGE LINE LT

646.462 DURABLE 12 INCH WHITE LINE, THERMOPLASTIC OR
 646.463 DURABLE 12 INCH WHITE LINE, EXPOXY PAINT OR
 646.464 DURABLE 12 INCH WHITE LINE, POLYUREA
 CASTLETON:
 STA I03+75.00 - STA I05+55.00 GORE AREA RT
 STA I04+12.16 RAMP P GORE AREA RT
 STA I04+80.00 - STA I05+15.00 HATCHED AREA LT


646.492 DURABLE LETTER OR SYMBOL, THERMOPLASTIC OR
 646.493 DURABLE LETTER OR SYMBOL, EXPOXY PAINT
 CASTLETON:
 STA I05+23.04 LT, RAMP N, "S,T,O,P" (4 EA)
 STA I05+23.04 LT, RAMP N, "S,T,O,P" (4 EA)
 STA I06+24.25 LT ARROW (1 EA)
 STA I06+98.40 LT "O,N,L,Y" (4 EA)

646.482 TEMPORARY 24 INCH STOP BAR, THERMOPLASTIC OR
 646.483 DURABLE 24 INCH STOP BAR, EXPOXY PAINT OR
 646.484 DURABLE 24 INCH STOP BAR, POLYUREA
 CASTLETON:
 STA I05+23.04 LT, RAMP N
 STA I05+23.04 LT, RAMP N

646.682 TEMPORARY 24 INCH STOP BAR, PAINT
 CASTLETON:
 STA I05+23.04 LT, RAMP N
 STA I05+23.04 LT, RAMP N

646.692 TEMPORARY LETTER OR SYMBOL, PAINT
 CASTLETON:
 STA I05+23.04 LT, RAMP N, "S,T,O,P" (8 EA)
 STA I05+23.04 LT, RAMP N, "S,T,O,P" (8 EA)
 STA I06+24.25 LT ARROW (2 EA)

646.81 PAINTED CURB
 CASTLETON:
 STA I02+50.0 - STA I02+95.0 RT (45.0 LF)
 STA I04+85.0 - STA I05+15.0 LT/RT (60.0 LF)
 STA I06+20.0 - STA I06+50.0 RT (60.0 LF)

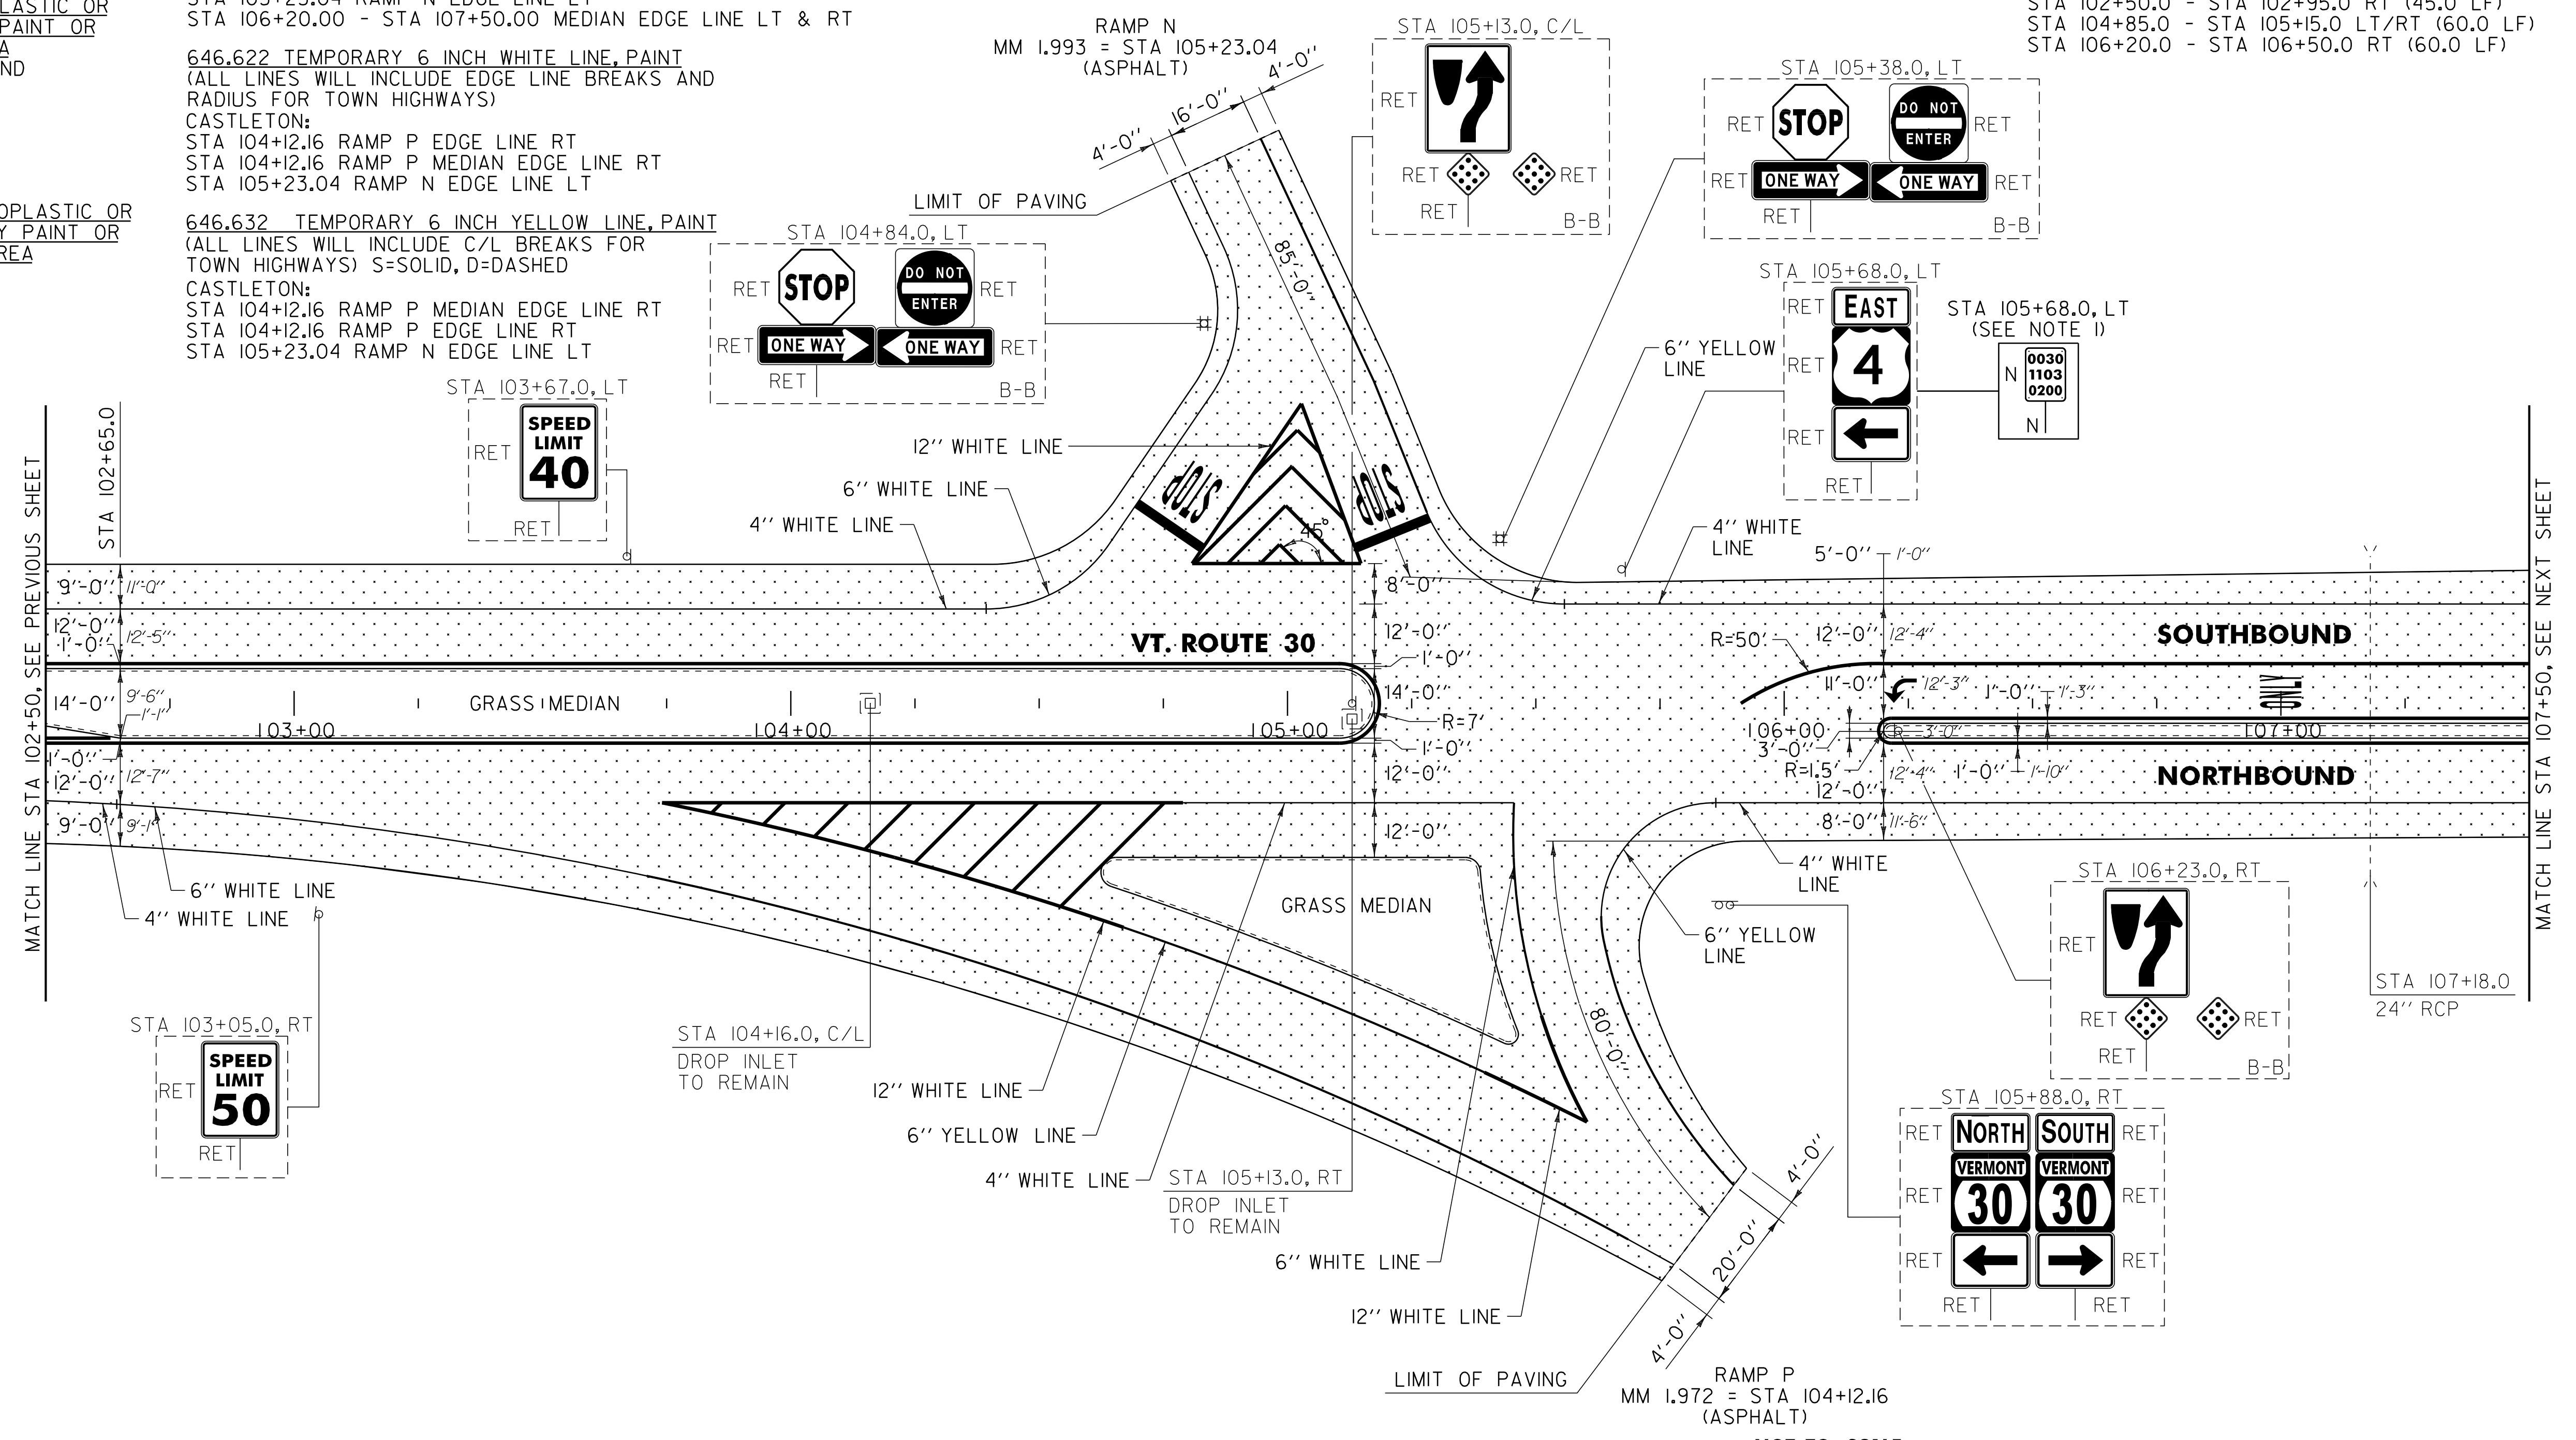

NOTE:
 1. THIS NEW MILE MARKER SIGN IS TO BE
 INSTALLED ON THE EXISTING SIGN POST.

AREA TO BE
 COLD PLANNED

SIGN LEGEND
 R = REMOVE
 S = SALVAGE
 N = NEW
 RET = RETAIN
 B-B = BACK TO BACK
 EXISTING BY: - - - - -
 NEW = _____

NOT TO SCALE

PROJECT LAYOUT SHEET #5	PROJECT NAME: CASTLETON	PLOT DATE: 04-JUN-2013 09:11
	PROJECT NUMBER: STP 2909(1)	DRAWN BY: W.G.P.
	FILE NAME: p10c212.dgn	CHECKED BY: D.E.G.
	PROJECT LEADER: D.E.G.	SHEET 133 OF 152