

646.402 DURABLE 4 INCH WHITE LINE, THERMOPLASTIC OR  
 646.403 DURABLE 4 INCH WHITE LINE, EXPOXY PAINT OR  
 646.404 DURABLE 4 INCH WHITE LINE, POLYUREA  
 (ALL LINES WILL INCLUDE EDGE LINE BREAKS AND  
 RADIUS FOR TOWN HIGHWAYS)  
 CASTLETON:  
 STA 112+50.00 - STA 118+00.00 EDGE LINE LT & RT  
 STA 112+50.00 - STA 114+75.00 SOLID LANE LINE RT

646.602 TEMPORARY 4 INCH WHITE LINE, PAINT  
 (ALL LINES WILL INCLUDE EDGE LINE BREAKS AND  
 RADIUS FOR TOWN HIGHWAYS)  
 CASTLETON:  
 STA 112+50.00 - STA 118+00.00 EDGE LINE LT & RT  
 STA 112+50.00 - STA 114+75.00 SOLID LANE LINE RT  
 STA 115+26.24 RAMP Q EDGE LINE RT  
 STA 116+21.28 RAMP R EDGE LINE LT  
 STA 116+21.28 RAMP R MEDIAN EDGE LINE LT

646.622 TEMPORARY 6 INCH WHITE LINE, PAINT  
 (ALL LINES WILL INCLUDE C/L BREAKS FOR  
 TOWN HIGHWAYS) S=SOLID, D=DASHED  
 CASTLETON:  
 STA 115+26.24 RAMP Q EDGE LINE RT  
 STA 116+21.28 RAMP R EDGE LINE LT  
 STA 116+21.28 RAMP R MEDIAN EDGE LINE LT

646.624 DURABLE 12 INCH WHITE LINE, THERMOPLASTIC OR  
 646.625 DURABLE 12 INCH WHITE LINE, EXPOXY PAINT OR  
 646.626 DURABLE 12 INCH WHITE LINE, POLYUREA  
 CASTLETON:  
 STA 115+00.00 - STA 116+68.00 GORE AREA LT  
 STA 115+35.00 - STA 116+08.00 HATCHED AREA RT  
 STA 116+21.28 RAMP R GORE AREA LT

646.492 DURABLE LETTER OR SYMBOL, THERMOPLASTIC OR  
 646.493 DURABLE LETTER OR SYMBOL, EXPOXY PAINT  
 CASTLETON:  
 STA 112+90.00 RT ARROW (1EA)  
 STA 113+65.38 RT "O,N,L,Y" (4 EA)  
 STA 114+40.75 RT ARROW (1EA)  
 STA 115+26.24 RT, RAMP Q, "S,T,O,P" (4 EA)  
 STA 115+26.24 RT, RAMP Q, "S,T,O,P" (4 EA)

646.412 DURABLE 4 INCH YELLOW LINE, THERMOPLASTIC OR  
 646.413 DURABLE 4 INCH YELLOW LINE, EXPOXY PAINT OR  
 646.414 DURABLE 4 INCH YELLOW LINE, POLYUREA  
 (ALL LINES WILL INCLUDE C/L BREAKS FOR  
 TOWN HIGHWAYS) S=SOLID, D=DASHED  
 CASTLETON:  
 STA 112+50.00 - STA 114+45.00 MEDIAN EDGE LINE LT  
 STA 115+55.00 - STA 118+00.00 MEDIAN EDGE LINE LT & RT

646.612 TEMPORARY 4 INCH YELLOW LINE, PAINT  
 (ALL LINES WILL INCLUDE C/L BREAKS FOR  
 TOWN HIGHWAYS) S=SOLID, D=DASHED  
 CASTLETON:  
 STA 112+50.00 - STA 114+45.00 MEDIAN EDGE LINE LT  
 STA 115+55.00 - STA 118+00.00 MEDIAN EDGE LINE LT & RT  
 STA 115+26.24 RAMP Q EDGE LINE RT  
 STA 116+21.28 RAMP R EDGE LINE LT  
 STA 116+21.28 RAMP R MEDIAN EDGE LINE LT

646.632 TEMPORARY 6 INCH YELLOW LINE, PAINT  
 (ALL LINES WILL INCLUDE C/L BREAKS FOR  
 TOWN HIGHWAYS) S=SOLID, D=DASHED  
 CASTLETON:  
 STA 115+26.24 RAMP Q EDGE LINE RT  
 STA 116+21.28 RAMP R EDGE LINE LT  
 STA 116+21.28 RAMP R MEDIAN EDGE LINE LT

646.482 DURABLE 24 INCH STOP BAR, THERMOPLASTIC OR  
 646.483 DURABLE 24 INCH STOP BAR, EXPOXY PAINT OR  
 646.484 DURABLE 24 INCH STOP BAR, POLYUREA  
 CASTLETON:  
 STA 115+26.24 RT, RAMP Q  
 STA 115+26.24 RT, RAMP Q  
 STA 115+26.24 RT, RAMP Q

646.692 TEMPORARY LETTER OR SYMBOL, PAINT  
 CASTLETON:  
 STA 112+90.00 RT ARROW (2 EA)  
 STA 114+40.75 RT ARROW (2 EA)  
 STA 115+26.24 RT, RAMP Q, "S,T,O,P" (8 EA)  
 STA 115+26.24 RT, RAMP Q, "S,T,O,P" (8 EA)


646.432 DURABLE 6 INCH YELLOW LINE, THERMOPLASTIC OR  
 646.433 DURABLE 6 INCH YELLOW LINE, EXPOXY PAINT OR  
 646.434 DURABLE 6 INCH YELLOW LINE, POLYUREA  
 (ALL LINES WILL INCLUDE C/L BREAKS FOR  
 TOWN HIGHWAYS) S=SOLID, D=DASHED  
 CASTLETON:  
 STA 115+26.24 RAMP Q EDGE LINE RT  
 STA 116+21.28 RAMP R EDGE LINE LT  
 STA 116+21.28 RAMP R MEDIAN EDGE LINE LT

646.632 TEMPORARY 6 INCH YELLOW LINE, PAINT  
 (ALL LINES WILL INCLUDE C/L BREAKS FOR  
 TOWN HIGHWAYS) S=SOLID, D=DASHED  
 CASTLETON:  
 STA 115+26.24 RAMP Q EDGE LINE RT  
 STA 116+21.28 RAMP R EDGE LINE LT  
 STA 116+21.28 RAMP R MEDIAN EDGE LINE LT

646.682 TEMPORARY 24 INCH STOP BAR, PAINT  
 CASTLETON:  
 STA 115+26.24 RT, RAMP Q  
 STA 116+26.24 RT, RAMP Q

646.81 PAINTED CURB  
 CASTLETON:  
 STA 114+15.0 - STA 114+45.0 LT (60.0 LF)  
 STA 115+55.0 - STA 115+85.0 LT/RT (60.0 LF)  
 STA 117+75.0 - STA 118+00.0 LT (25.0 LF)

646.81 PAINTED CURB  
 CASTLETON:  
 STA 114+15.0 - STA 114+45.0 LT (60.0 LF)  
 STA 115+55.0 - STA 115+85.0 LT/RT (60.0 LF)  
 STA 117+75.0 - STA 118+00.0 LT (25.0 LF)

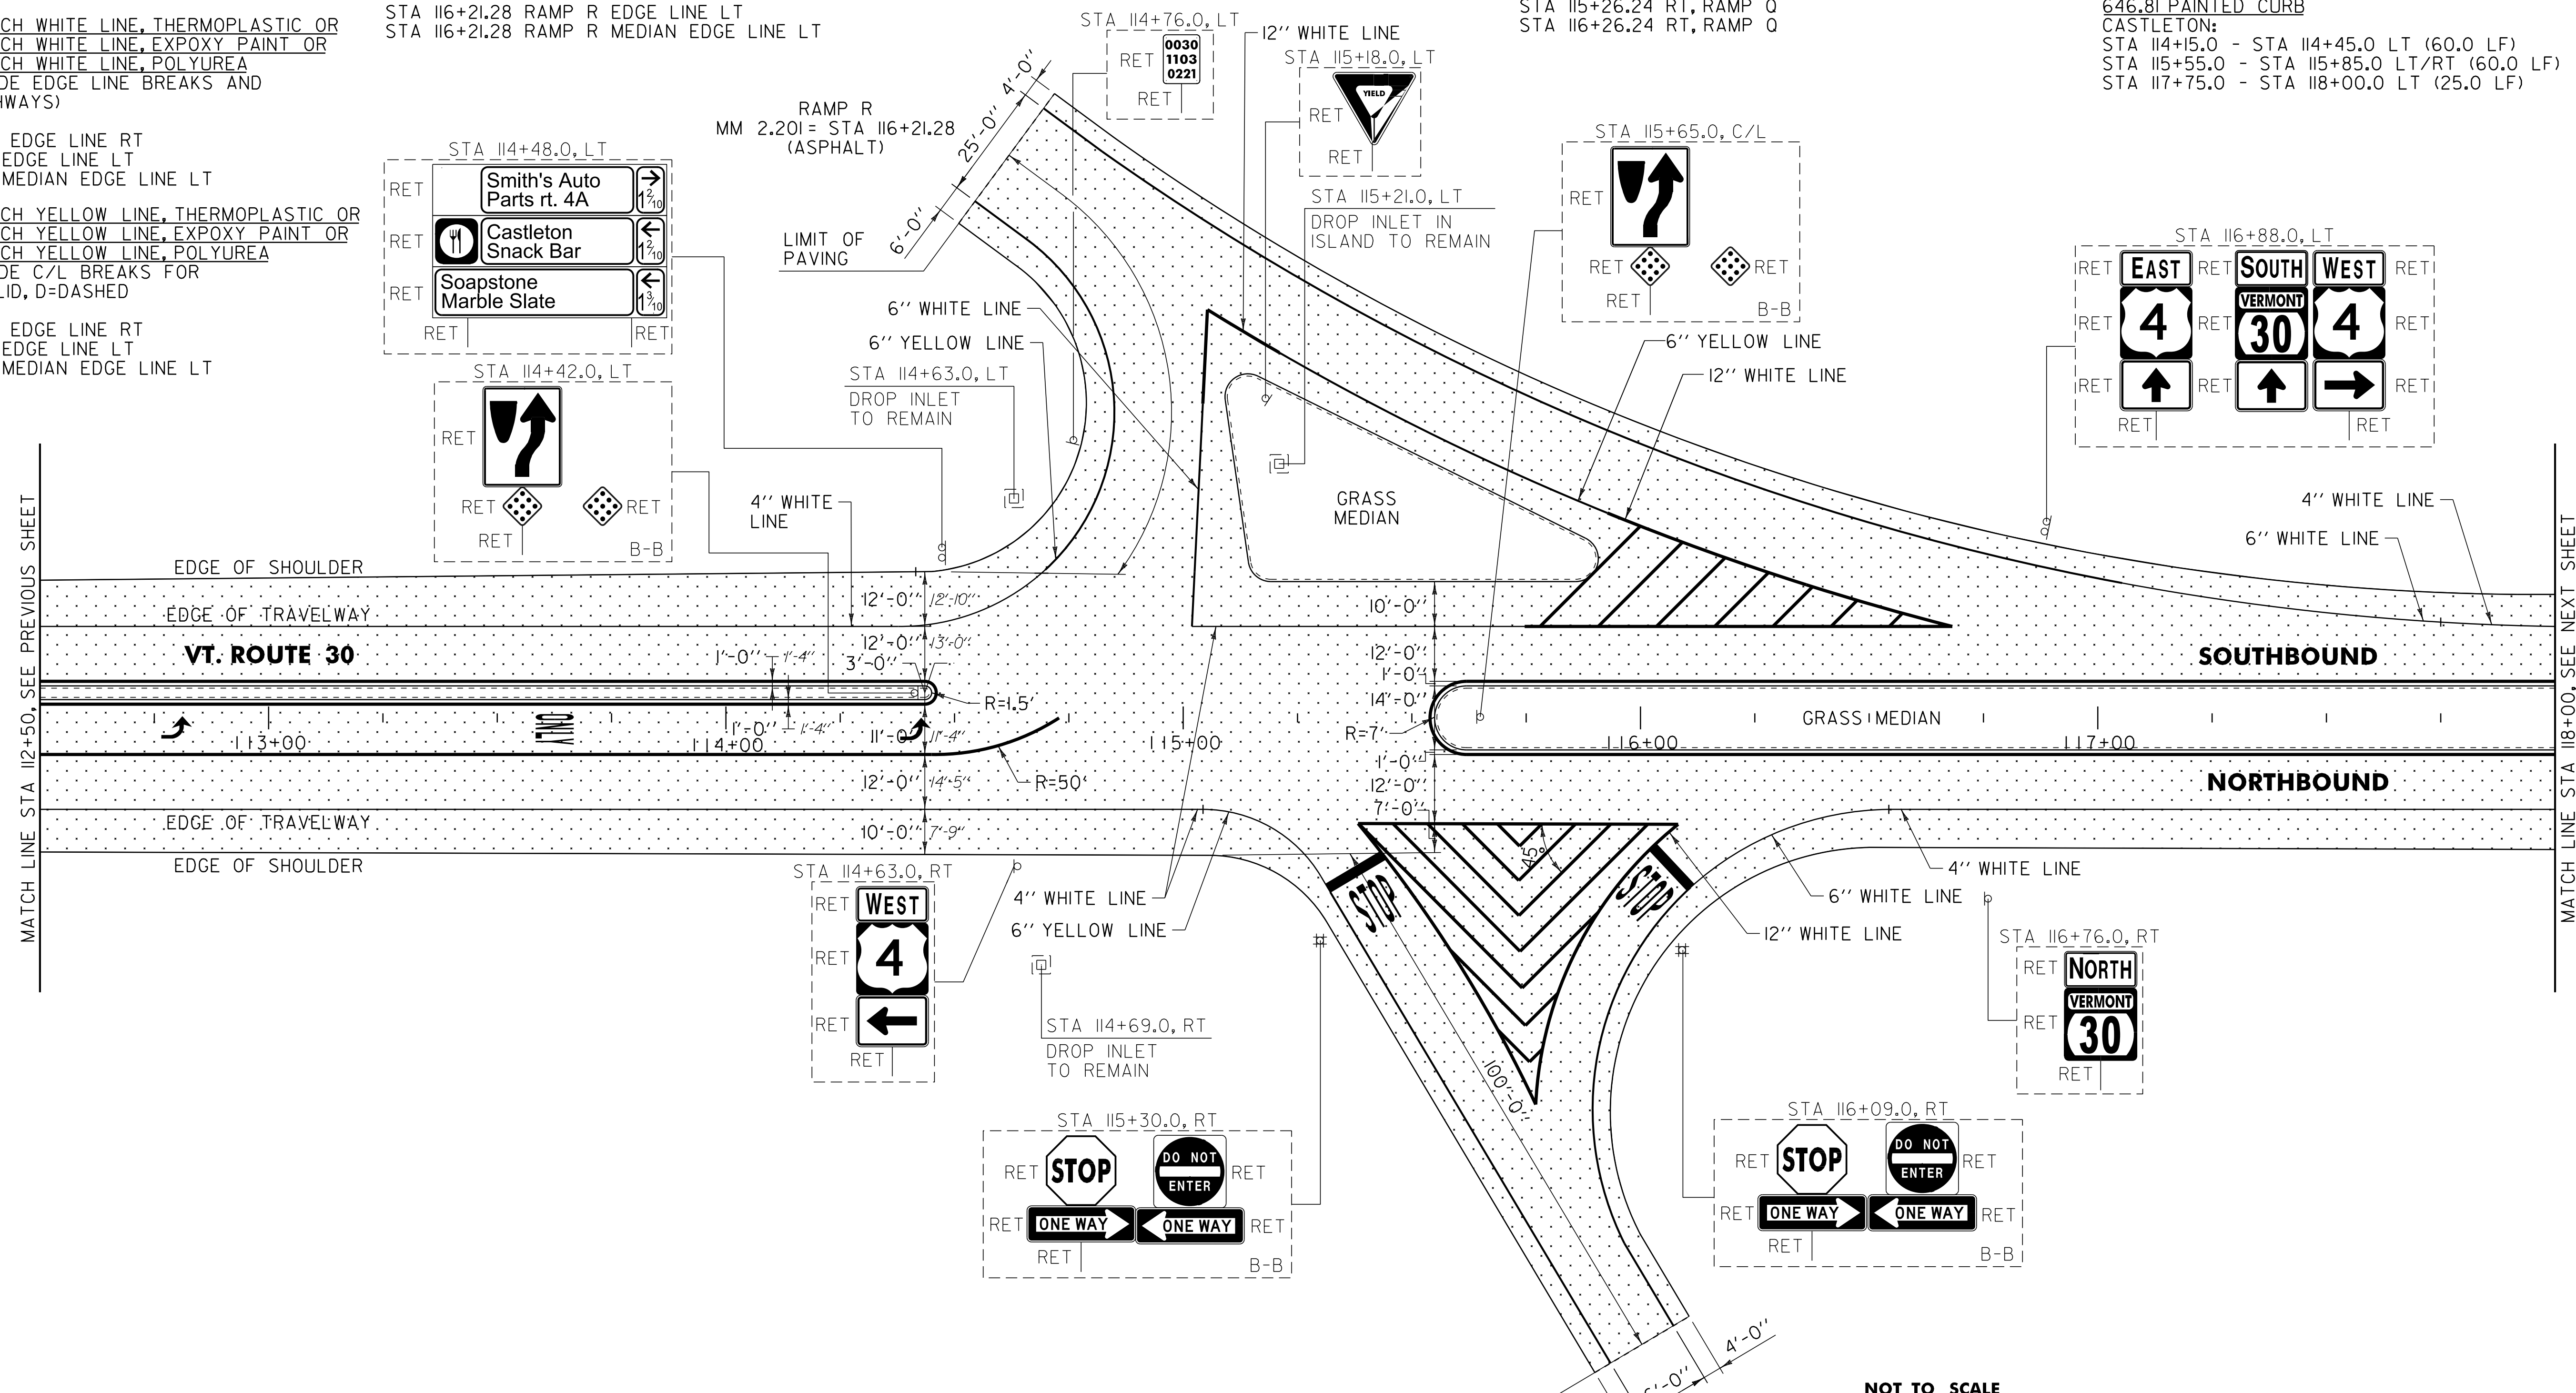

**SIGN LEGEND**  
 R = REMOVE  
 S = SALVAGE  
 N = NEW  
 RET = RETAIN  
 B-B = BACK TO BACK  
 EXISTING = - - - - -  
 NEW = \_\_\_\_\_

AREA TO BE COLD PLANNED

**NOT TO SCALE**

<b>PROJECT LAYOUT SHEET #7</b>	PROJECT NAME: CASTLETON	PLOT DATE: 04-JUN-2013 09:1
	PROJECT NUMBER: STP 2909(1)	DRAWN BY: W.G.P.
	FILE NAME: p10c212.dgn	CHECKED BY: D.E.G.
	PROJECT LEADER: D.E.G.	SHEET 135 OF 152
	DESIGNED BY: M.J.M.	
	IPARM FILE: p10c212107.i	