

646.402 DURABLE 4 INCH WHITE LINE, THERMOPLASTIC OR
 646.403 DURABLE 4 INCH WHITE LINE, EPOXY PAINT OR
 646.404 DURABLE 4 INCH WHITE LINE, POLYUREA
 (ALL LINES WILL INCLUDE EDGE LINE BREAKS AND
 RADIUS FOR TOWN HIGHWAYS)
 CASTLETON:
 STA 176+50.00 - STA 188+50.00 EDGE LINE LT & RT



646.412 DURABLE 4 INCH YELLOW LINE, THERMOPLASTIC OR
 646.413 DURABLE 4 INCH YELLOW LINE, EPOXY PAINT OR
 646.414 DURABLE 4 INCH YELLOW LINE, POLYUREA
 (ALL LINES WILL INCLUDE C/L BREAKS FOR
 TOWN HIGHWAYS) S=SOLID, D=DASHED
 CASTLETON:
 STA 176+50.00 - STA 188+50.00

646.602 TEMPORARY 4 INCH WHITE LINE, PAINT
 (ALL LINES WILL INCLUDE EDGE LINE BREAKS AND
 RADIUS FOR TOWN HIGHWAYS)
 CASTLETON:
 STA 176+50.00 - STA 188+50.00 EDGE LINE LT & RT

646.612 TEMPORARY 4 INCH YELLOW LINE, PAINT
 (ALL LINES WILL INCLUDE C/L BREAKS FOR
 TOWN HIGHWAYS) S=SOLID, D=DASHED
 CASTLETON:
 STA 176+50.00 - STA 188+50.00

LT ☉ RT
 S - S

LT ☉ RT
 S - S

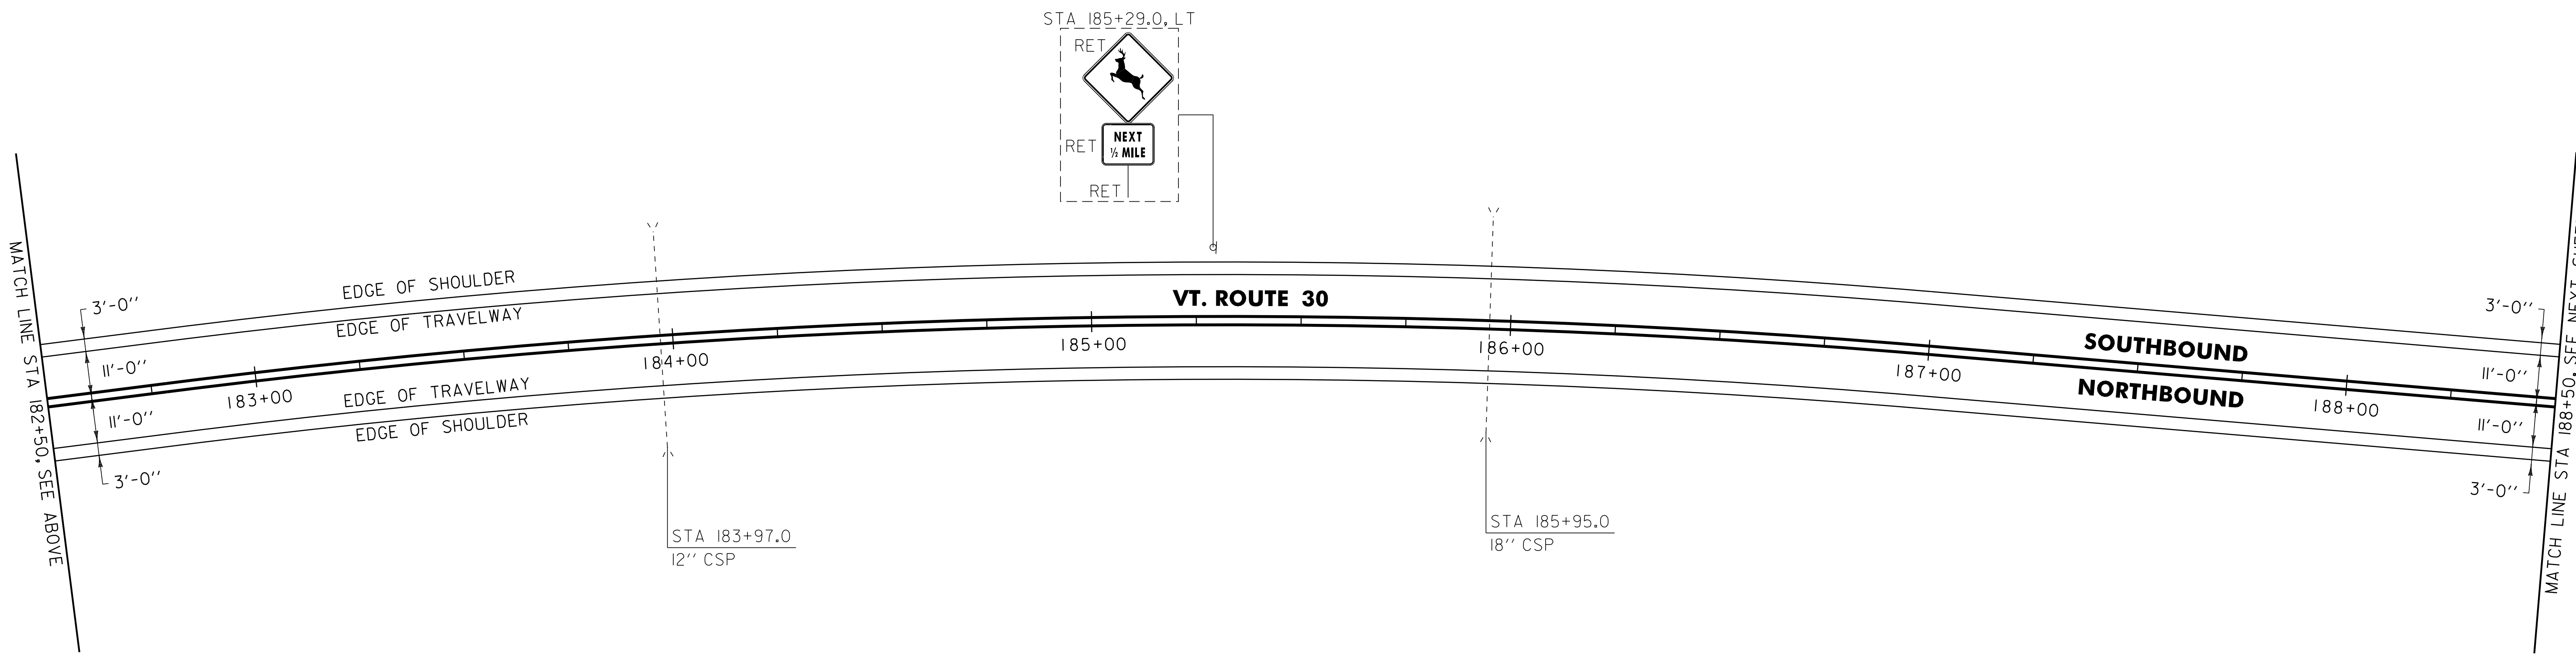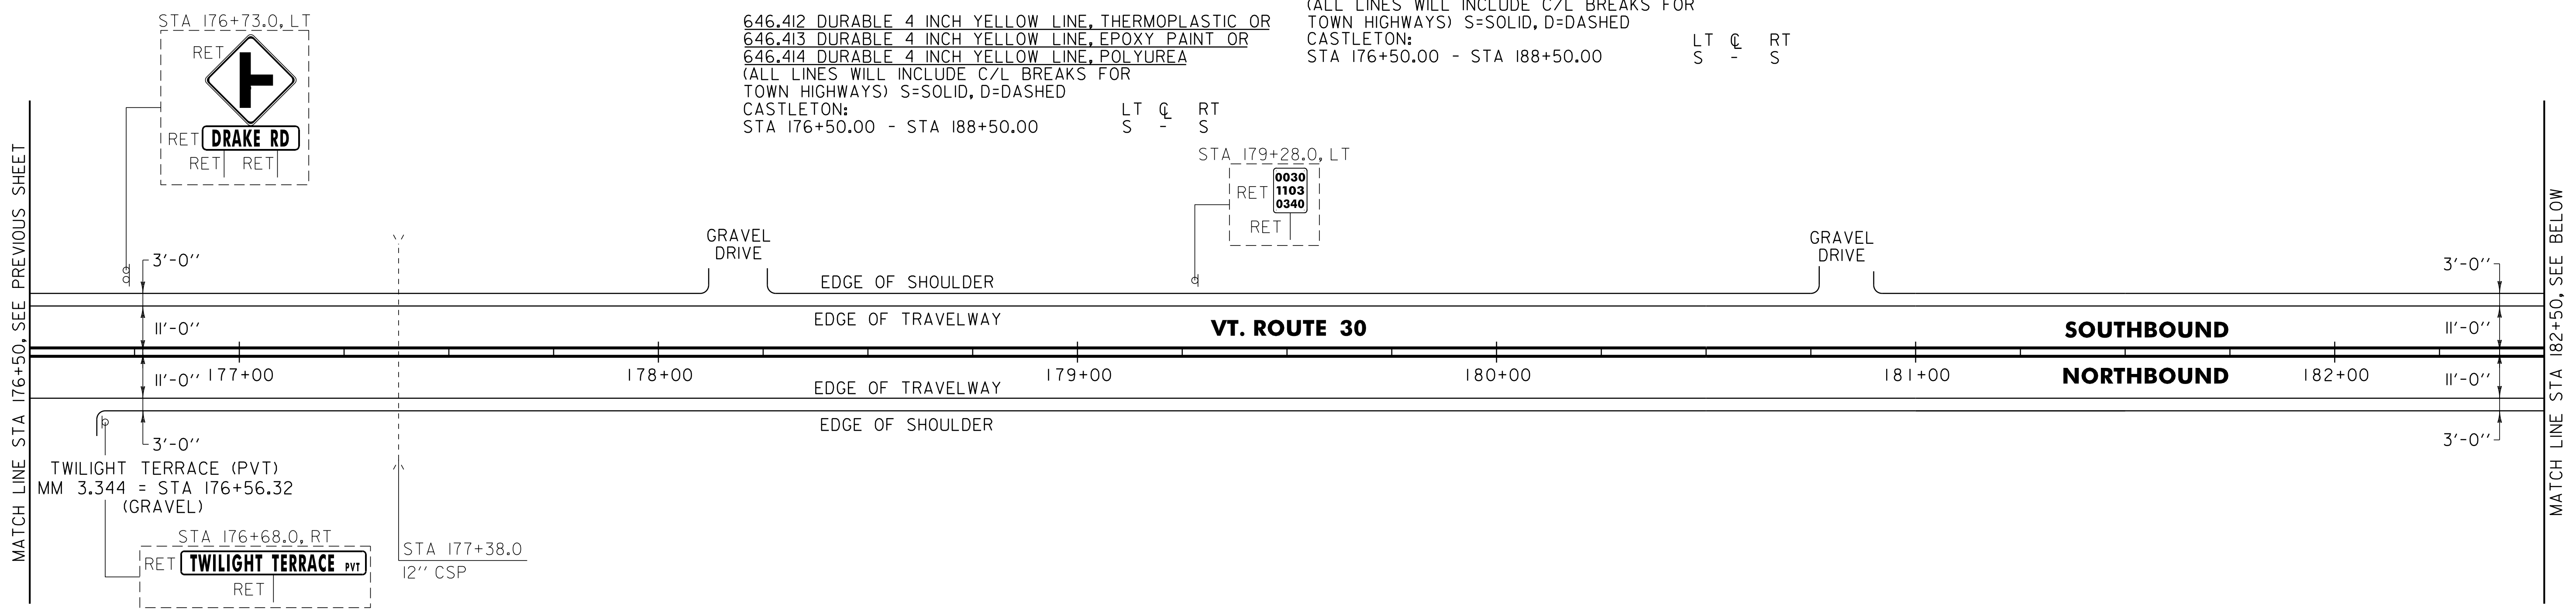

SIGN LEGEND
 R = REMOVE
 S = SALVAGE
 N = NEW
 RET = RETAIN
 B-B = BACK TO BACK
 EXISTING = - - - - -
 NEW = _____

| | | |
|---------------------------------|-----------------------------|------------------------------|
| PROJECT LAYOUT SHEET #14 | NOT TO SCALE | |
| | PROJECT NAME: CASTLETON | PLOT DATE: 04-JUN-2013 09:14 |
| | PROJECT NUMBER: STP 2909(1) | DRAWN BY: W.G.P. |
| | FILE NAME: p10c212.dgn | CHECKED BY: D.E.G. |
| | DESIGNED BY: M.J.M. | SHEET 142 OF 152 |
| | IPARM FILE: p10c212114.i | |