


646.402 DURABLE 4 INCH WHITE LINE, THERMOPLASTIC OR
 646.403 DURABLE 4 INCH WHITE LINE, EPOXY PAINT OR
 646.404 DURABLE 4 INCH WHITE LINE, POLYUREA
 (ALL LINES WILL INCLUDE EDGE LINE BREAKS AND
 RADIUS FOR TOWN HIGHWAYS)
 CASTLETON:
 STA 272+50.00 - STA 274+03.20 EDGE LINE LT & RT

646.412 DURABLE 4 INCH YELLOW LINE, THERMOPLASTIC OR
 646.413 DURABLE 4 INCH YELLOW LINE, EPOXY PAINT OR
 646.414 DURABLE 4 INCH YELLOW LINE, POLYUREA
 (ALL LINES WILL INCLUDE C/L BREAKS FOR
 TOWN HIGHWAYS) S=SOLID, D=DASHED
 CASTLETON:
 STA 272+50.00 - STA 274+03.20 LT C RT
 S - S

646.602 TEMPORARY 4 INCH WHITE LINE, PAINT
 (ALL LINES WILL INCLUDE EDGE LINE BREAKS AND
 RADIUS FOR TOWN HIGHWAYS)
 CASTLETON:
 STA 272+50.00 - STA 274+03.20 EDGE LINE LT & RT

646.612 TEMPORARY 4 INCH YELLOW LINE, PAINT
 (ALL LINES WILL INCLUDE C/L BREAKS FOR
 TOWN HIGHWAYS) S=SOLID, D=DASHED
 CASTLETON:
 STA 272+50.00 - STA 274+03.20 LT C RT
 S - S

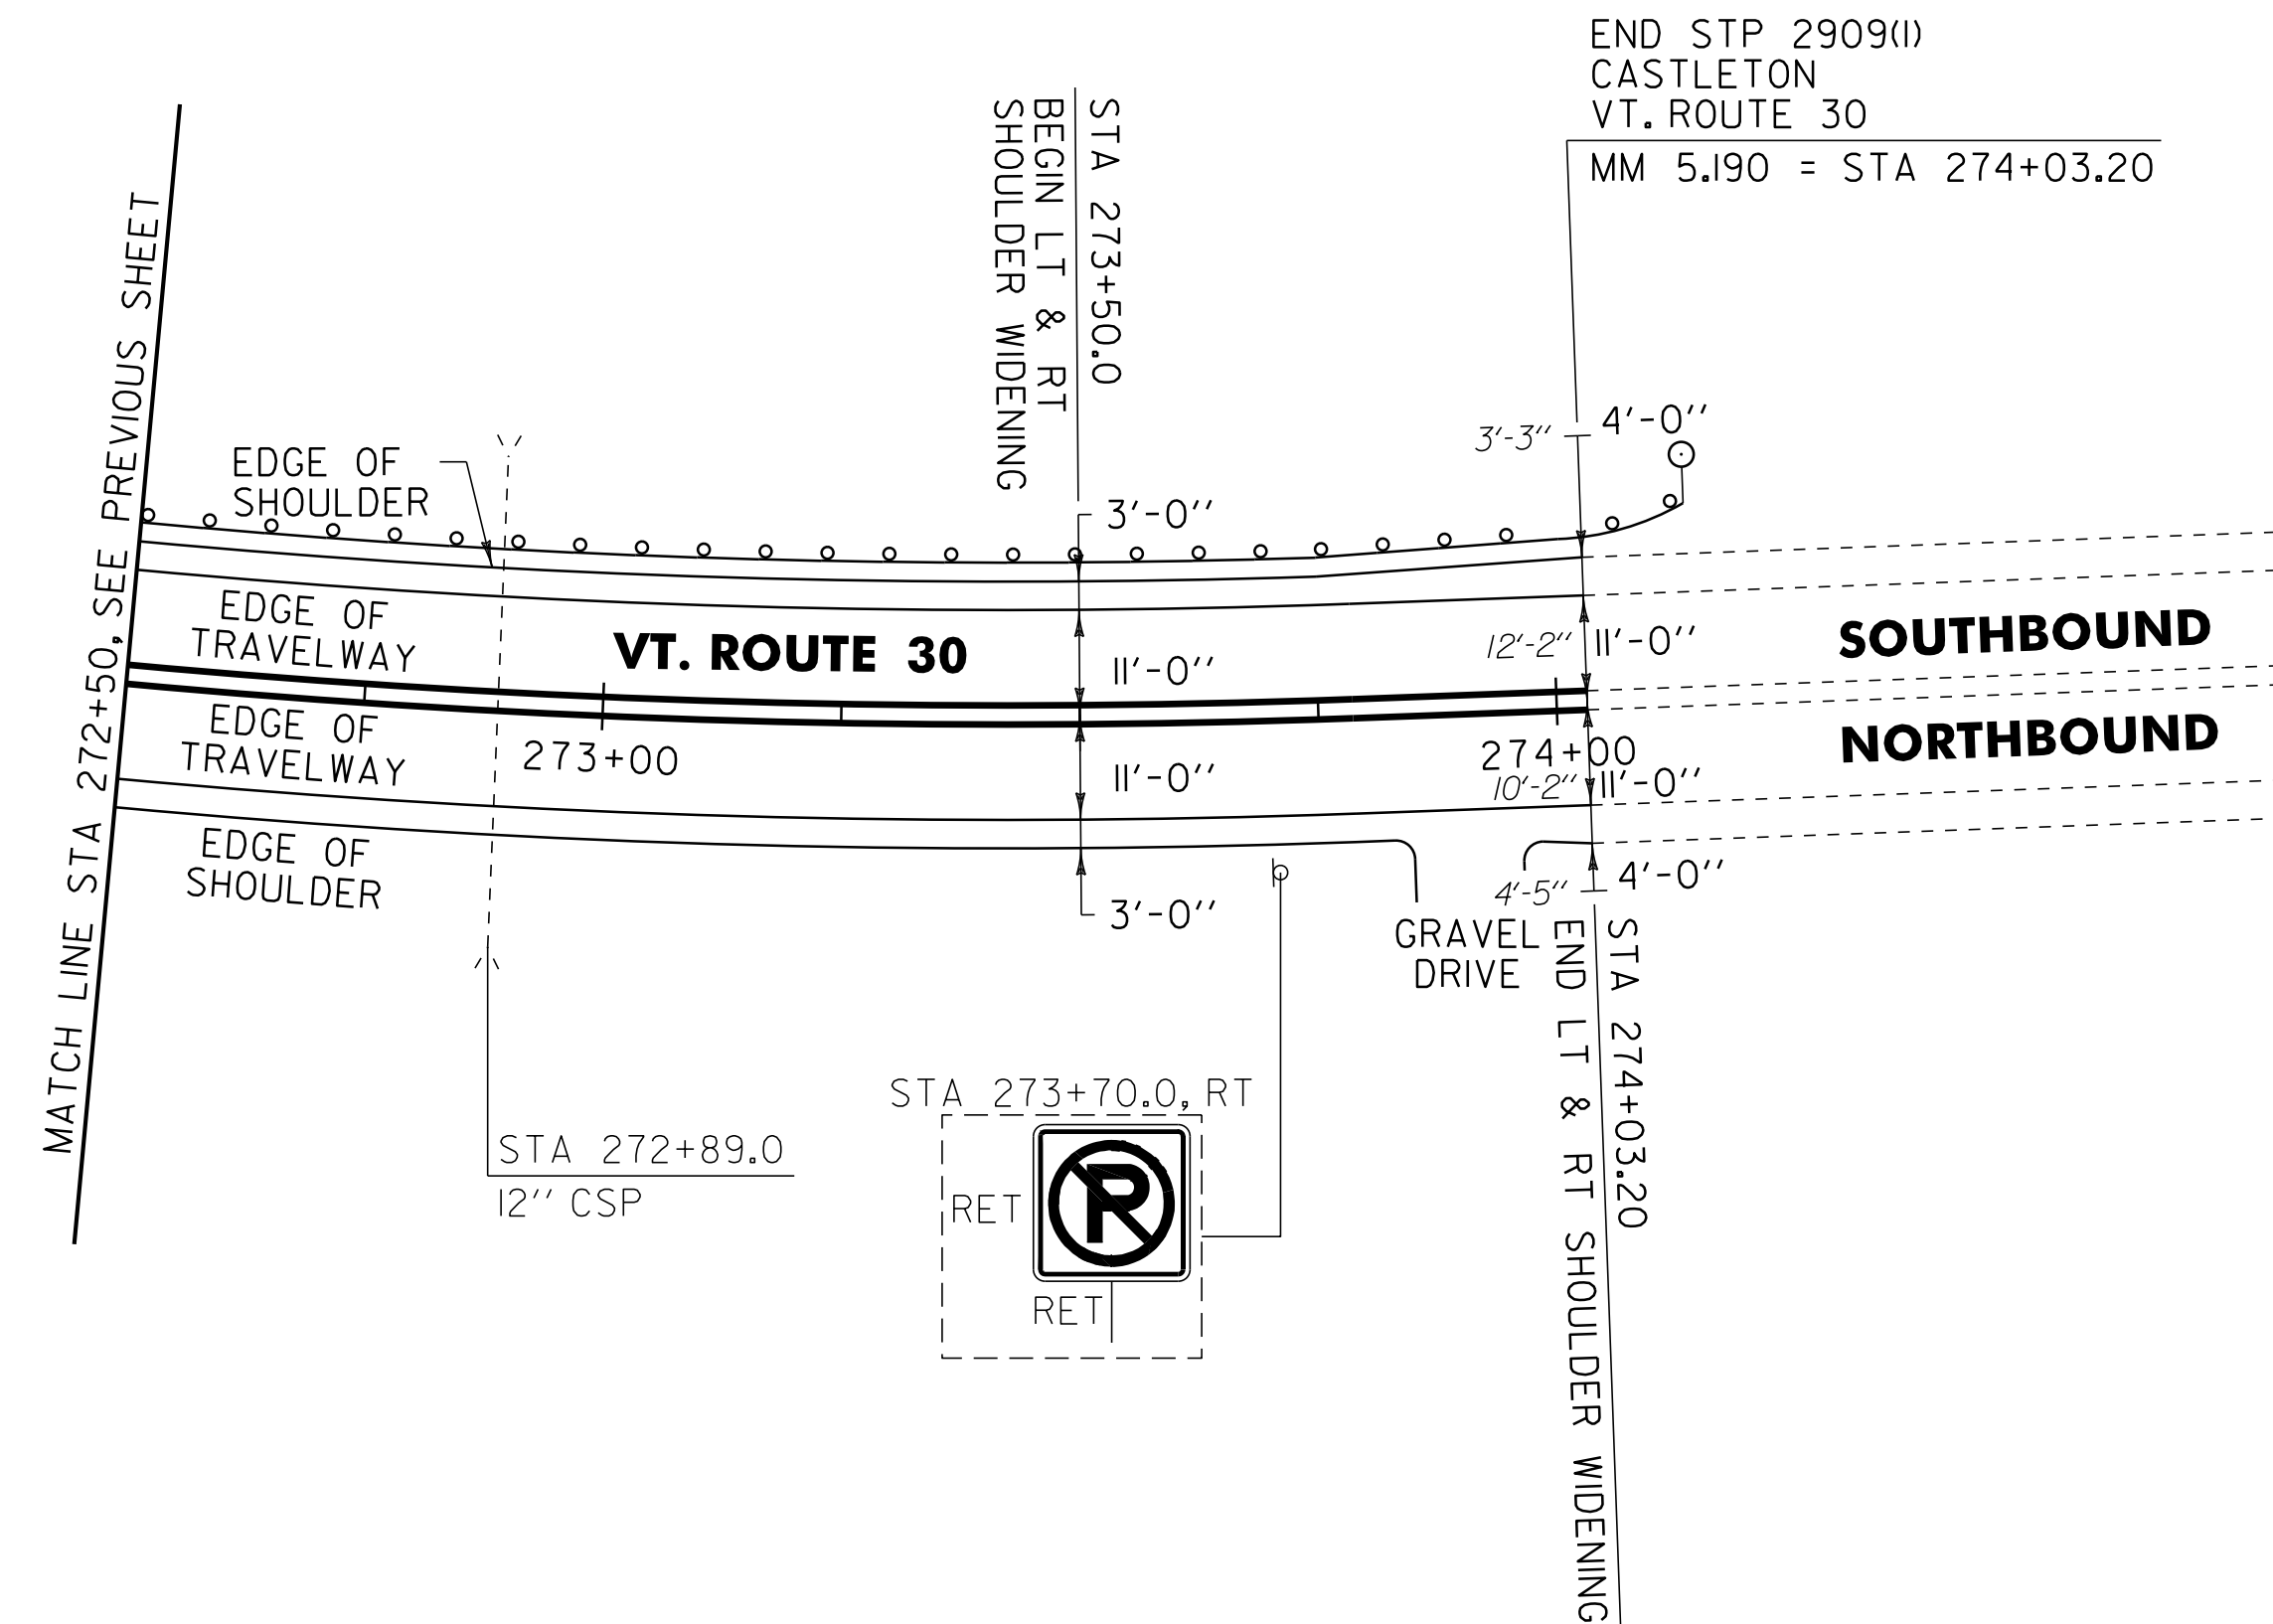

621.205 STEEL BEAM GUARDRAIL, GALVANIZED W/8 FEET POSTS
 CASTLETON:
 STA 272+50.0 - STA 274+19.0 (189.0 LF)

621.80 REMOVAL AND DISPOSAL OF GUARDRAIL
 CASTLETON:
 STA 272+50.0 - STA 274+14.0 LT (164.0 LF)

621.60 ANCHOR FOR STEEL BEAM RAIL
 CASTLETON:
 STA 274+12.5 LT

676.10 DELINEATOR WITH STEEL POST
 CASTLETON:
 STA 274+19.0 LT

SIGN LEGEND
 R = REMOVE
 S = SALVAGE
 N = NEW
 RET = RETAIN
 B-B = BACK TO BACK
 EXISTING = - - - - -
 NEW = _____

NOT TO SCALE	
PROJECT LAYOUT SHEET #22	PROJECT NAME: CASTLETON
	PROJECT NUMBER: STP 2909(I)
	FILE NAME: p10c212.dgn
	PLOT DATE: 04-JUN-2013 09:14
DESIGNED BY: M.J.M.	DRAWN BY: W.G.P.
IPARM FILE: p10c212122.i	CHECKED BY: D.E.G.
	SHEET 150 OF 152