



INDEX OF SHEETS
SEE SHEET 2

STATE OF VERMONT
AGENCY OF TRANSPORTATION

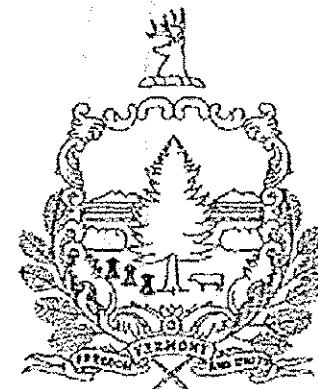



PROPOSED IMPROVEMENT
TOWNS OF CASTLETON, IRA, & WEST RUTLAND
COUNTY OF RUTLAND
VT. ROUTE 4A & VT. ROUTE 30

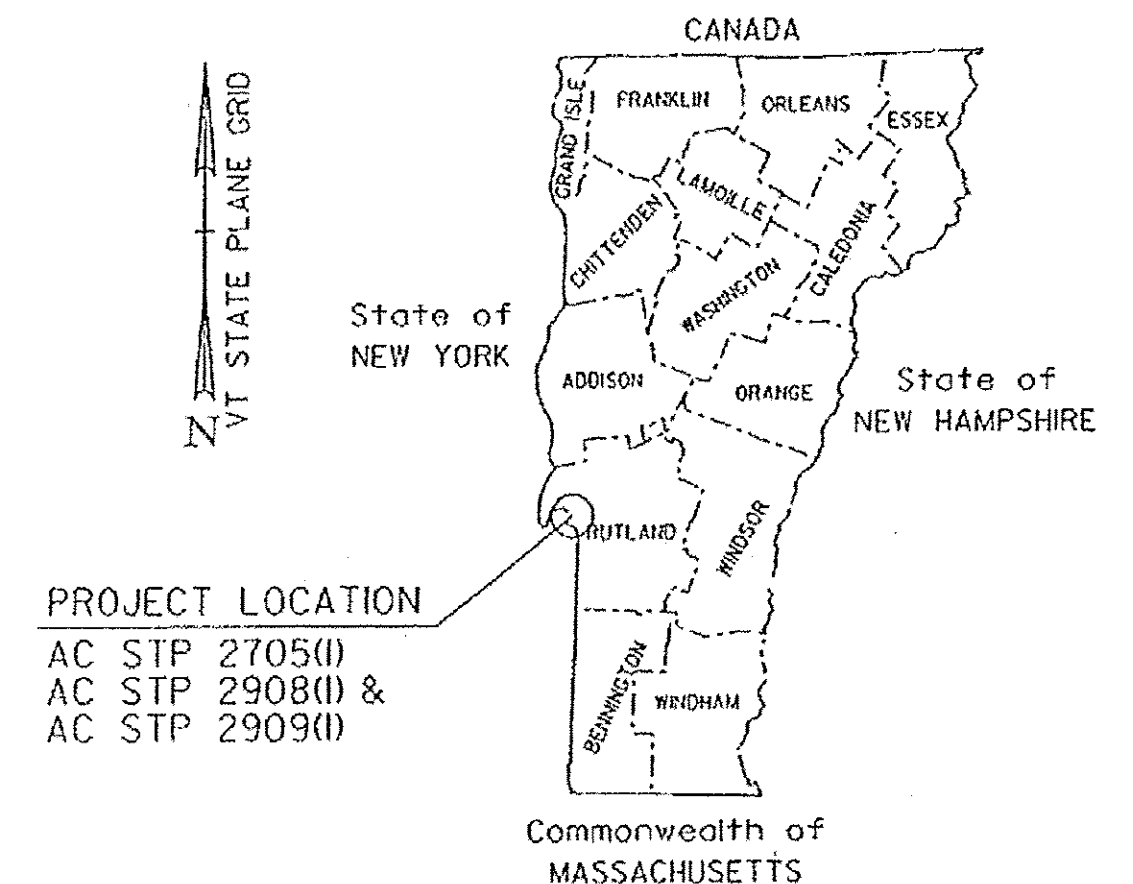

CASTLETON-WEST RUTLAND
AC STP 2705(I)
SEE SHEET 12
FOR ADDITIONAL PROJECT INFORMATION
AND THE SUPERPAVE DESIGN CRITERIA

CASTLETON CLASS I
AC STP 2908(I)
SEE SHEET 90
FOR ADDITIONAL PROJECT INFORMATION
AND THE SUPERPAVE DESIGN CRITERIA

CASTLETON
AC STP 2909(I)
SEE SHEET 120
FOR ADDITIONAL PROJECT INFORMATION
AND THE SUPERPAVE DESIGN CRITERIA

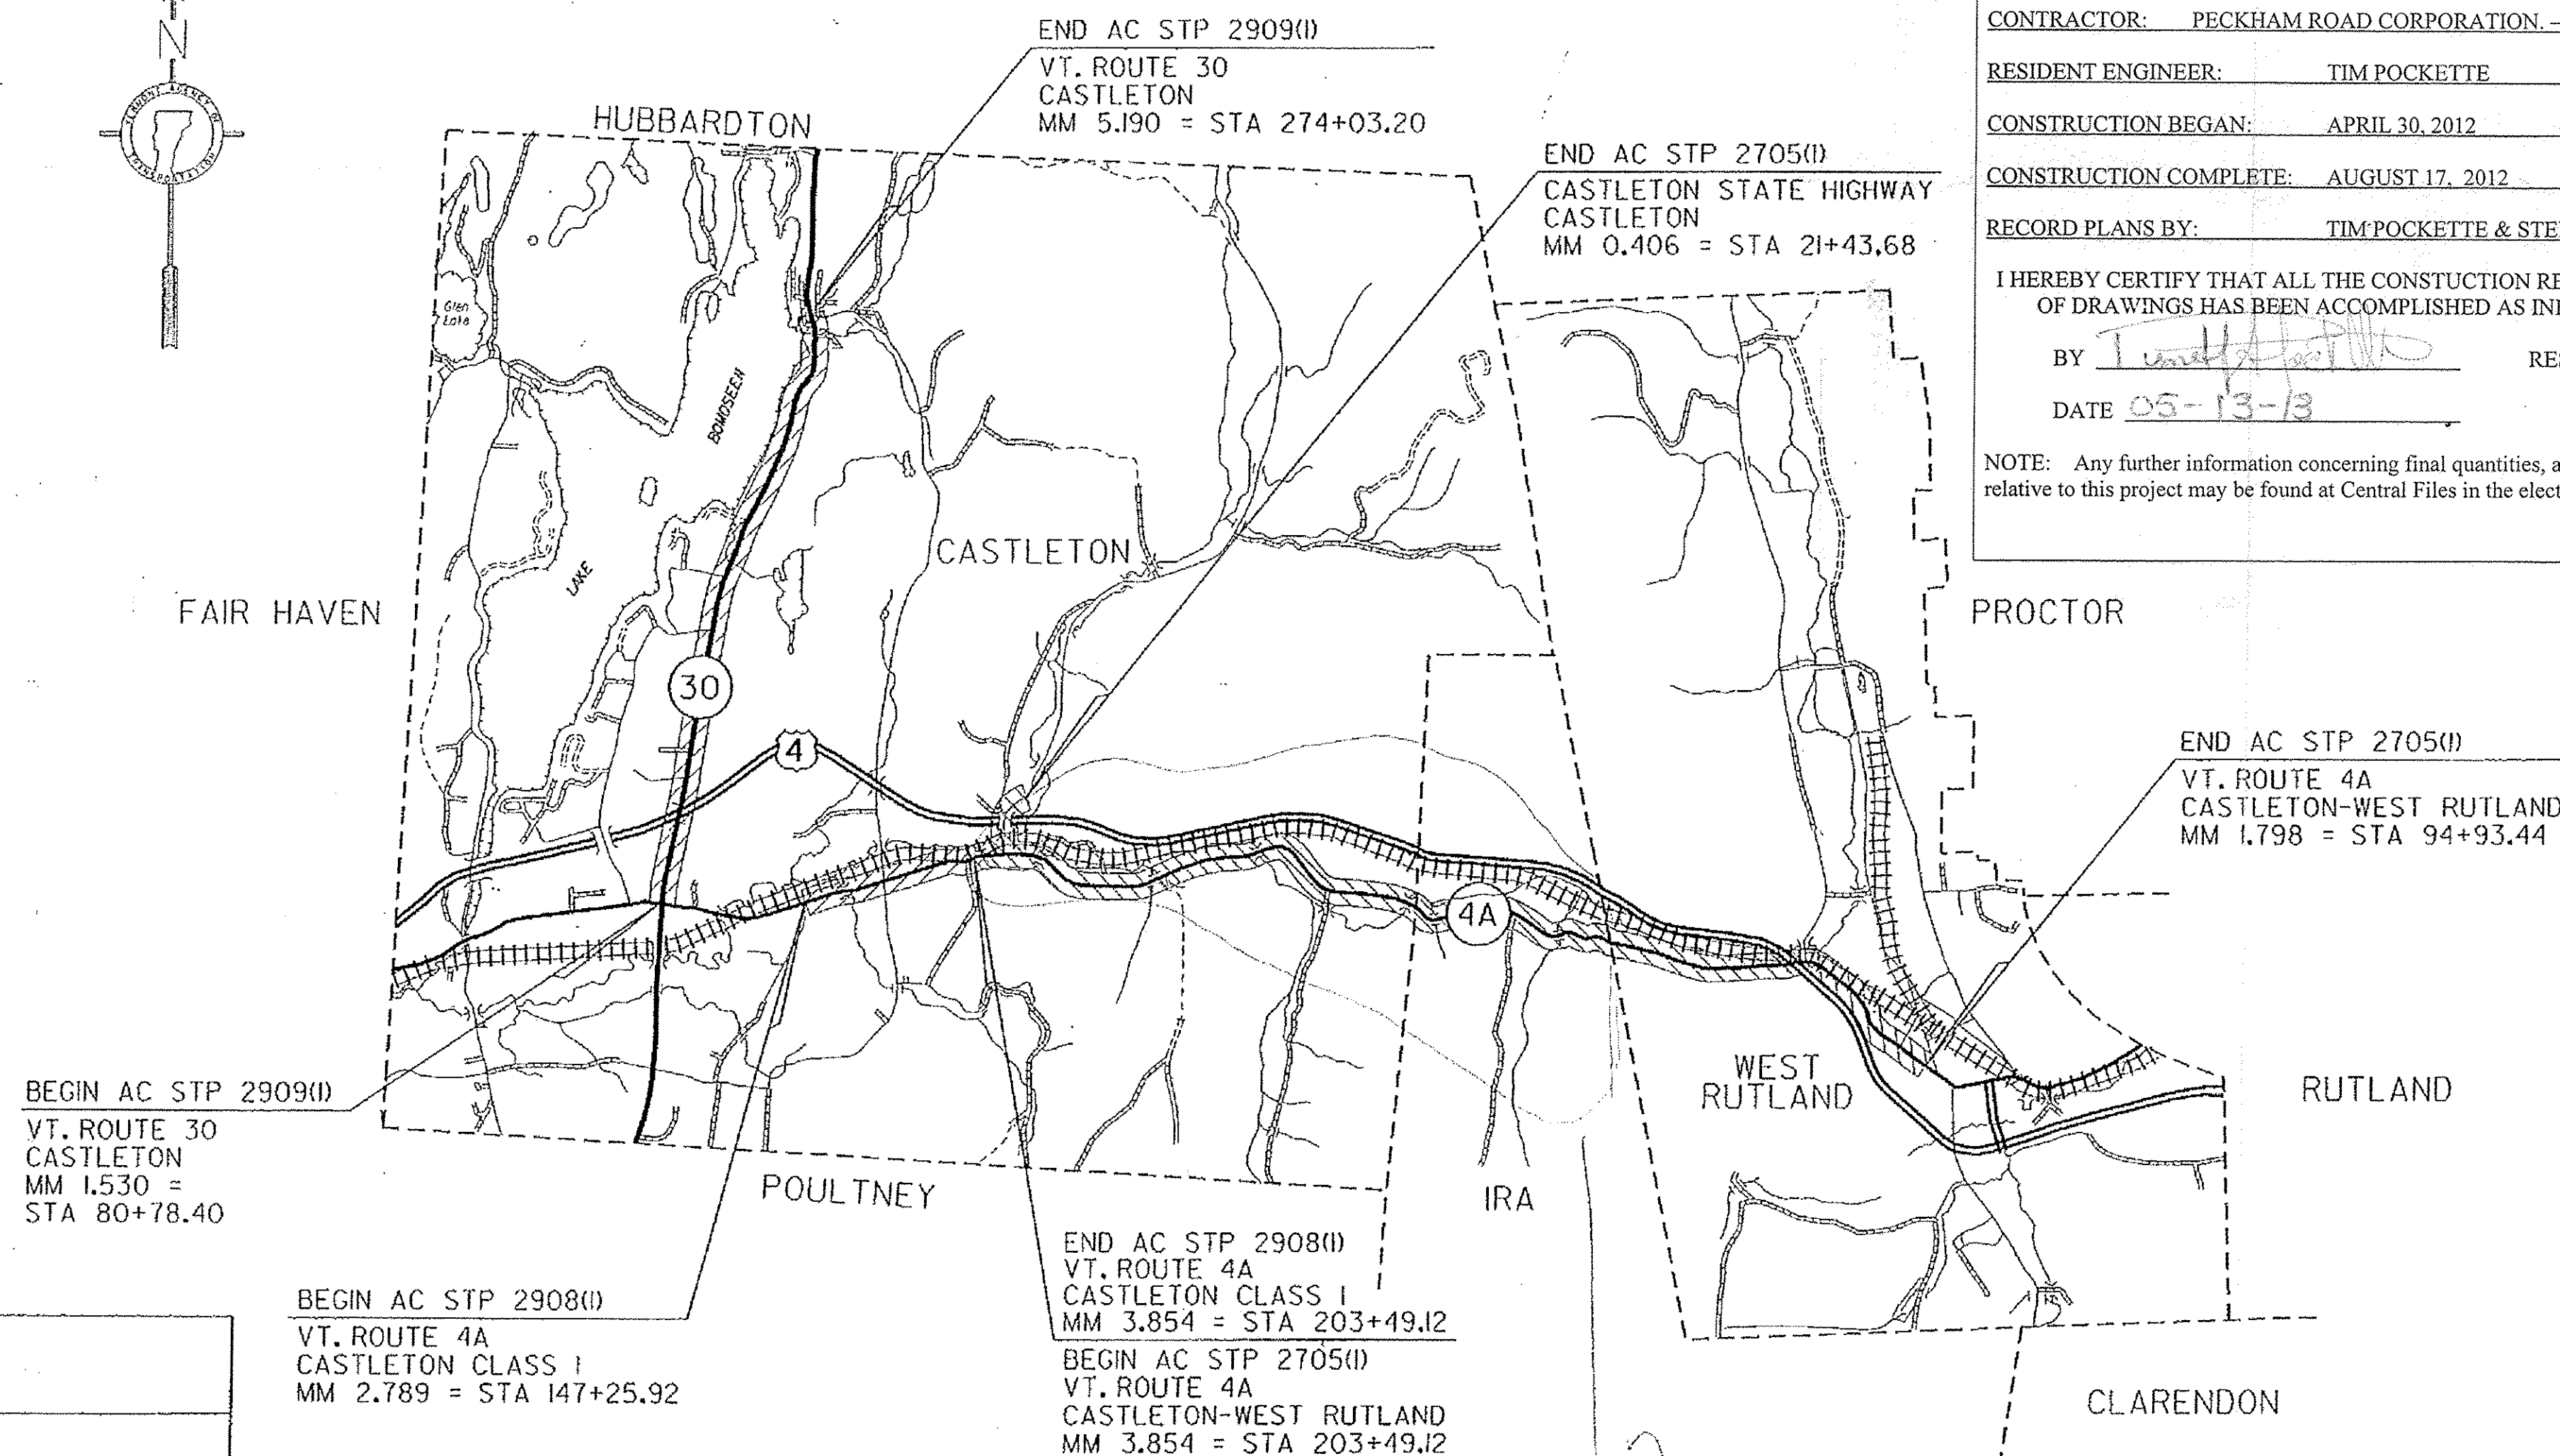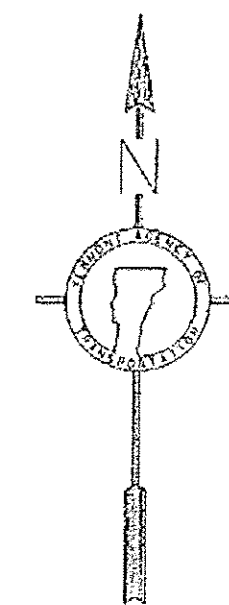

RECORD PLANS

CONTRACTOR: PECKHAM ROAD CORPORATION - WHITE PLAINS, NY

RESIDENT ENGINEER: TIM POCKETTE

CONSTRUCTION BEGAN: APRIL 30, 2012

CONSTRUCTION COMPLETE: AUGUST 17, 2012


RECORD PLANS BY: TIM POCKETTE & STEPHEN KENT

I HEREBY CERTIFY THAT ALL THE CONSTRUCTION REQUIRED BY THIS SET OF DRAWINGS HAS BEEN ACCOMPLISHED AS INDICATED HEREIN.

BY *Tim Pockette* RESIDENT ENGINEER

DATE 05-13-13

NOTE: Any further information concerning final quantities, amounts or other details relative to this project may be found at Central Files in the electronic archives.

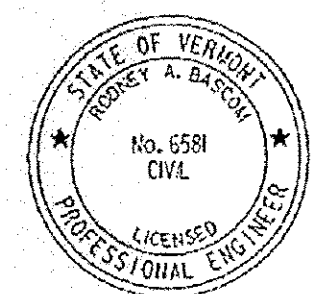

PROCTOR

PLANS PREPARED BY

Kathryn A. B...

CHA

QUALITY ASSURANCE PROGRAM: LEVEL 3

CONVENTIONAL SYMBOLS

COUNTY LINE	---
TOWN LINE	- - - -
LIMITS OF ACCESS	o - - - - o
POINT OF ACCESS	X
FENCE LINE	X - - - - X
STONE WALL	o - - - - o
TRAVELED WAY	o - - - - o
GUARD RAIL	o - - - - o
RAILROAD	o - - - - o
SURVEY LINE	o - - - - o
CULVERT	o - - - - o
POWER POLE	o
TELEPHONE POLE	o
TREES	o
CONTROL OF ACCESS	o - - - - o
PROPERTY LINE	o - - - - o
R.O.W. TAKING LINE	o - - - - o
SLOPE RIGHTS	o - - - - o
TOP OF CUT	o - - - - o
TOE OF SLOPE	o - - - - o

SURVEYED BY : NA
SURVEYED DATE : NA

DATUM
VERTICAL NA
HORIZONTAL NA

DEPARTMENT OF TRANSPORTATION
FEDERAL HIGHWAY ADMINISTRATION
APPROVED *Mark D. Ricketts* 9-22-11
DIRECTOR OF PROGRAM DEVELOPMENT
APPROVED *Robt. F...* DATE 9/2/11
PROJECT MANAGER : MIKE FOWLER
PROJECT NAME : CASTLETON-WEST RUTLAND
& CASTLETON
PROJECT NUMBER : AC STP 2705 (I), AC STP 2908 (I)
& AC STP 2909 (I)
SHEET 1 OF 152 SHEETS