
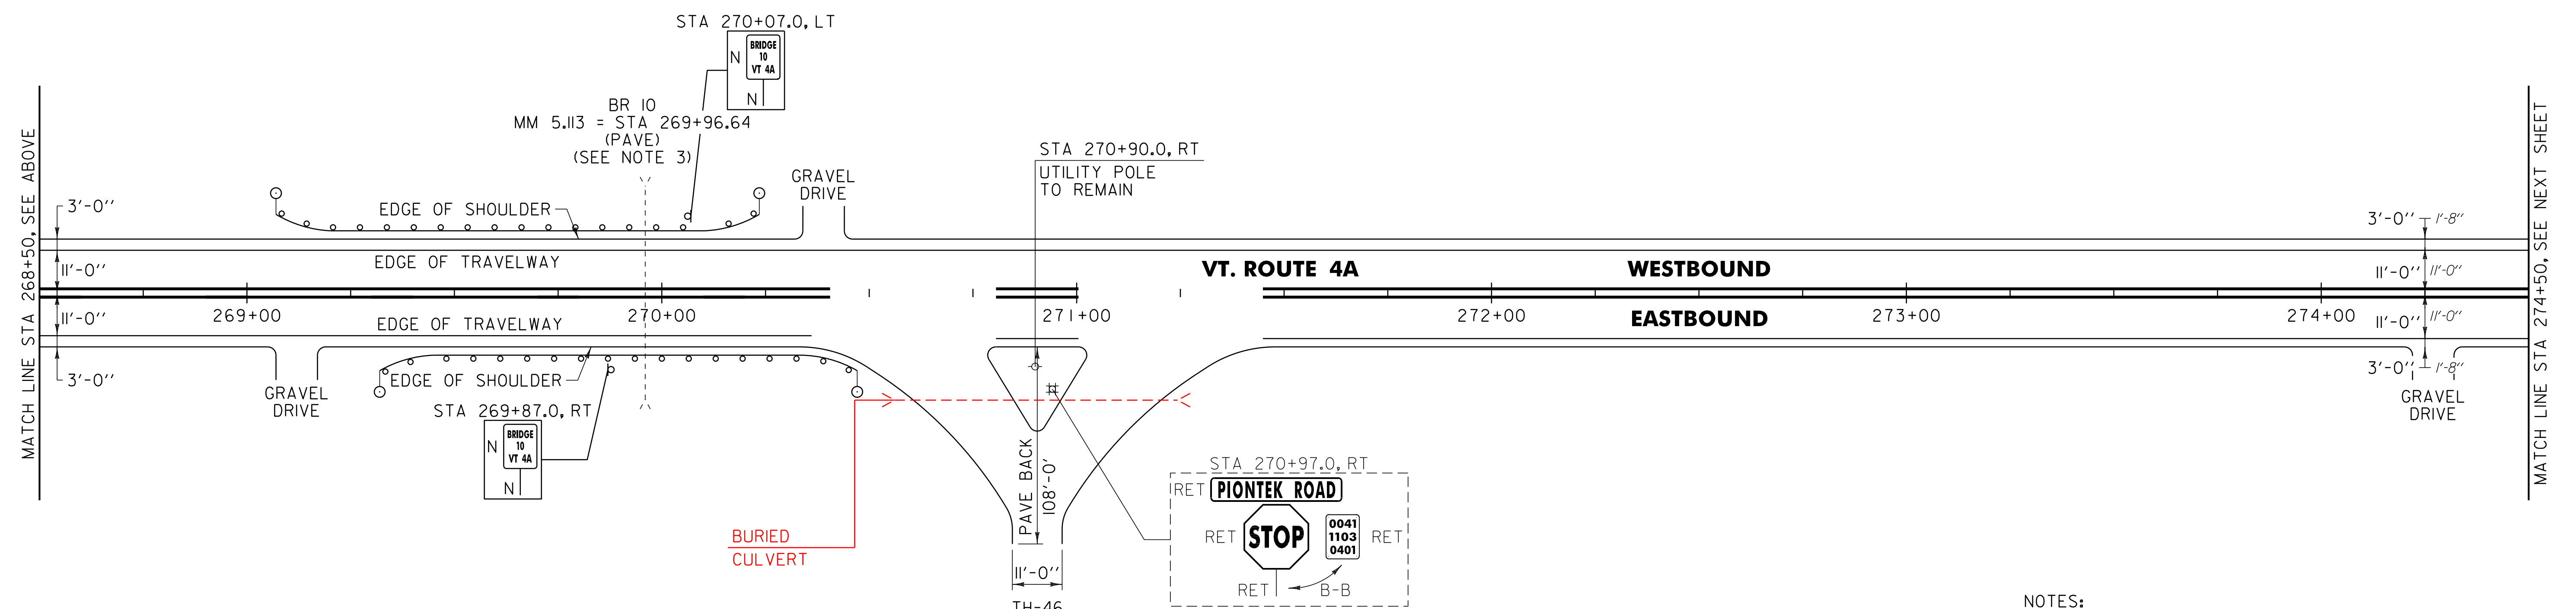


646.402 DURABLE 4 INCH WHITE LINE, THERMOPLASTIC OR
 646.403 DURABLE 4 INCH WHITE LINE, EPOXY PAINT OR
 646.404 DURABLE 4 INCH WHITE LINE, POLYUREA
 (ALL LINES WILL INCLUDE EDGE LINE BREAKS AND
 RADIUS FOR TOWN HIGHWAYS)
 CASTLETON:
 STA 262+50.00 - STA 274+50.00 LT & RT

646.412 DURABLE 4 INCH YELLOW LINE, THERMOPLASTIC OR
 646.413 DURABLE 4 INCH YELLOW LINE, EPOXY PAINT OR
 646.414 DURABLE 4 INCH YELLOW LINE, POLYUREA
 (ALL LINES WILL INCLUDE C/L BREAKS FOR
 TOWN HIGHWAYS) S=SOLID, D=DASHED
 CASTLETON:
 STA 262+50.00 - STA 274+50.00 LT ☉ RT
 S - S

646.602 TEMPORARY 4 INCH WHITE LINE, PAINT
 (ALL LINES WILL INCLUDE EDGE LINE BREAKS AND
 RADIUS FOR TOWN HIGHWAYS)
 CASTLETON:
 STA 262+50.00 - STA 274+50.00 LT ☉ RT
 S - S

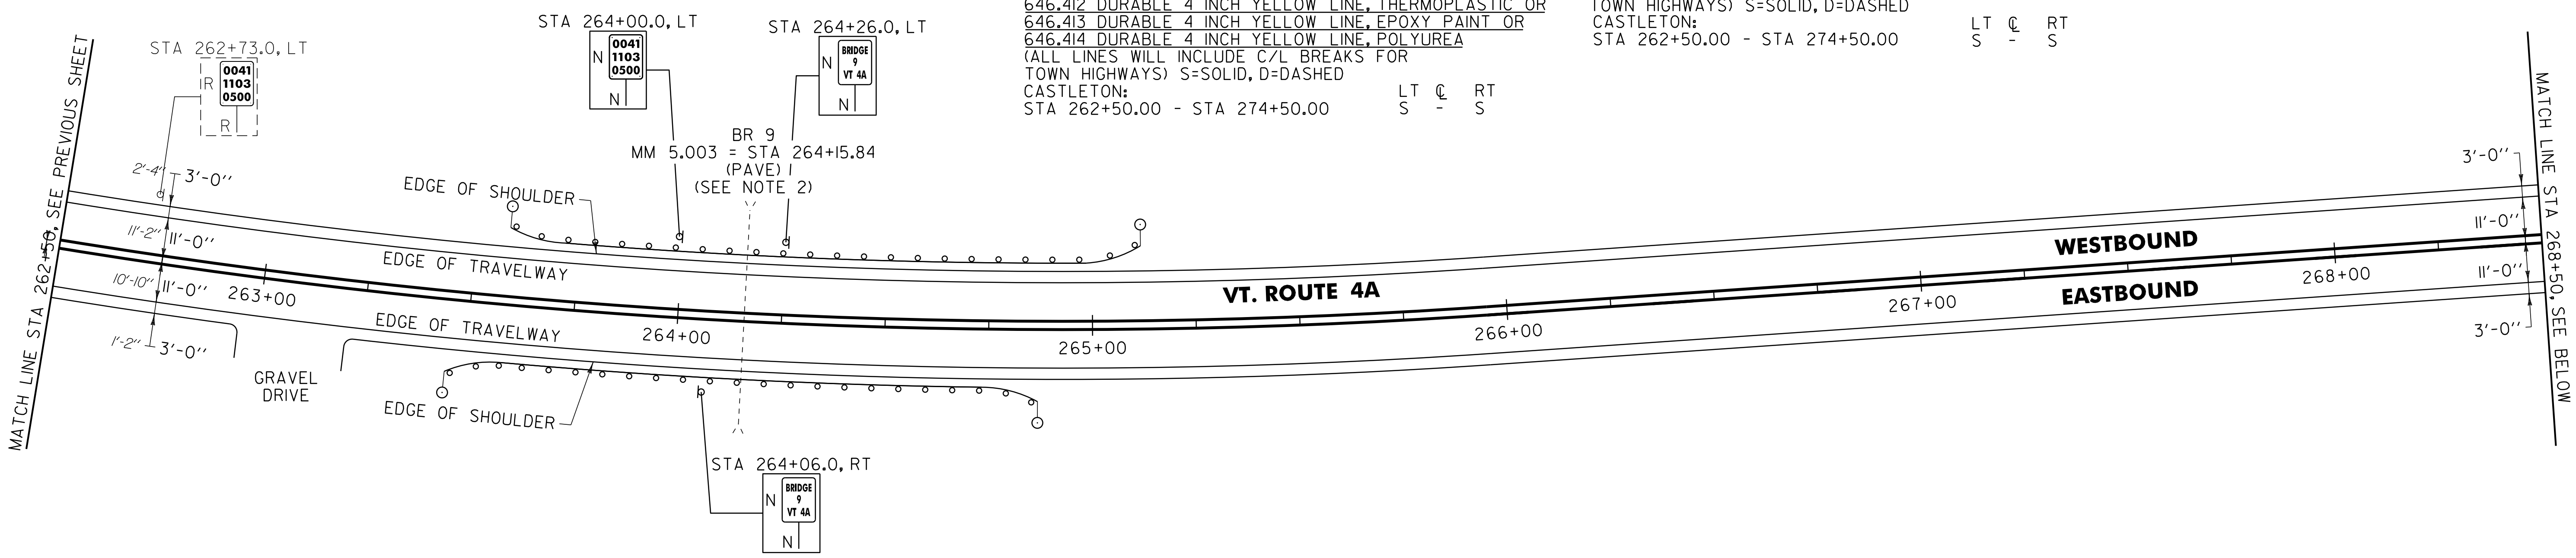

621.20 STEEL BEAM GUARDRAIL, GALVANIZED
 CASTLETON:
 STA 263+45.3 - STA 263+72.3 RT (27.0 LF)
 STA 263+57.8 - STA 263+72.3 LT (14.5 LF)
 STA 264+59.8 - STA 264+86.8 RT (27.0 LF)
 STA 264+59.8 - STA 265+11.8 LT (52.0 LF)
 STA 269+07.0 - STA 269+84.0 LT (77.0 LF)
 STA 269+32.0 - STA 269+84.0 RT (52.0 LF)
 STA 270+09.0 - STA 270+23.5 LT (14.5 LF)
 STA 270+09.0 - STA 270+48.5 RT (39.5 LF)

621.60 ANCHOR FOR STEEL BEAM RAIL
 CASTLETON:
 STA 263+51.8 RT
 STA 263+64.3 LT
 STA 264+80.3 RT
 STA 265+05.3 LT
 STA 269+13.5 LT
 STA 269+38.5 RT
 STA 270+17.0 LT
 STA 270+42.0 RT

621.80 REMOVAL AND DISPOSAL OF GUARDRAIL
 CASTLETON:
 STA 263+56.0 - STA 264+80.0 RT (124.0 LF)
 STA 263+67.0 - STA 265+04.0 LT (137.0 LF)
 STA 269+18.0 - STA 270+15.0 LT (97.0 LF)
 STA 269+29.0 - STA 270+39.0 RT (110.0 LF)

676.10 DELINEATOR WITH STEEL POST
 CASTLETON:
 STA 263+45.3 RT
 STA 263+57.8 LT
 STA 264+86.8 RT
 STA 265+11.8 LT
 STA 269+07.0 LT
 STA 269+32.0 RT
 STA 270+23.5 LT
 STA 270+48.5 RT

- NOTES:
- PAVE BACK 108 FT FROM VT. ROUTE 4A EDGE OF SHOULDER TO THE EXISTING BRIDGE ON PIONTEK ROAD OR AS DIRECTED BY THE RESIDENT ENGINEER.
 - SEE SHEET 9 FOR DOUBLE-NESTED GUARDRAIL SYSTEM.
 - SEE SHEET 10 FOR STEEL BEAM GUARDRAIL AT SMALL CULVERT DETAIL.

SIGN LEGEND
 R = REMOVE
 S = SALVAGE
 N = NEW
 RET = RETAIN
 B-B = BACK TO BACK
 EXISTING = _____
 NEW = _____

NOT TO SCALE

PROJECT LAYOUT SHEET #7	PROJECT NAME: CASTLETON - WEST RUTLAND	PLOT DATE: 04-JUN-2013 09:2
	PROJECT NUMBER: STP 2705(1)	DRAWN BY: W.G.P.
	FILE NAME: p07cl68.dgn	CHECKED BY: D.E.G.
	DESIGNED BY: M.J.M.	SHEET 28 OF 152